
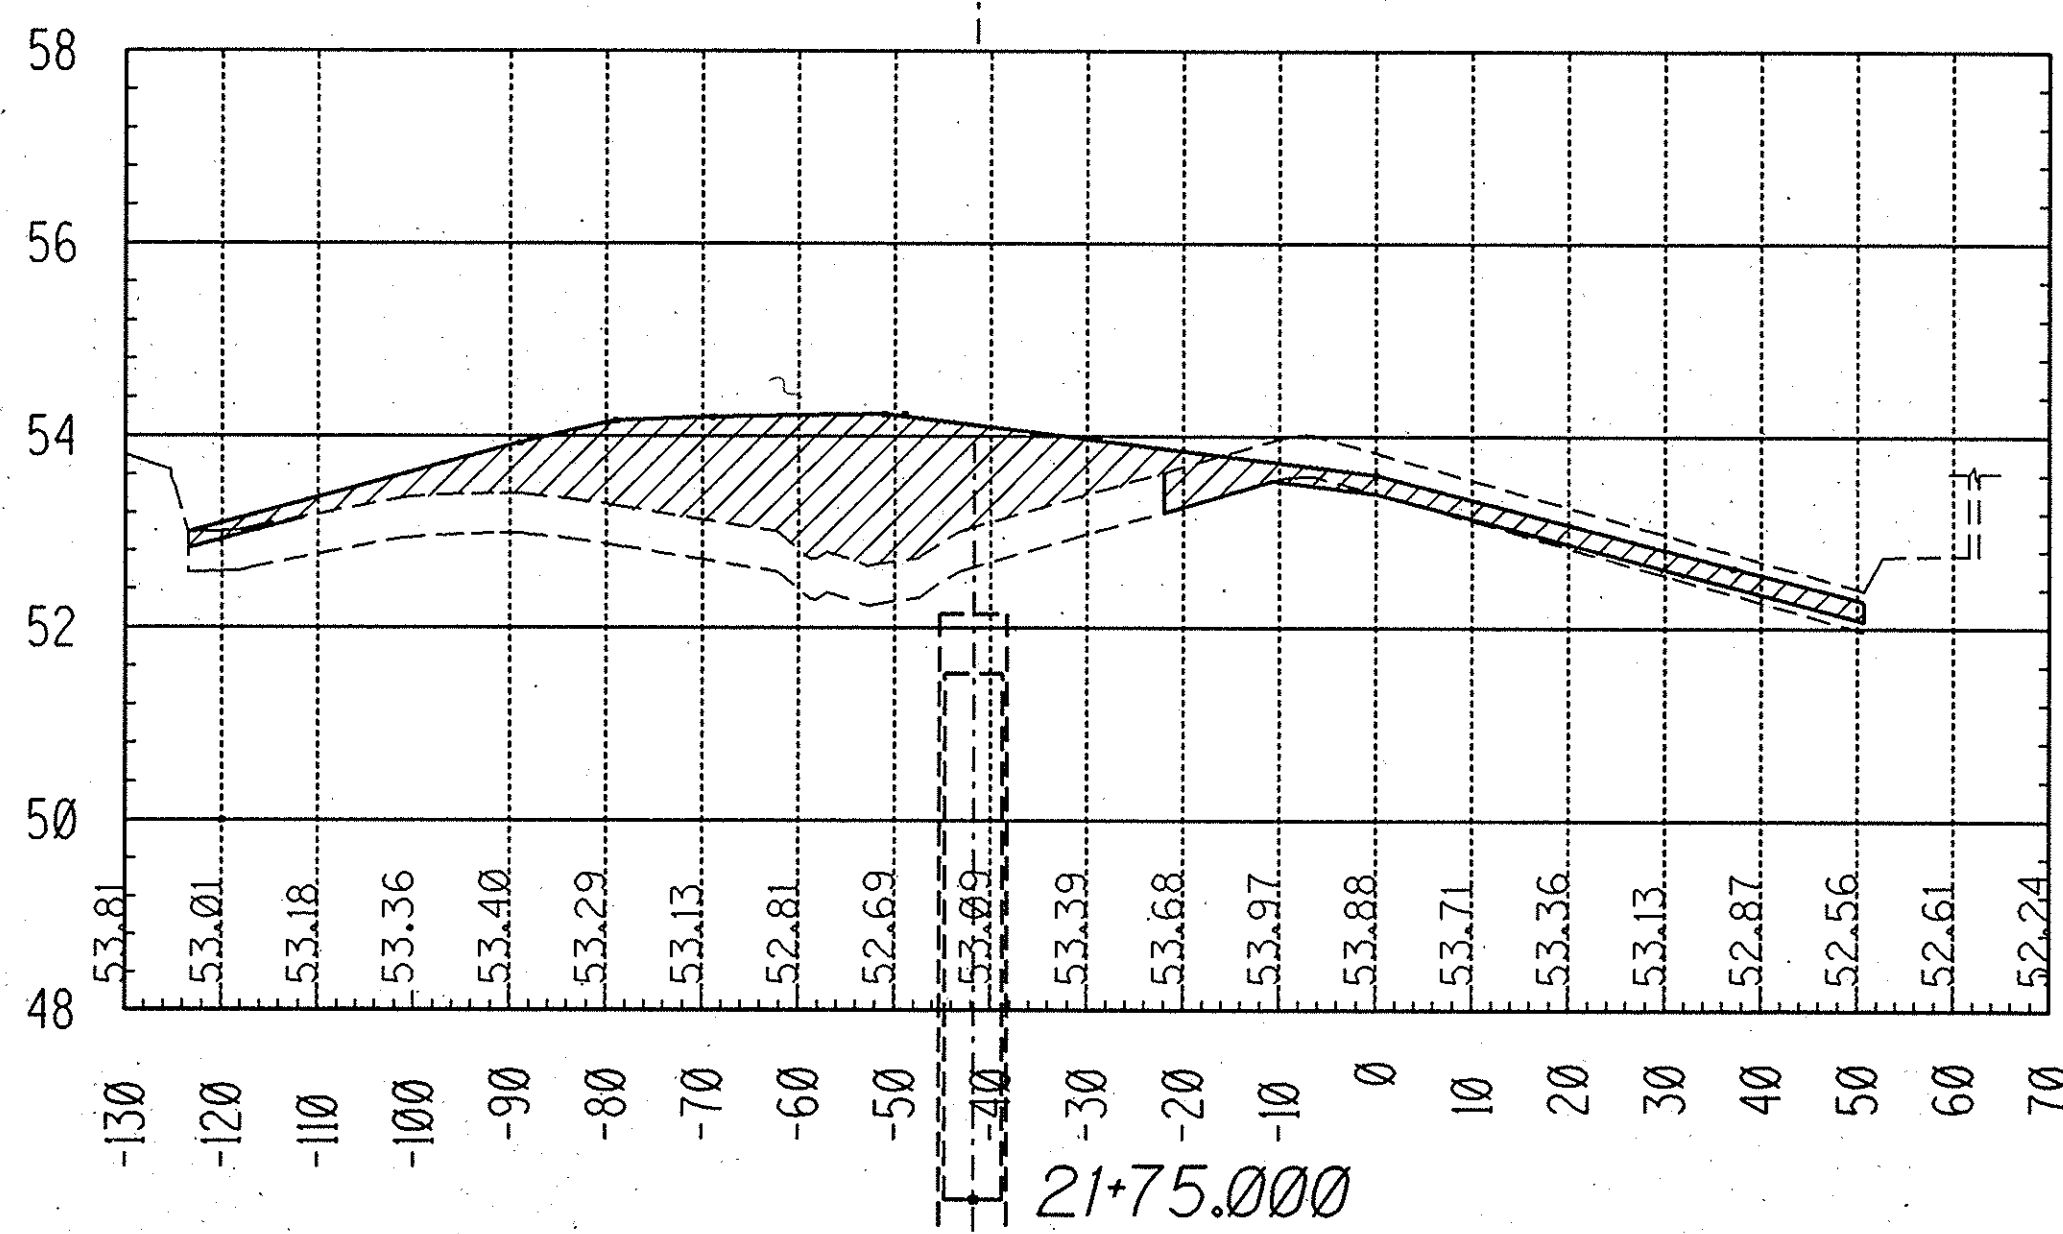
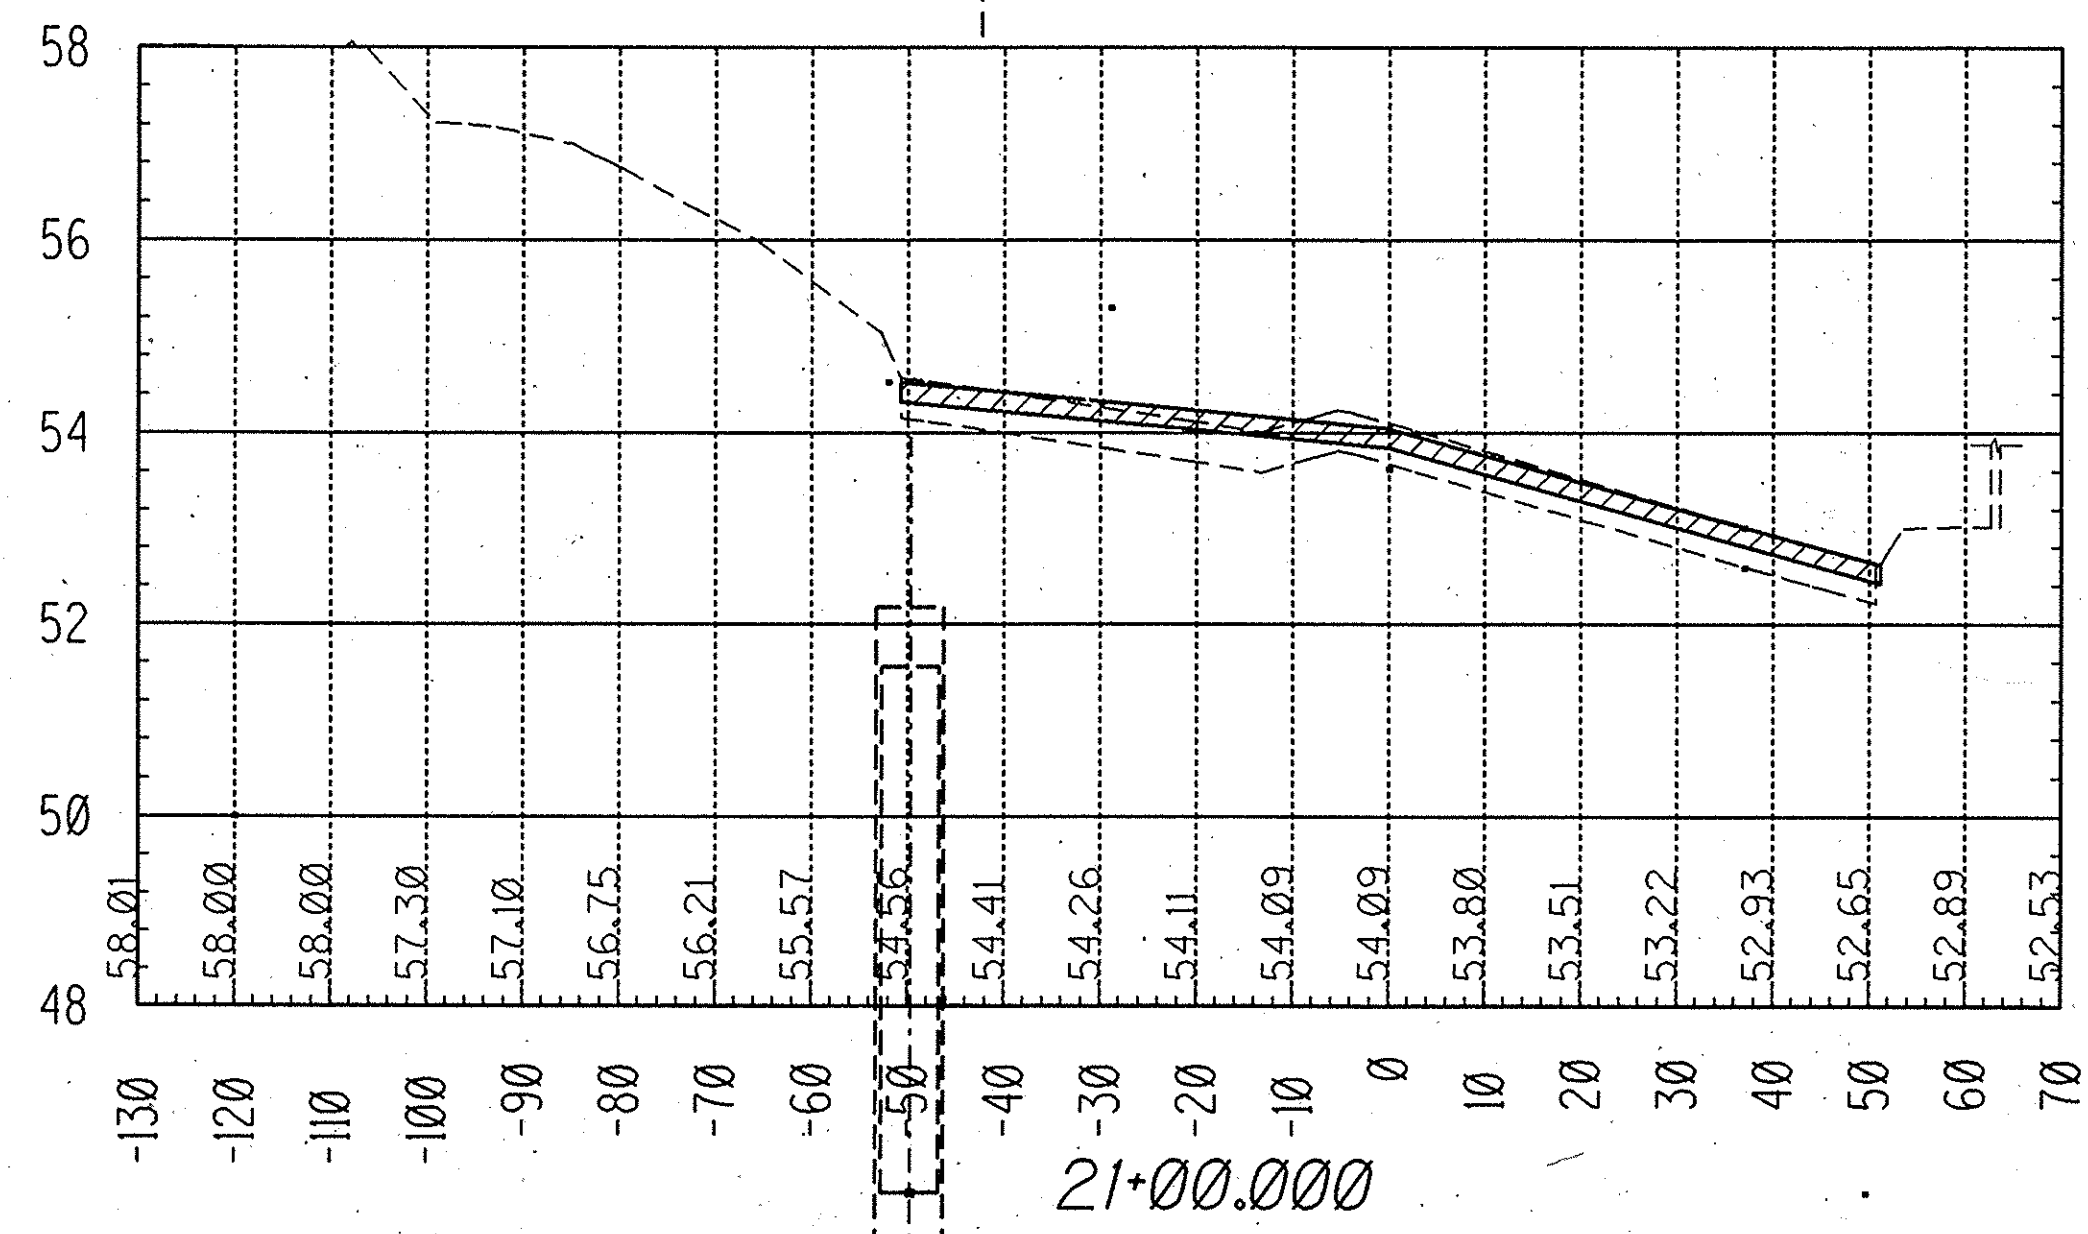
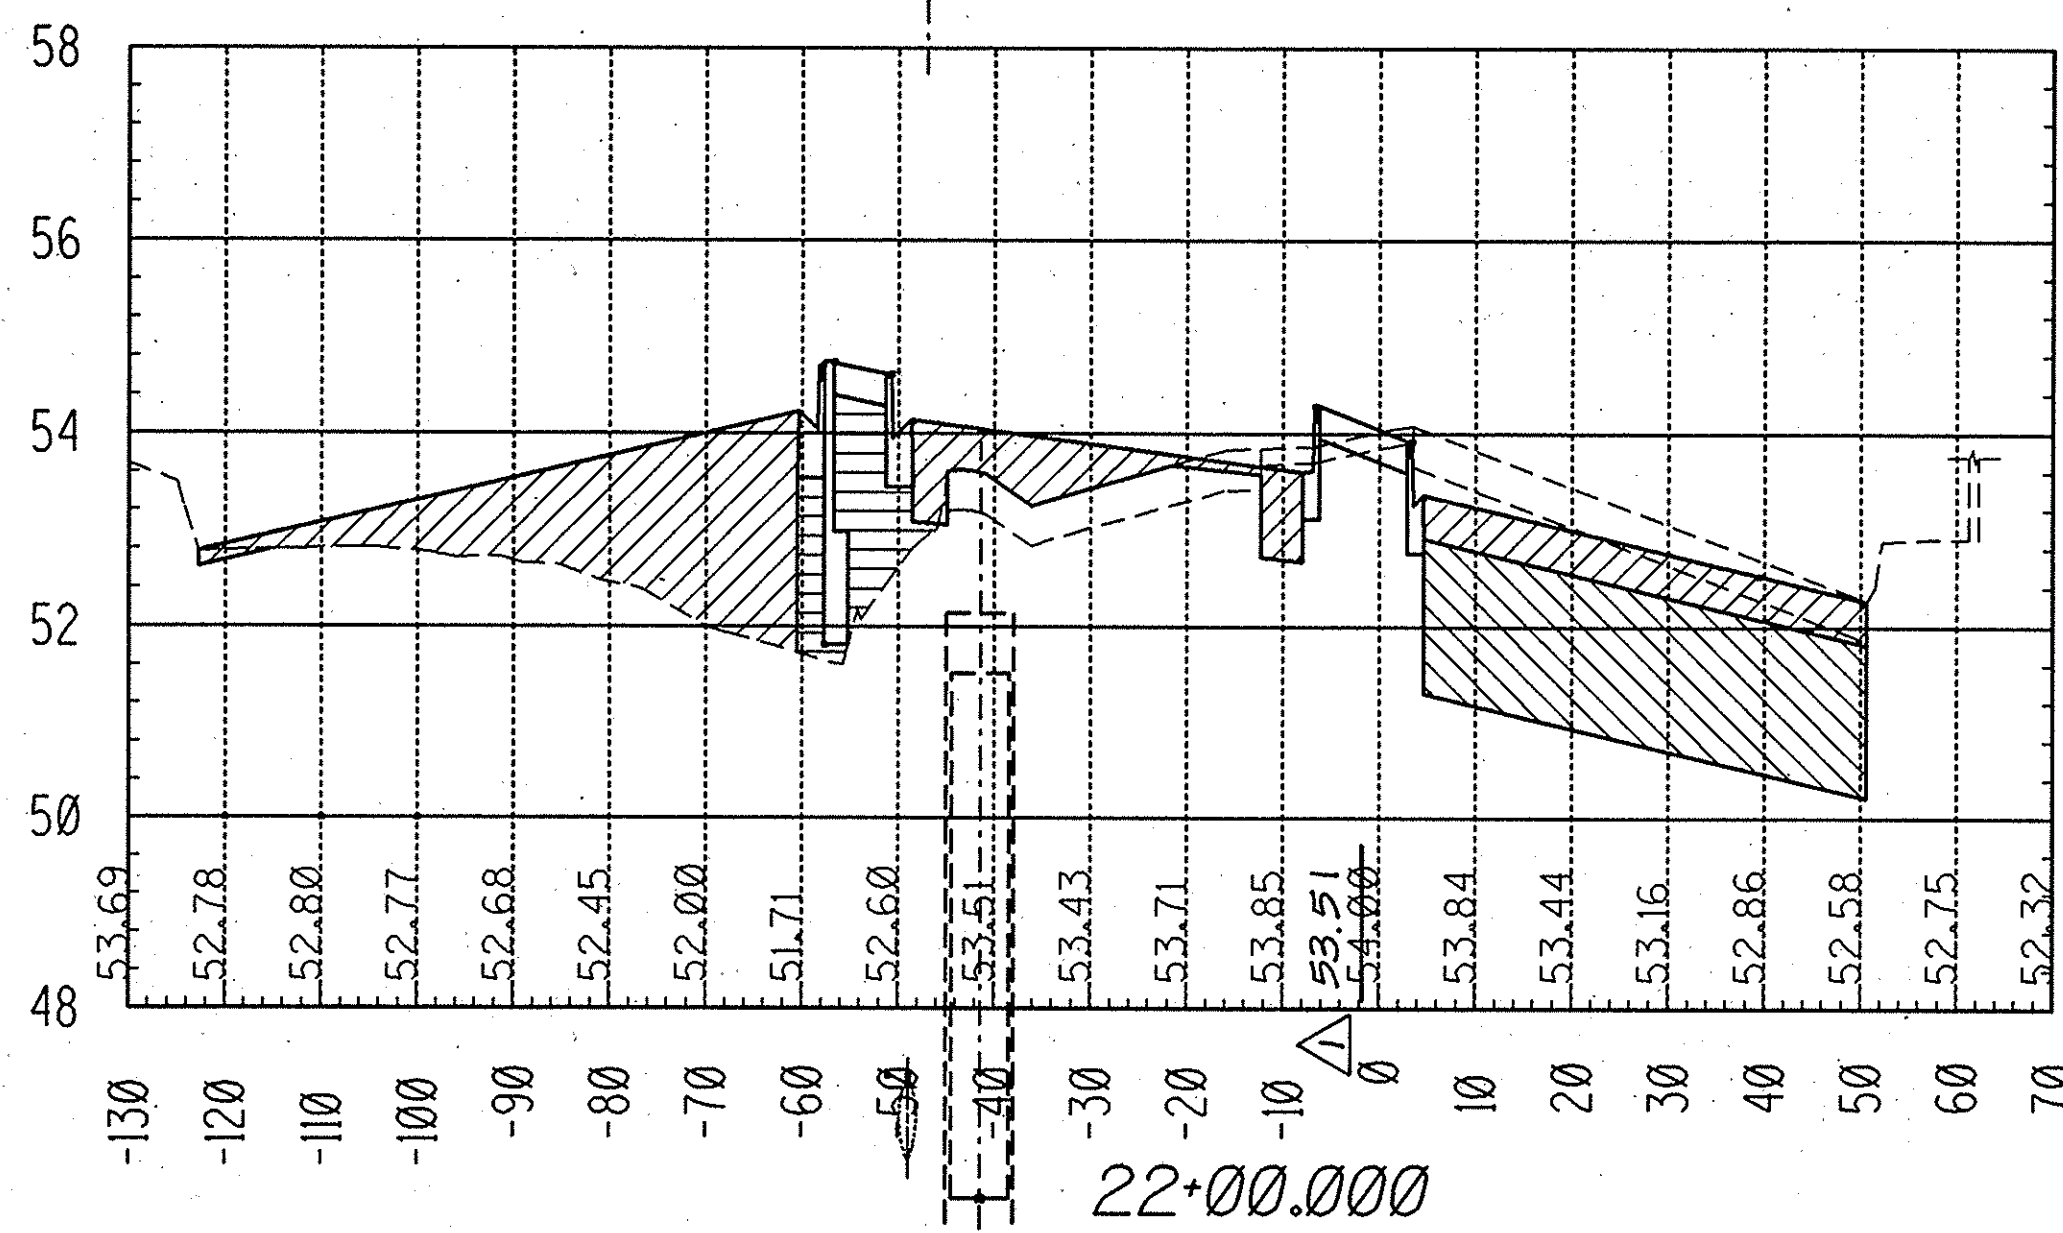
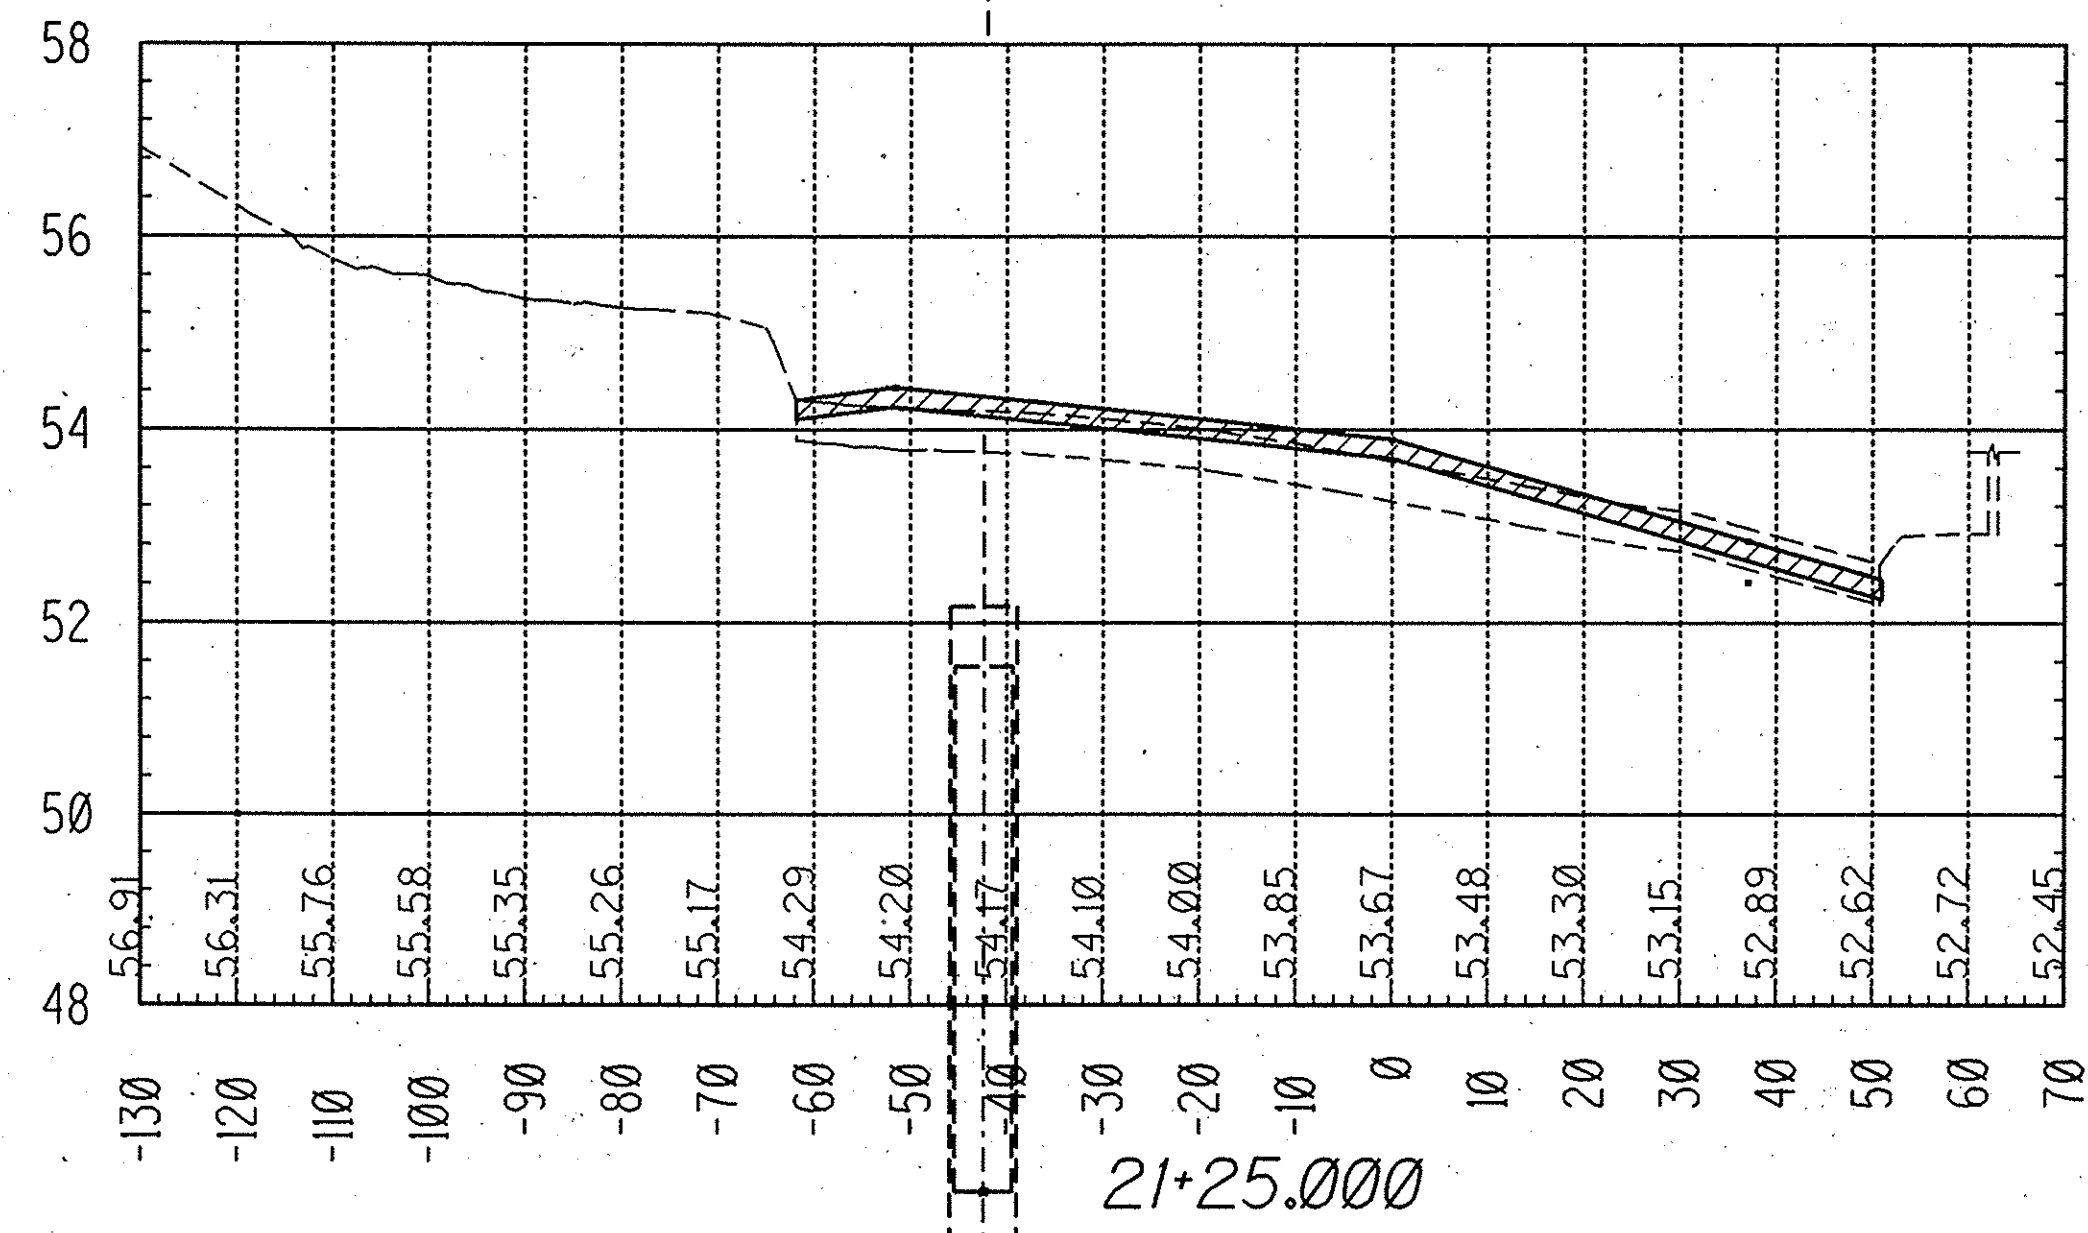
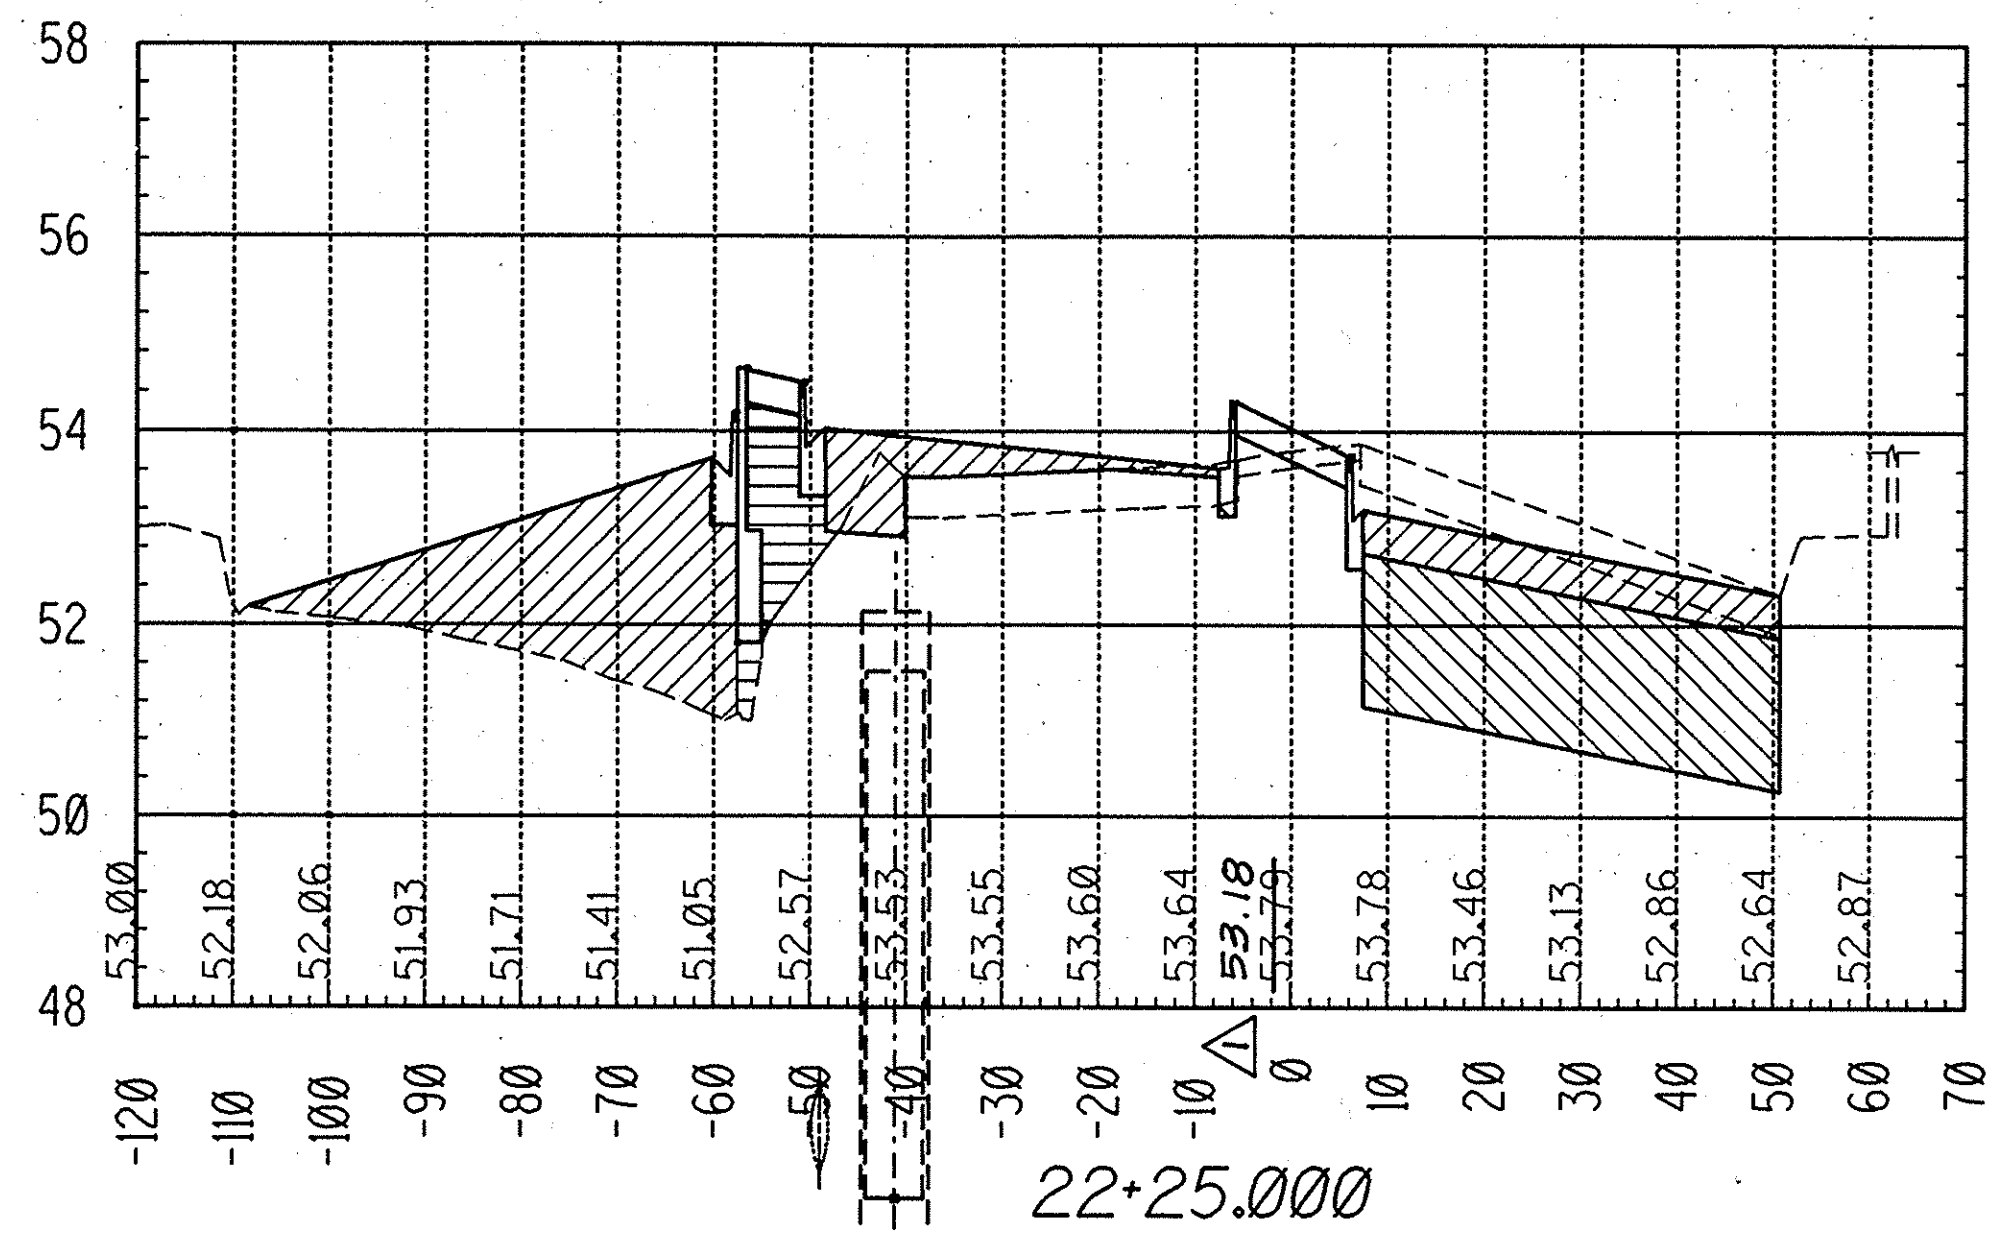


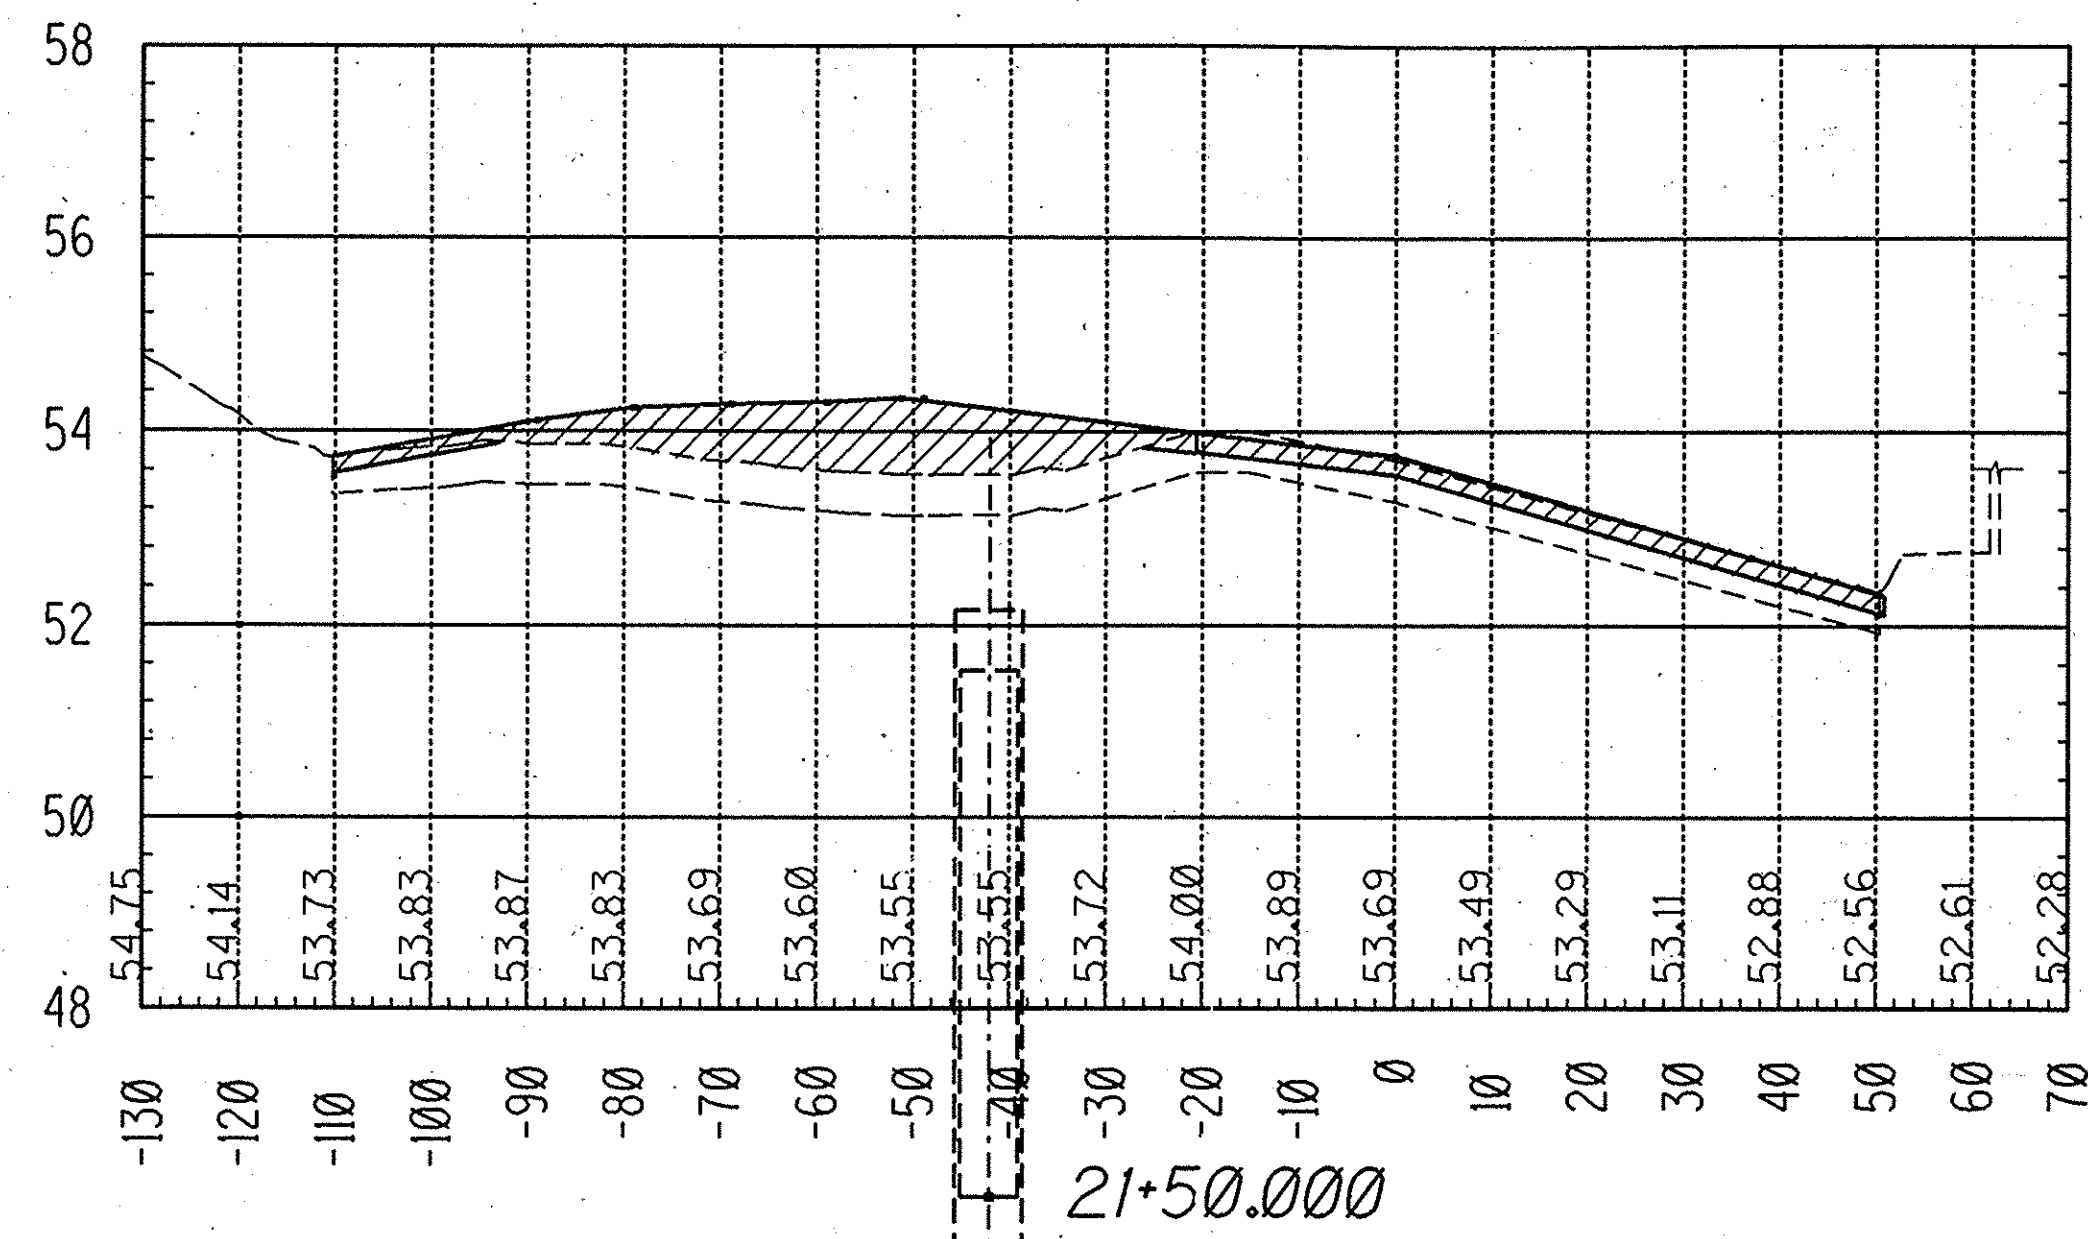

LEGEND

- AGGREGATE BASE MATERIAL
- ASPHALT CONCRETE
- UNCLASSIFIED FILL

RECORD DRAWING

1/2 0 2
3 inches on original drawing

ORANGE COUNTY ENVIRONMENTAL MANAGEMENT AGENCY	
HARBOR BLVD. IMPROVEMENTS	
CROSS SECTIONS 21+00 to 22+25	
DESIGNED: RRS	SHEET 45 OF 60
DRAWN: SG/PAN/AHP	CHECKED: RAH
SCALE: AS SHOWN	DATE: 3-93
DRAWING NO.	

PREPARED UNDER SUPERVISION OF
RICHARD RCE 39595 (61-93)

4-95 EXIST. ELEV. @ ϕ

REVISIONS

DATE 3/4/93

PROFILE

HORIZ. 1"=20'
VERT. 1"=2'