
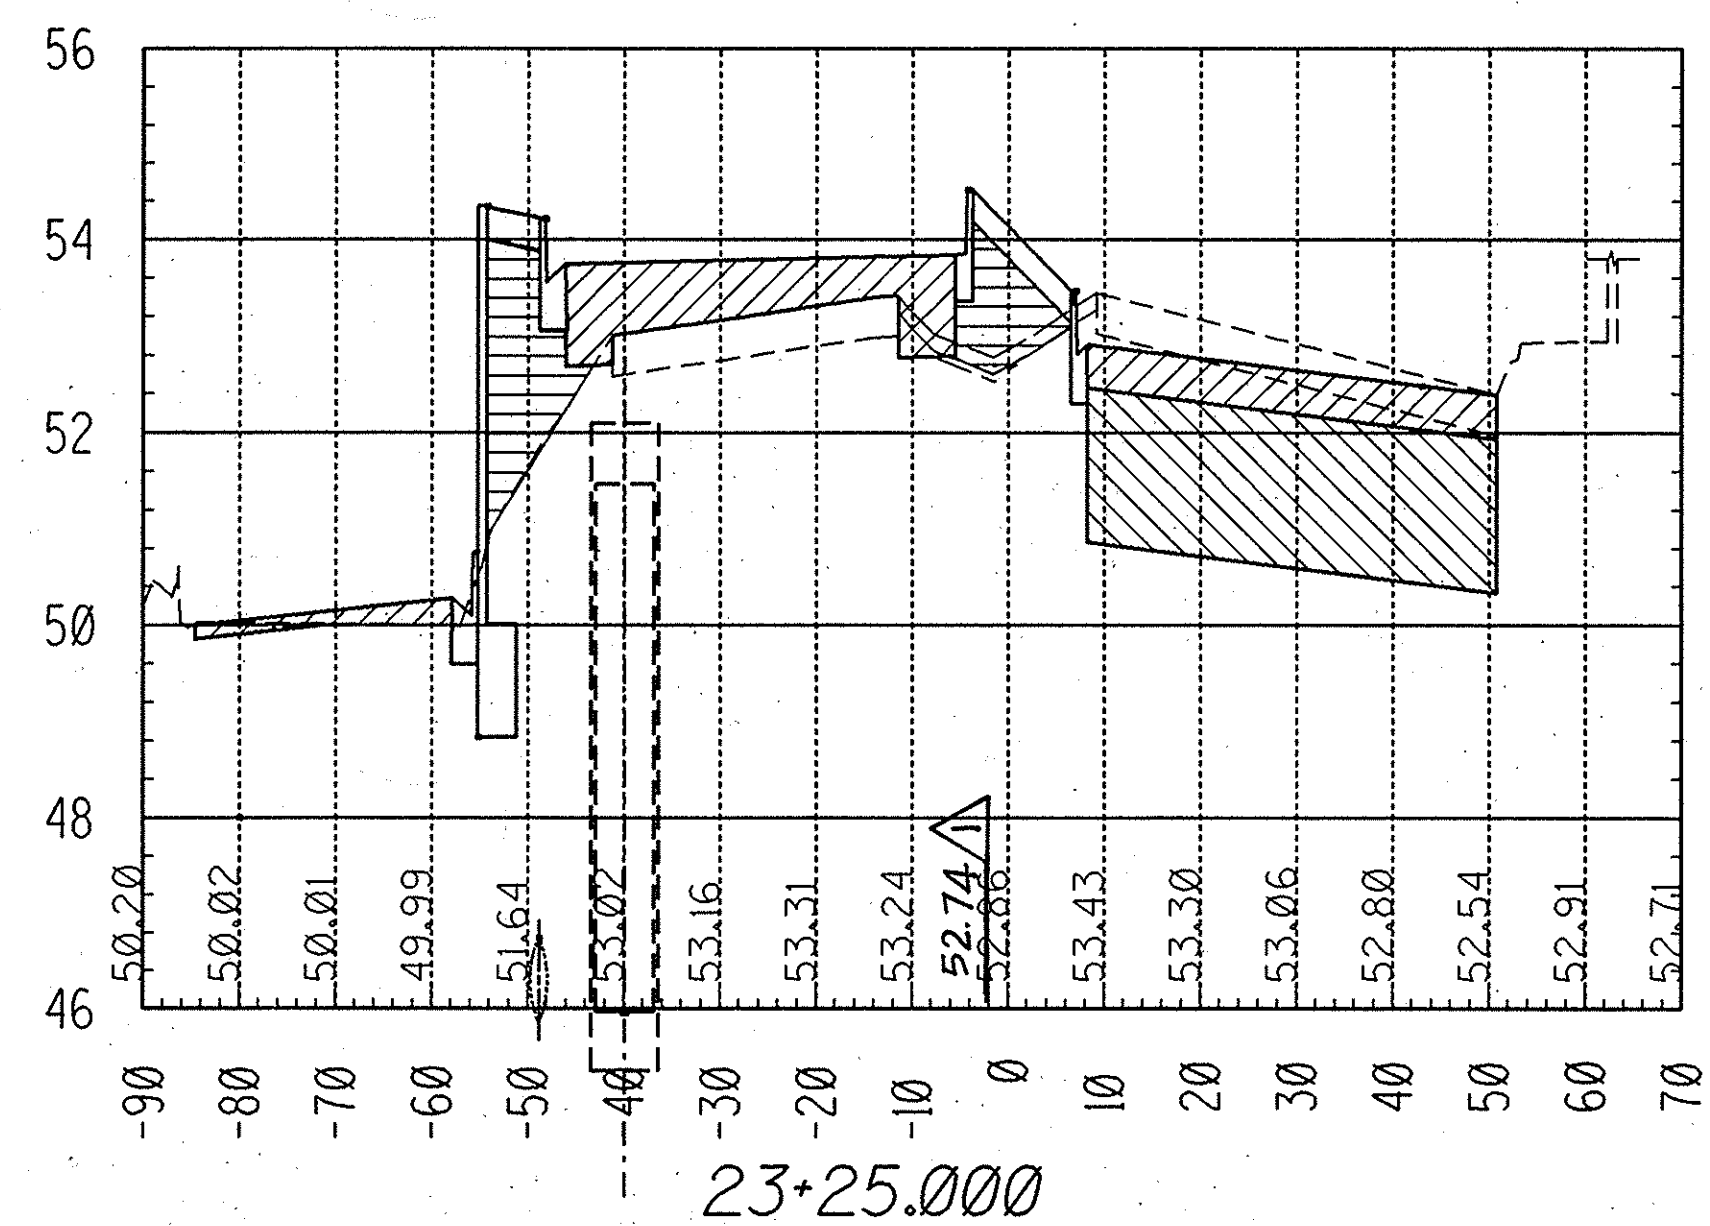
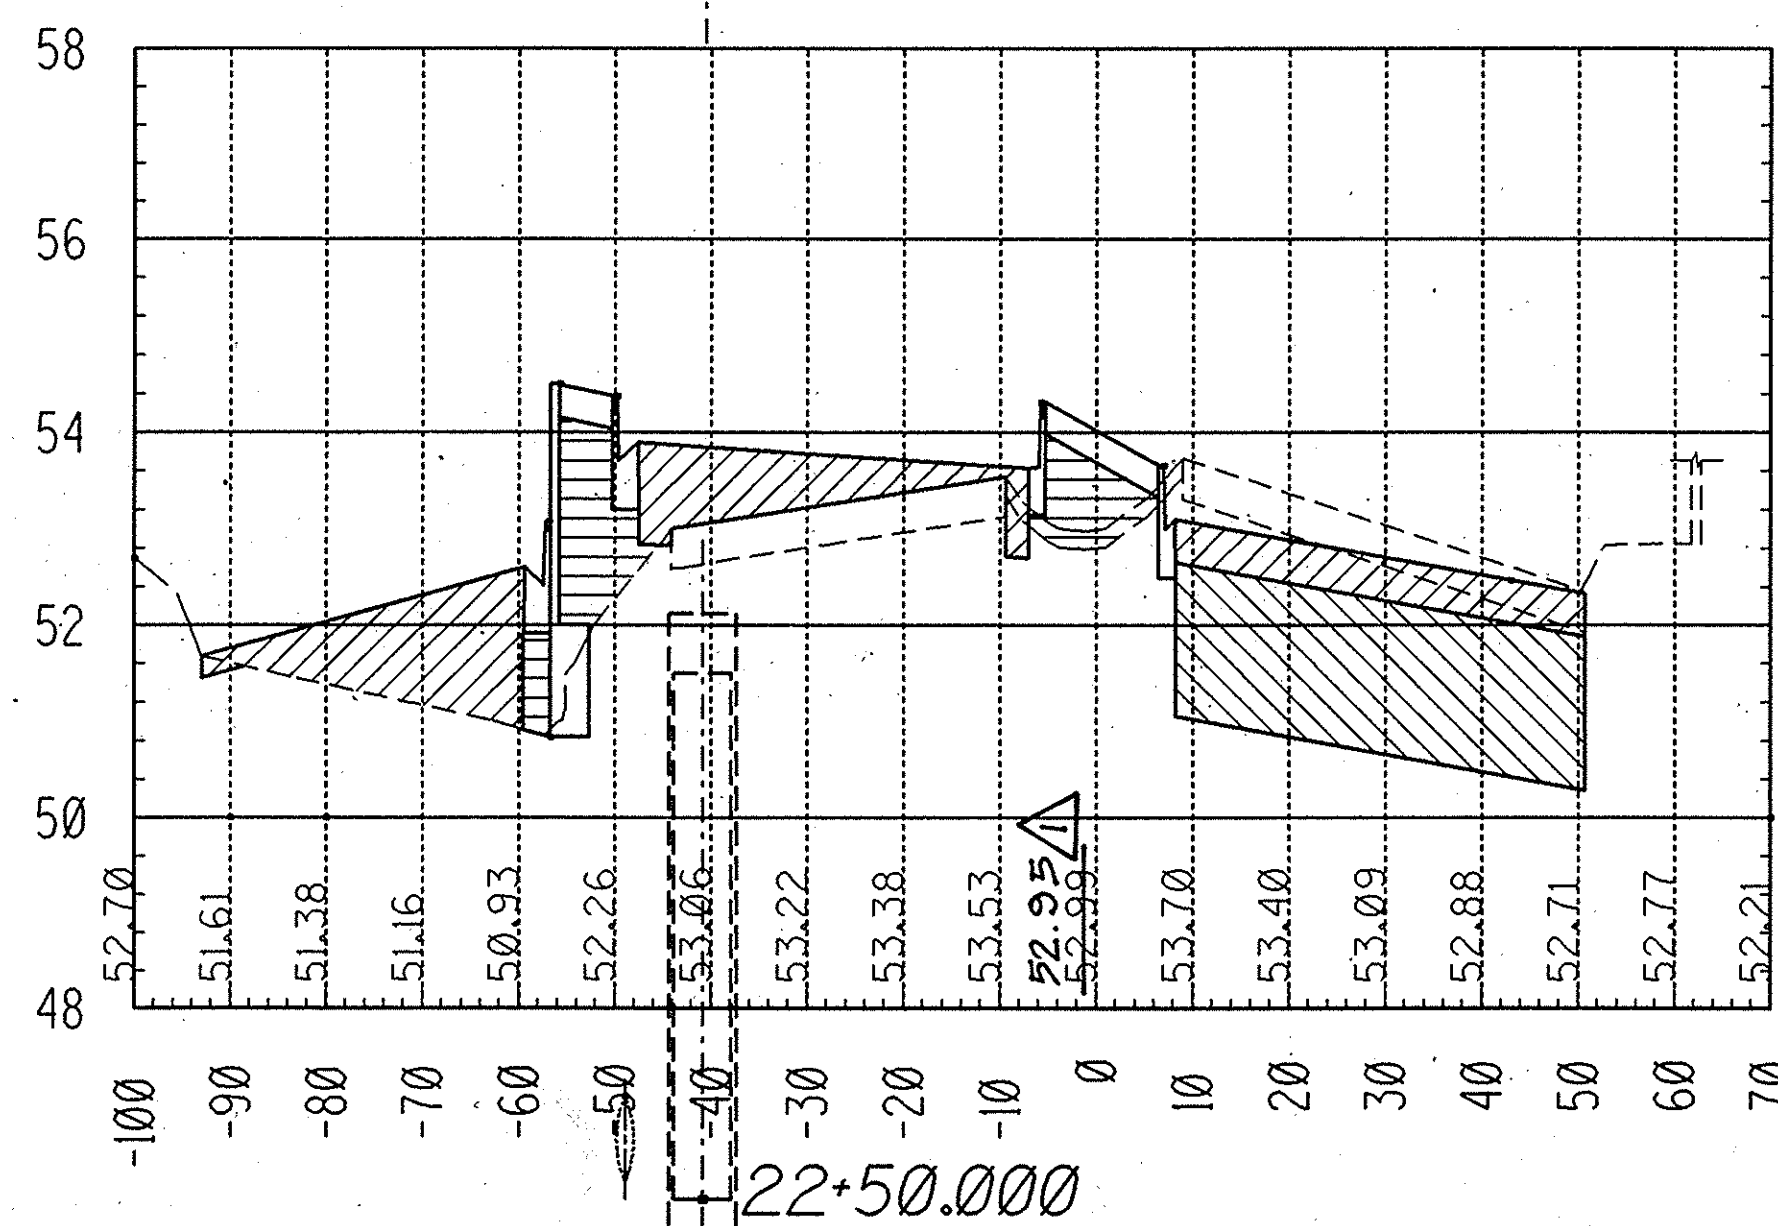
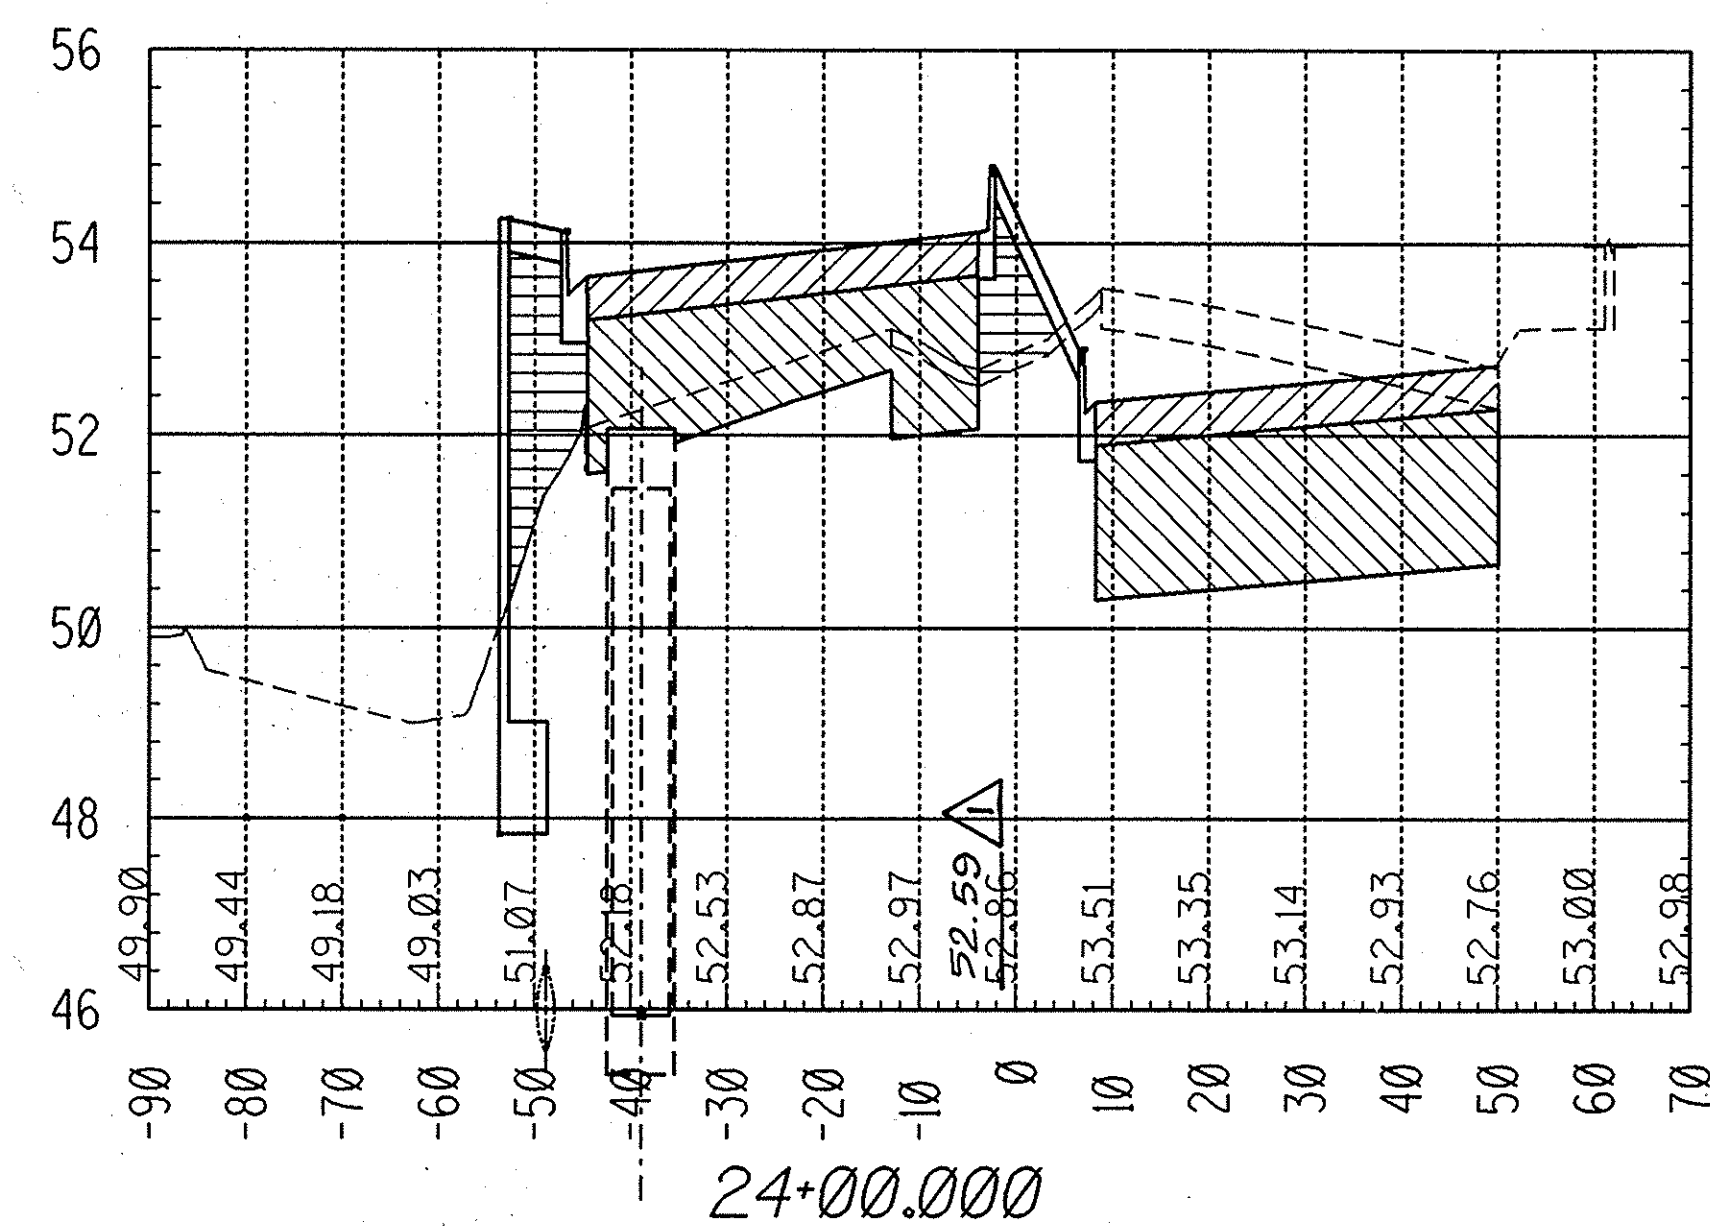
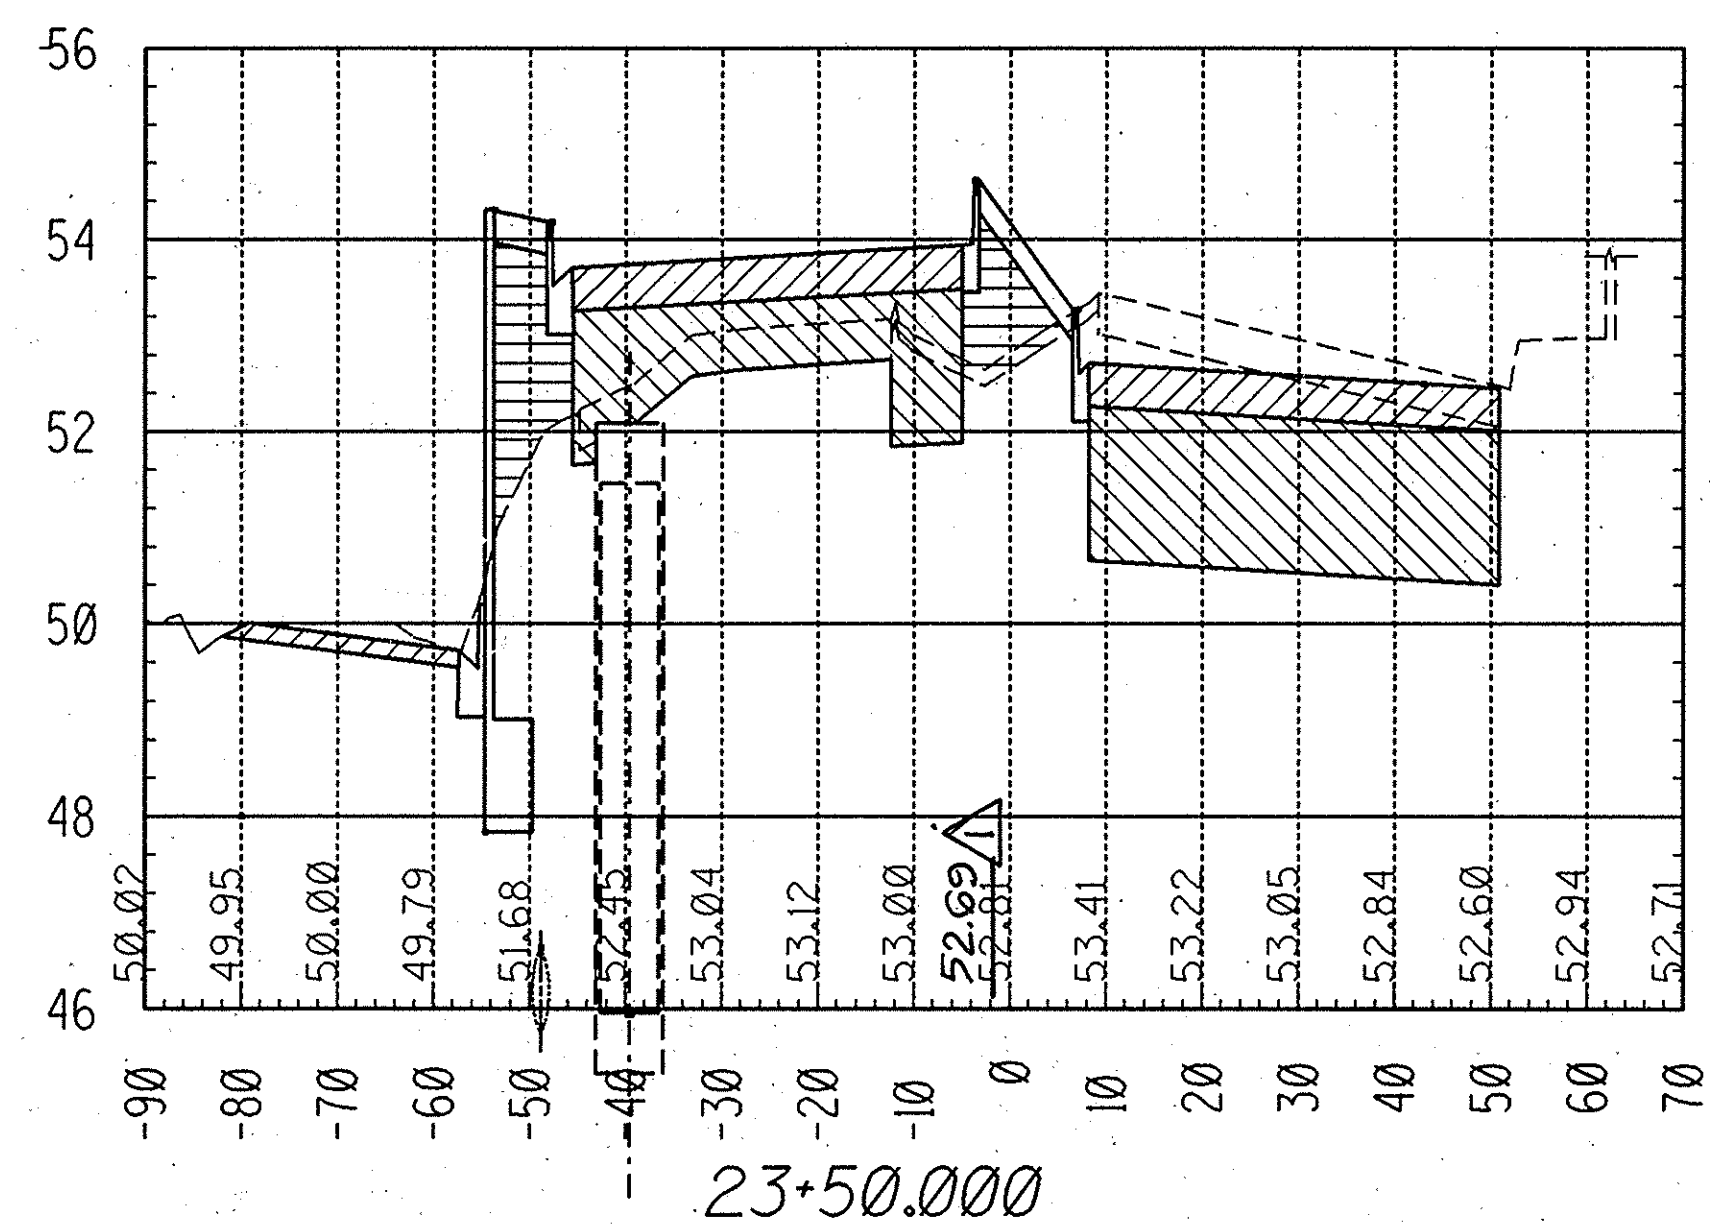
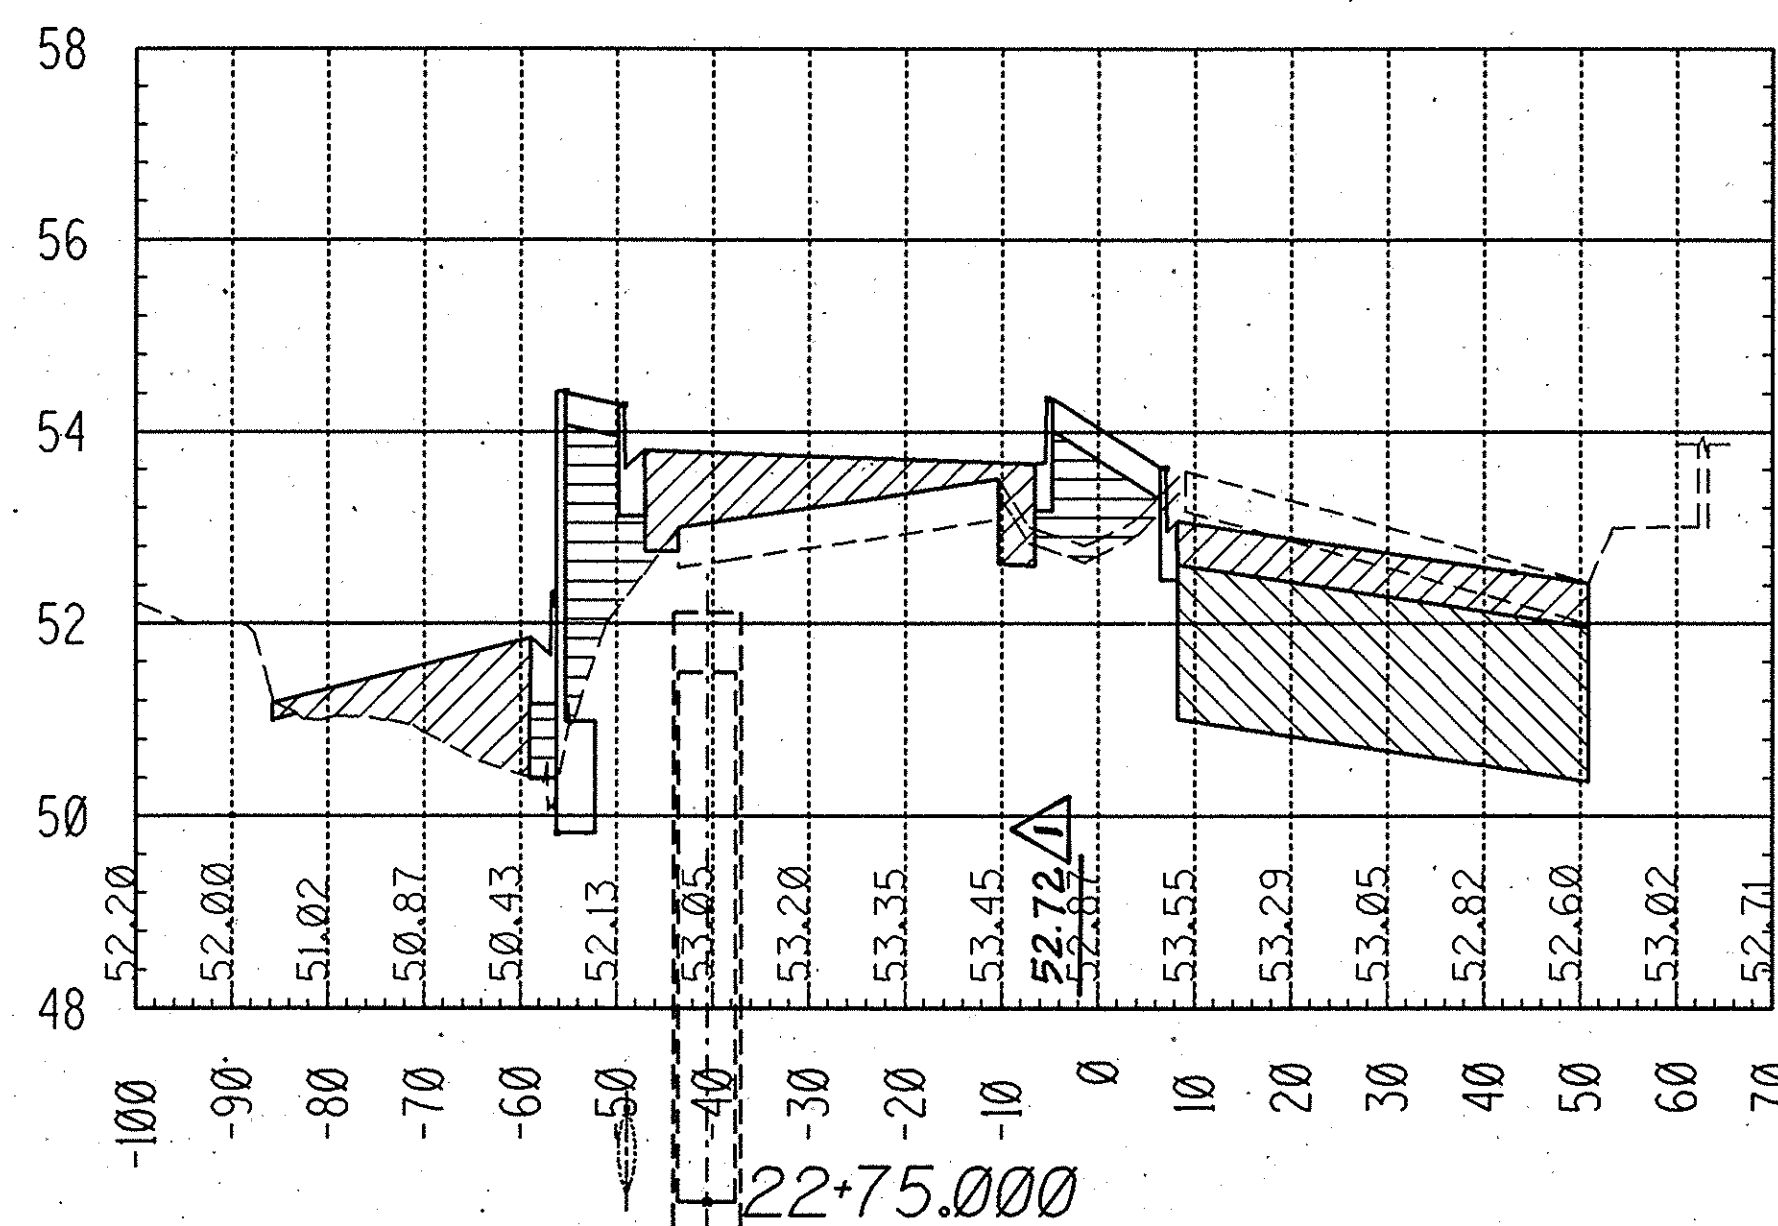
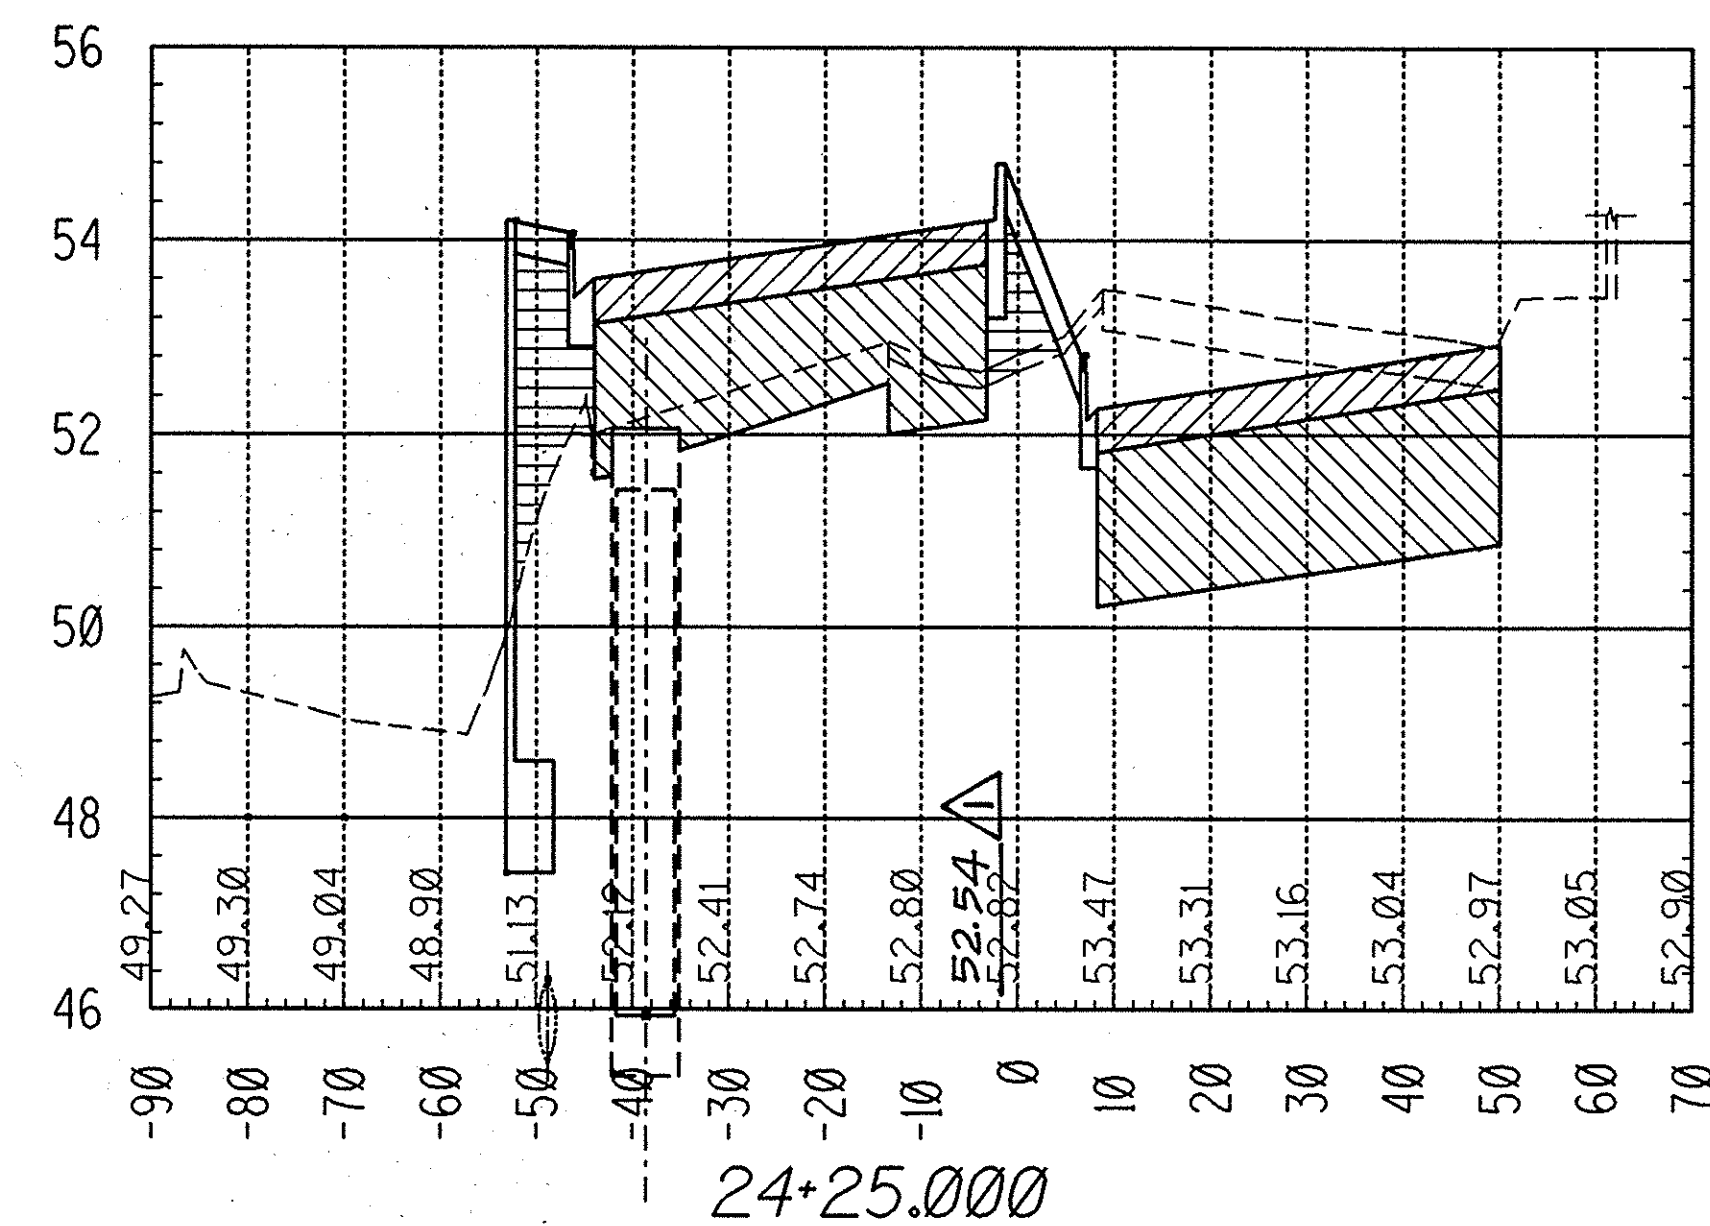
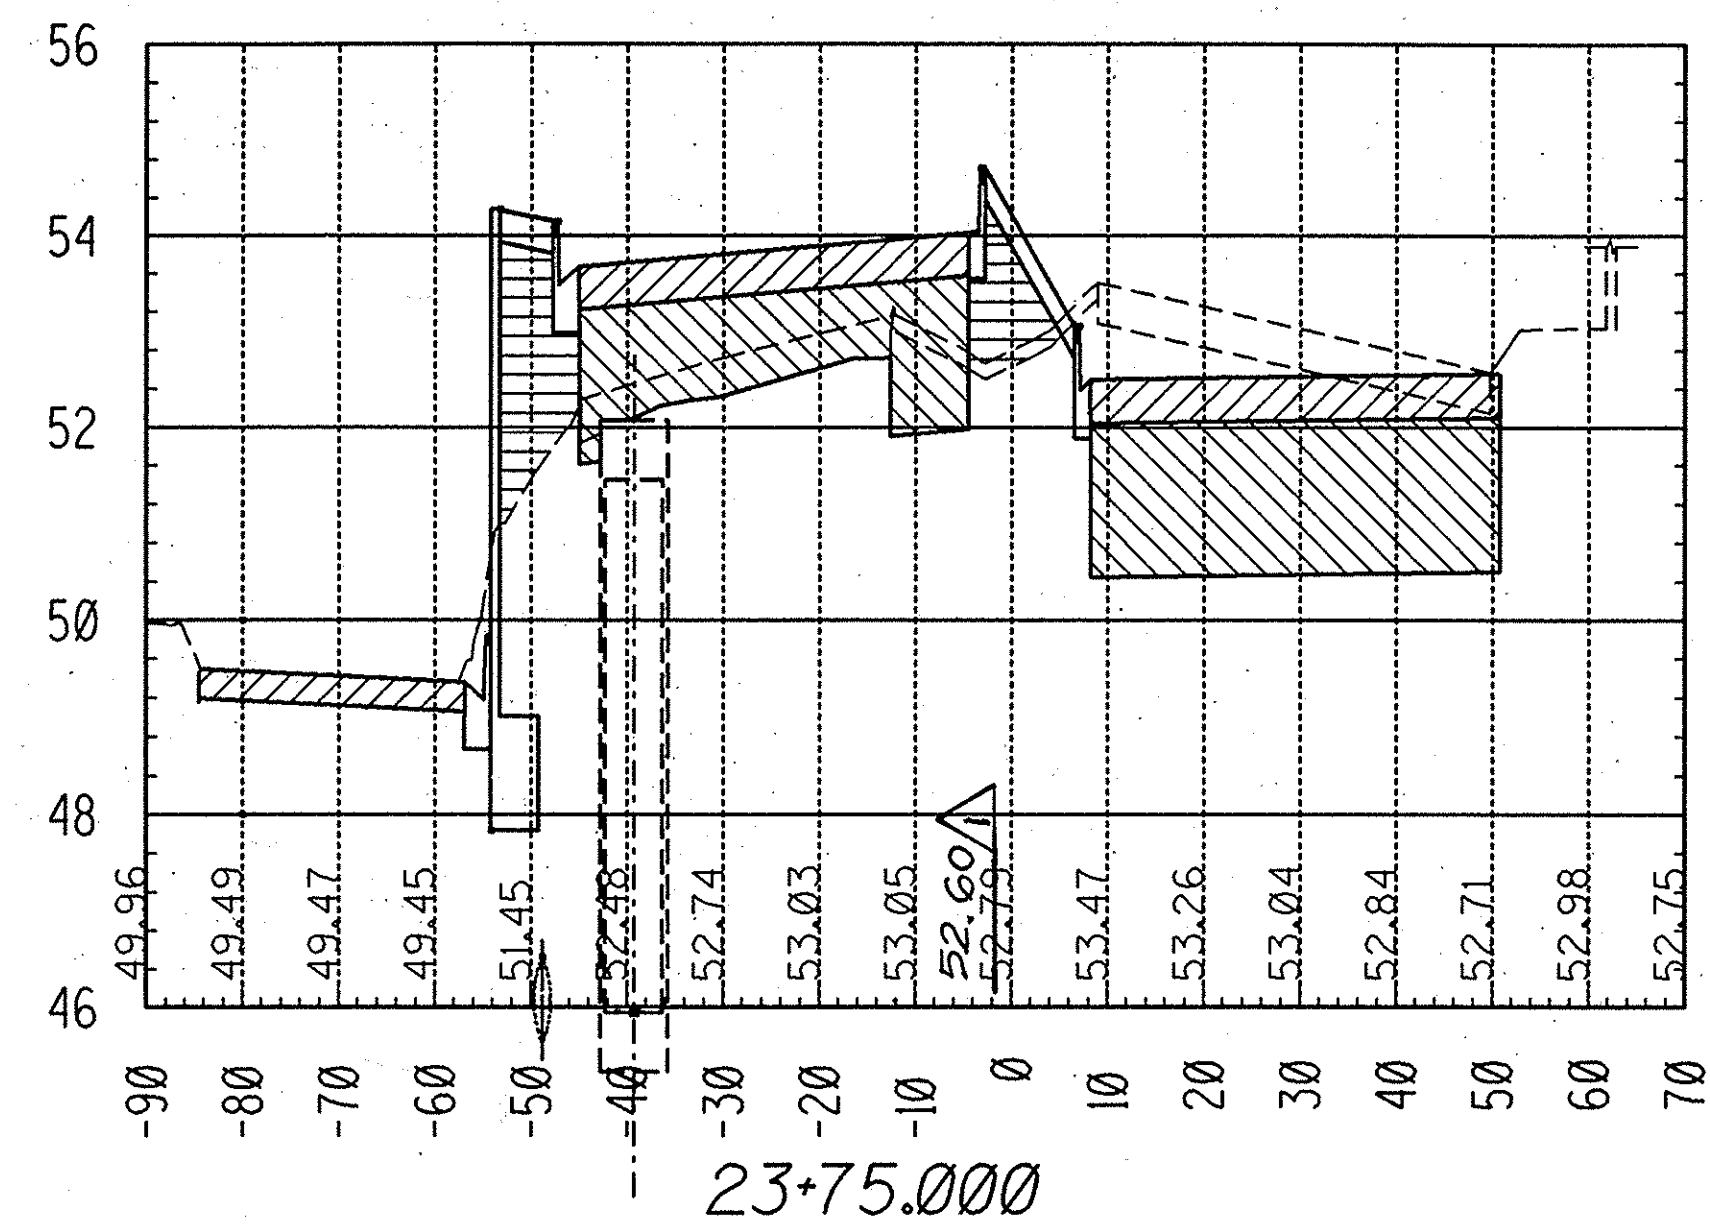


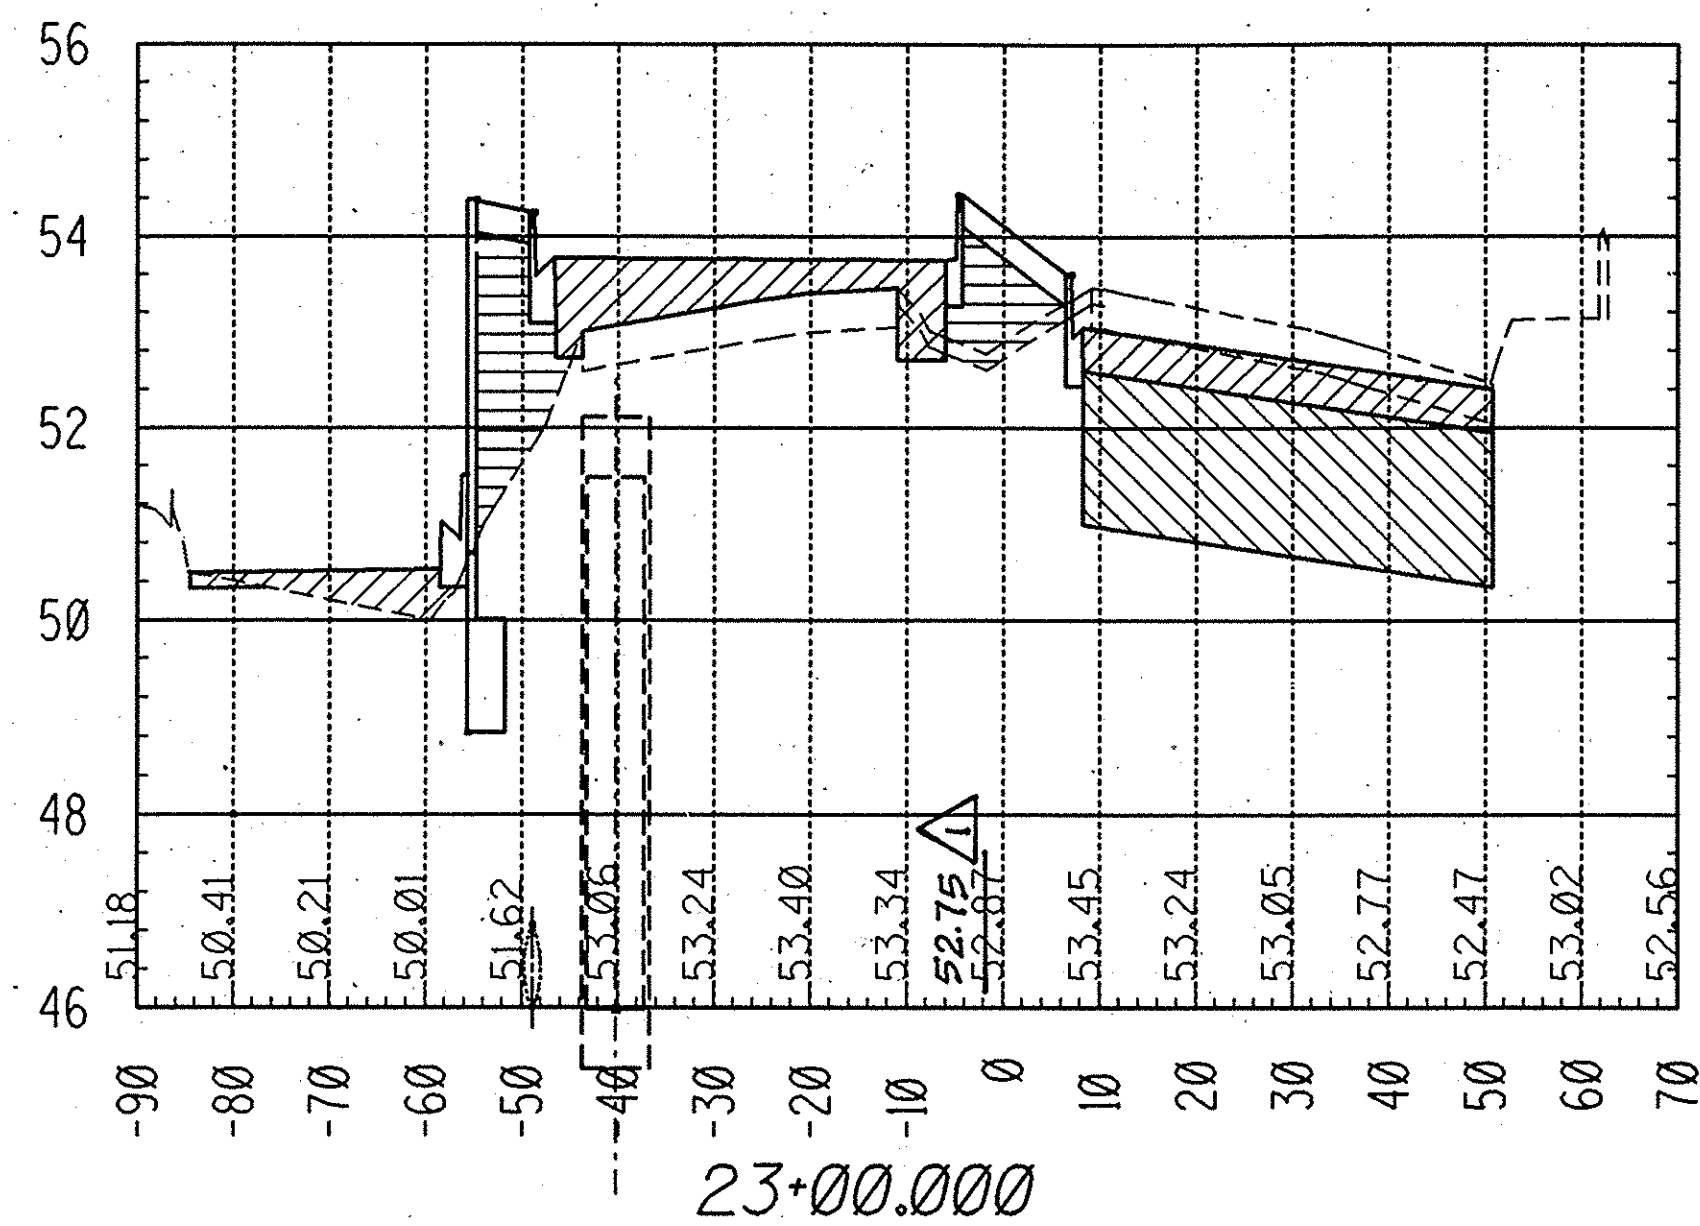

LEGEND

- AGGREGATE BASE MATERIAL
- ASPHALT CONCRETE
- UNCLASSIFIED FILL

PROFILE
HORIZ. 1"=20'
VERT. 1"=2'

3/2 0 2
3 inches on original drawing

ORANGE COUNTY ENVIRONMENTAL MANAGEMENT AGENCY	
HARBOR BLVD. IMPROVEMENTS	
CROSS SECTIONS 22+50 to 24+25	
DESIGNED - RRS	SHEET 46 OF 60
DRAWN - SG/PAN/AHP	CHECKED - RAH
SCALE AS SHOWN	DATE 3-93
DRAWING NO.	

RECORD DRAWING