
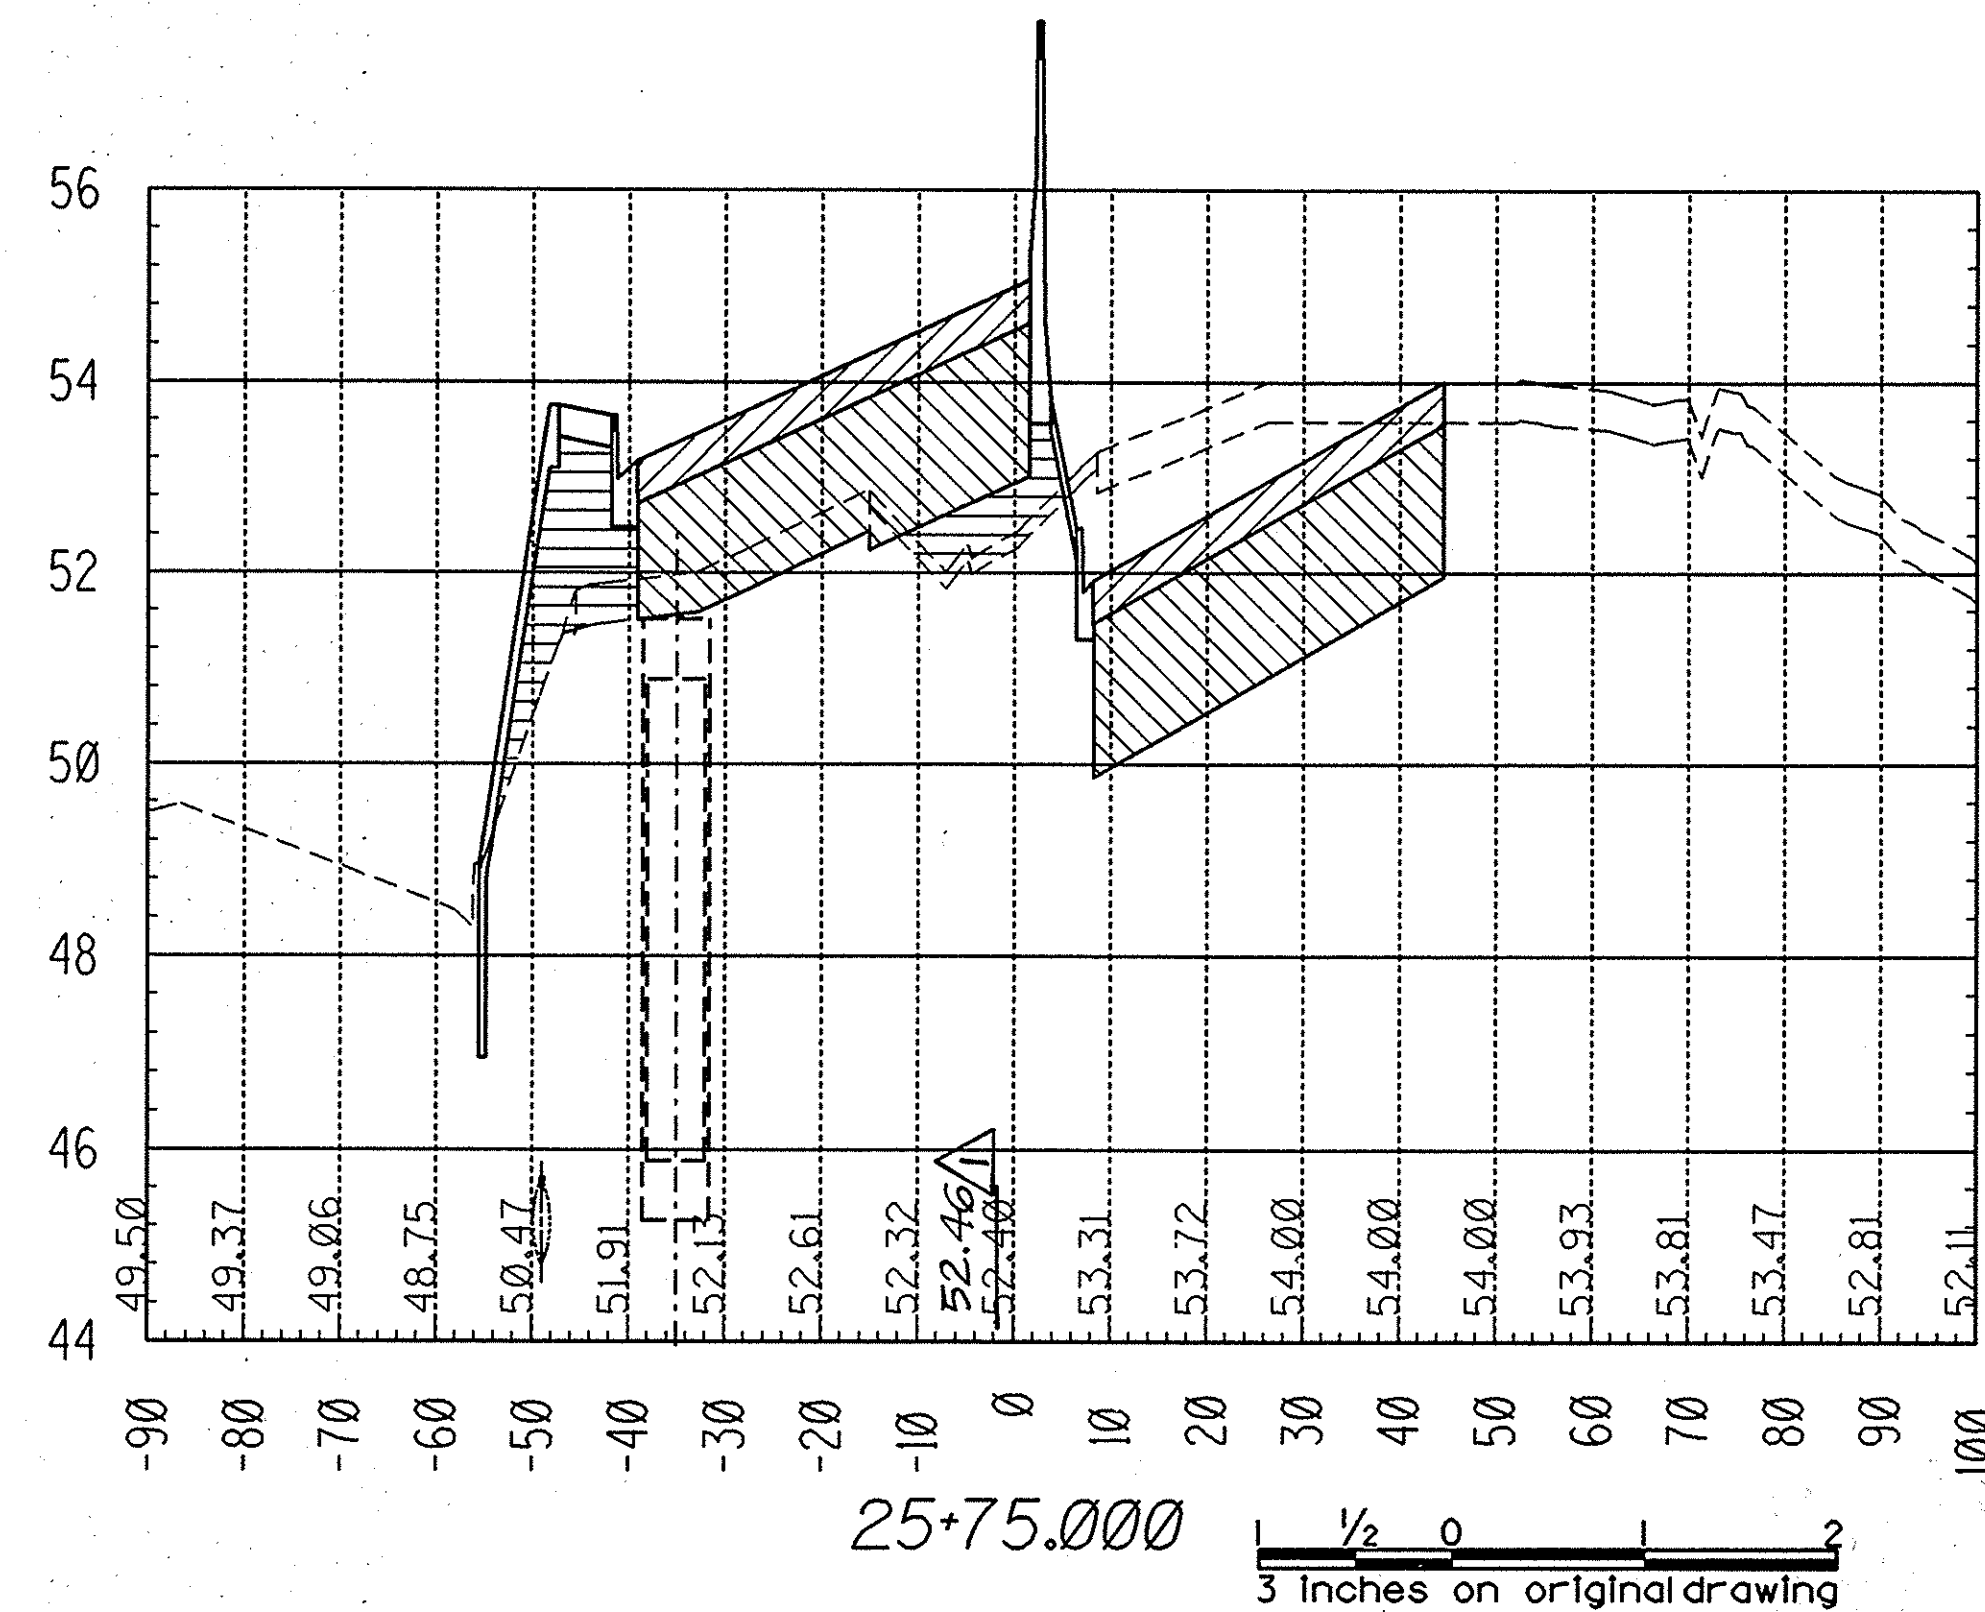
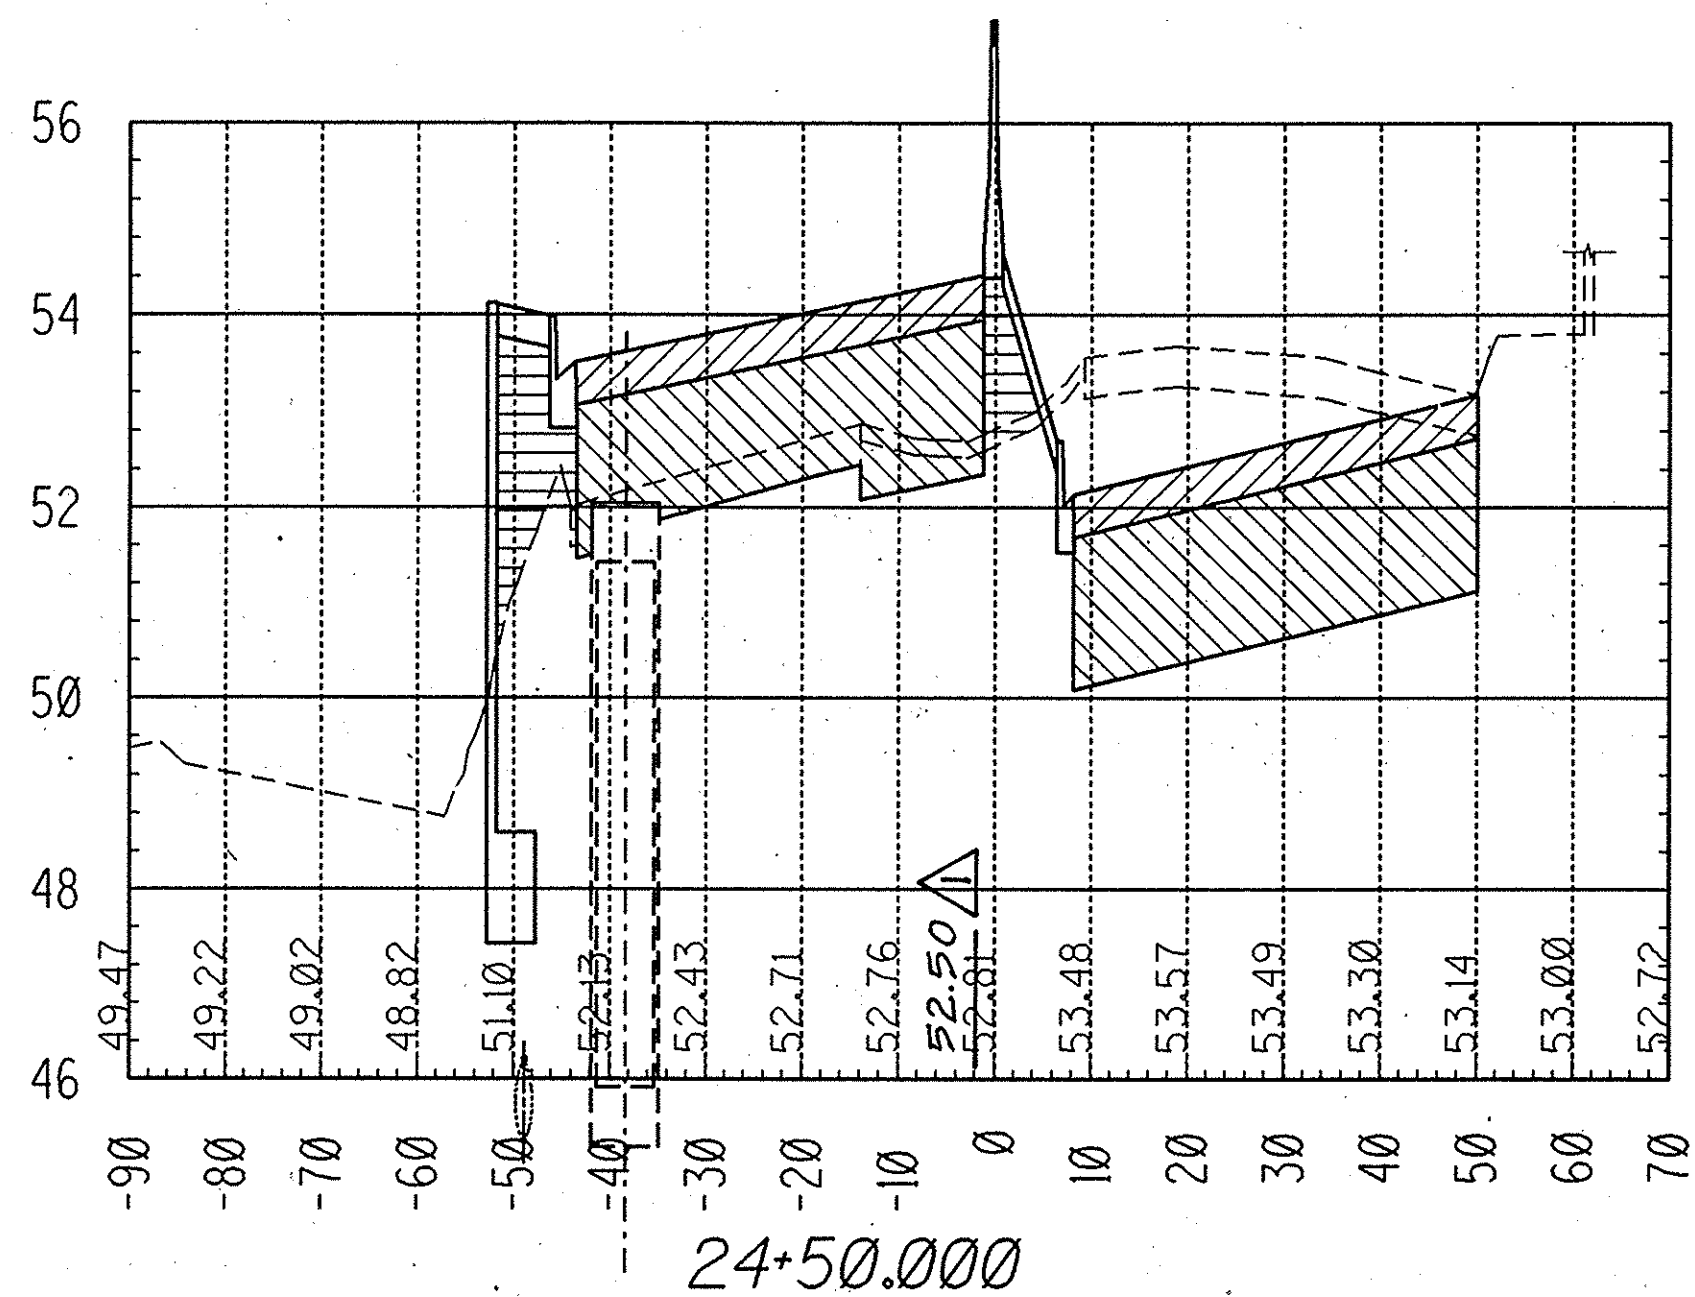
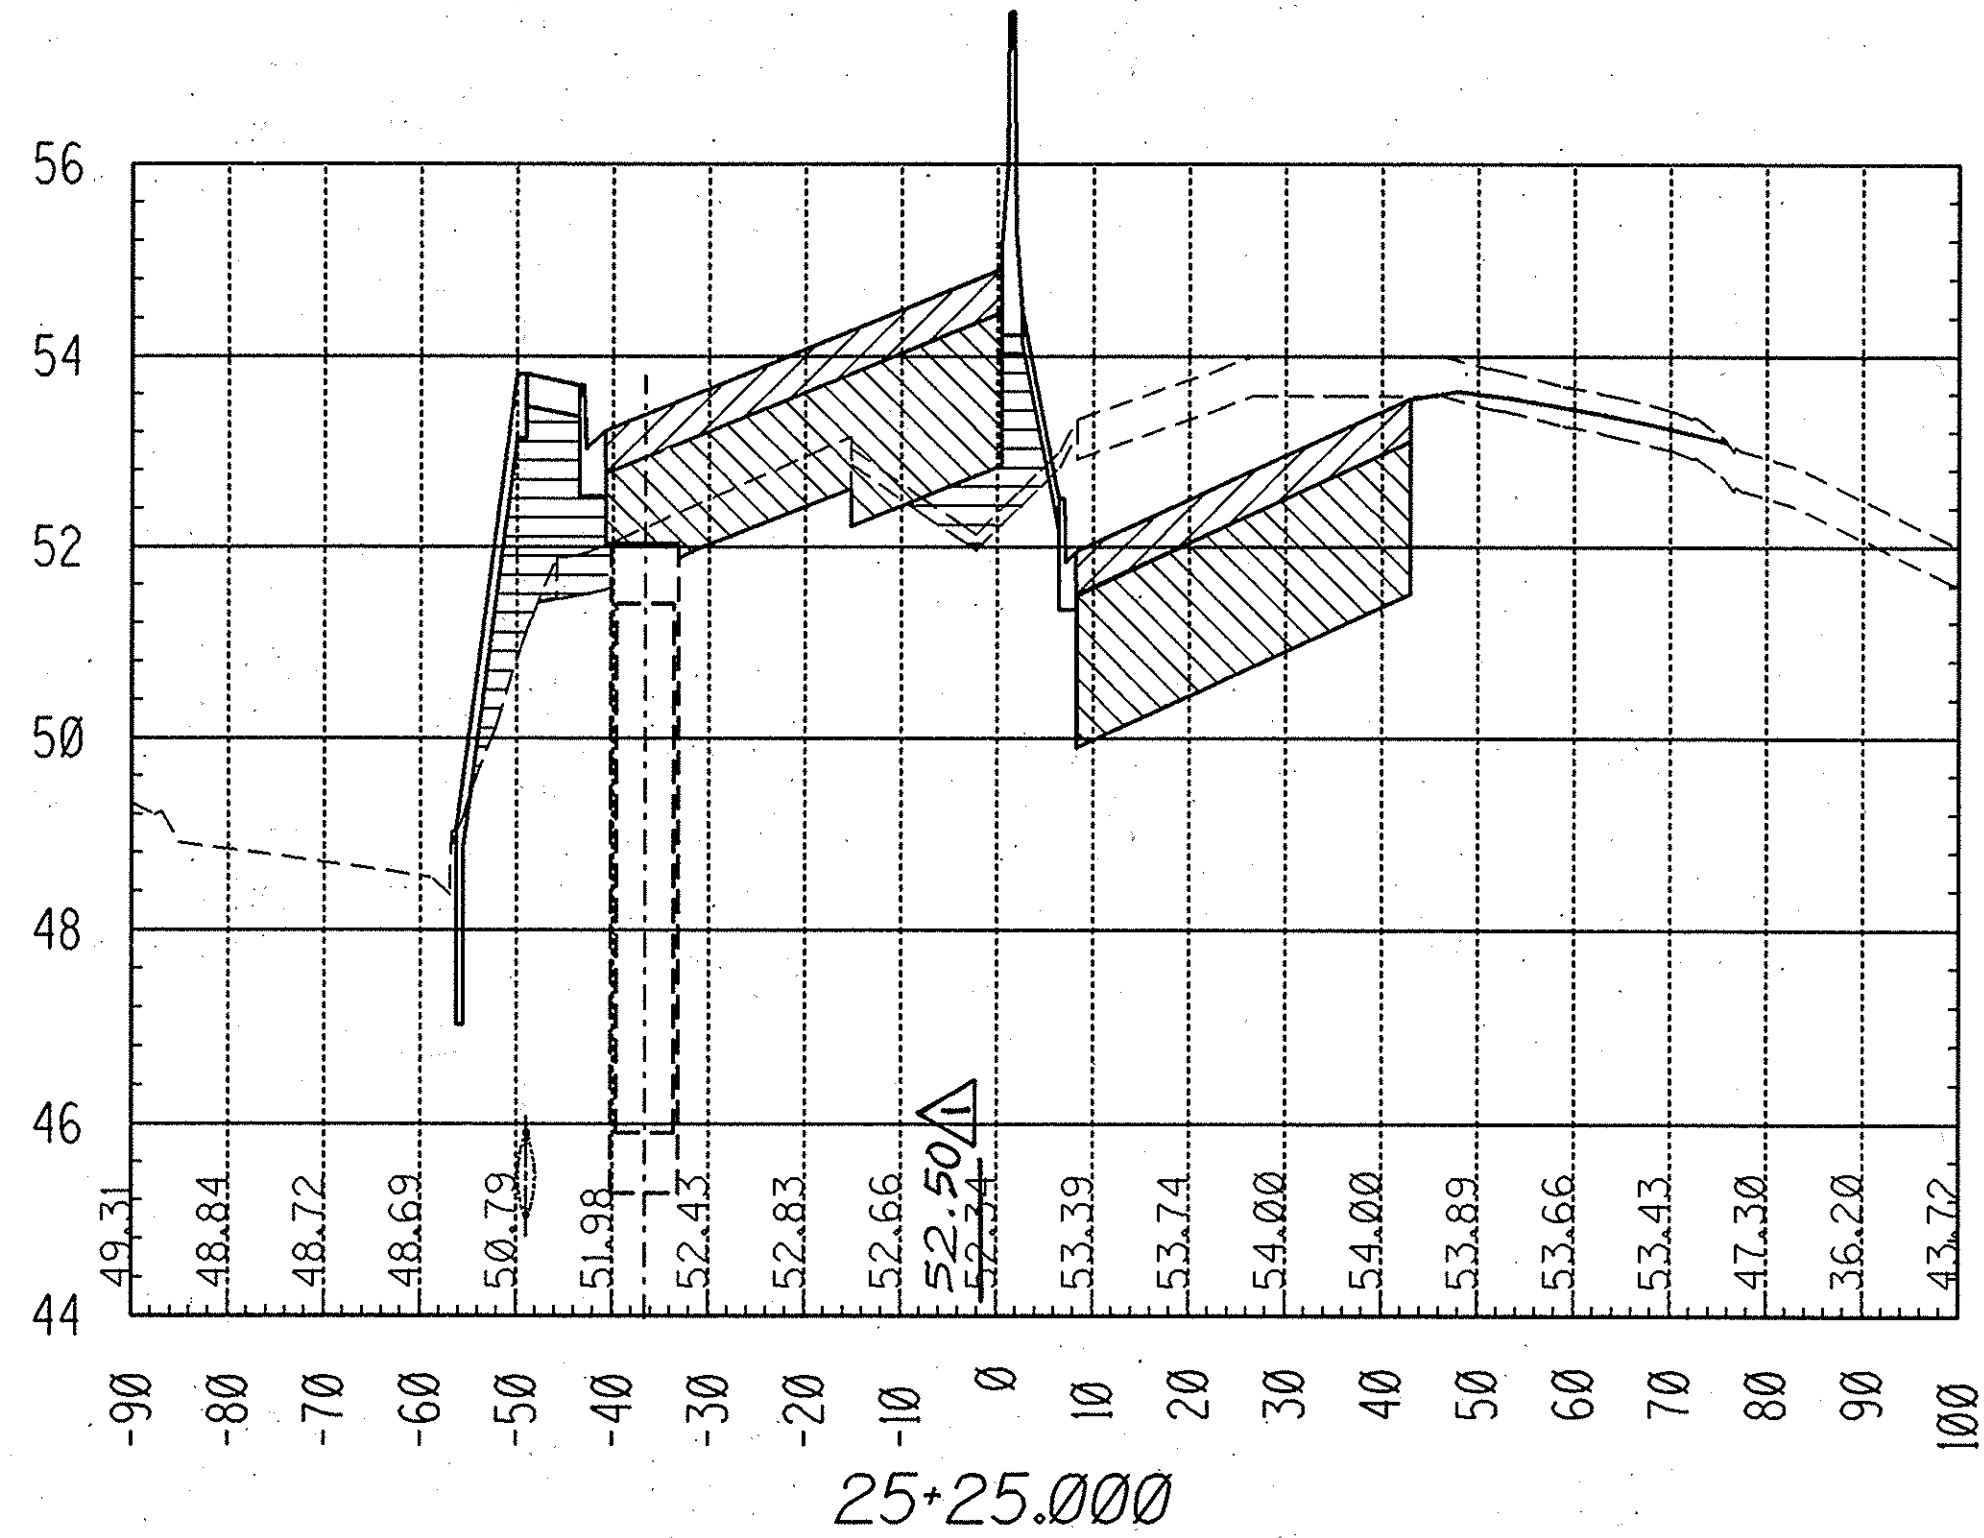
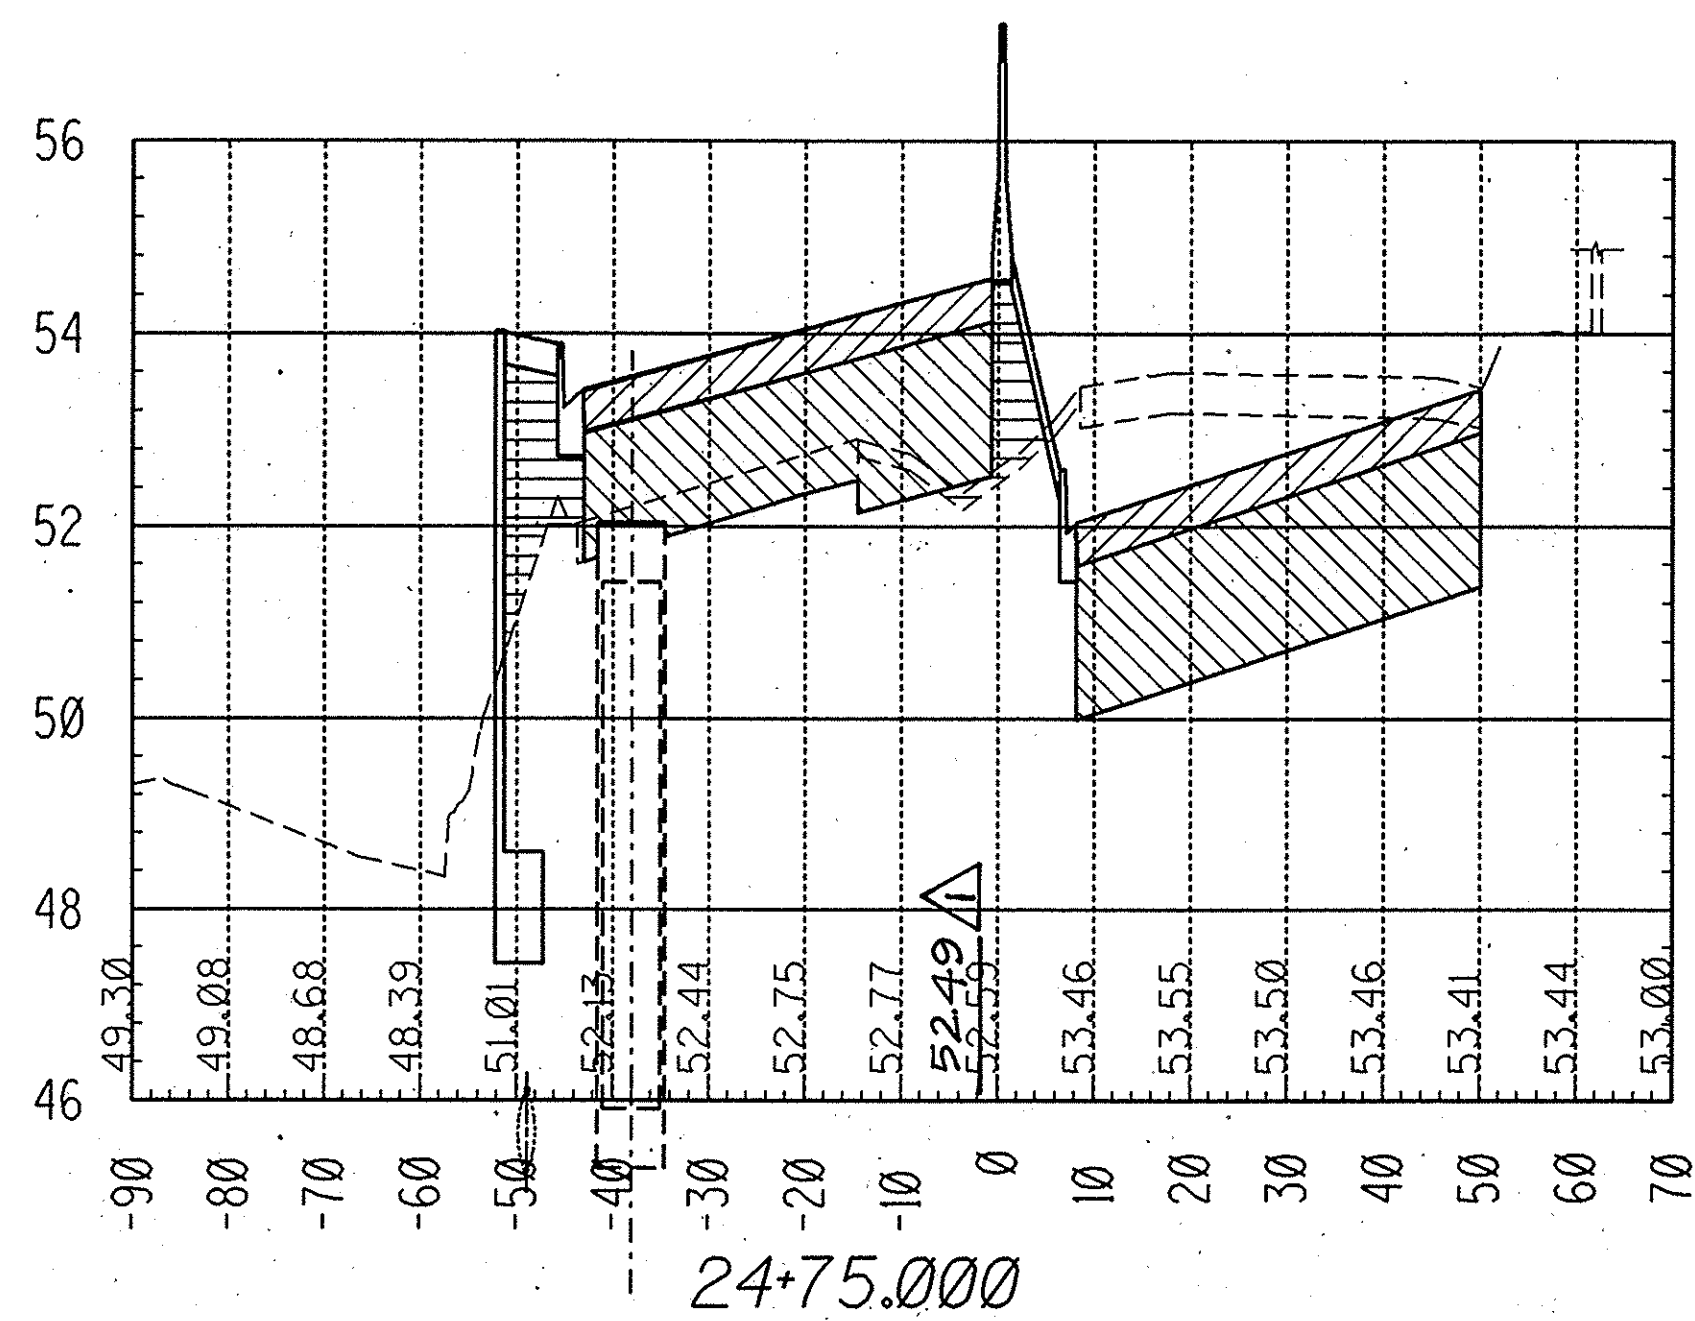
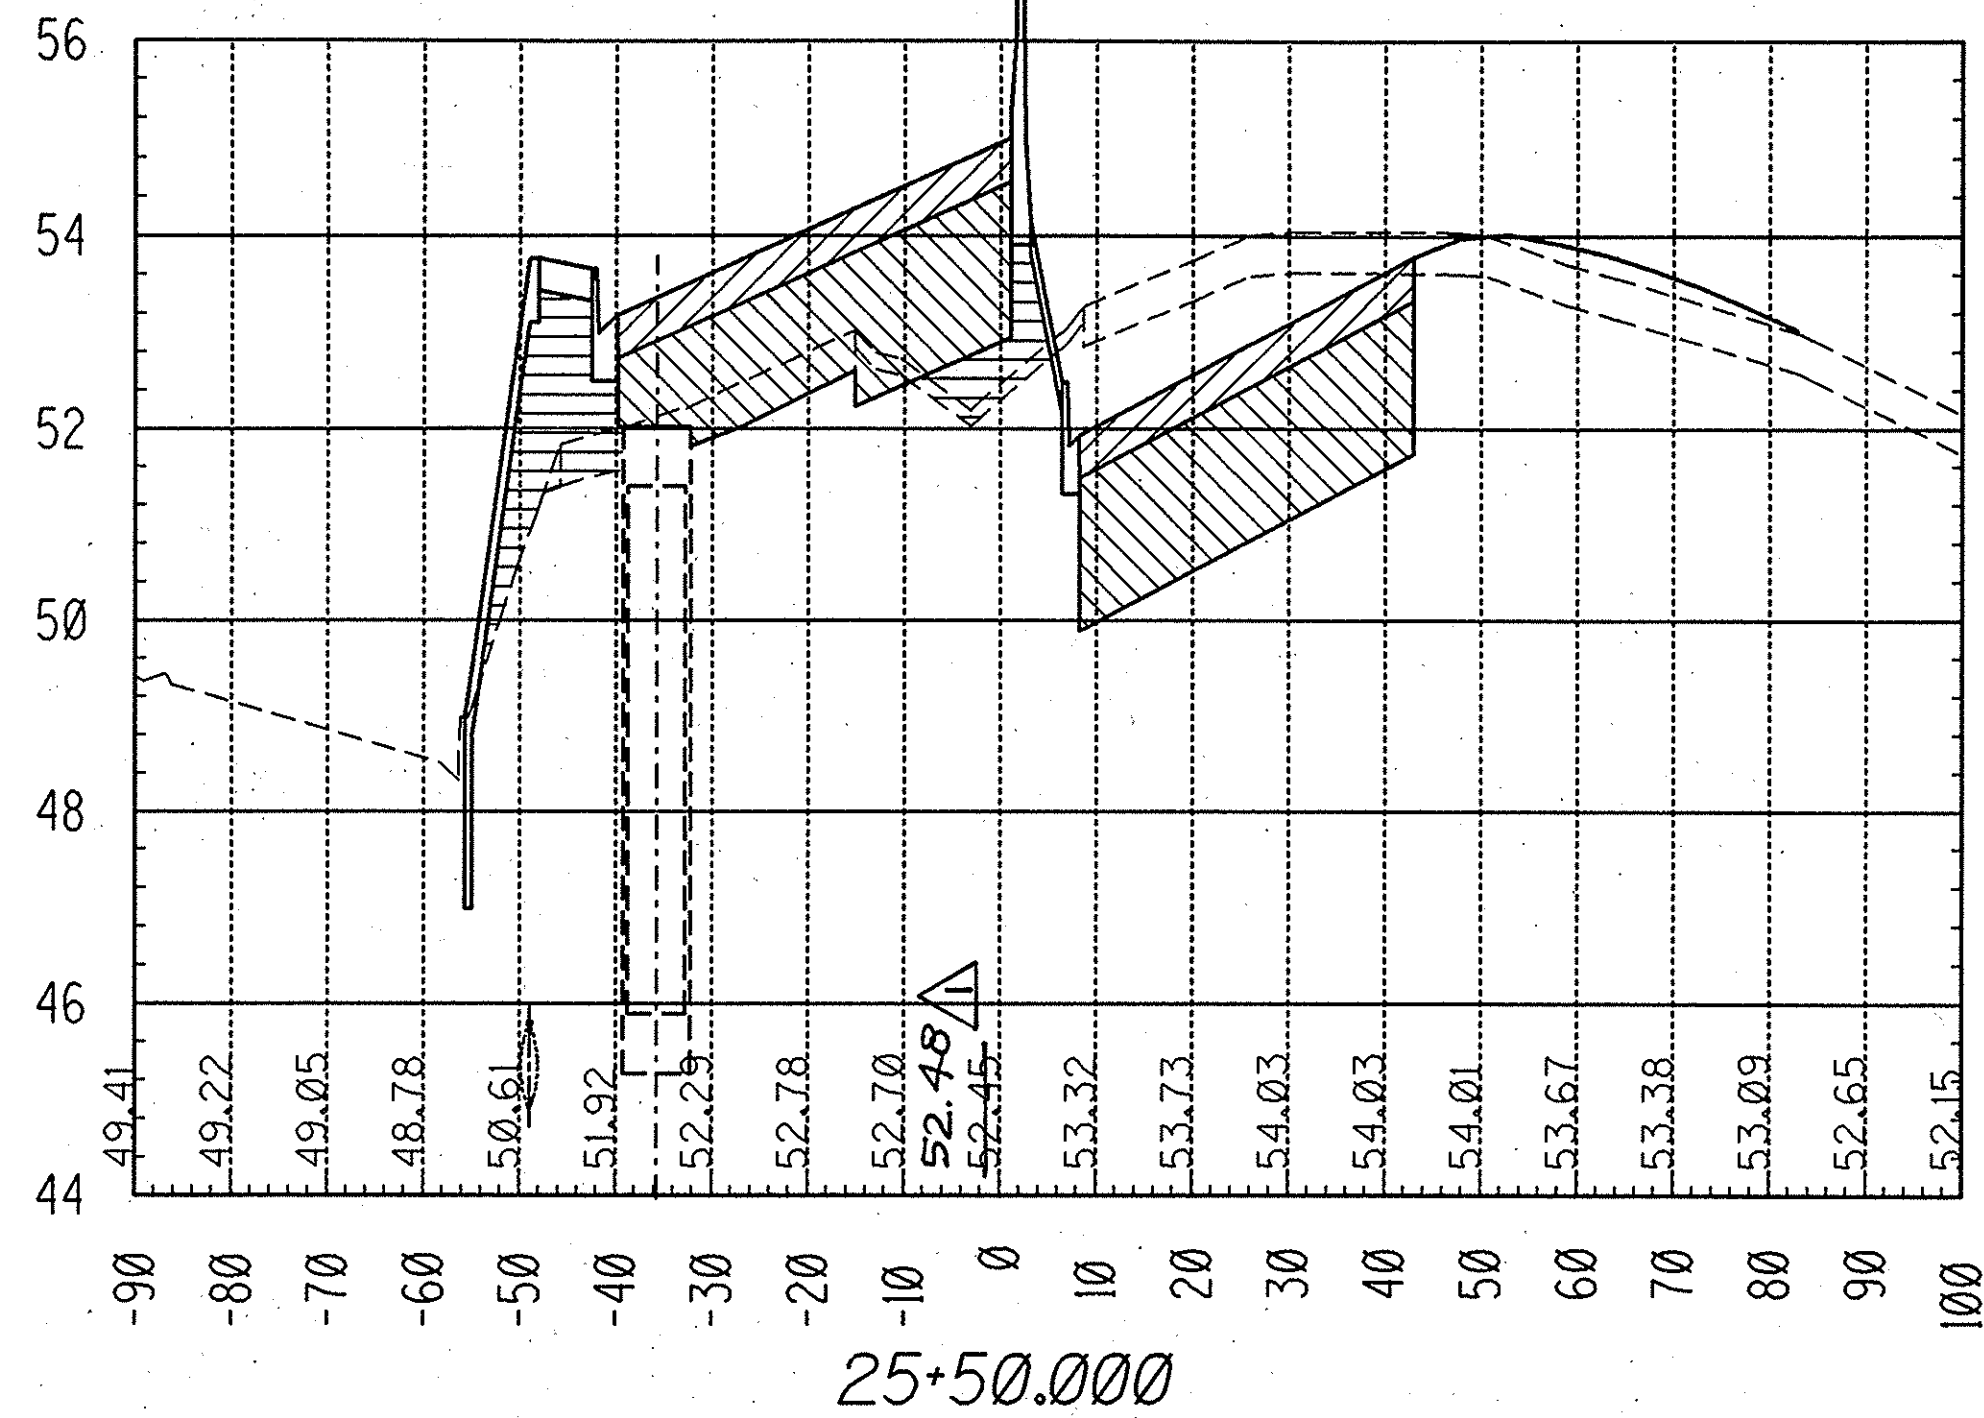


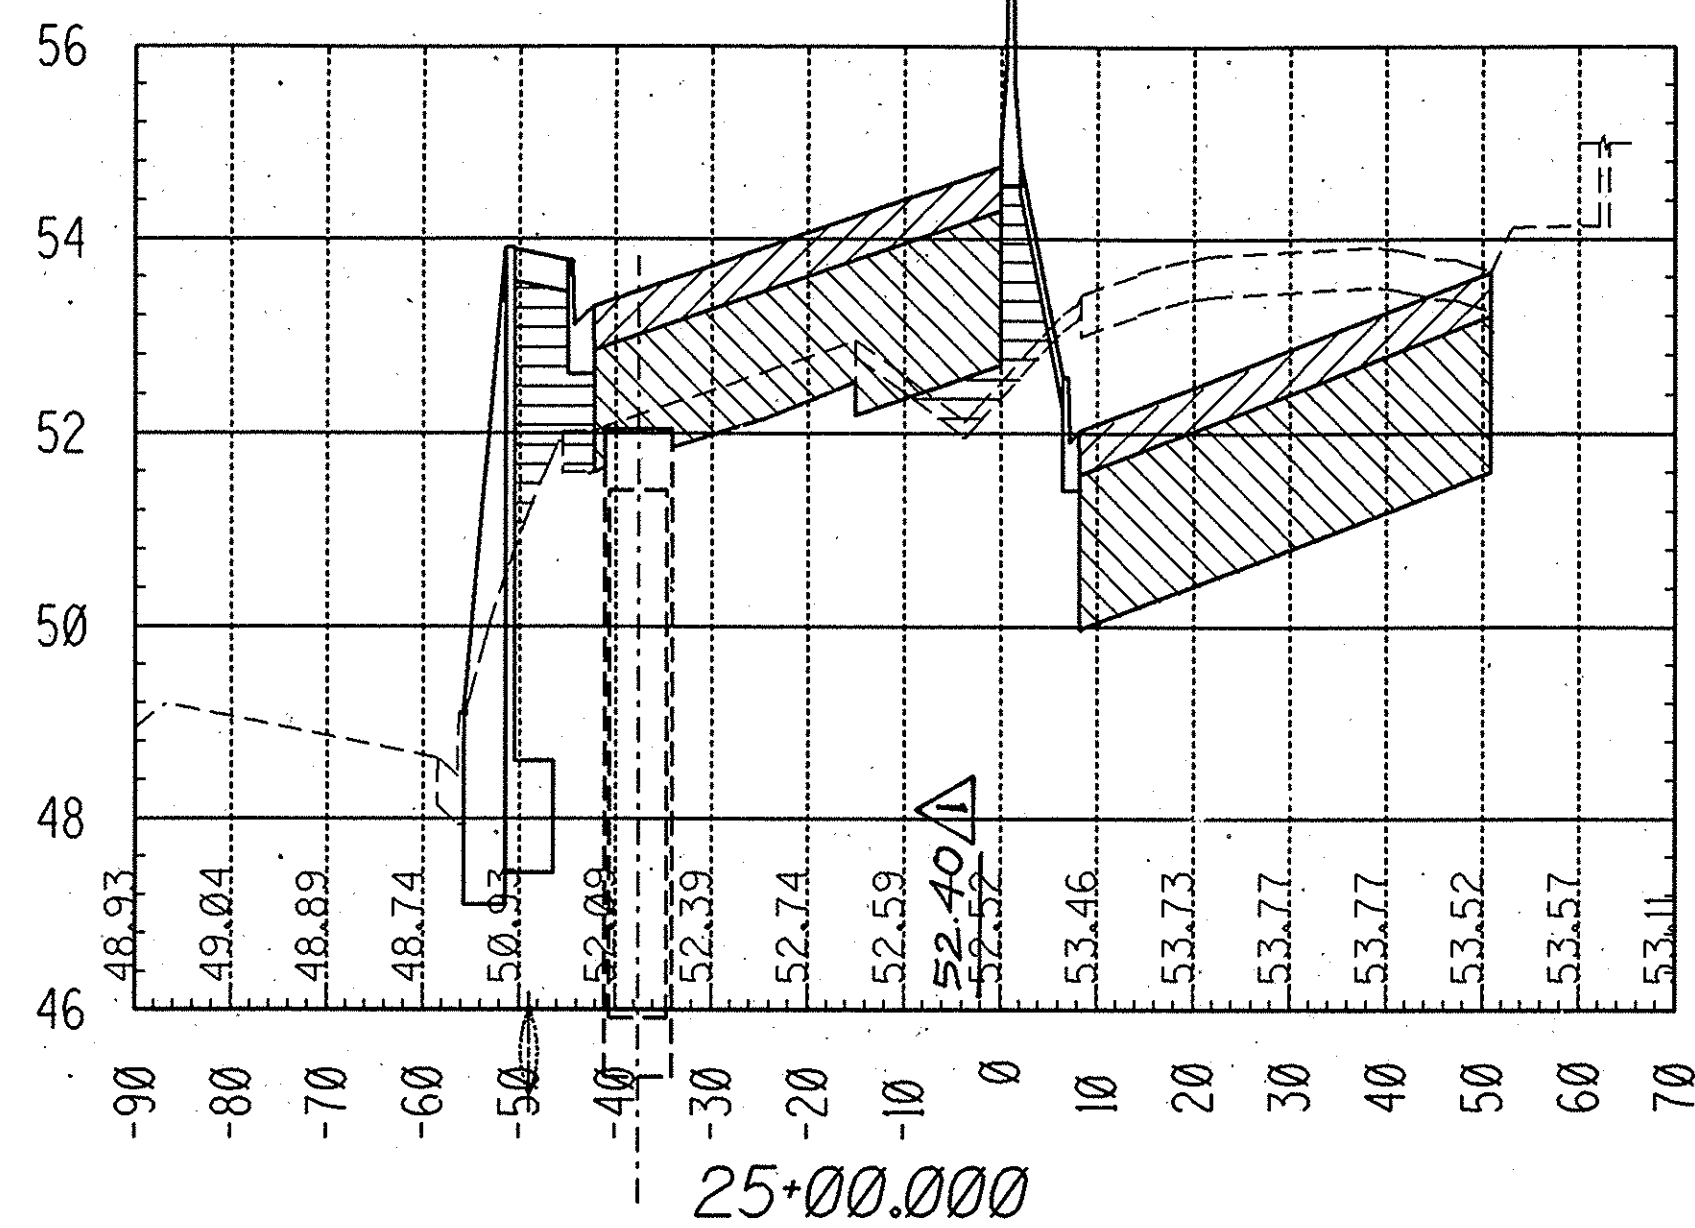

LEGEND

- AGGREGATE BASE MATERIAL
- ASPHALT CONCRETE
- UNCLASSIFIED FILL

PROFILE
HORIZ. 1"=20'
VERT. 1"=2'

RECORD DRAWING

ORANGE COUNTY ENVIRONMENTAL MANAGEMENT AGENCY	
HARBOR BLVD. IMPROVEMENTS	
CROSS SECTIONS 24+50 to 25+75	
DESIGNED - RRS	CHECKED - RAH
DRAWN - SG/PAN/AHP	DATE 3-93
SCALE AS SHOWN	DRAWING NO.
PREPARED UNDER RICHARD HARRIS RCE 39595 (exp: 12-31-93)	DATE 3/4/93
SHEET 47 OF 60	