




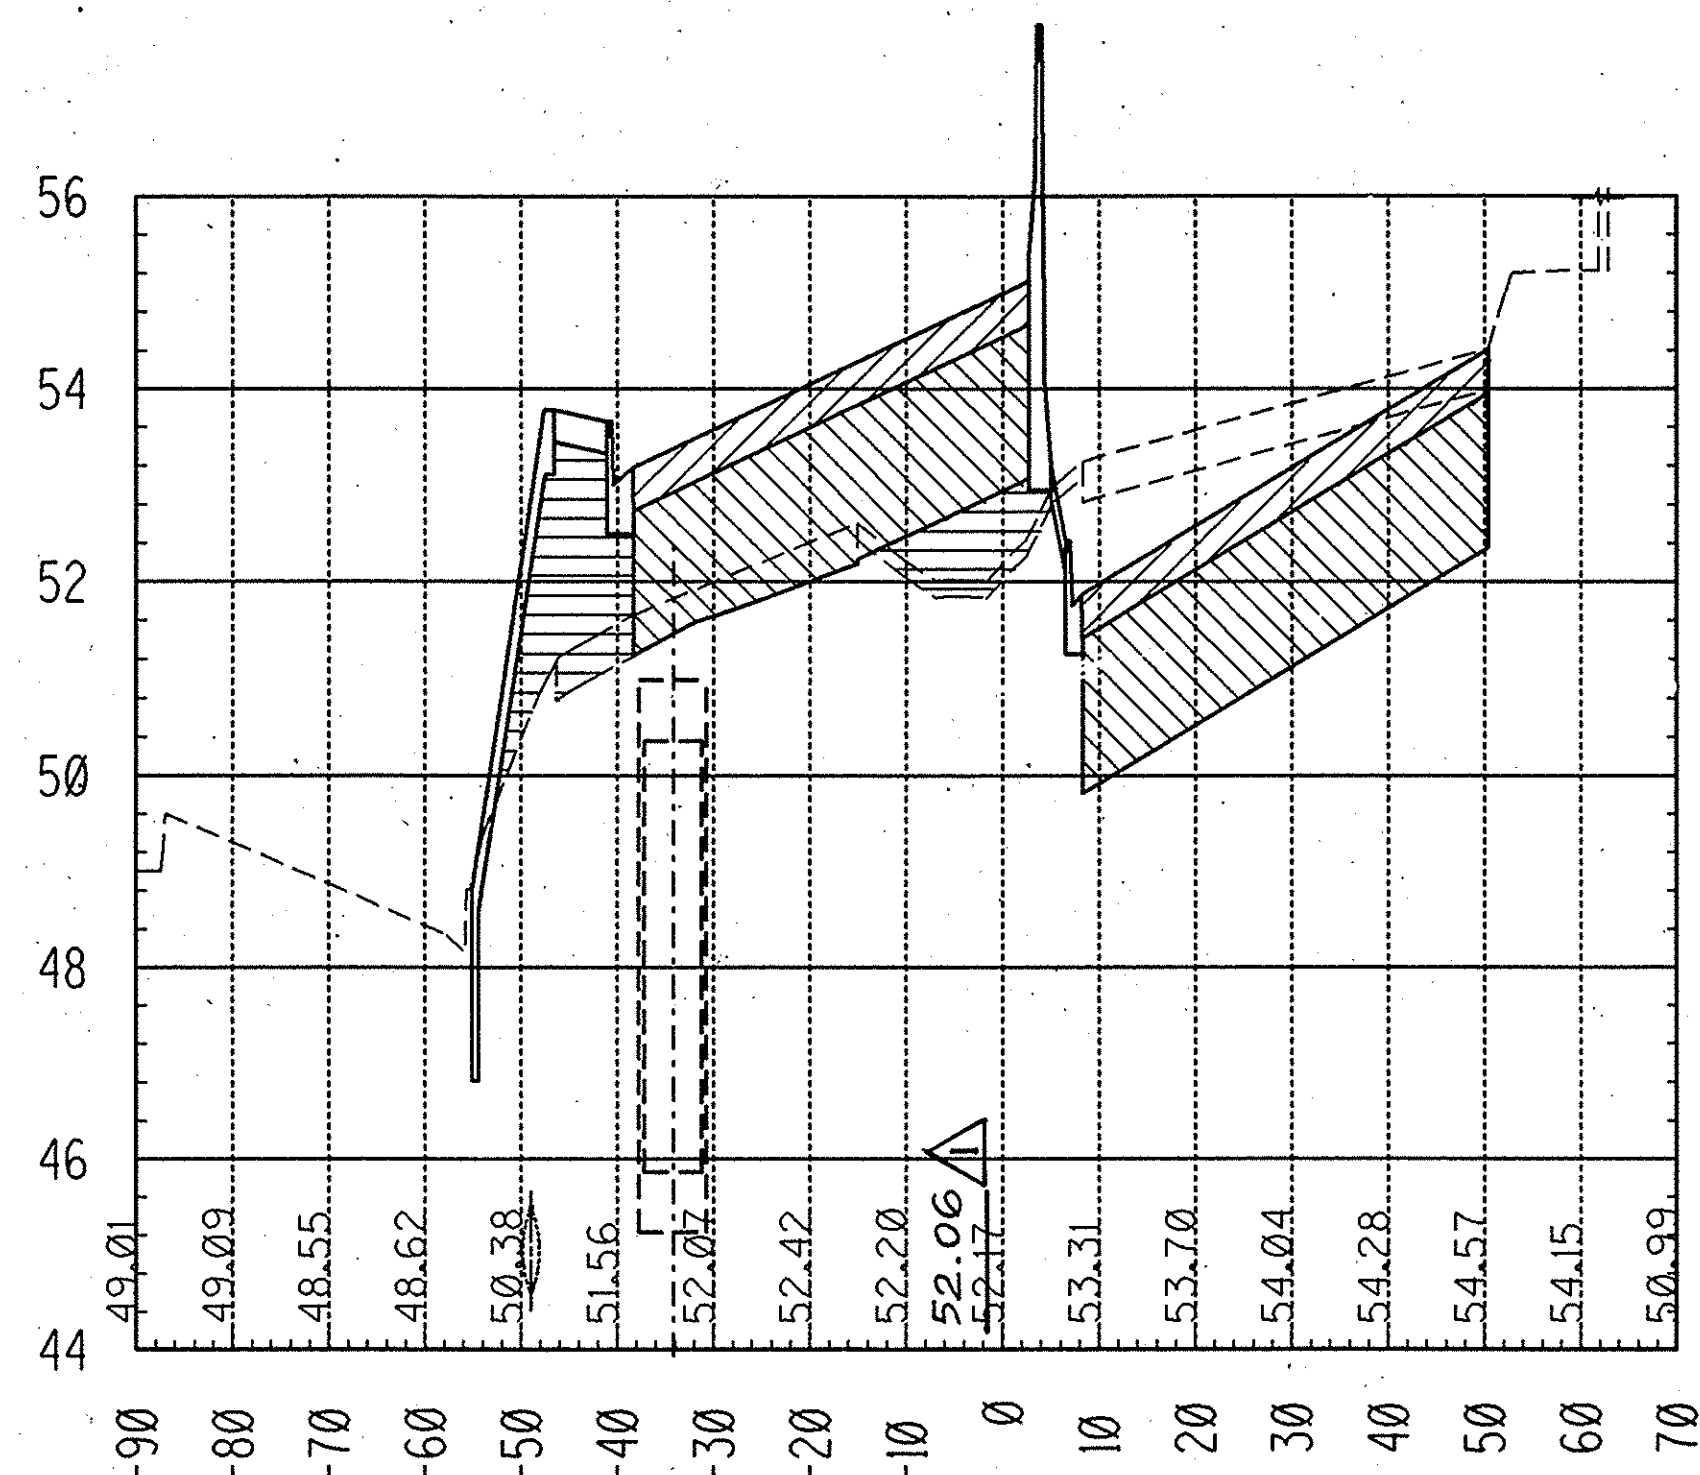


26+25.000

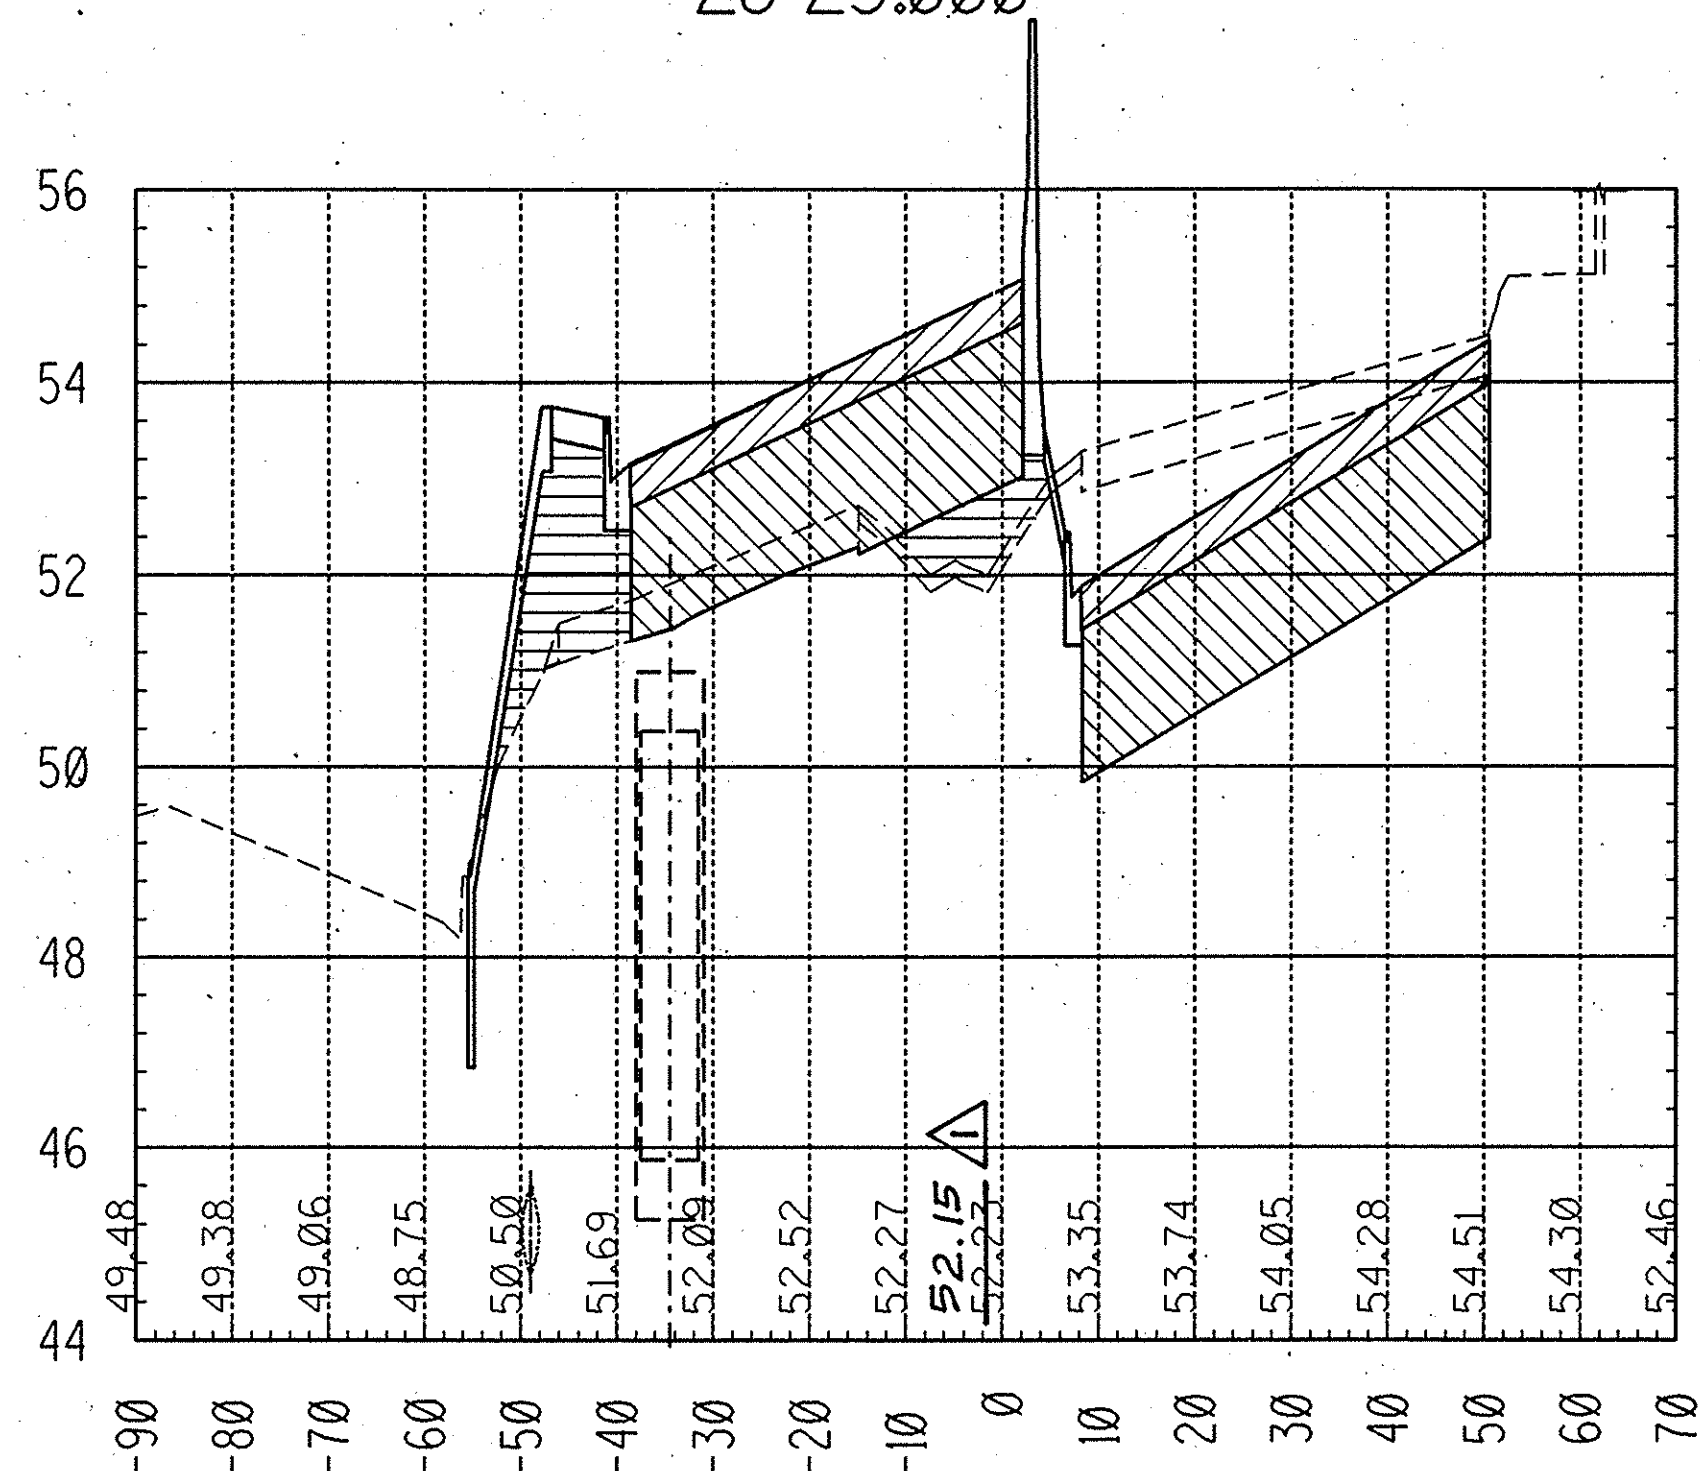


26+00.000

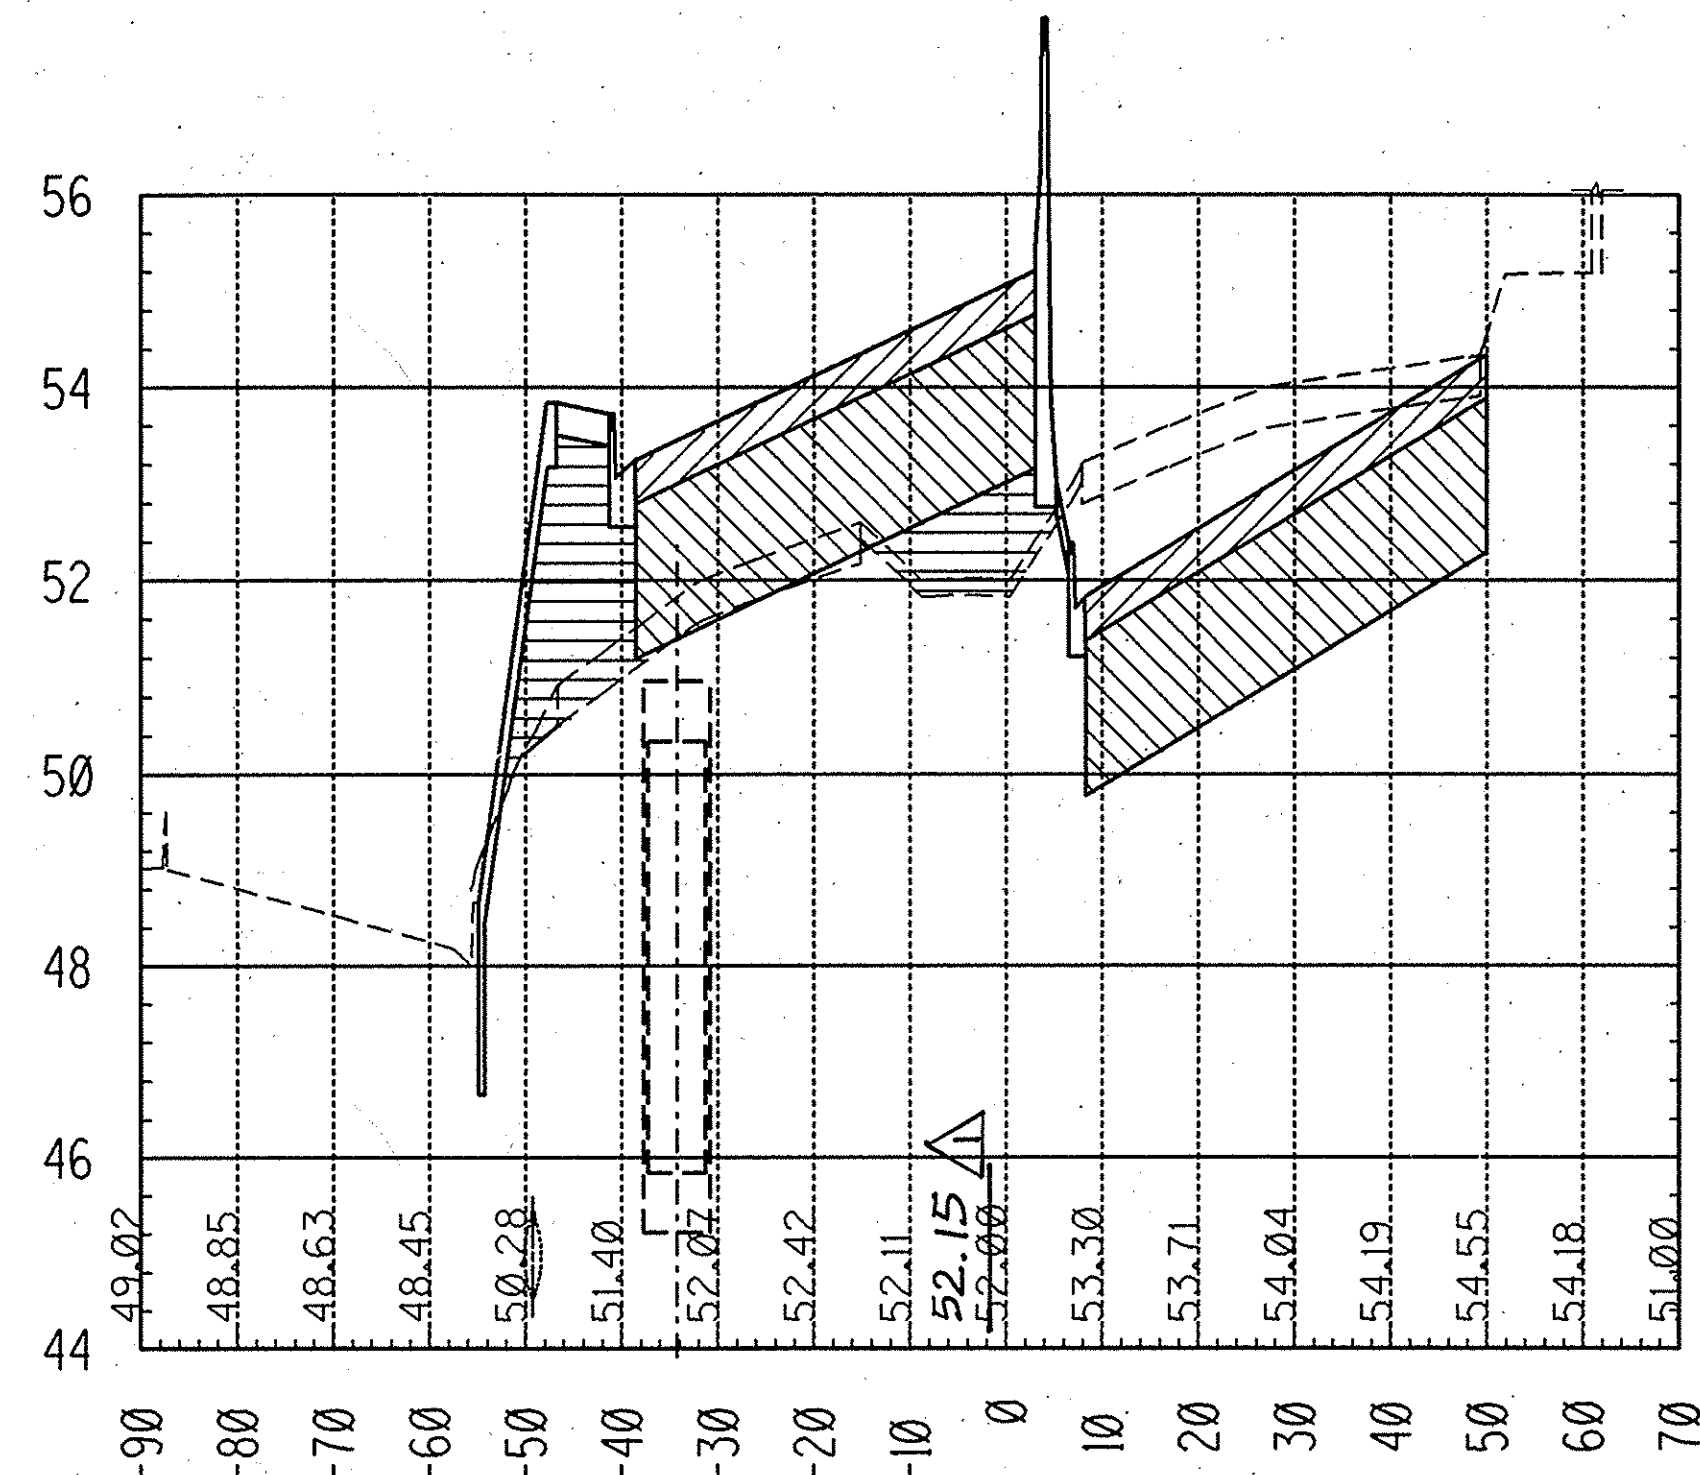


26+75.000

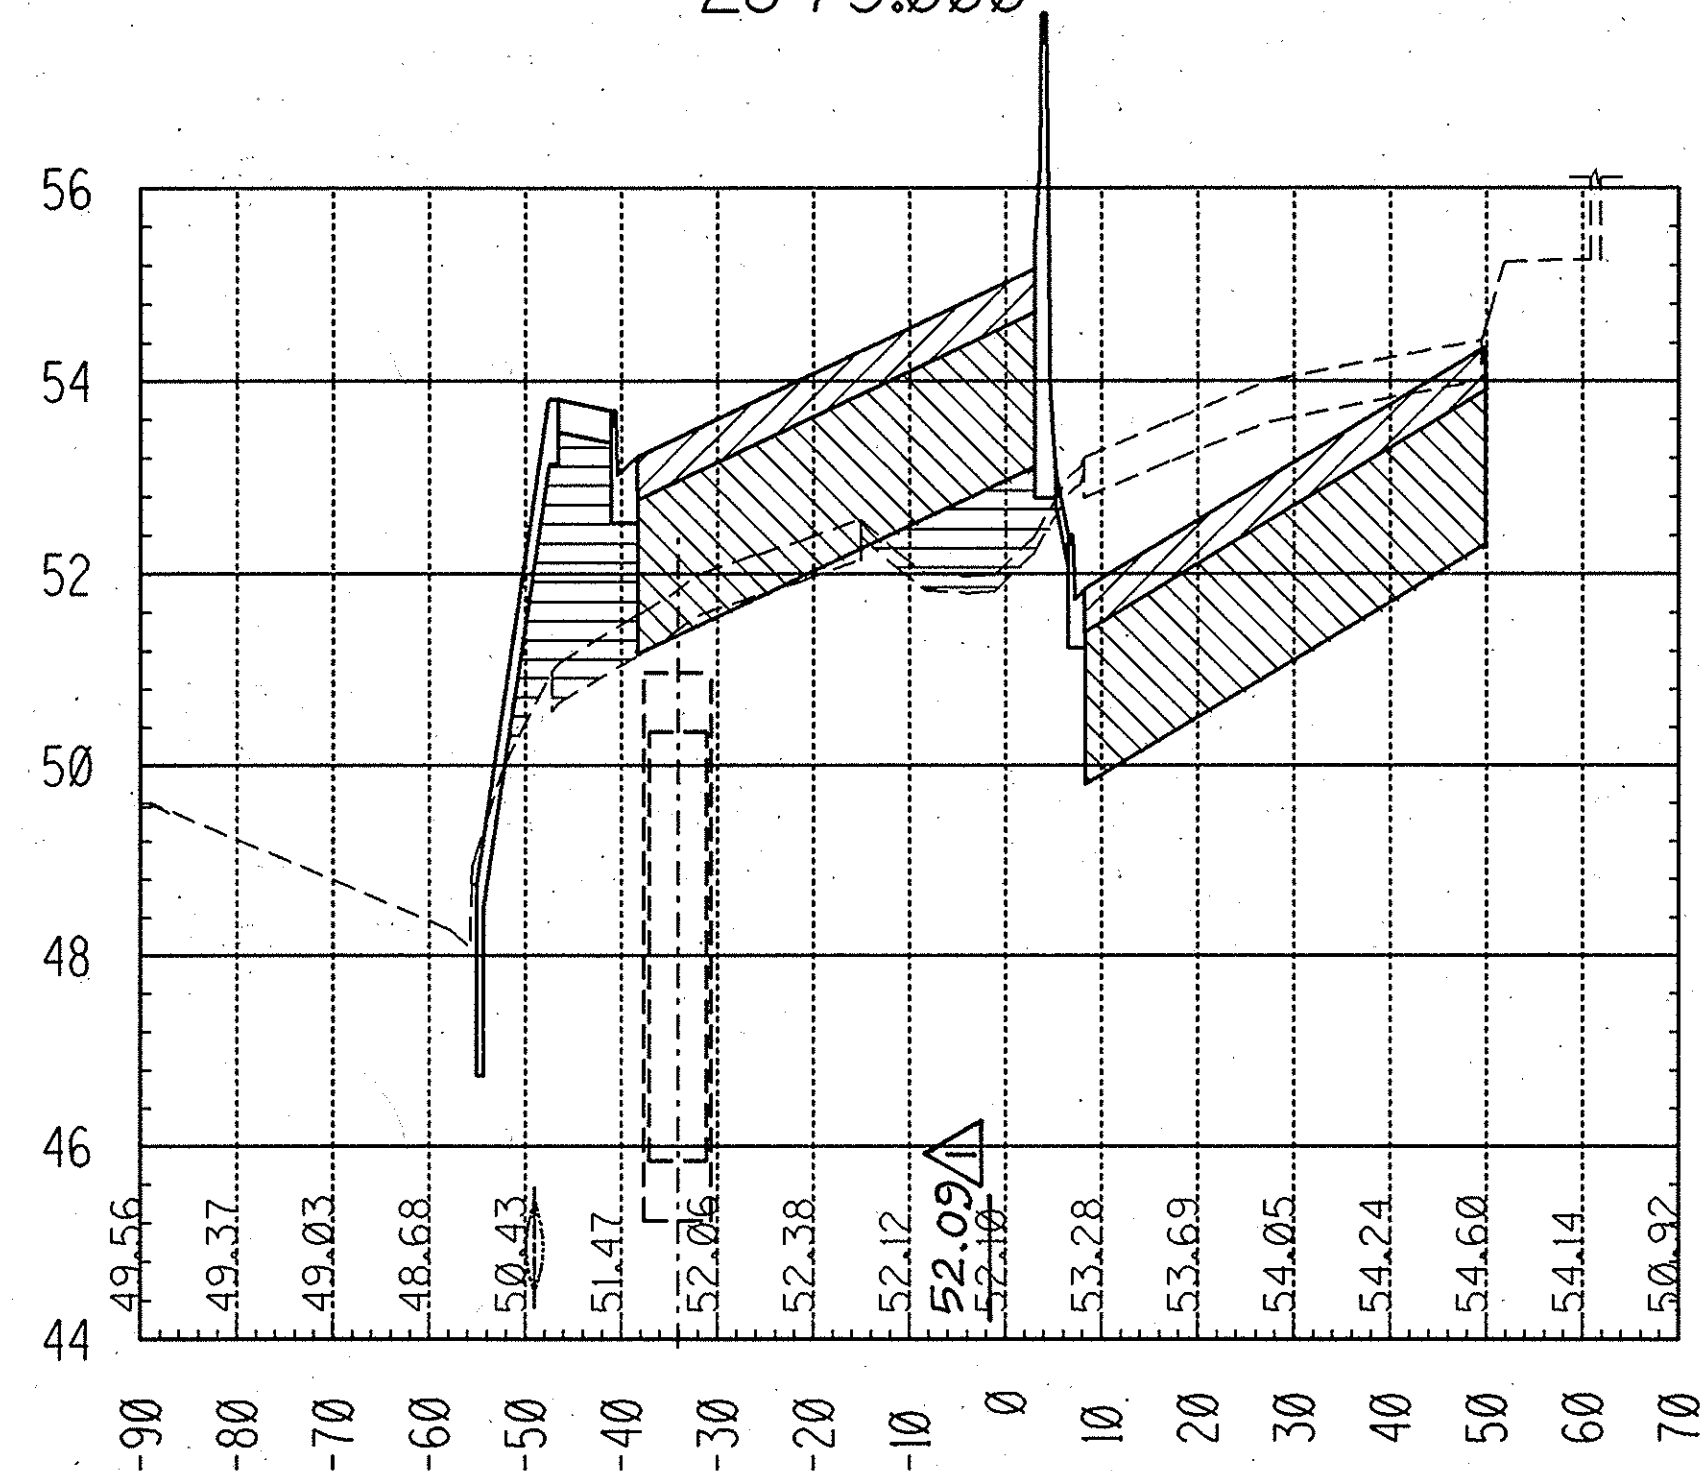

26+50.000

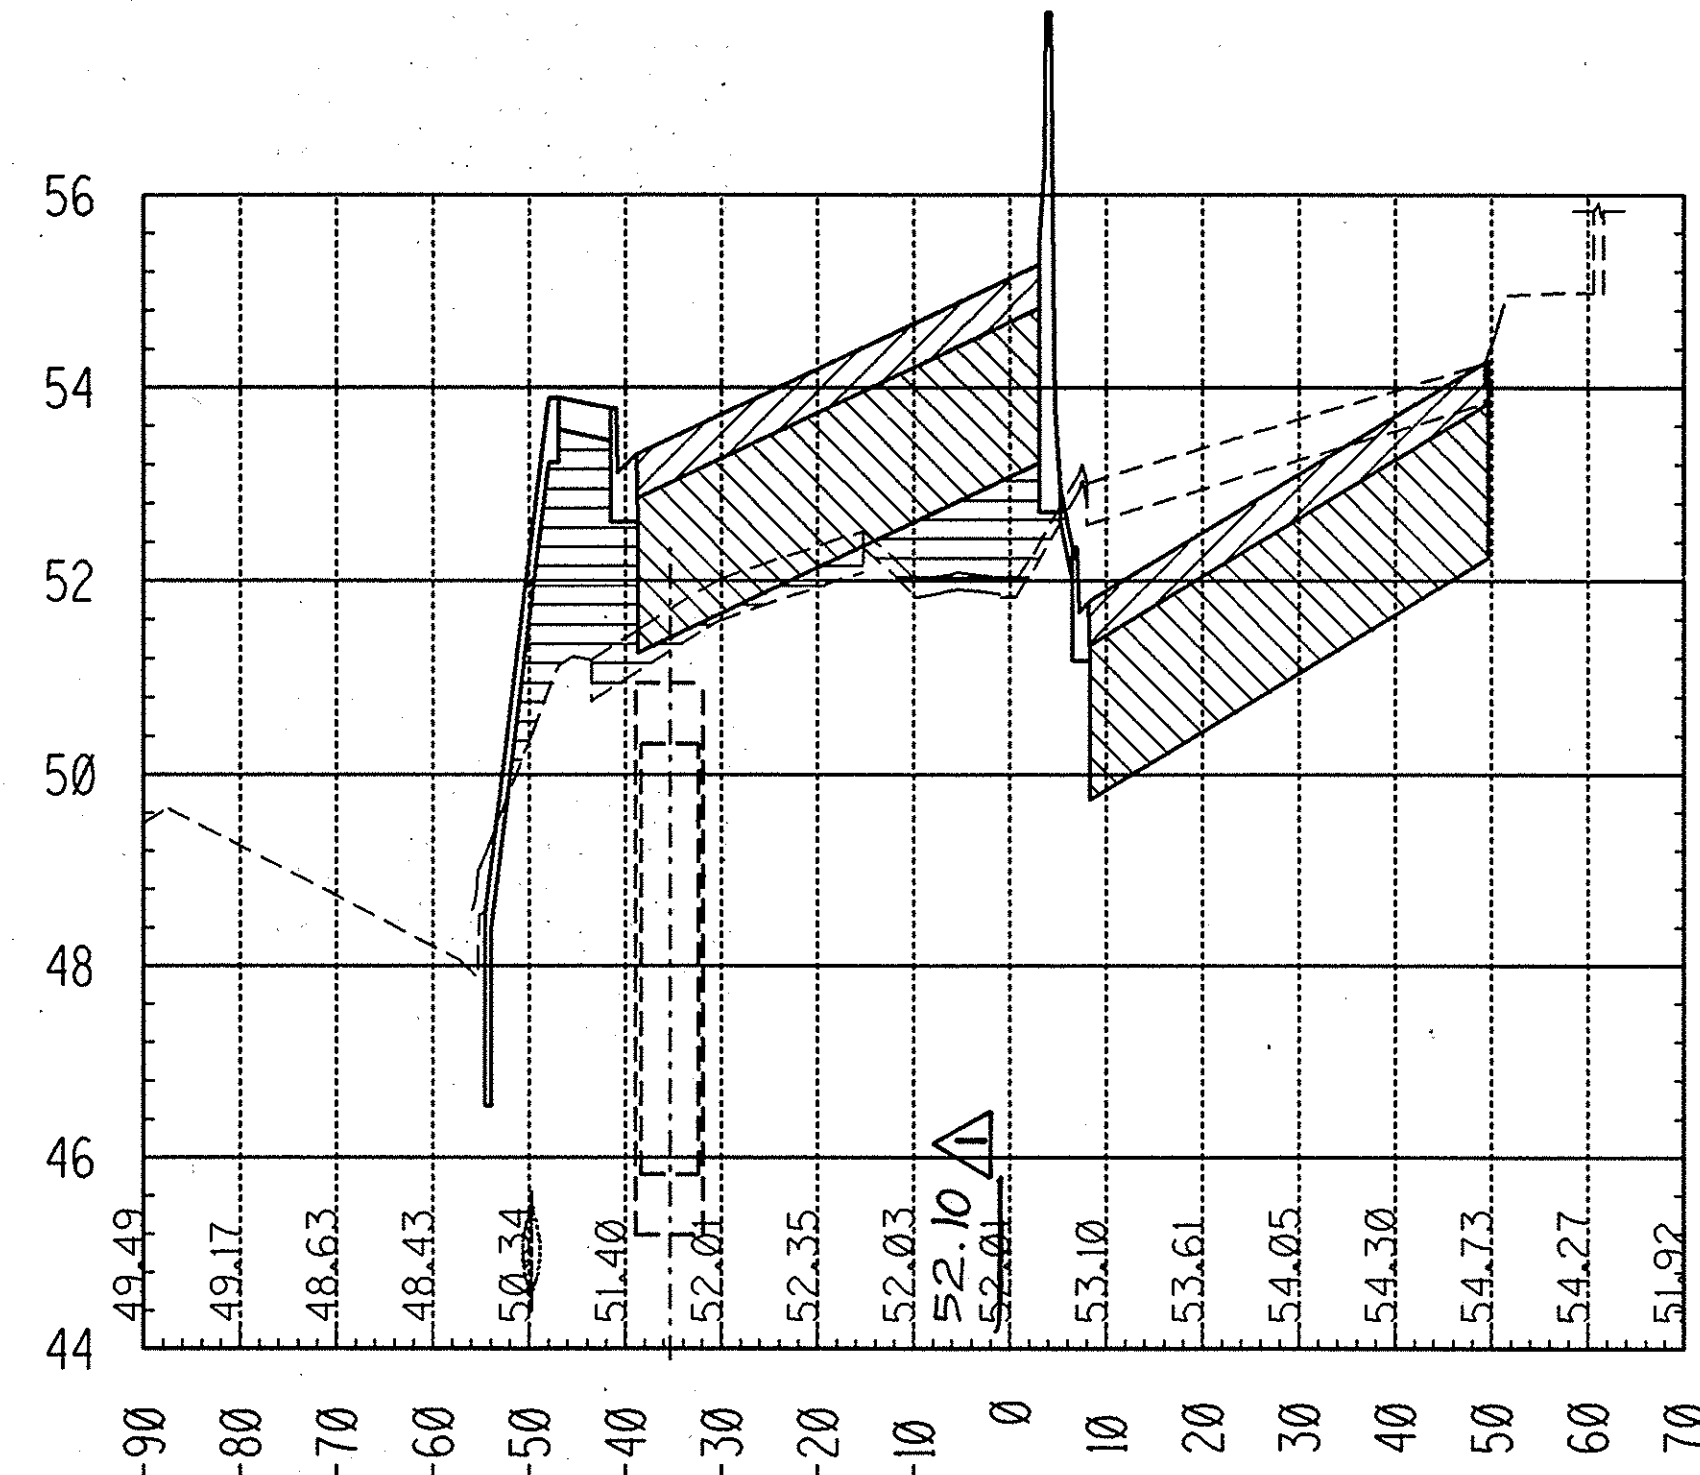

27+25.000

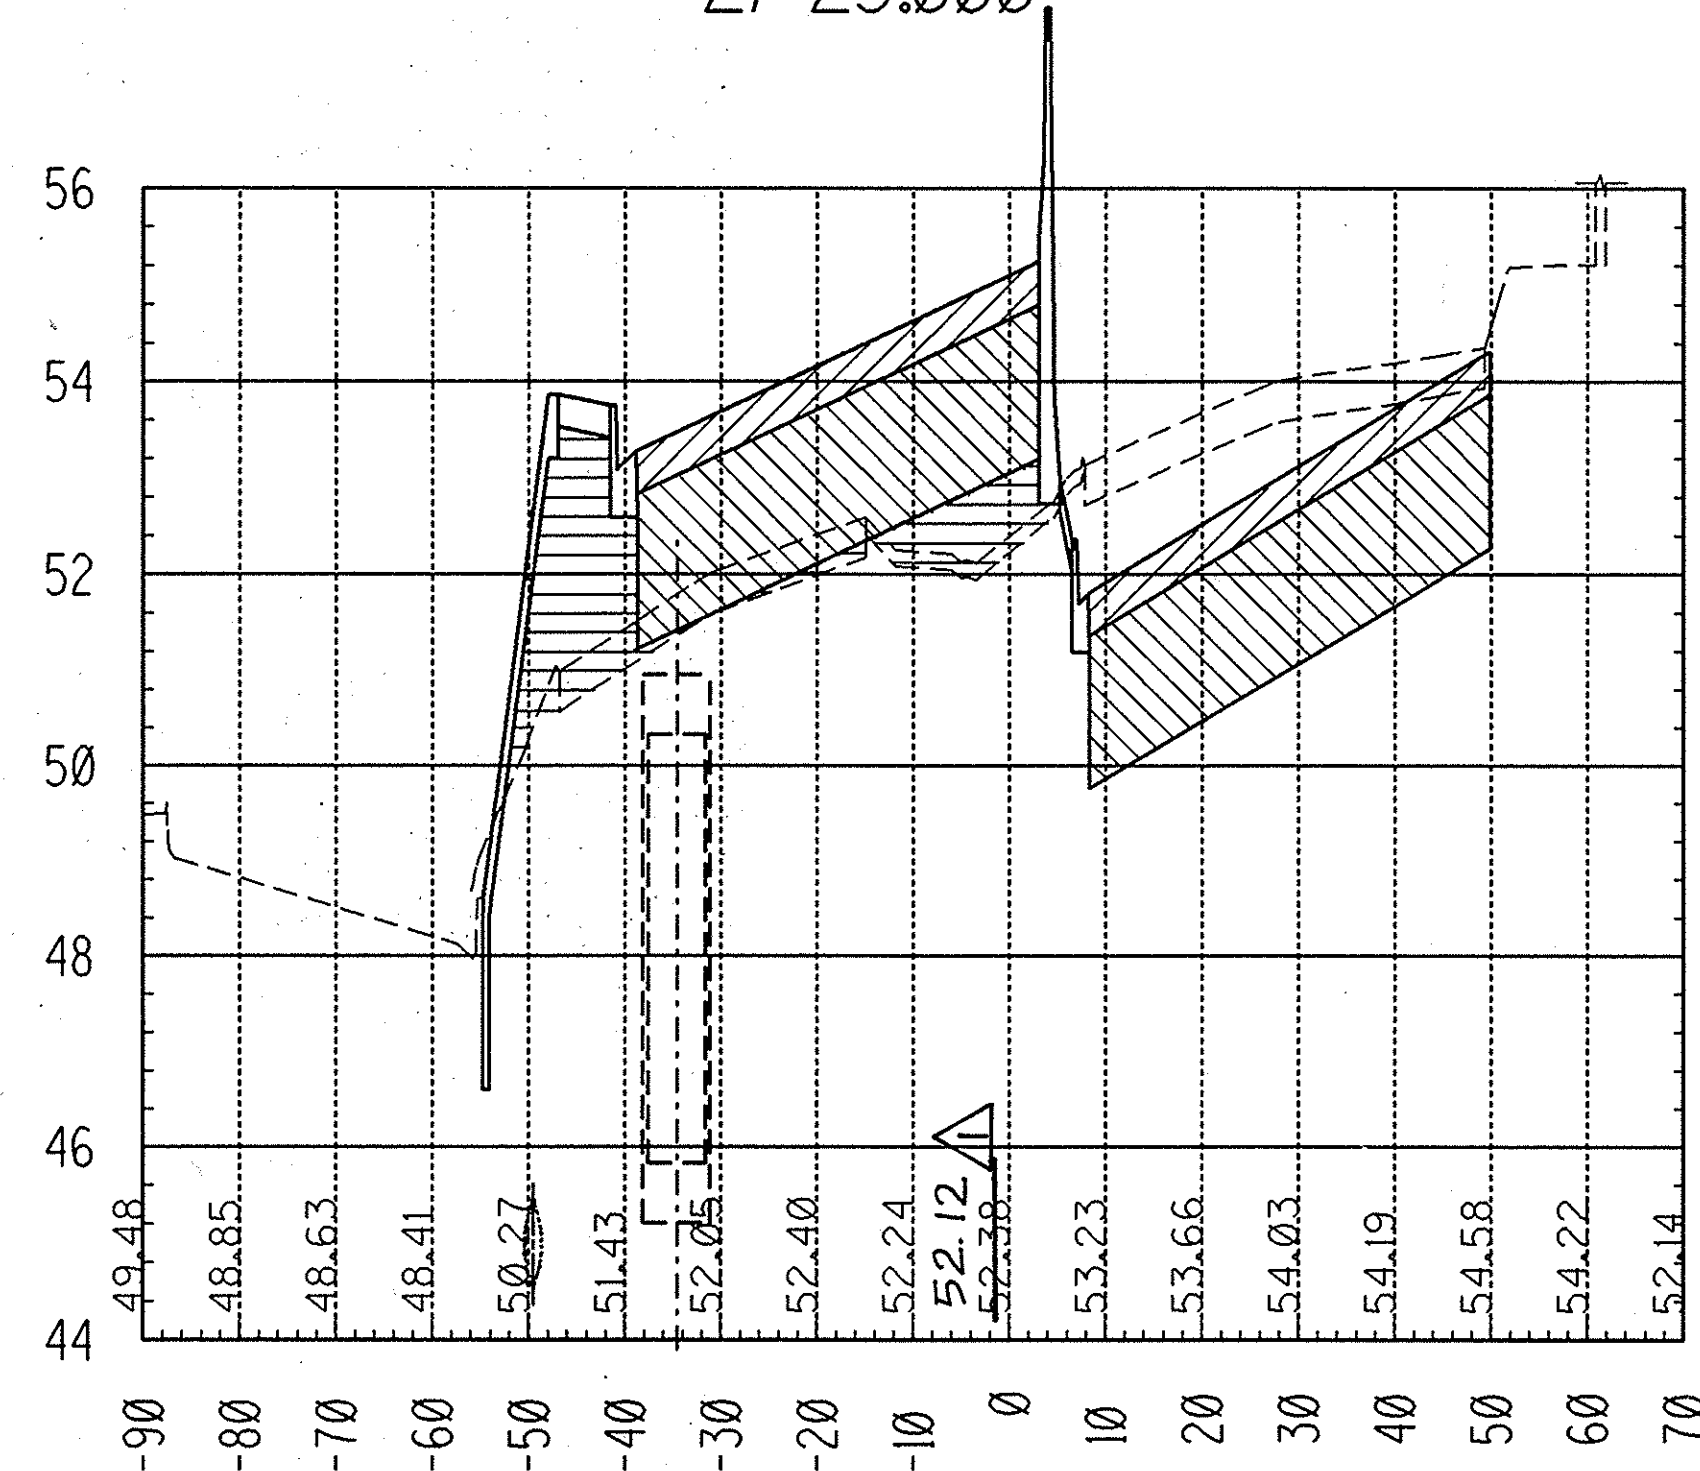

27+00.000

LEGEND

- AGGREGATE BASE MATERIAL
- ASPHALT CONCRETE
- UNCLASSIFIED FILL

RECORD DRAWING

1 1/2 0 1 2
3 inches on original drawing

PROFILE
HORIZ. 1"=20'
VERT. 1"=2'

ORANGE COUNTY ENVIRONMENTAL MANAGEMENT AGENCY	
HARBOR BLVD. IMPROVEMENTS	
CROSS SECTIONS 26+00 to 27+25	
DESIGNED: RRS	SHEET 48 OF 60
DRAWN: SG/PAN/AHP	CHECKED: RAH
SCALE: AS SHOWN	DATE: 3-93
DRAWING NO.	