
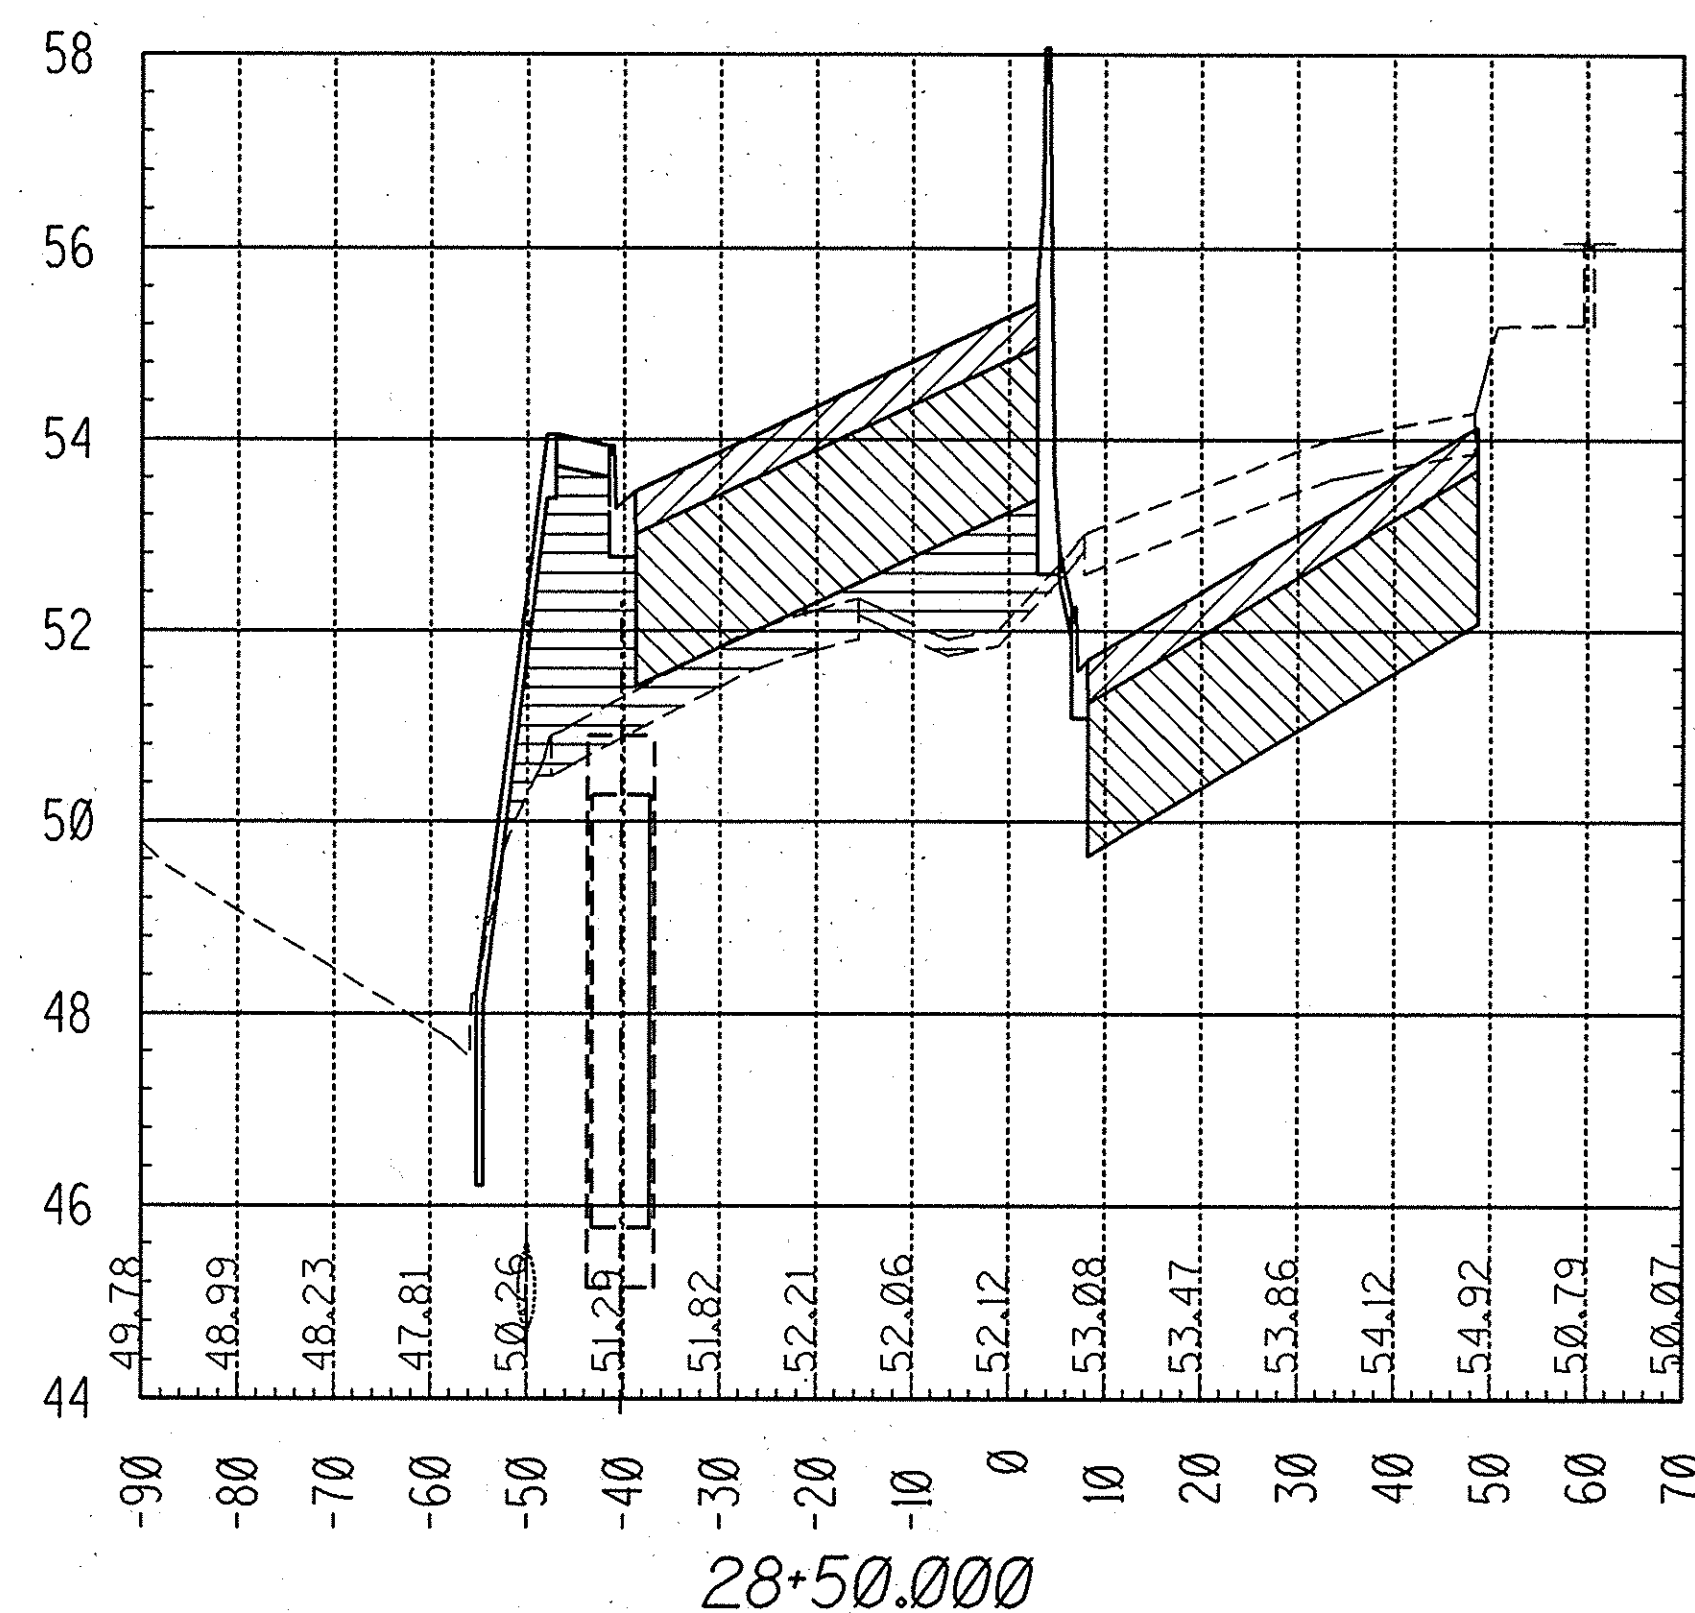
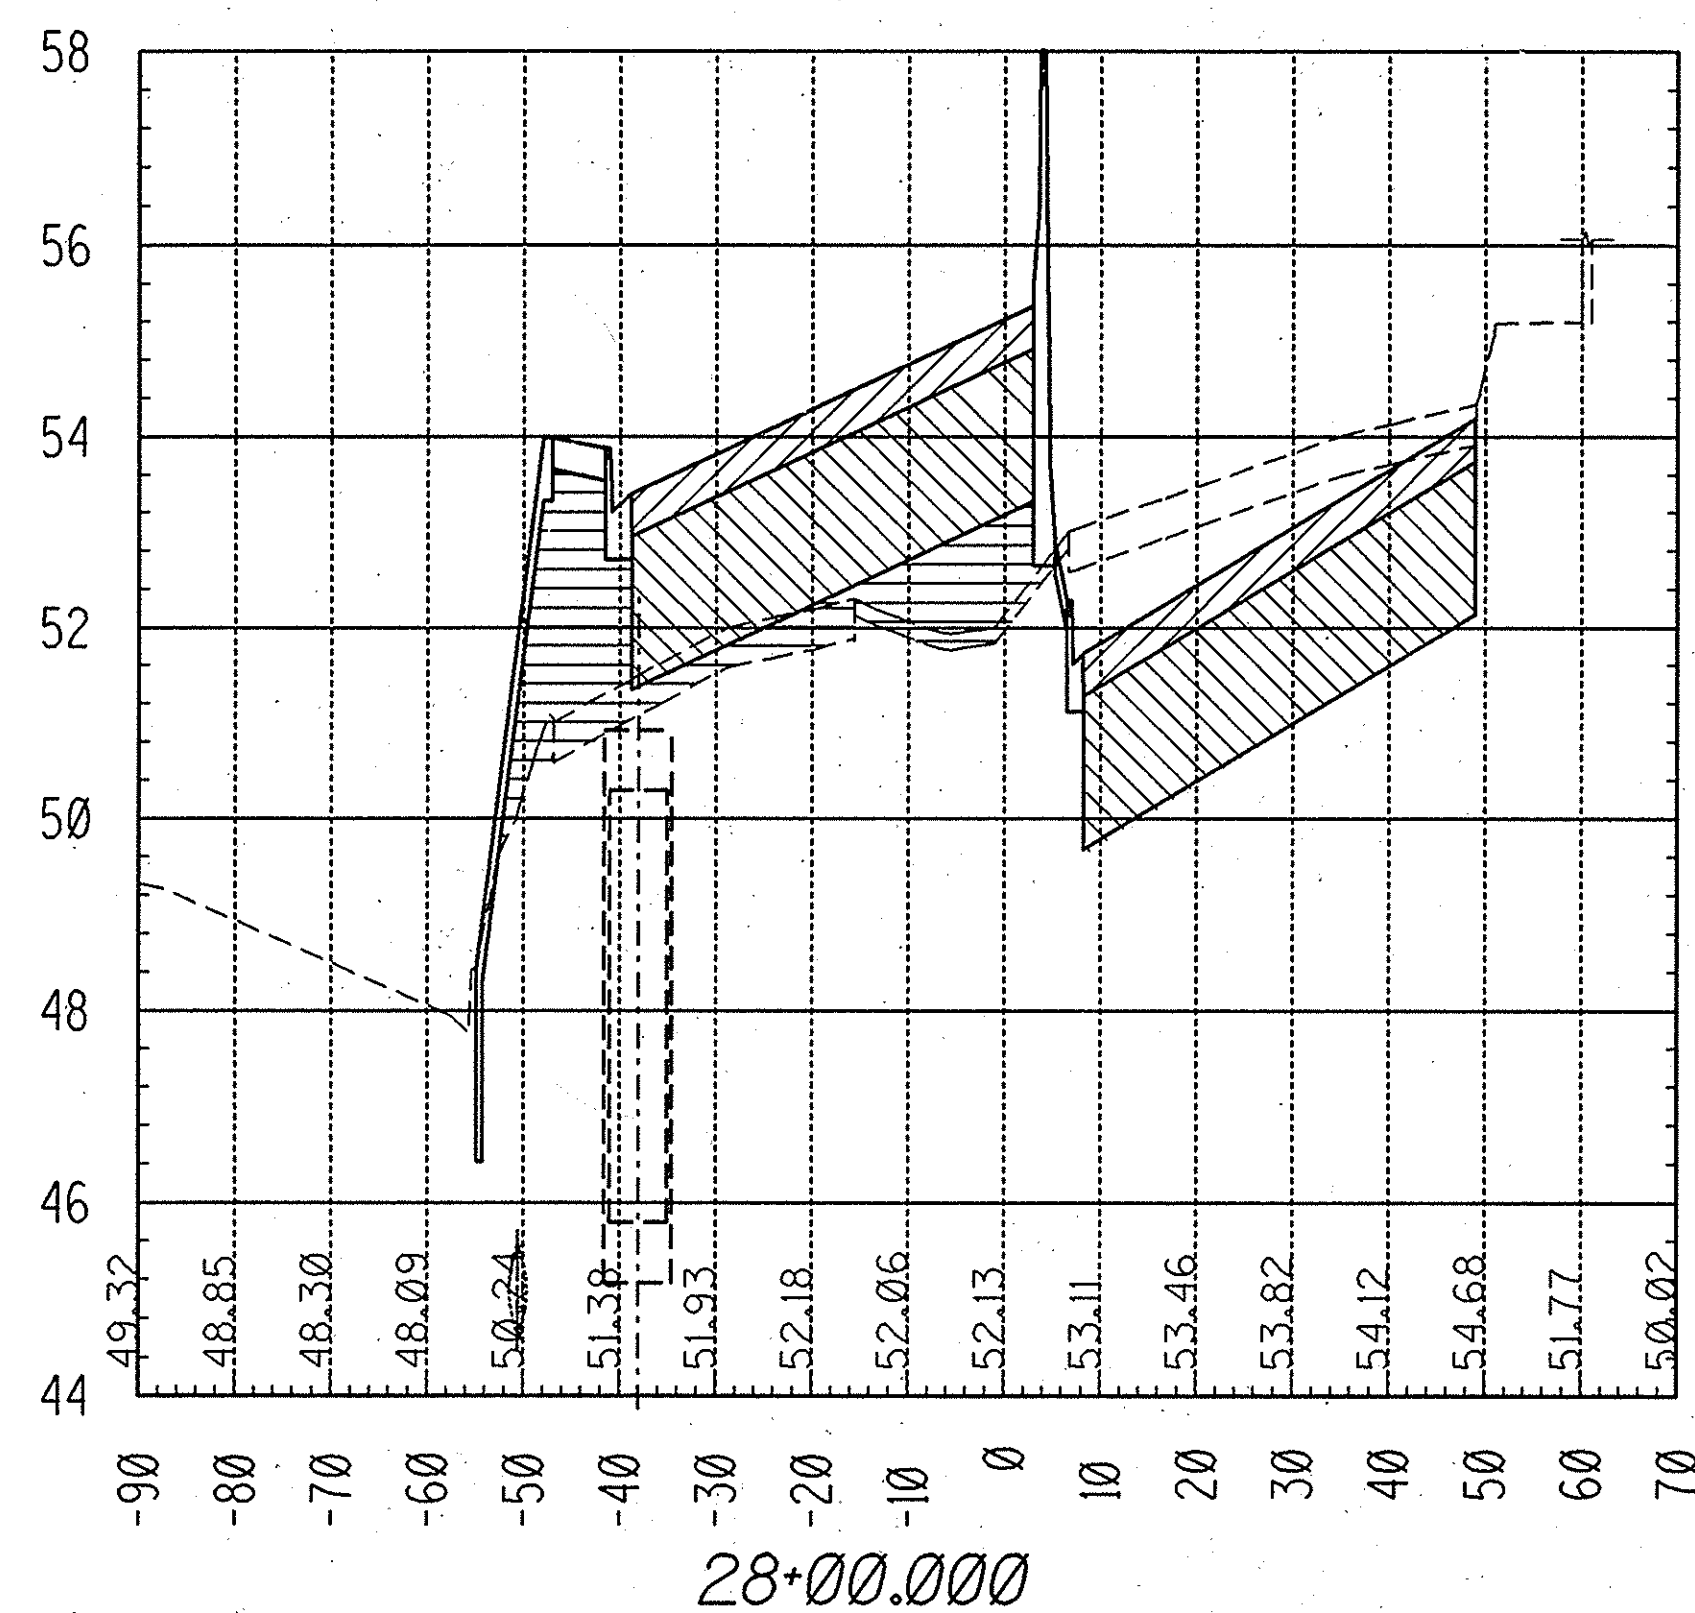
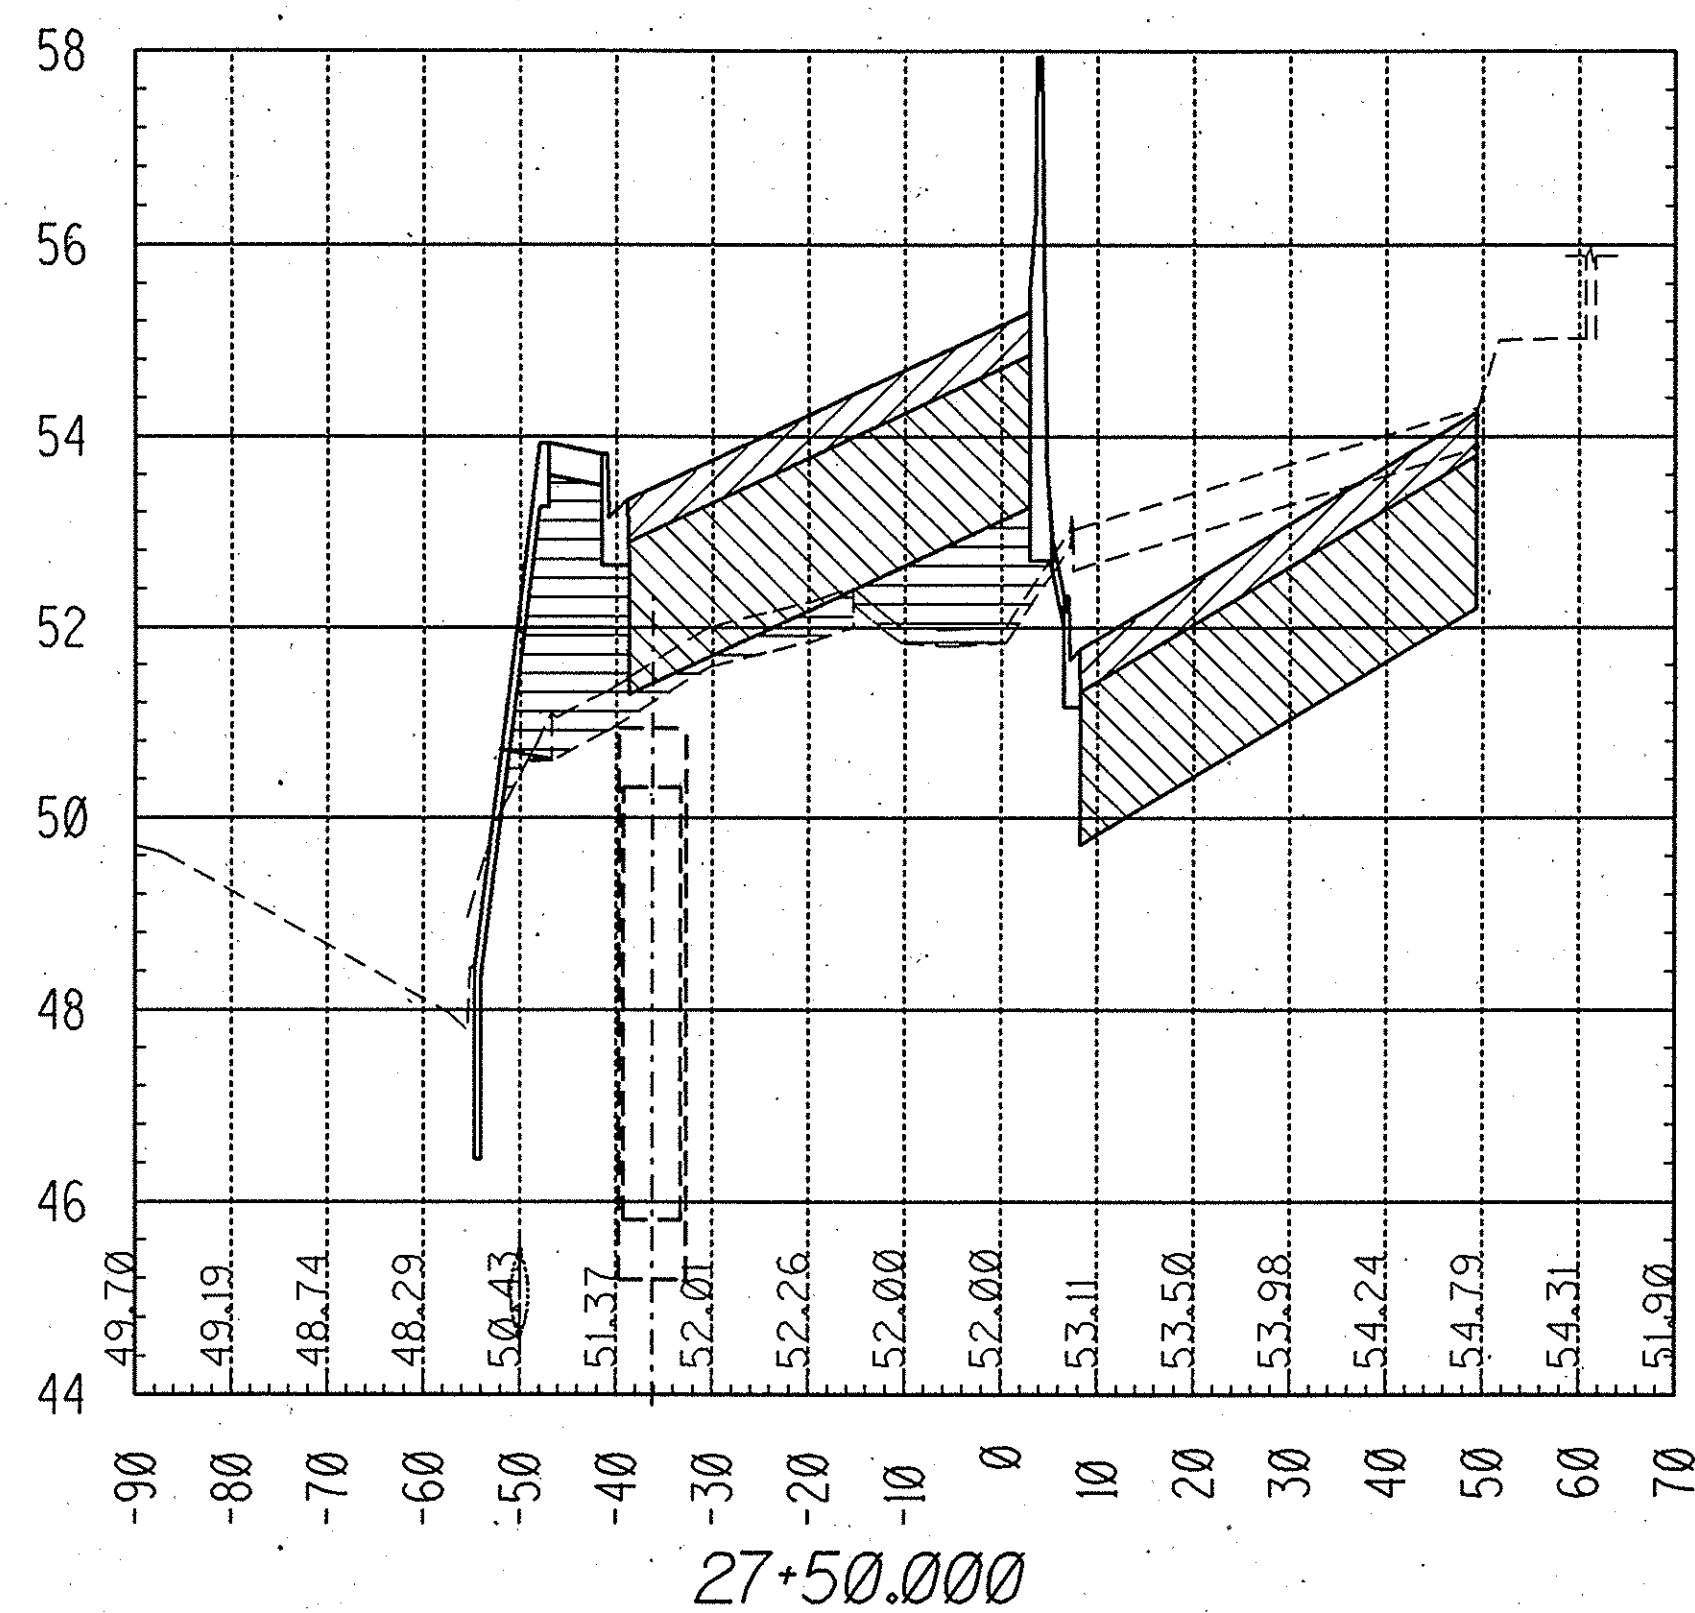
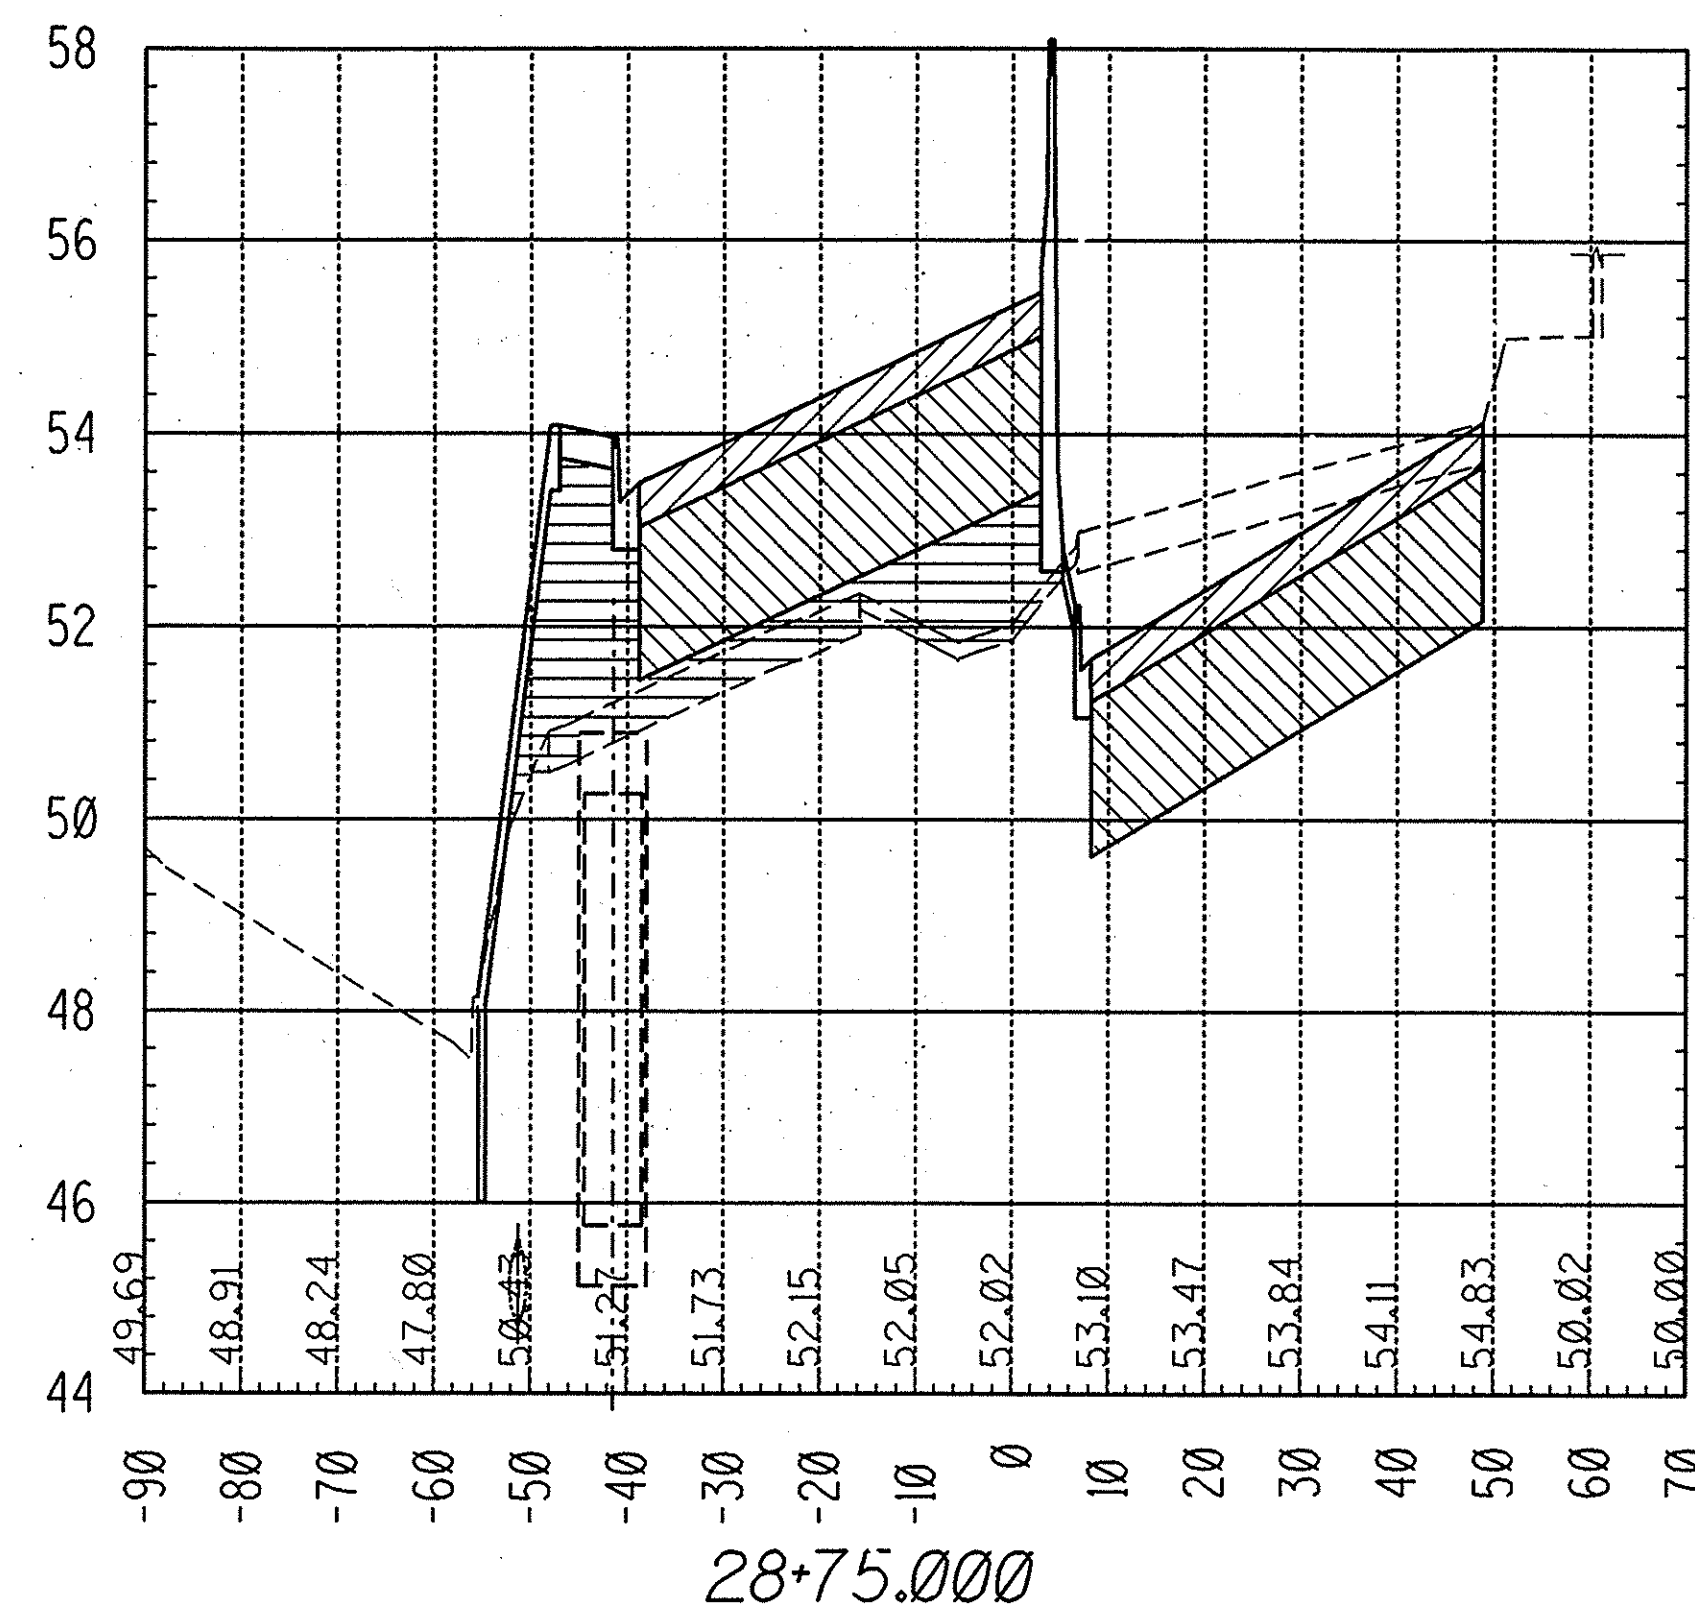
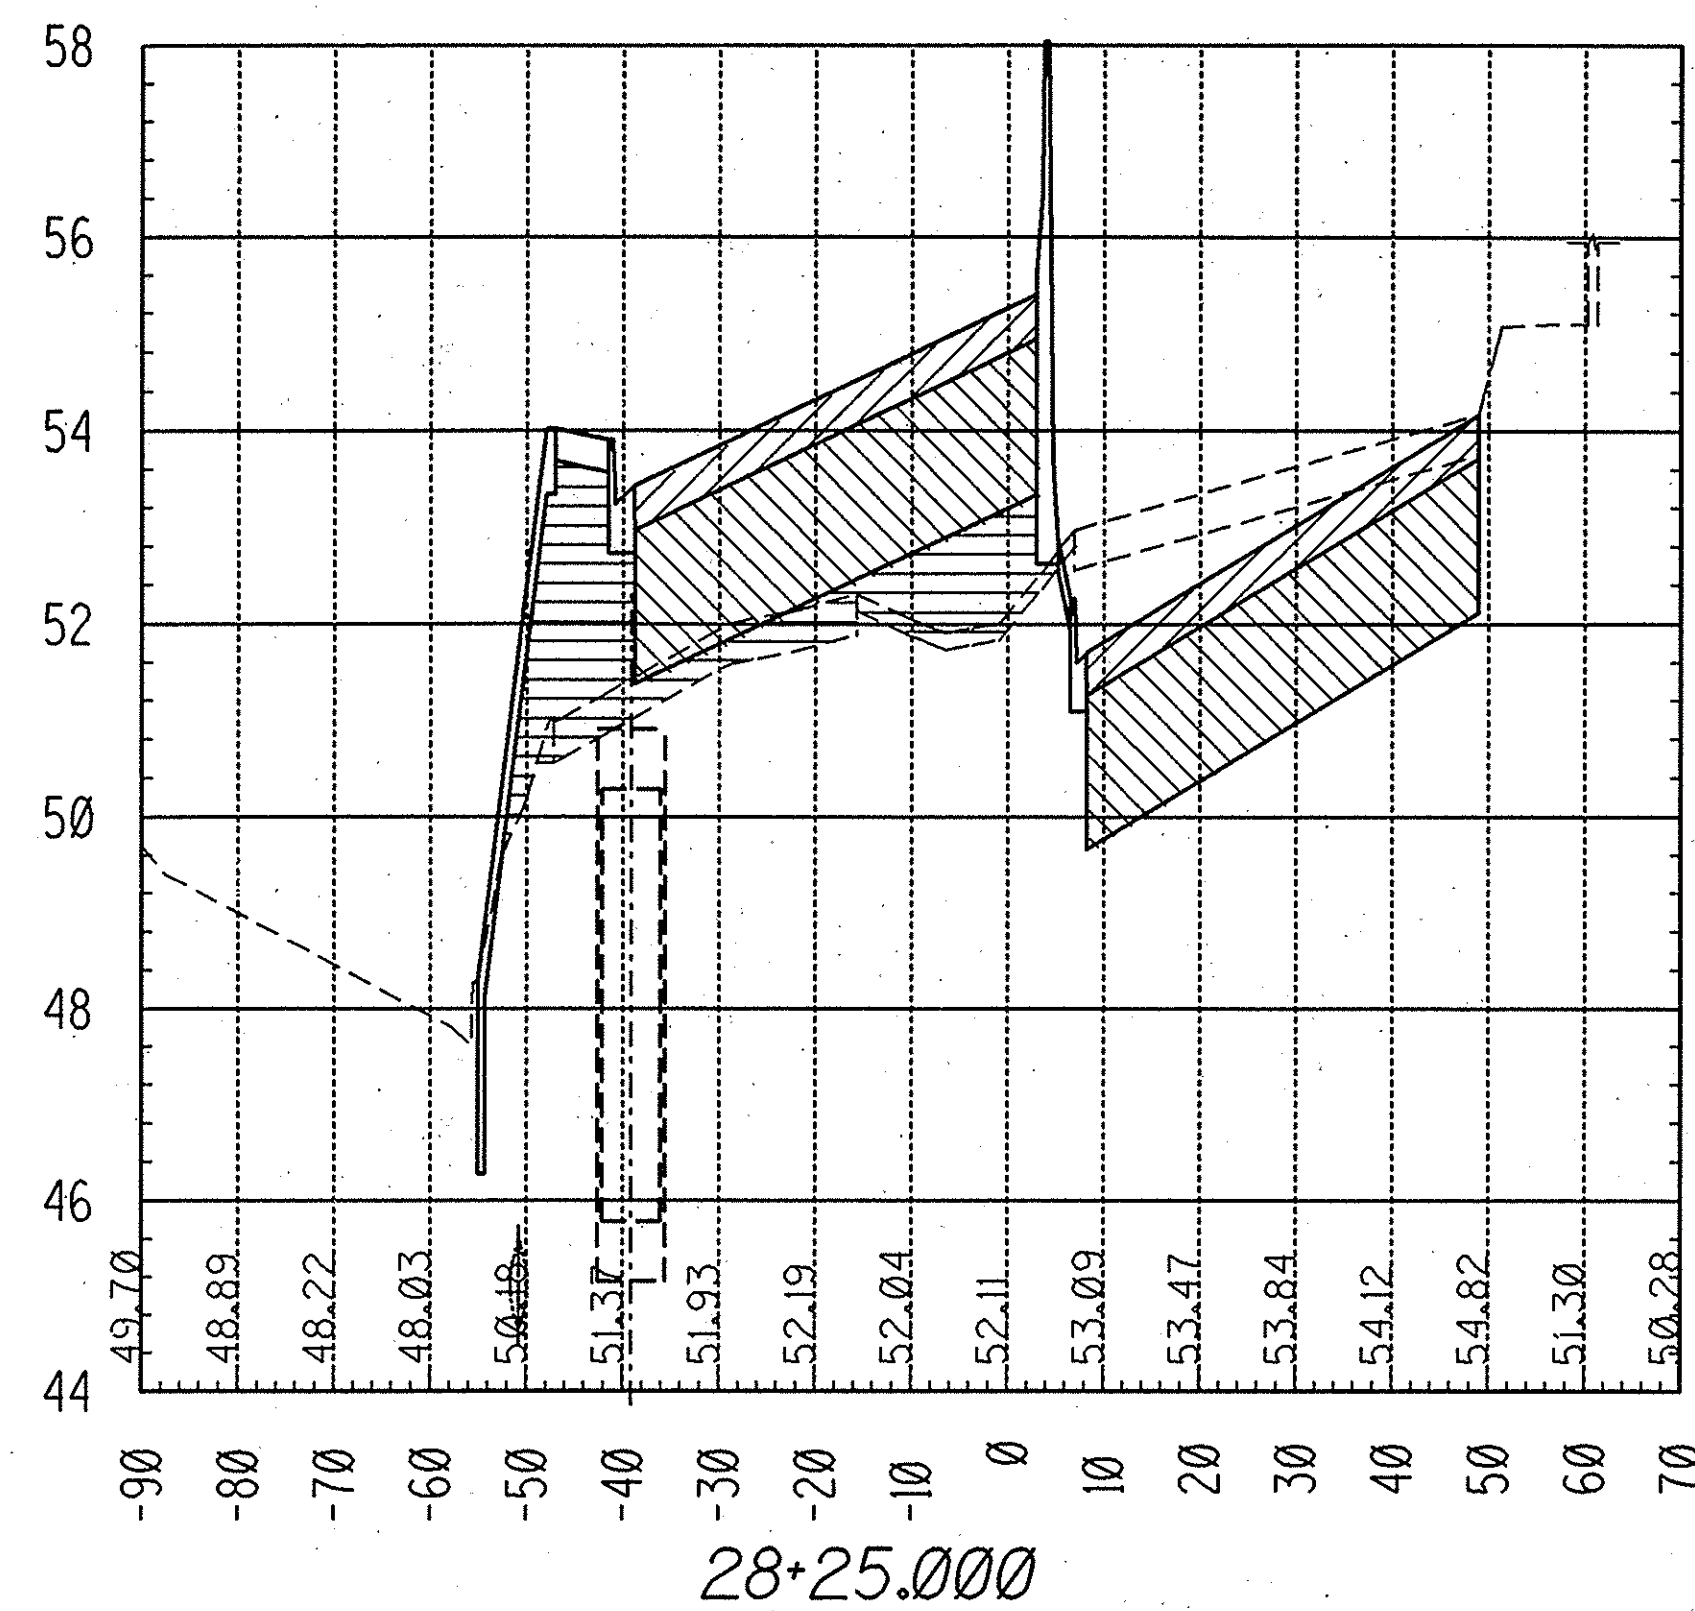


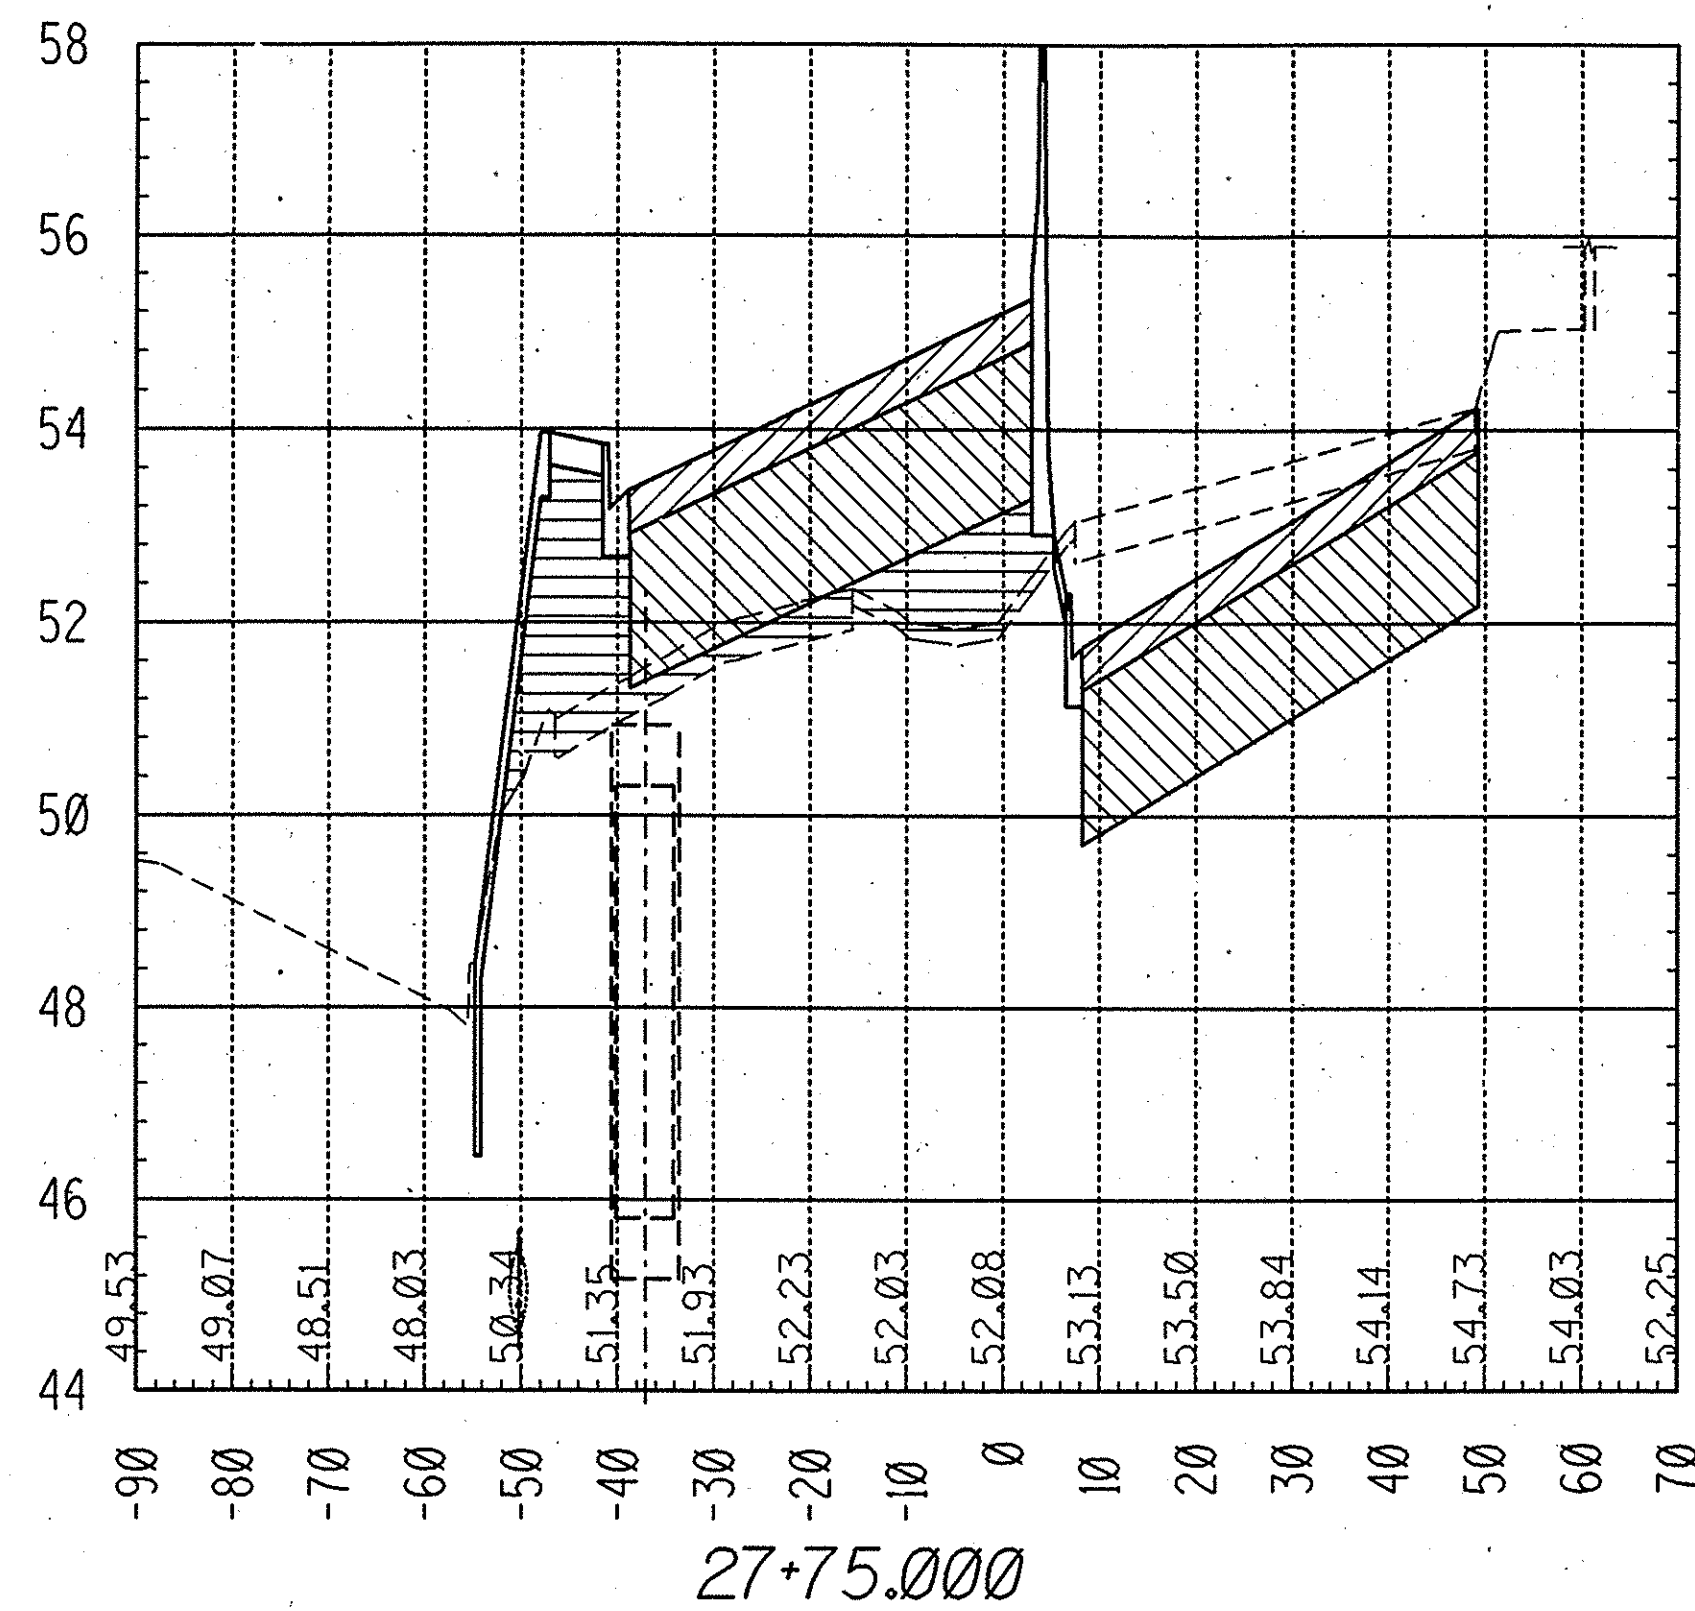

LEGEND

- AGGREGATE BASE MATERIAL
- ASPHALT CONCRETE
- UNCLASSIFIED FILL

RECORD DRAWING

1/2" = 0' 1" = 2'
3 inches on original drawing

PROFILE

HORIZ. 1" = 20'
VERT. 1" = 2'

ORANGE COUNTY ENVIRONMENTAL MANAGEMENT AGENCY	
HARBOR BLVD. IMPROVEMENTS	
CROSS SECTIONS 27+50 to 28+75	
DESIGNED - RRS	SHEET 49 OF 60
DRAWN - SG/PAN/AHP	CHECKED - RAH
SCALE AS SHOWN	DATE 3-93
RICHARD HART RCE 39595 (exp. 12-31-93)	