
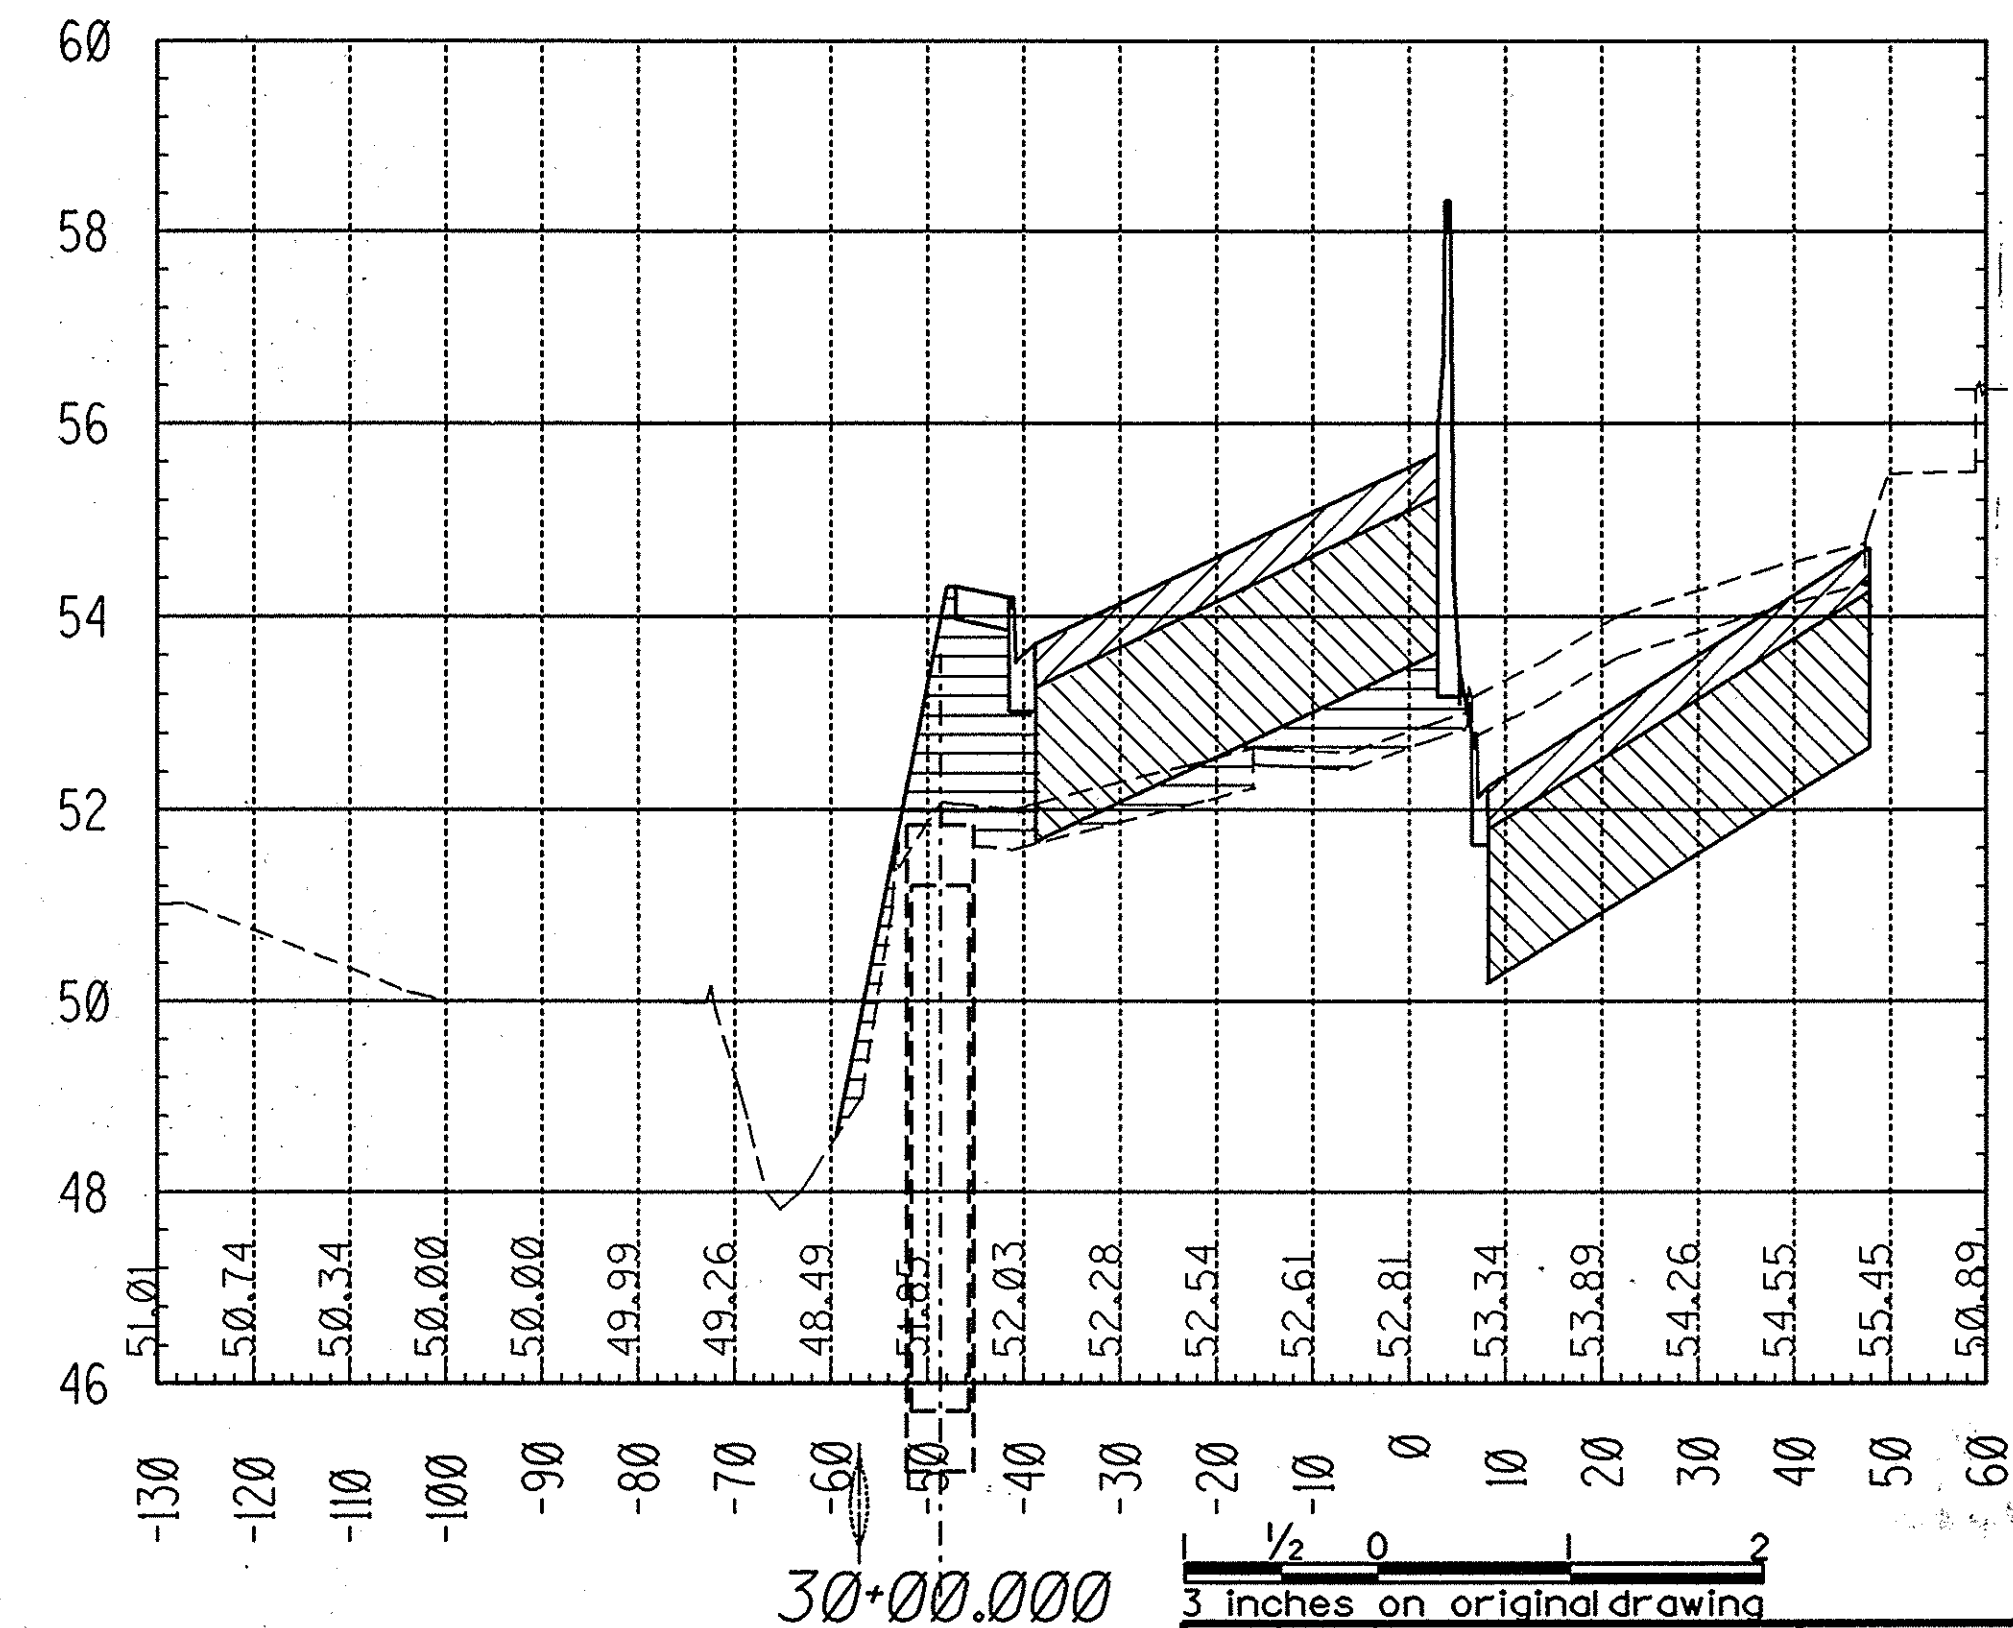
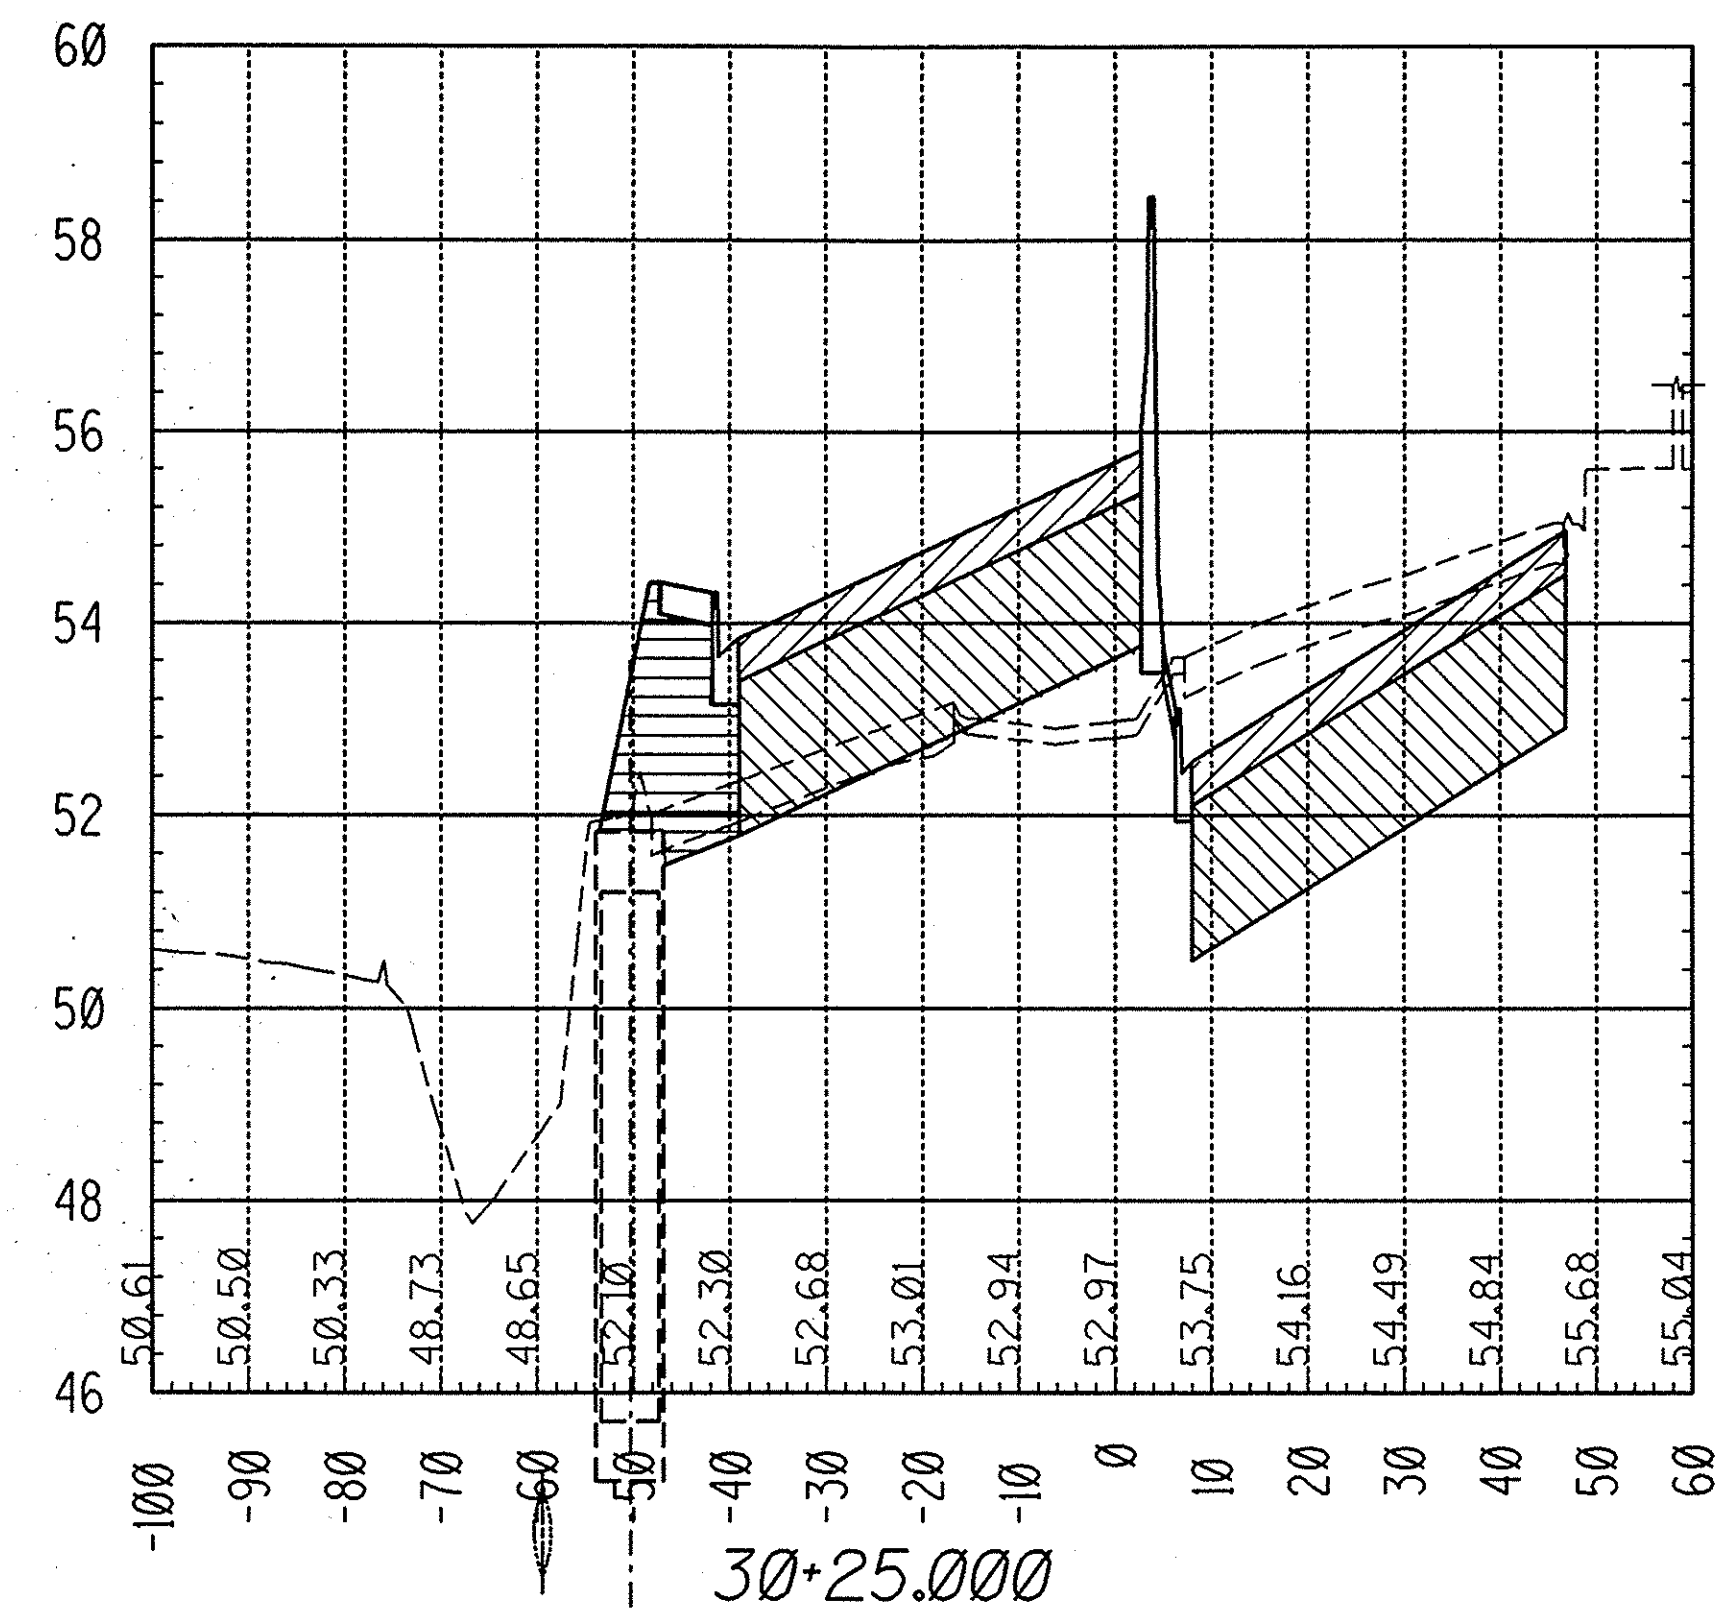
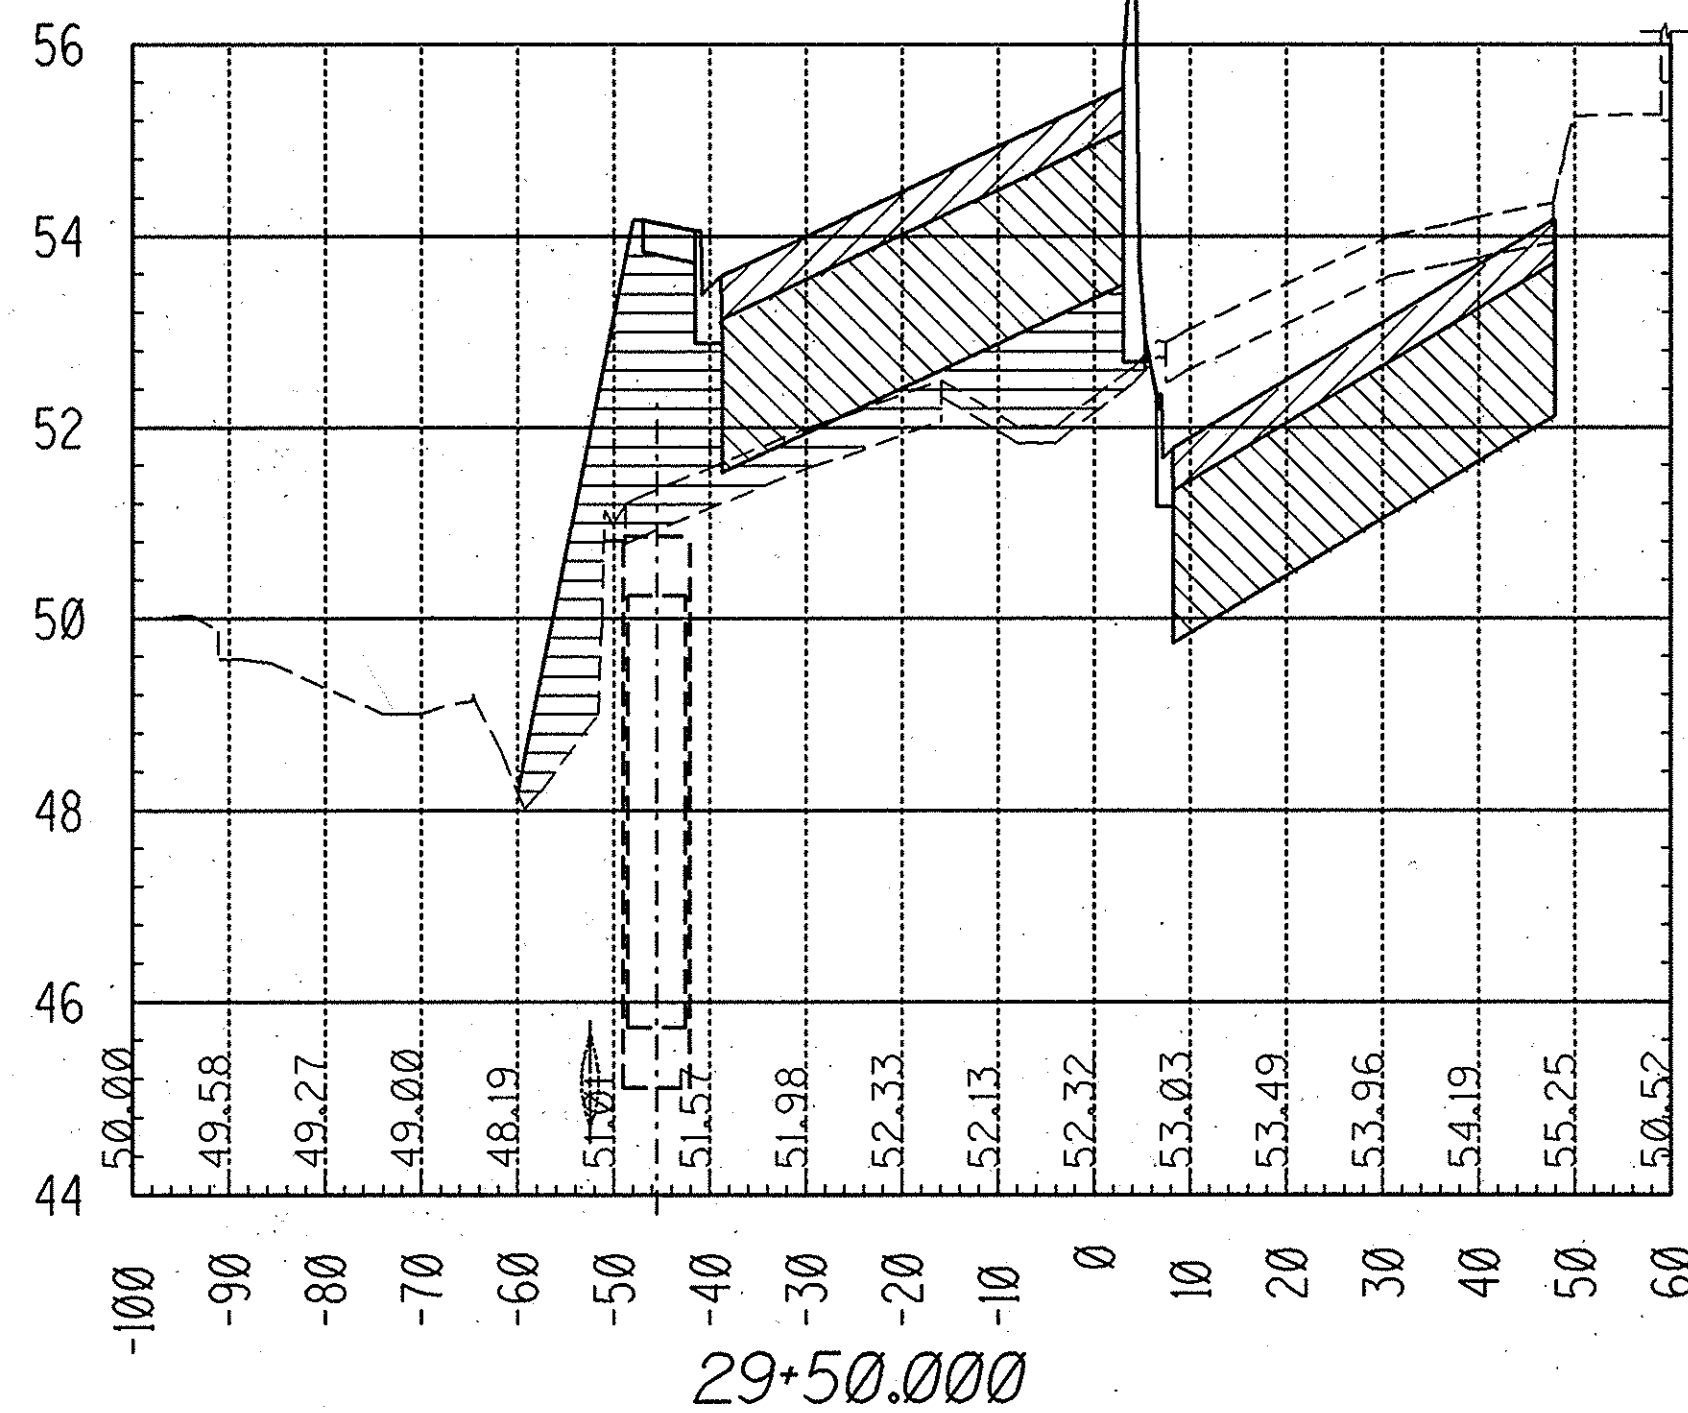
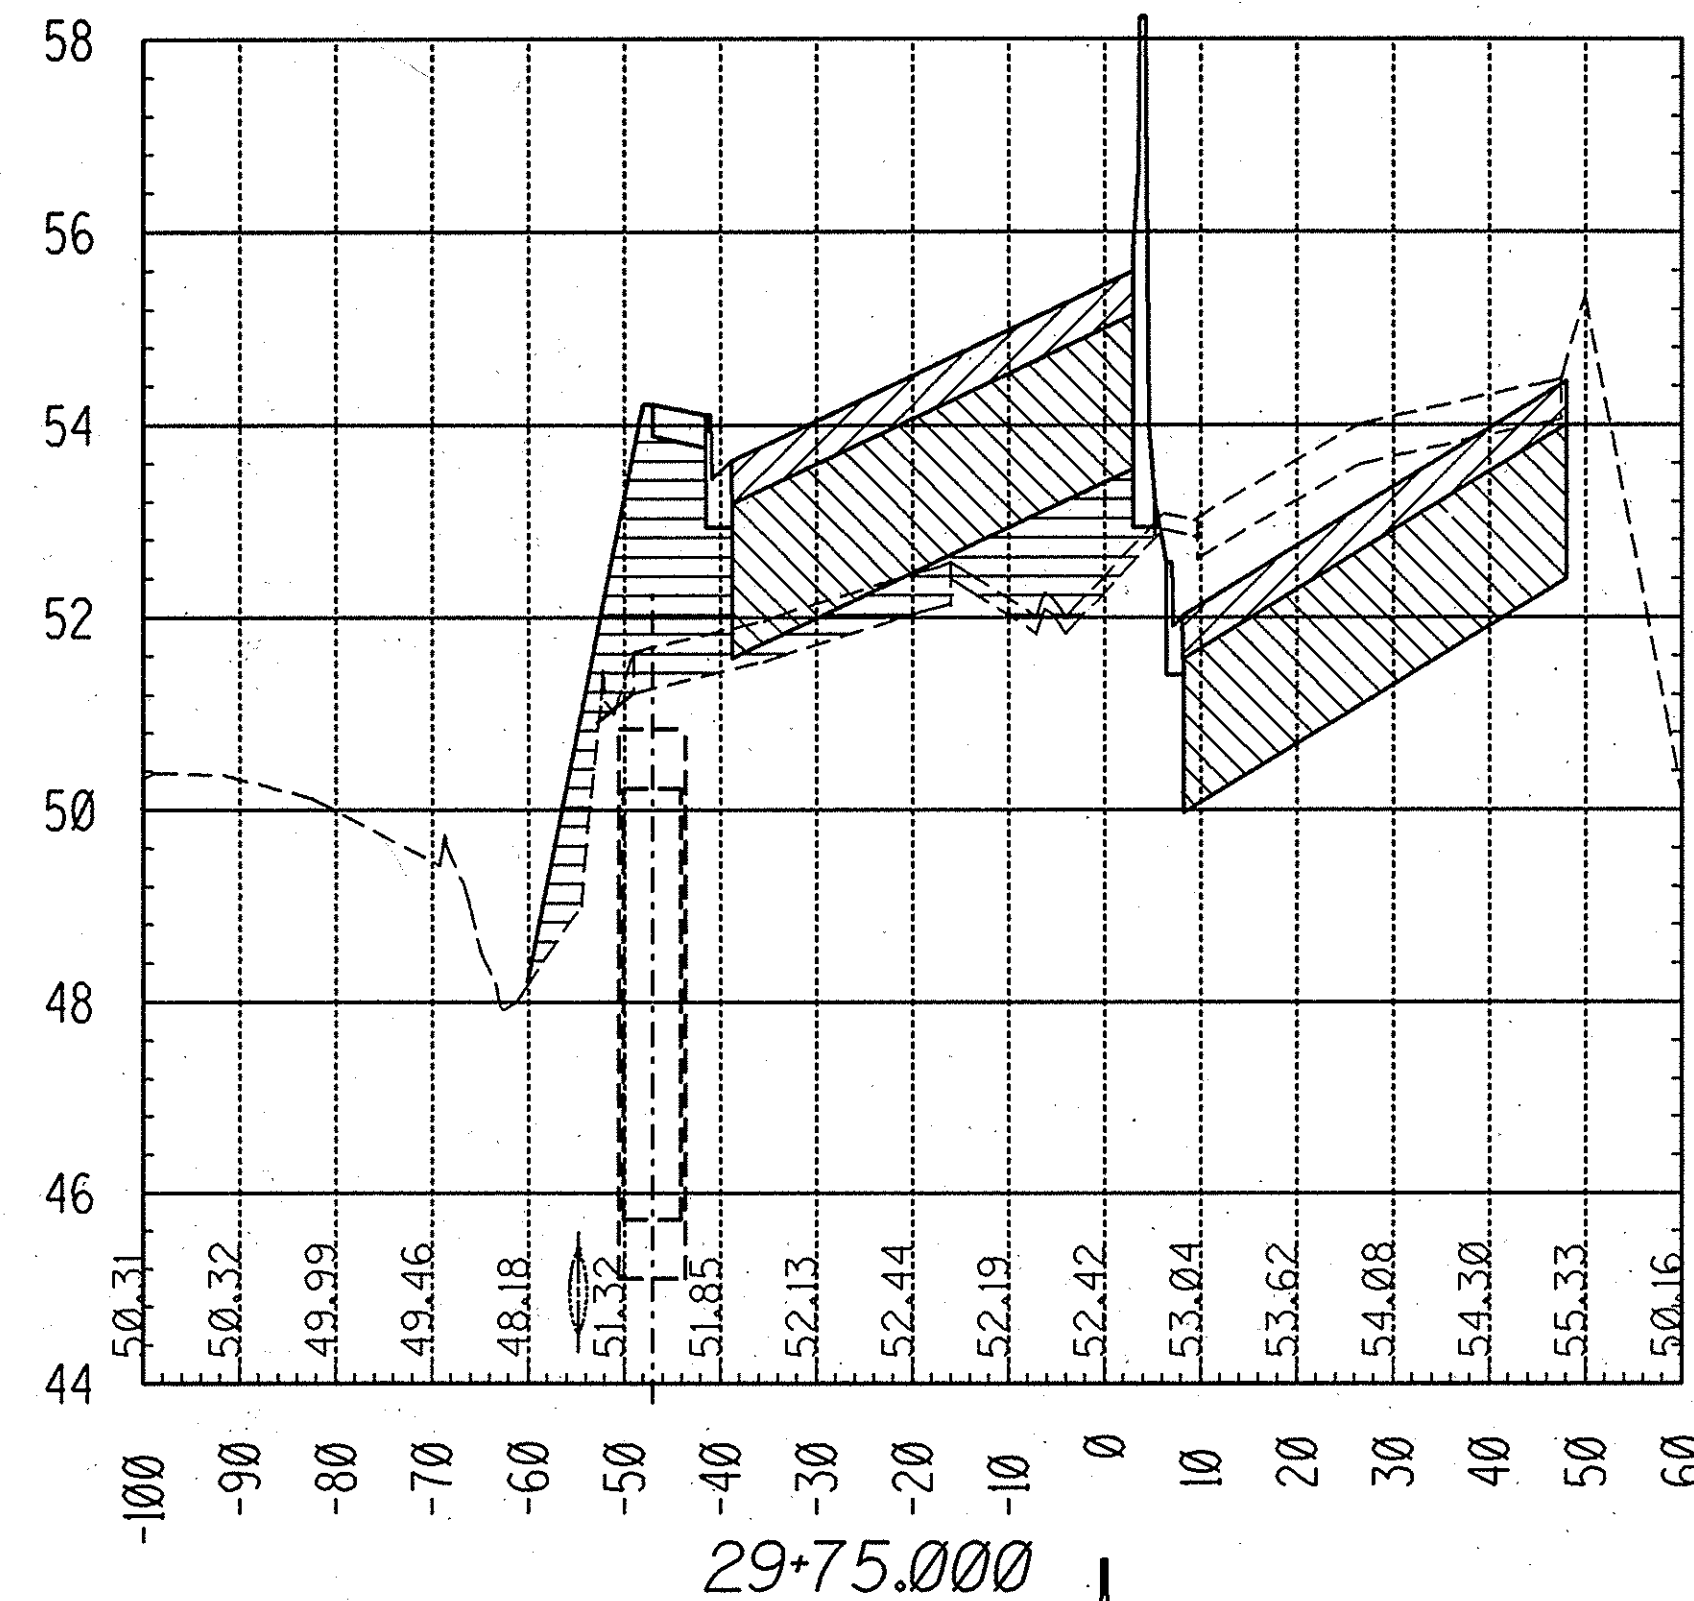
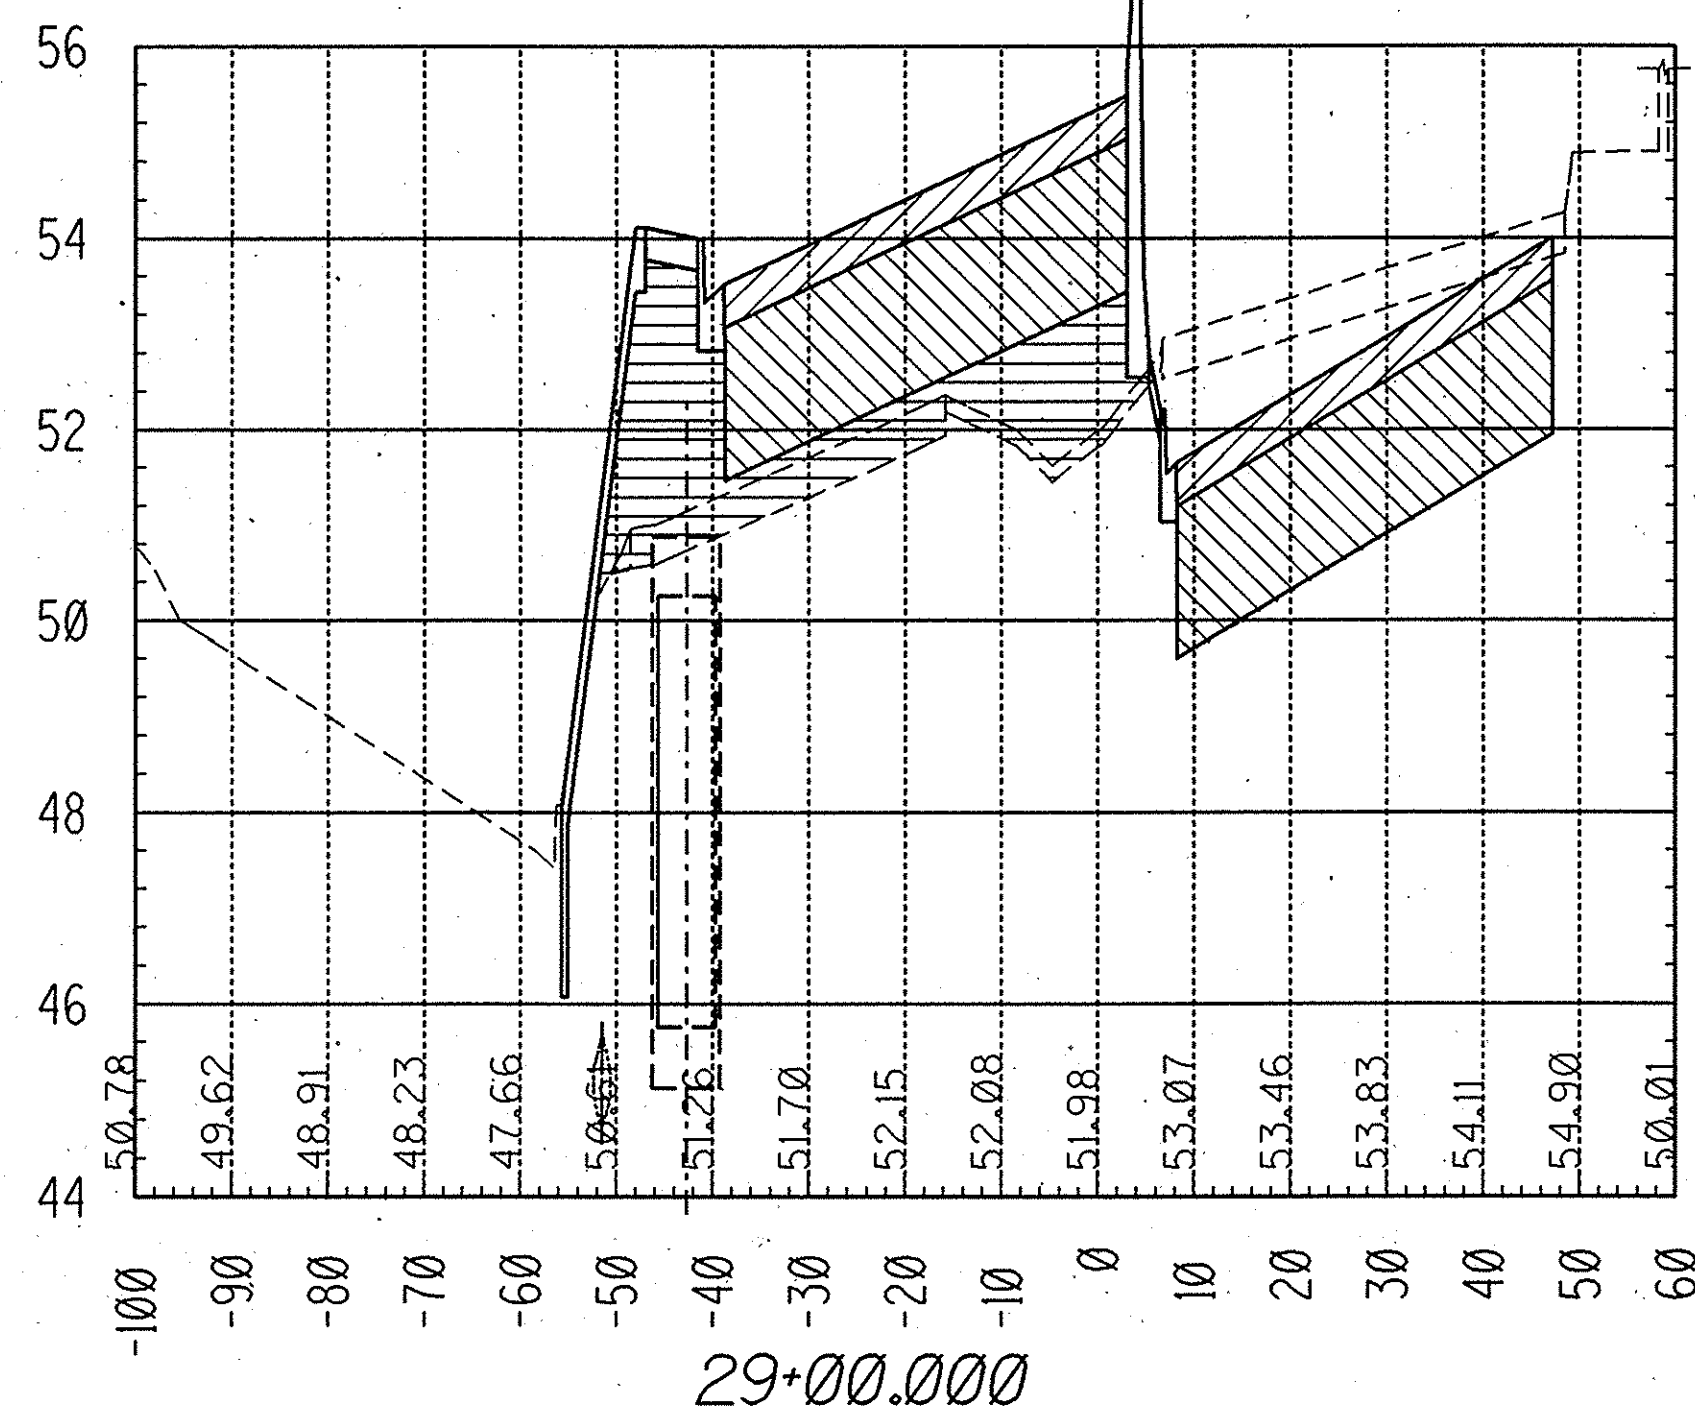


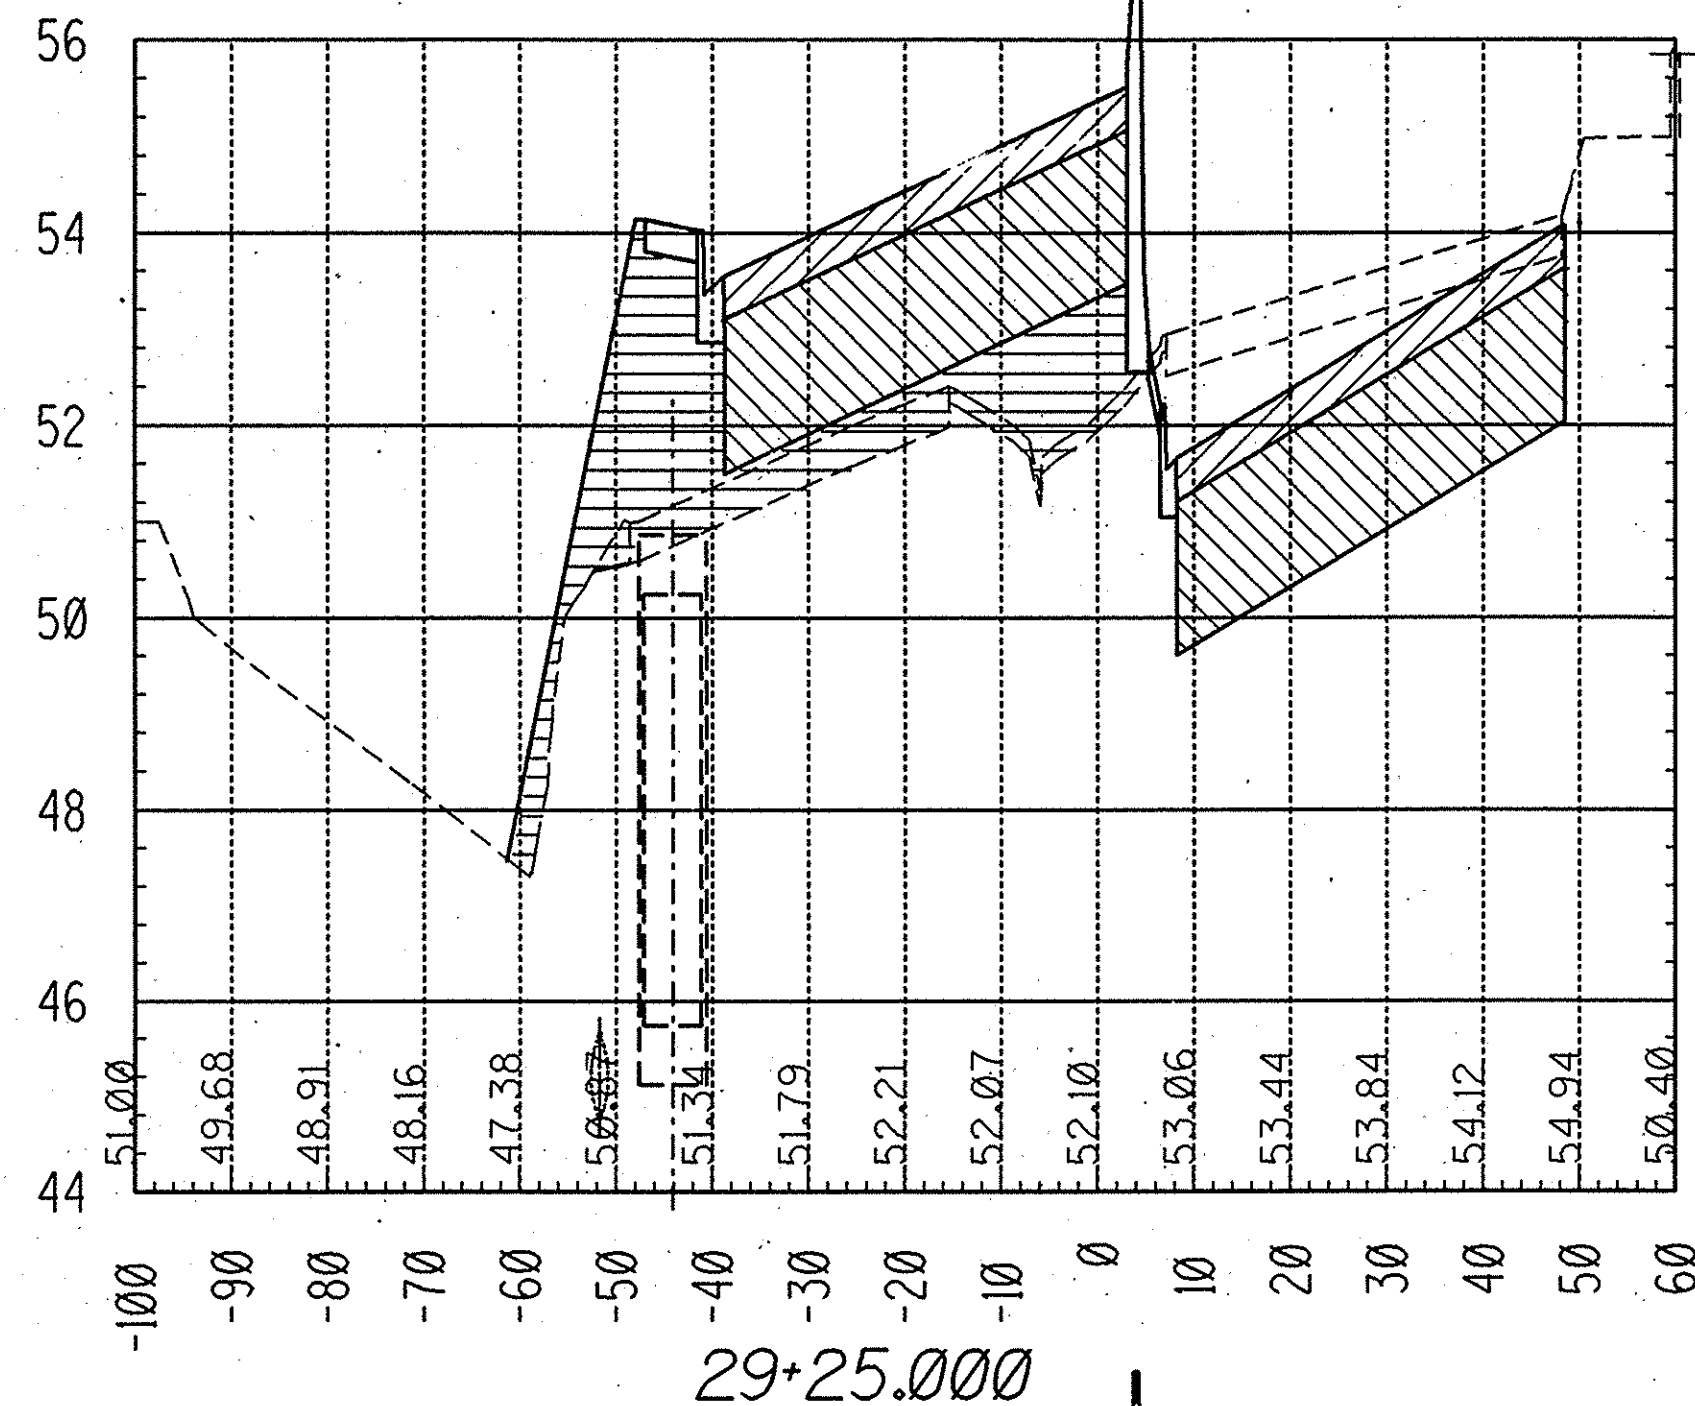

LEGEND

- AGGREGATE BASE MATERIAL
- ASPHALT CONCRETE
- UNCLASSIFIED FILL

RECORD DRAWING

PROFILE
HORIZ. 1"=20'
VERT. 1"=2'

ORANGE COUNTY ENVIRONMENTAL MANAGEMENT AGENCY	
HARBOR BLVD. IMPROVEMENTS	
CROSS SECTIONS 29+00 to 30+25	
DESIGNED: RBS	CHECKED: BAH
DRAWN: SG/PAN/AHP	DATE: 3-93
SCALE: AS SHOWN	DRAWING NO. 50 OF 60