
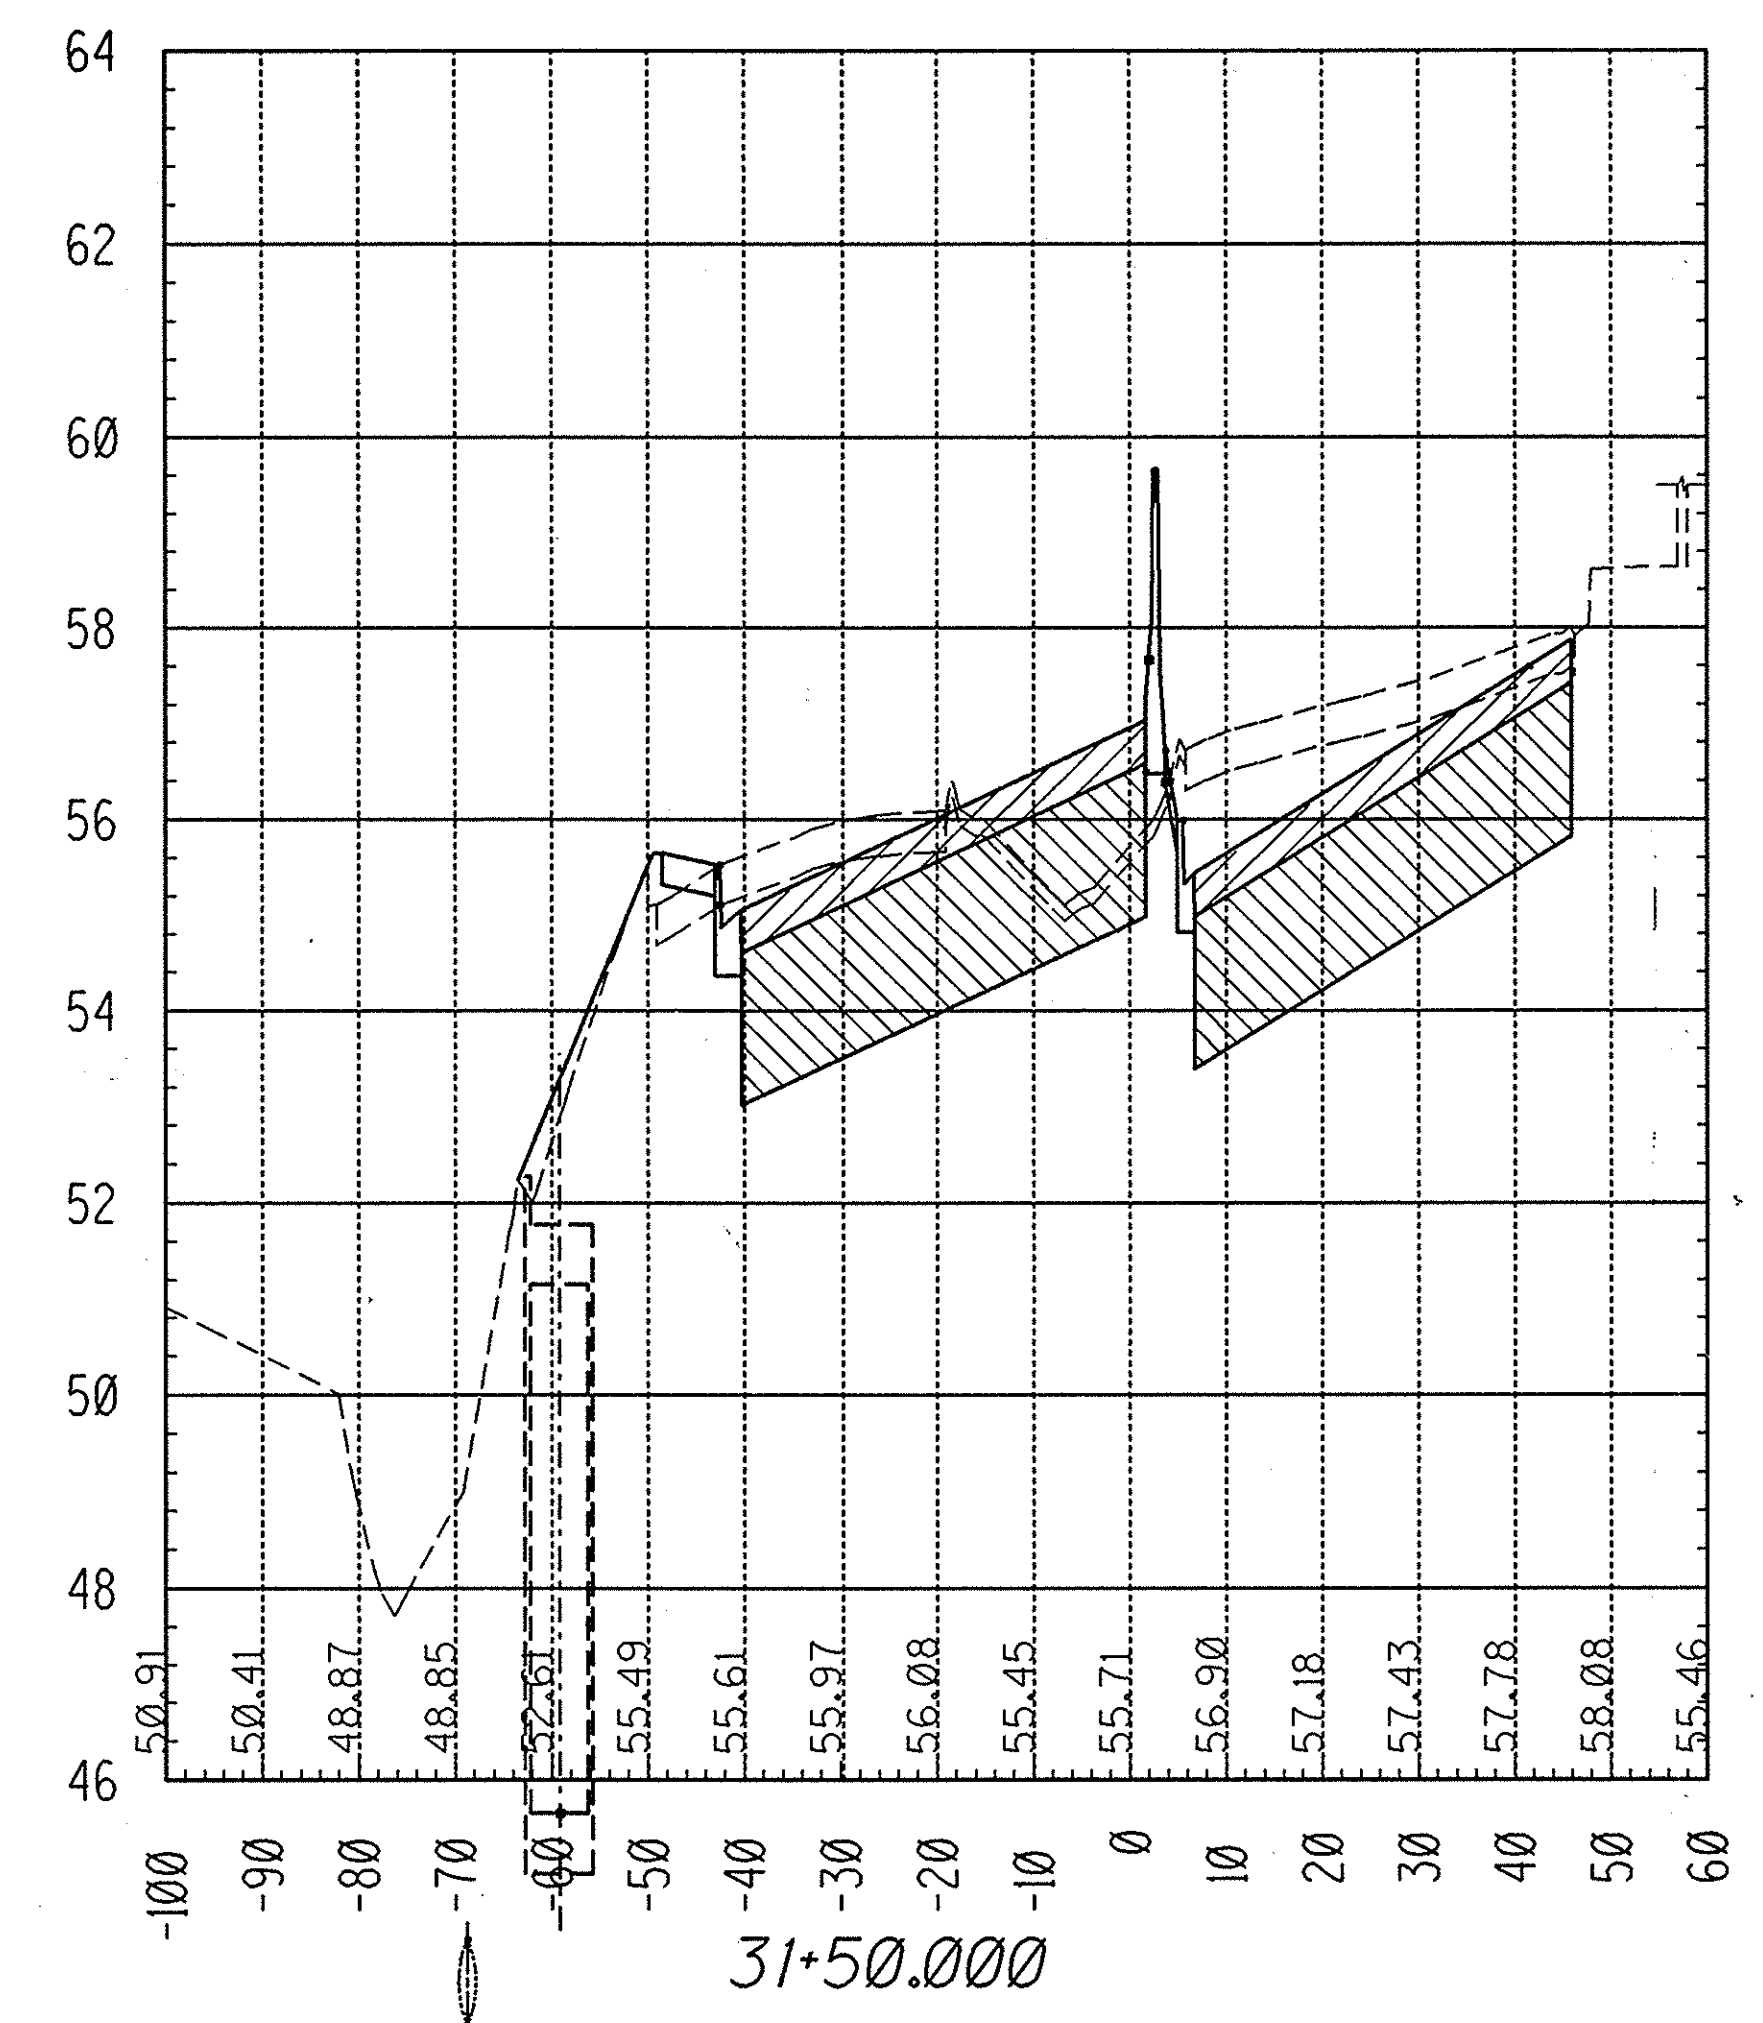
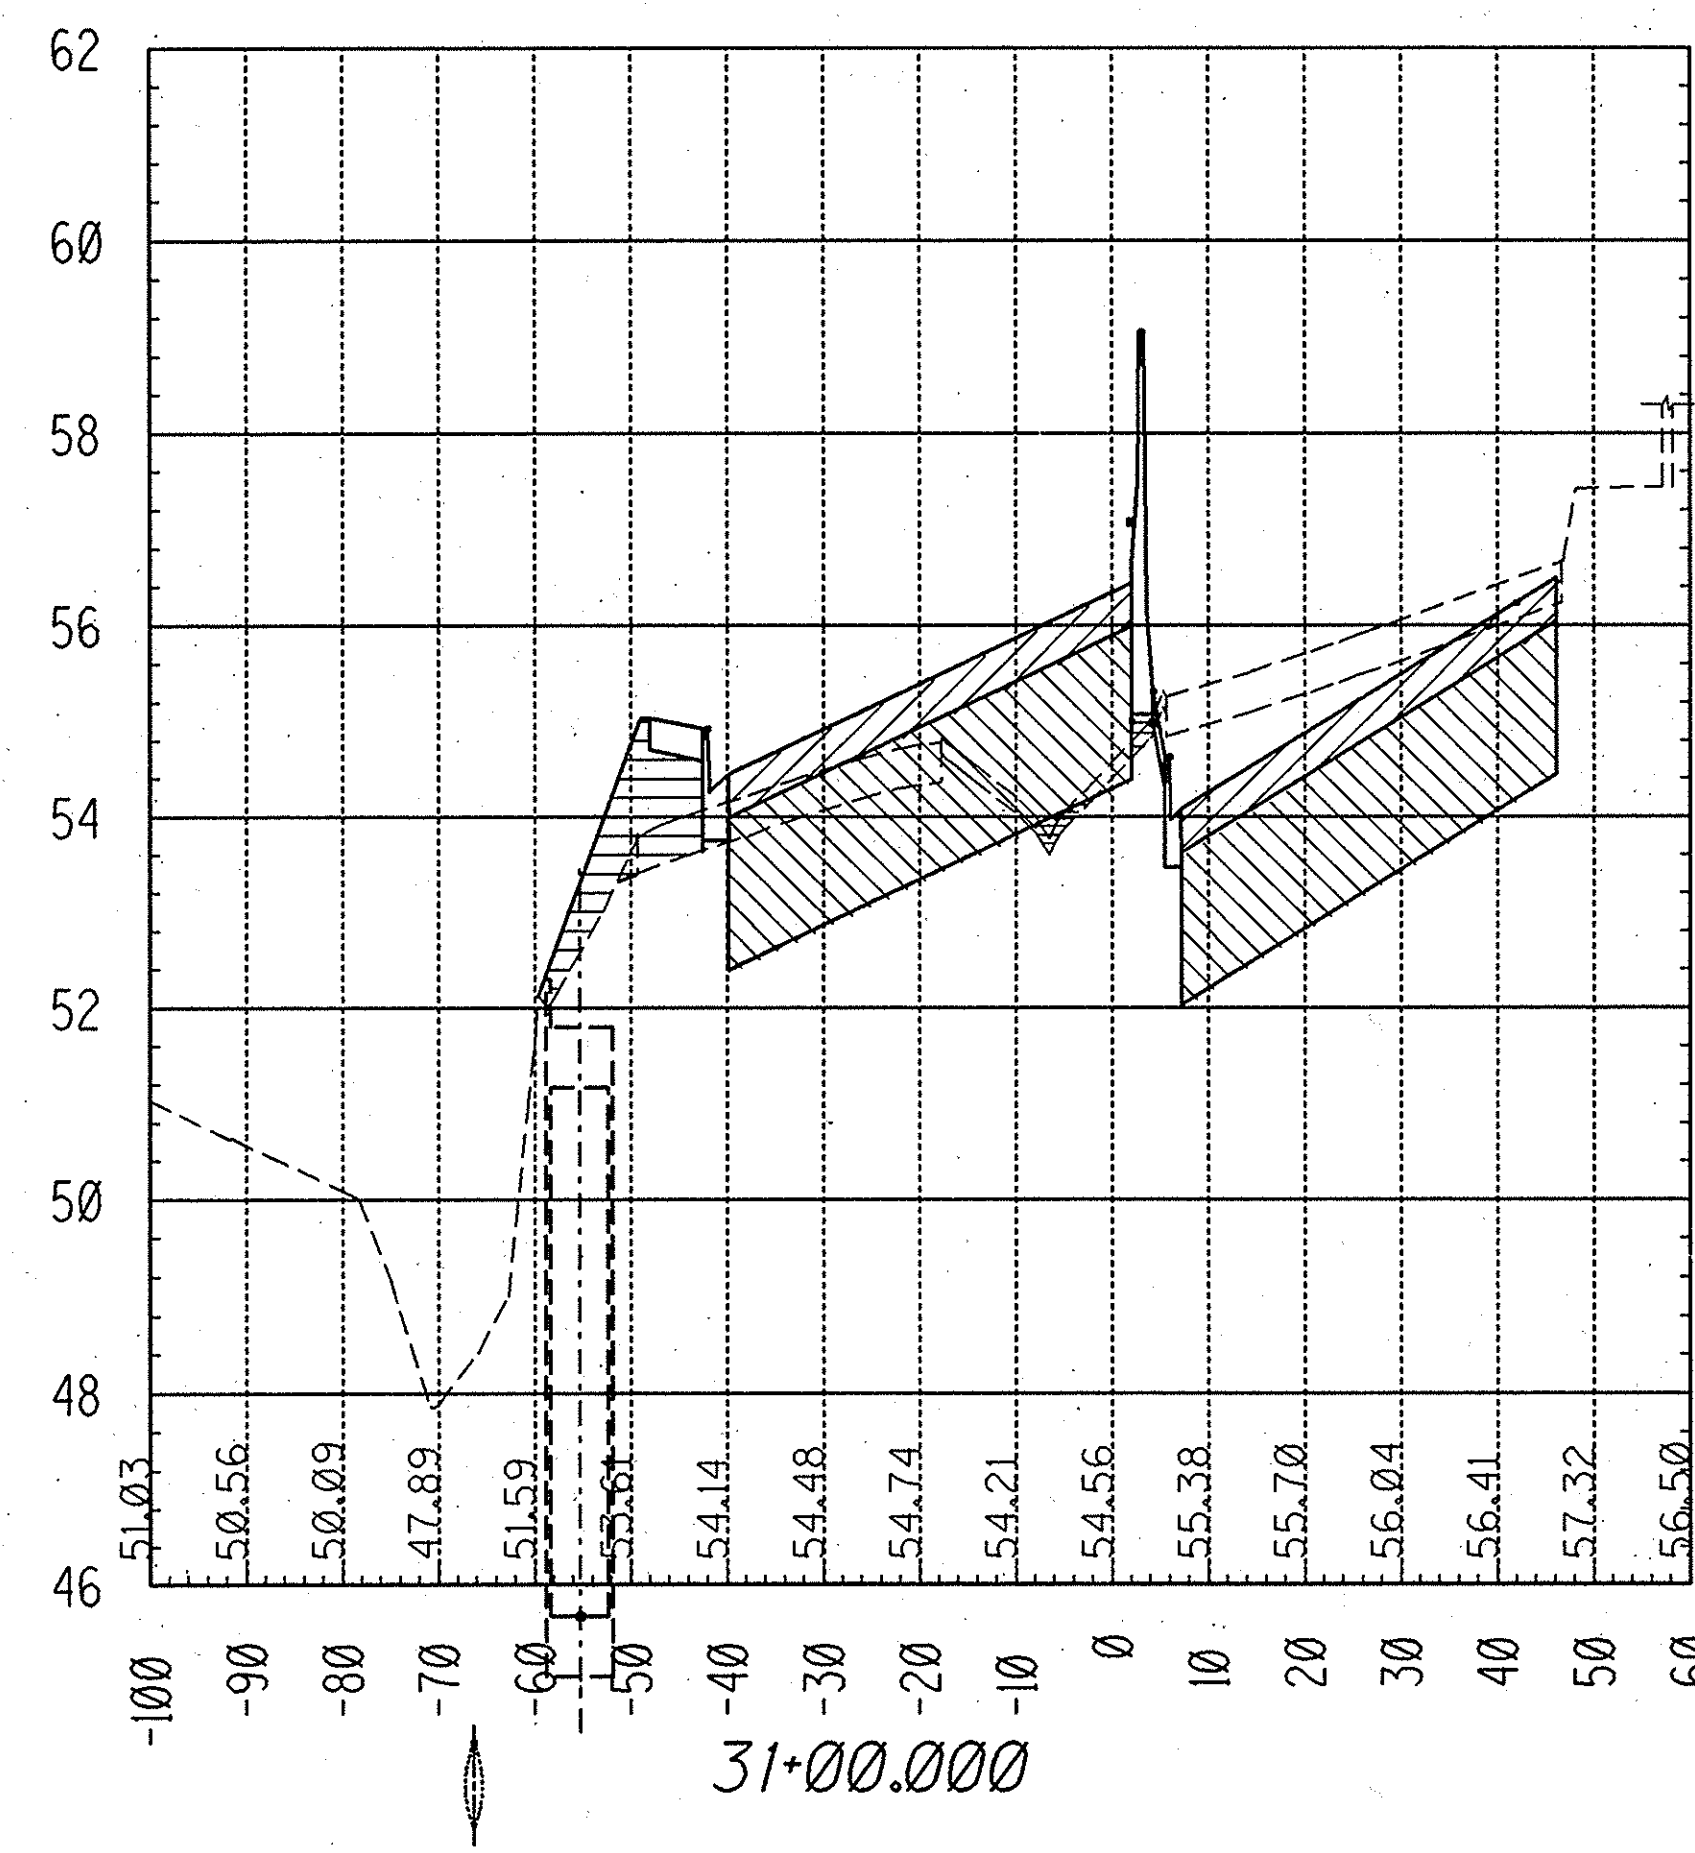
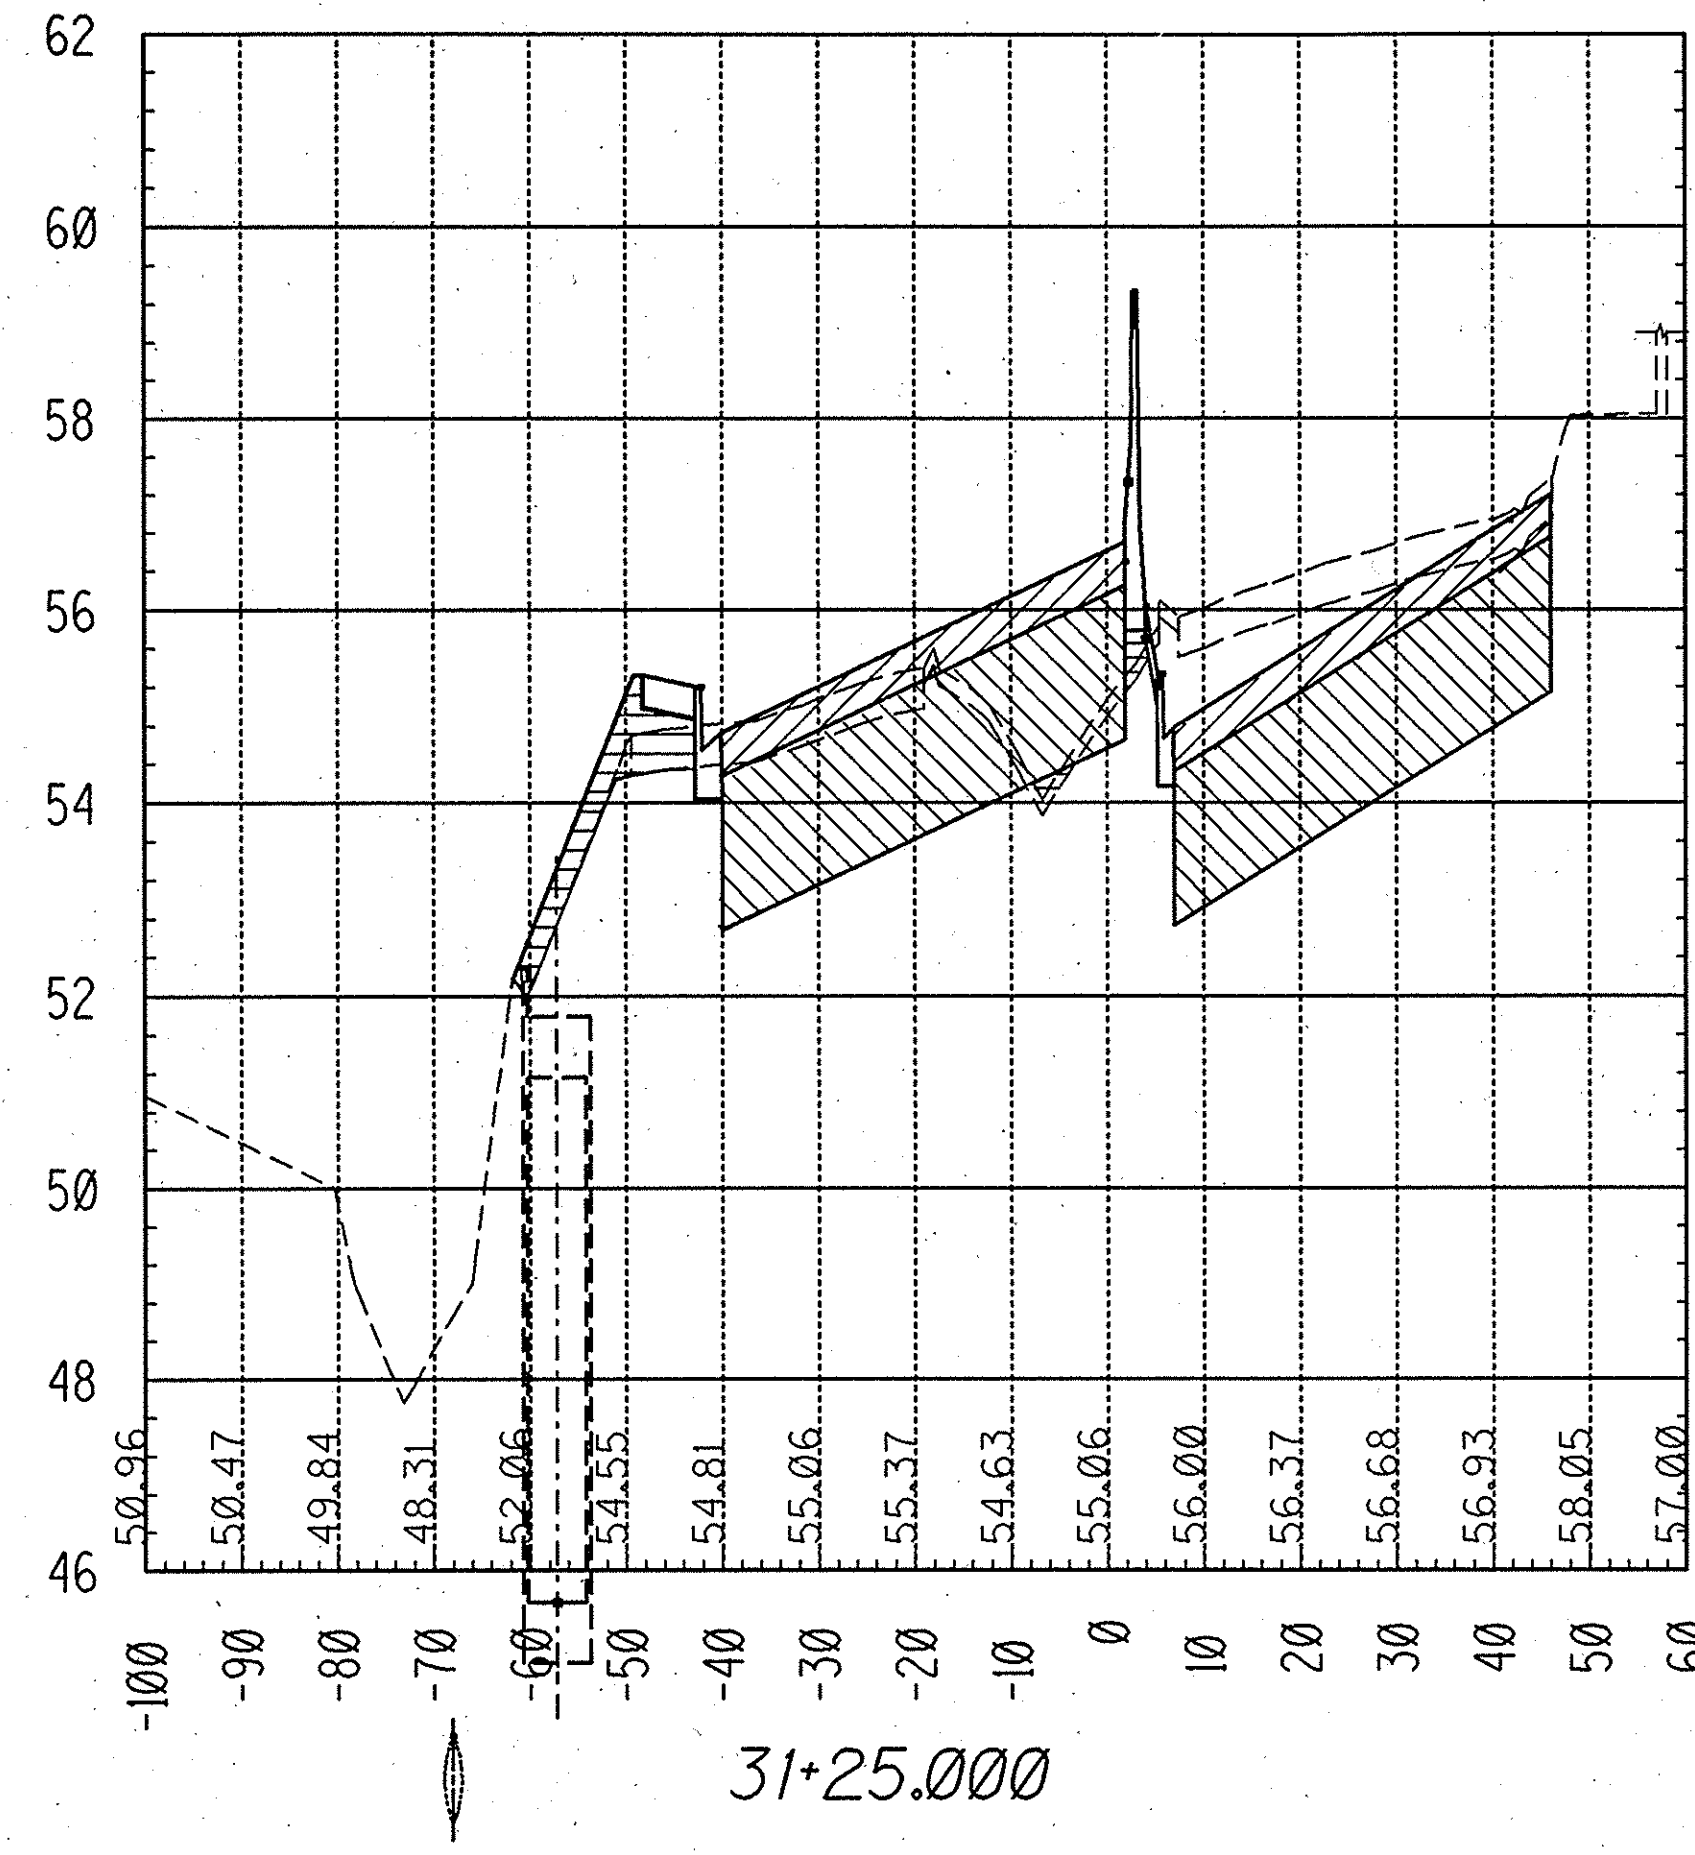
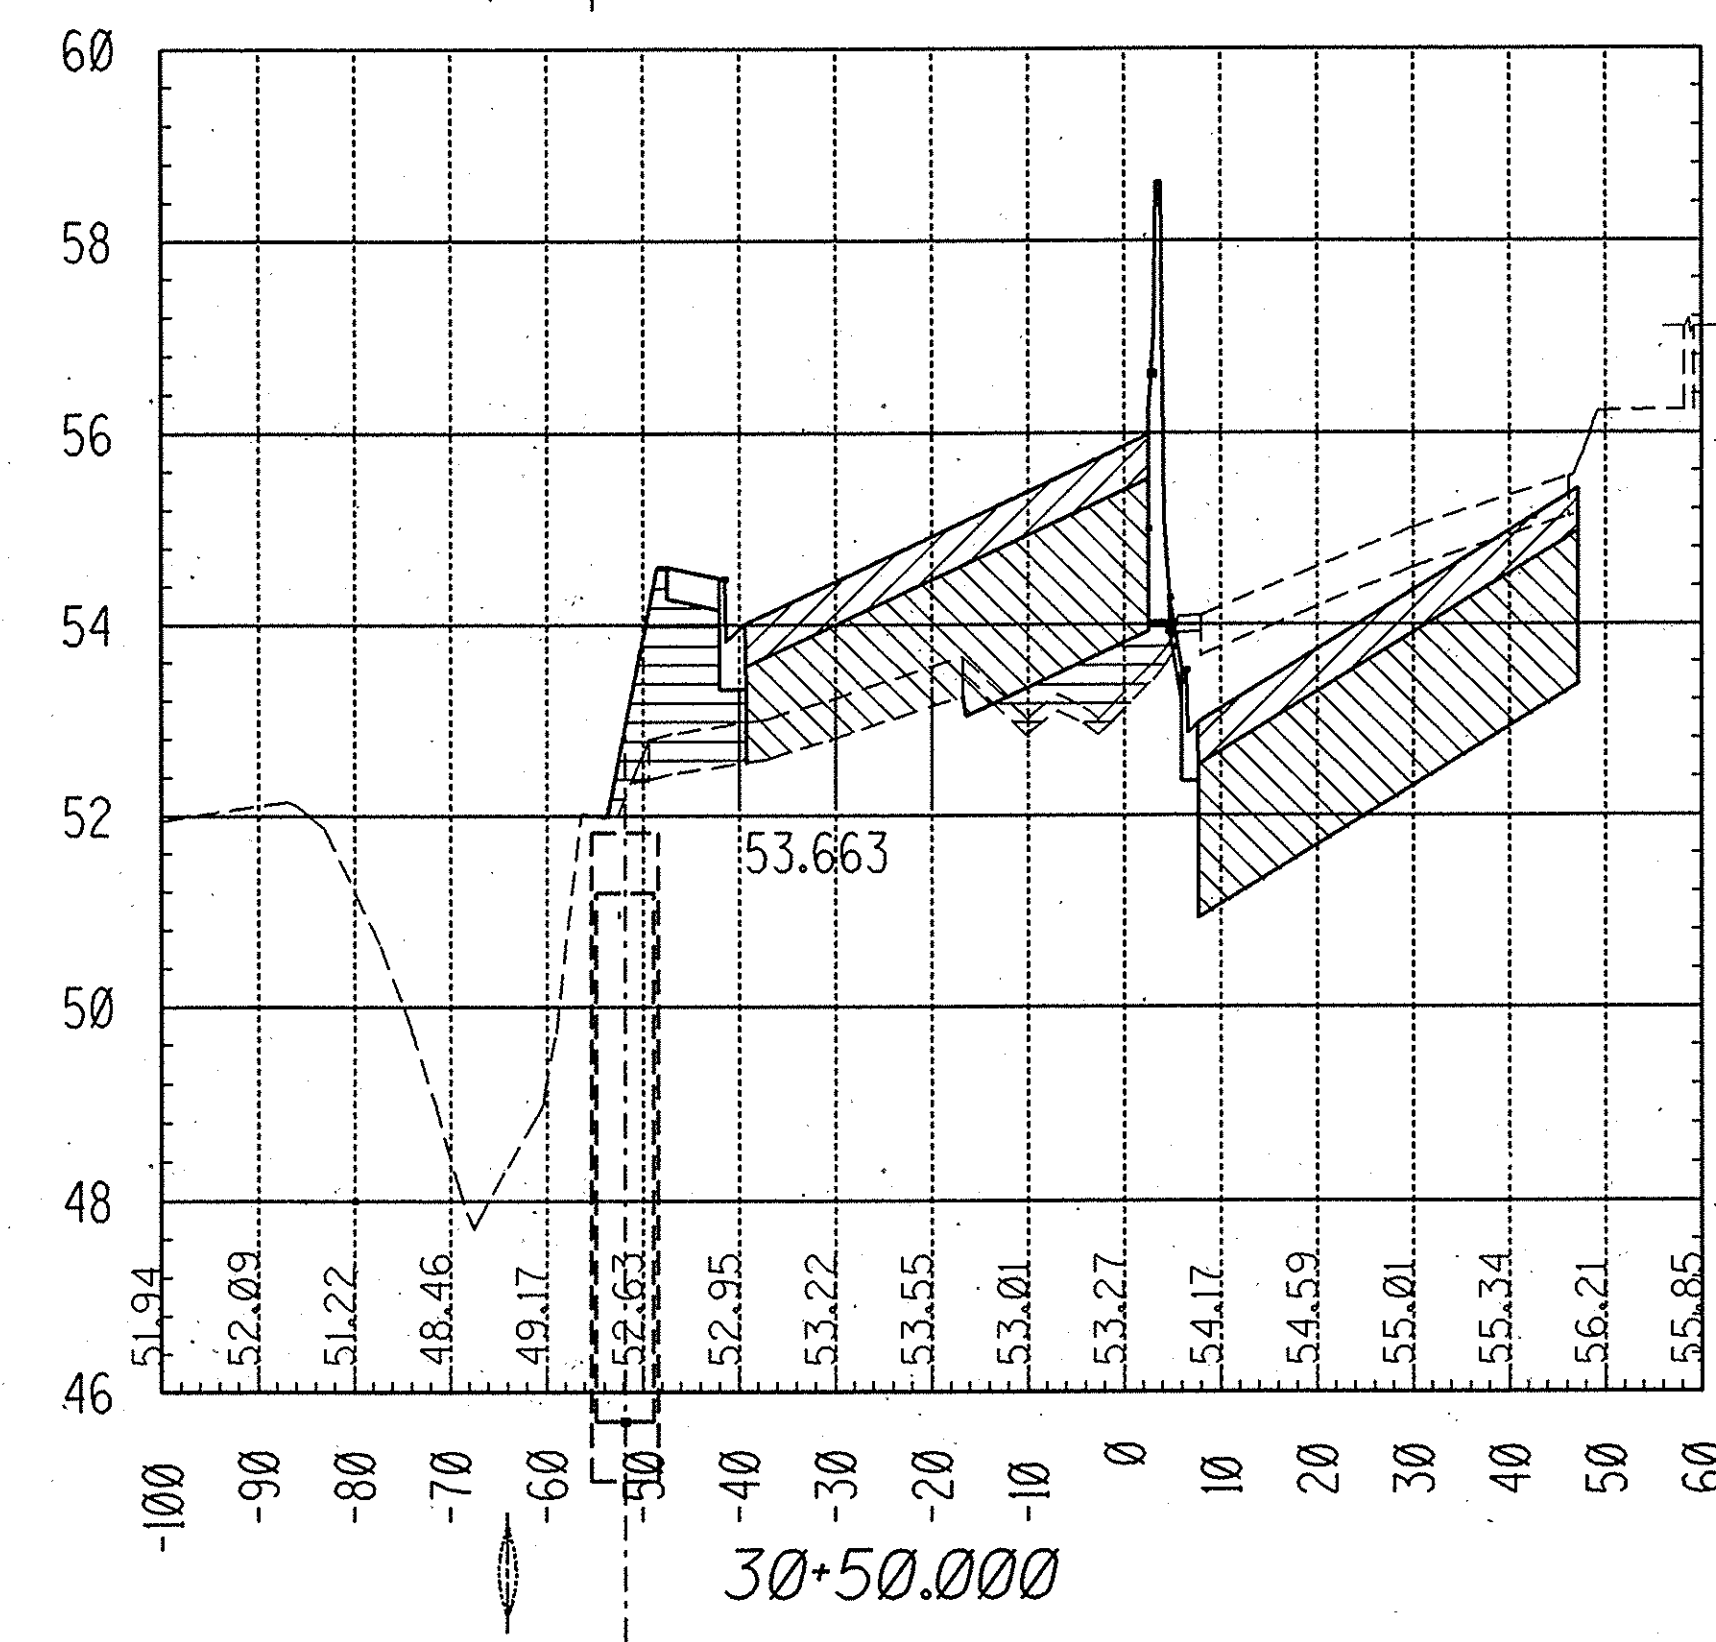


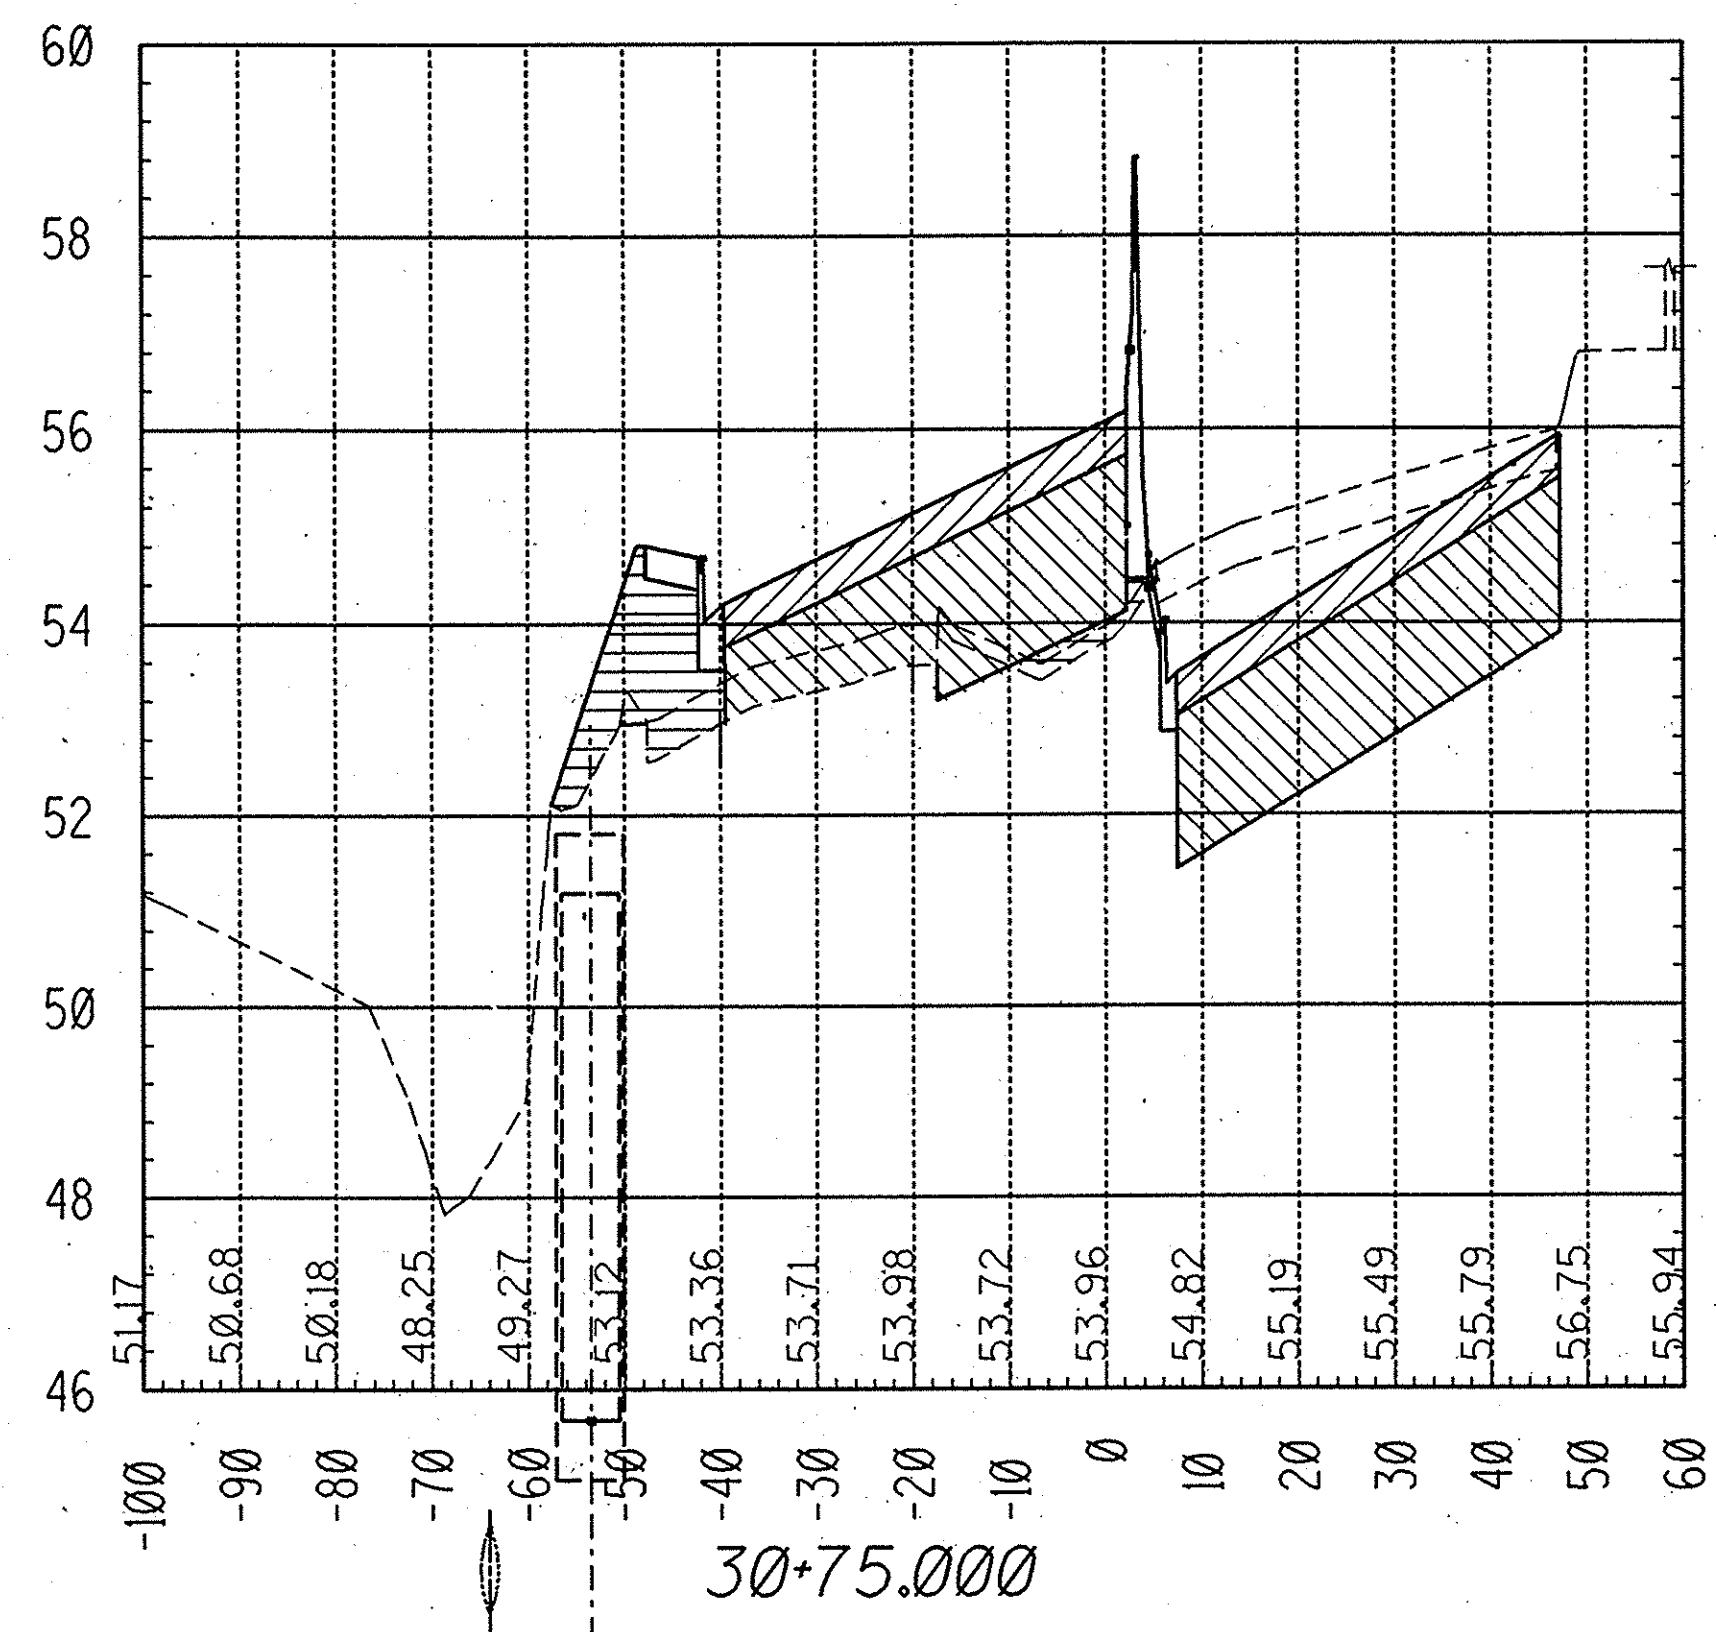

- LEGEND**
- AGGREGATE BASE MATERIAL
 - ASPHALT CONCRETE
 - UNCLASSIFIED FILL

PROFILE
 HORIZ. 1" = 20'
 VERT. 1" = 2'

1 1/2 0 2
 3 inches on original drawing

MARK	DATE	DESCRIPTION
REVISIONS		
PREPARED UNDER		
DESIGNED	DATE	3/4/93
DRAWN	SCALE	3-93
CHECKED	DATE	
RICHARD HART RCE 39595 (exp. 12-31-93)		

RECORD DRAWING

ORANGE COUNTY
 ENVIRONMENTAL MANAGEMENT AGENCY

HARBOR BLVD. IMPROVEMENTS

CROSS SECTIONS
 30+50 to 31+50

DESIGNED: BRS
 DRAWN: SG/AHP
 CHECKED: RAH
 SCALE: AS SHOWN
 DATE: 3-93
 SHEET 51 OF 60