
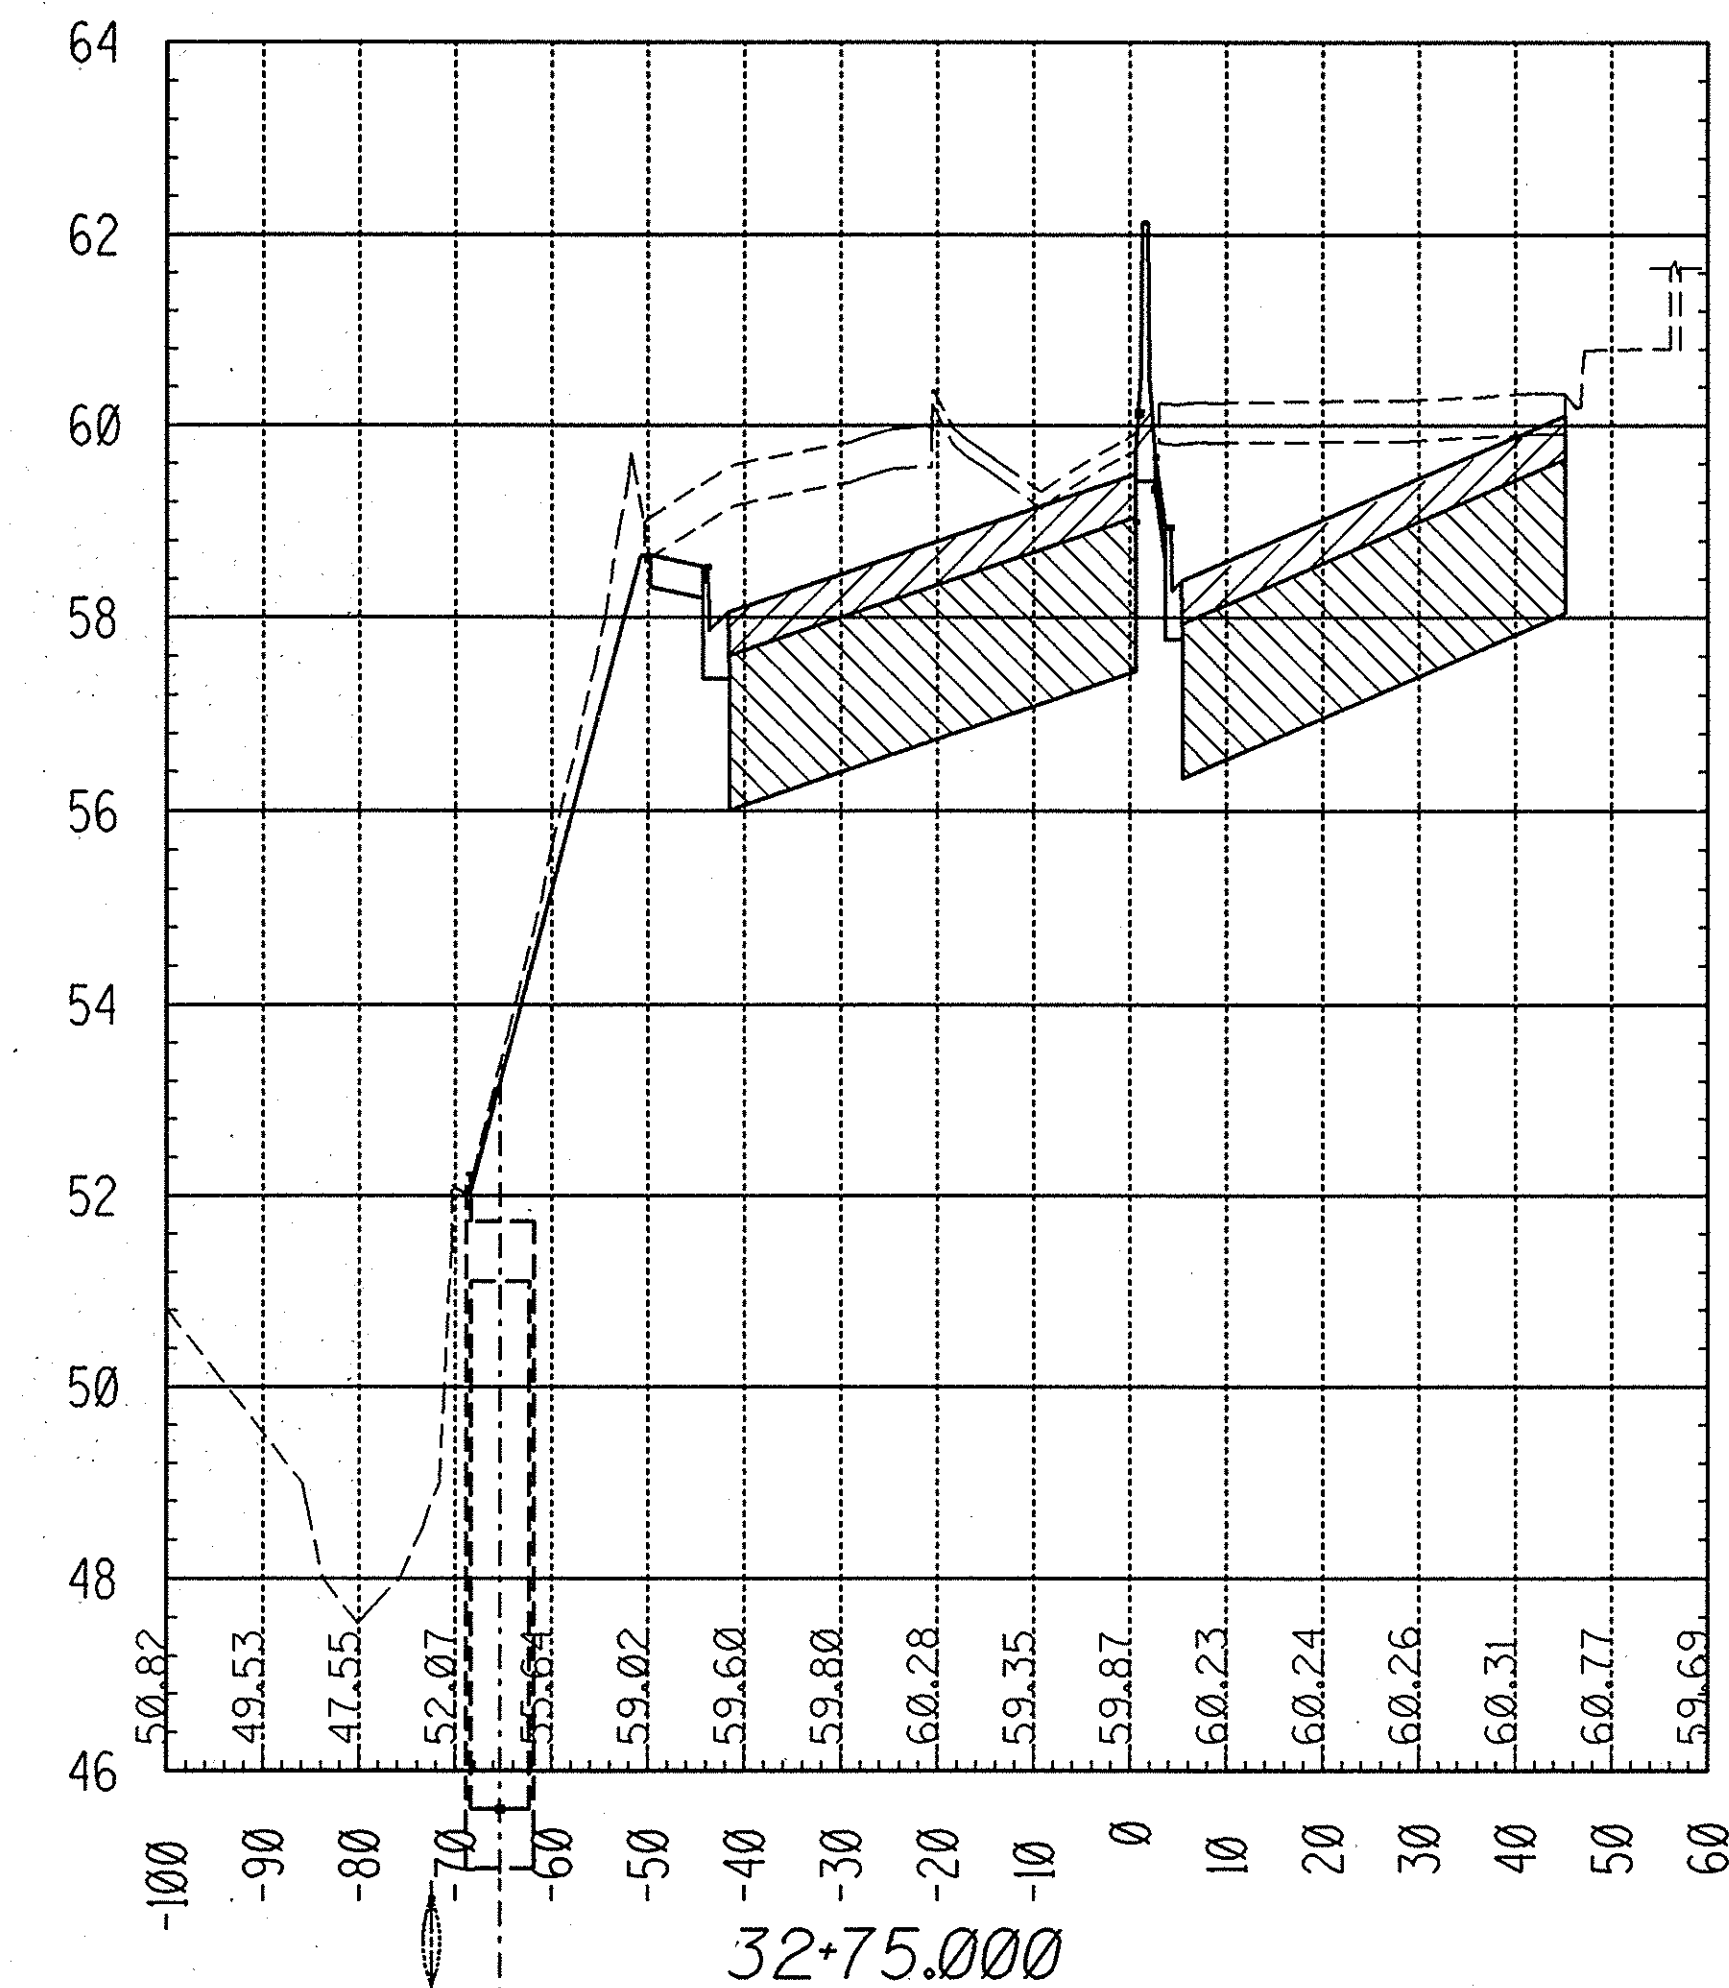
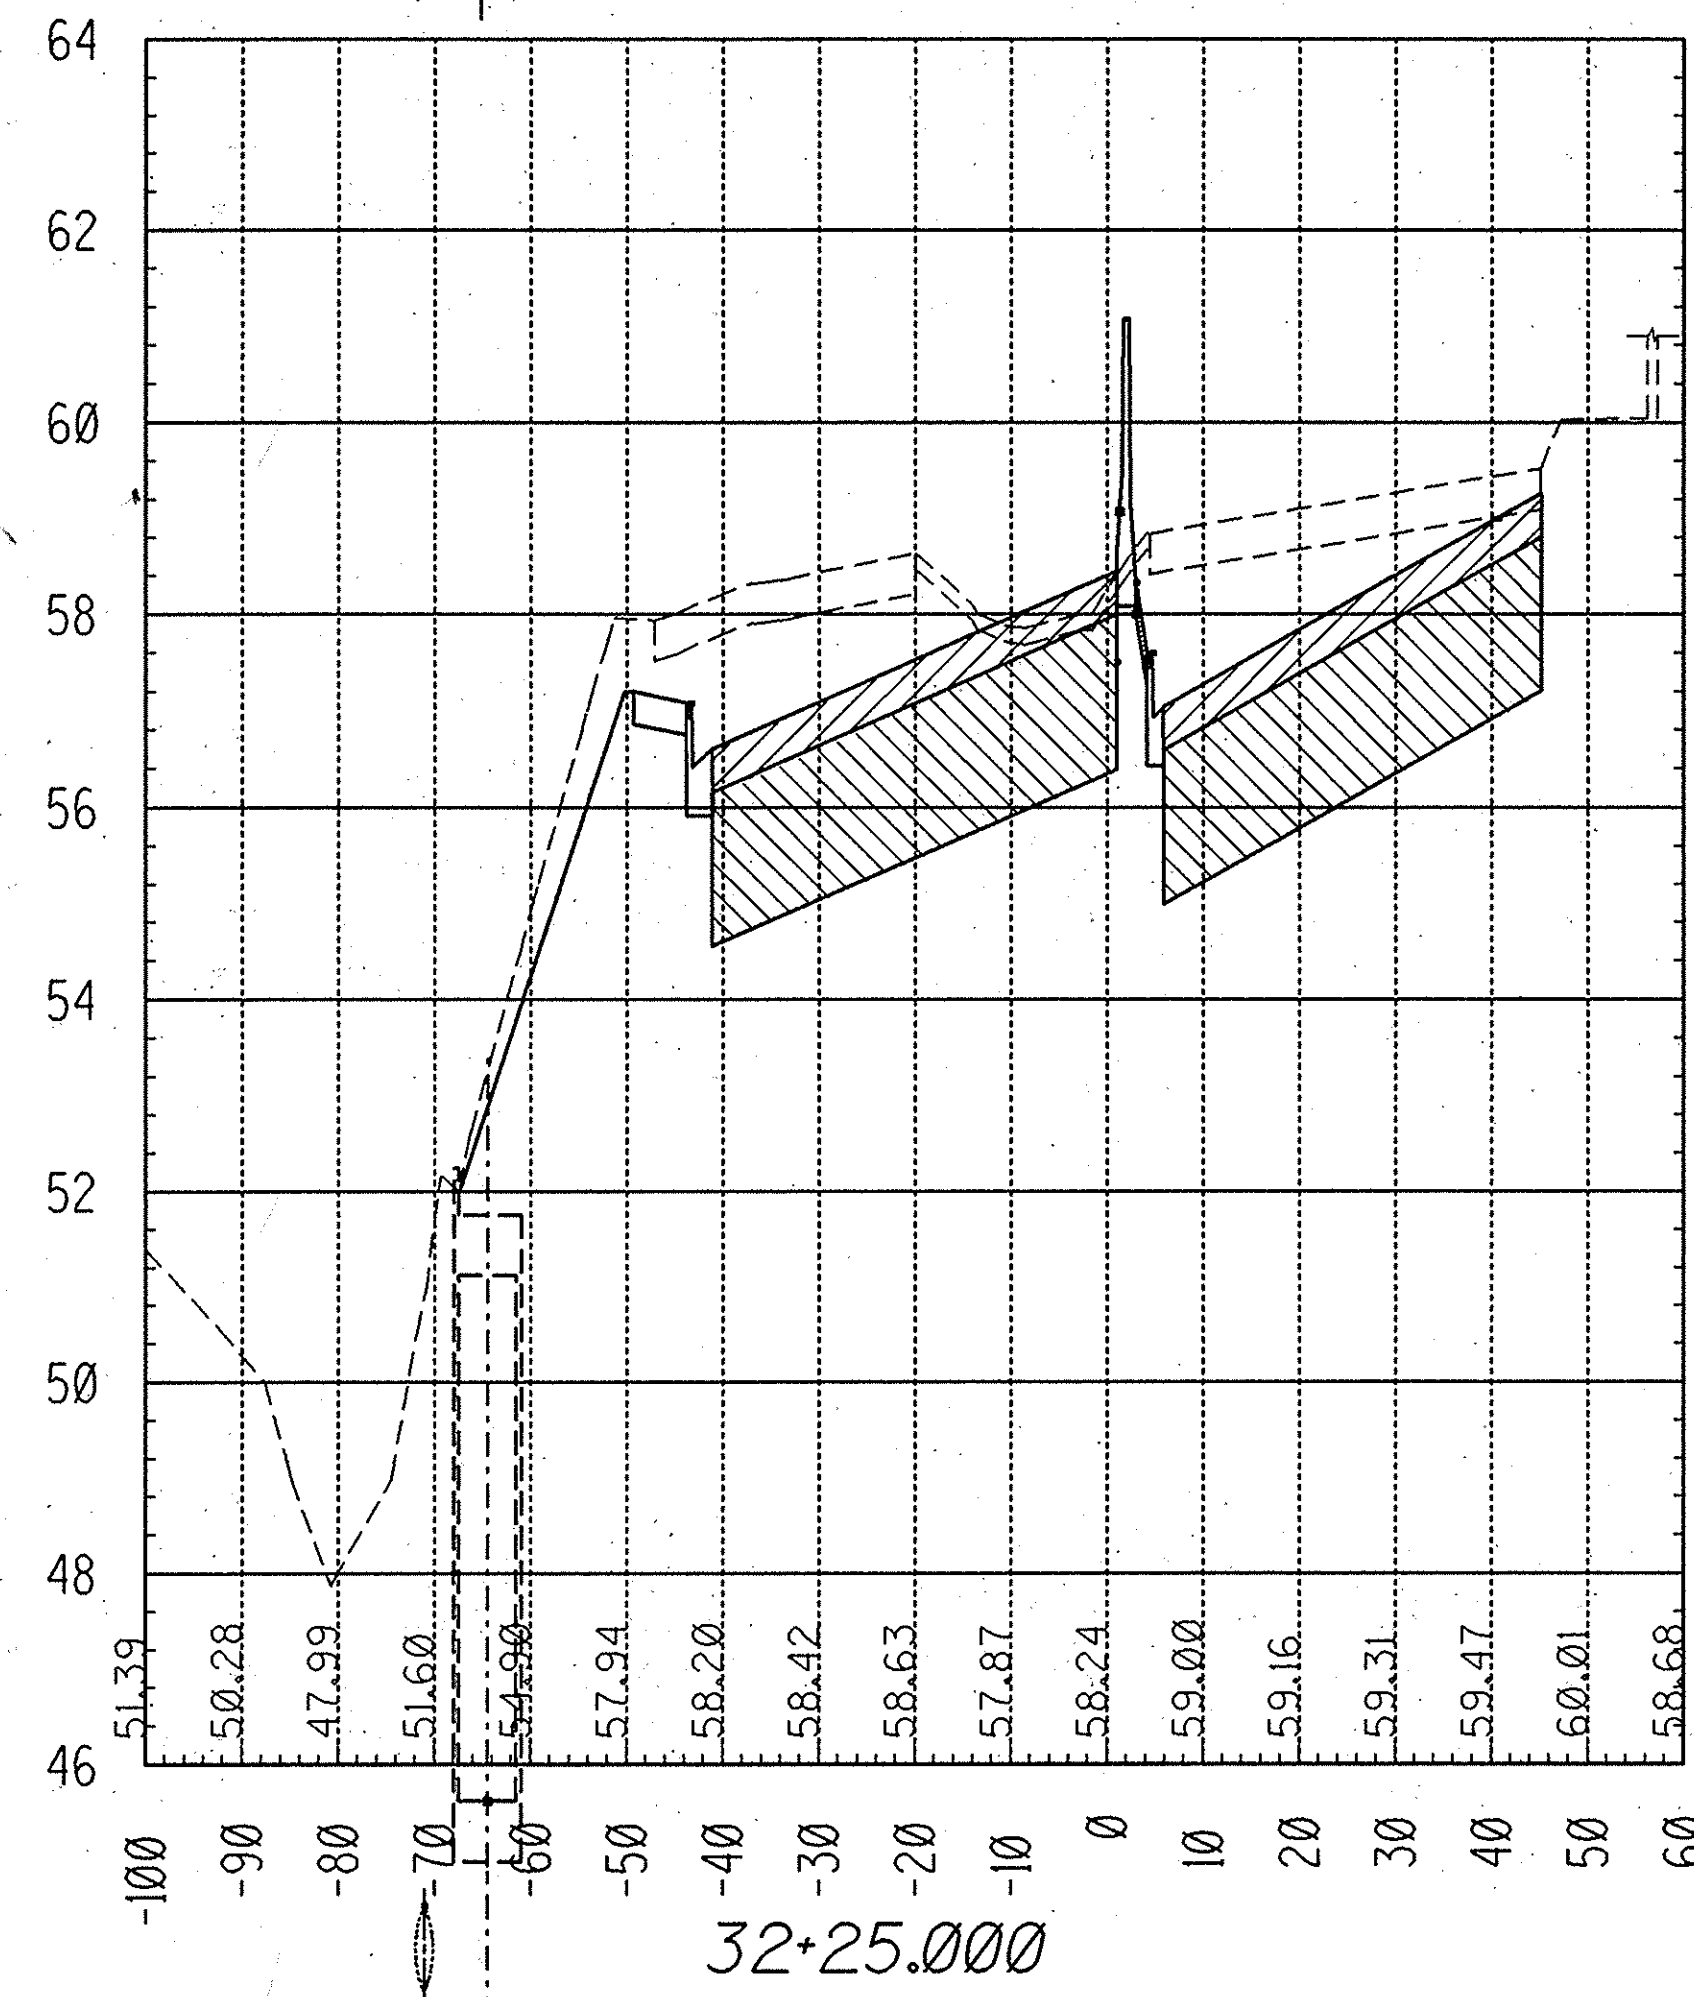
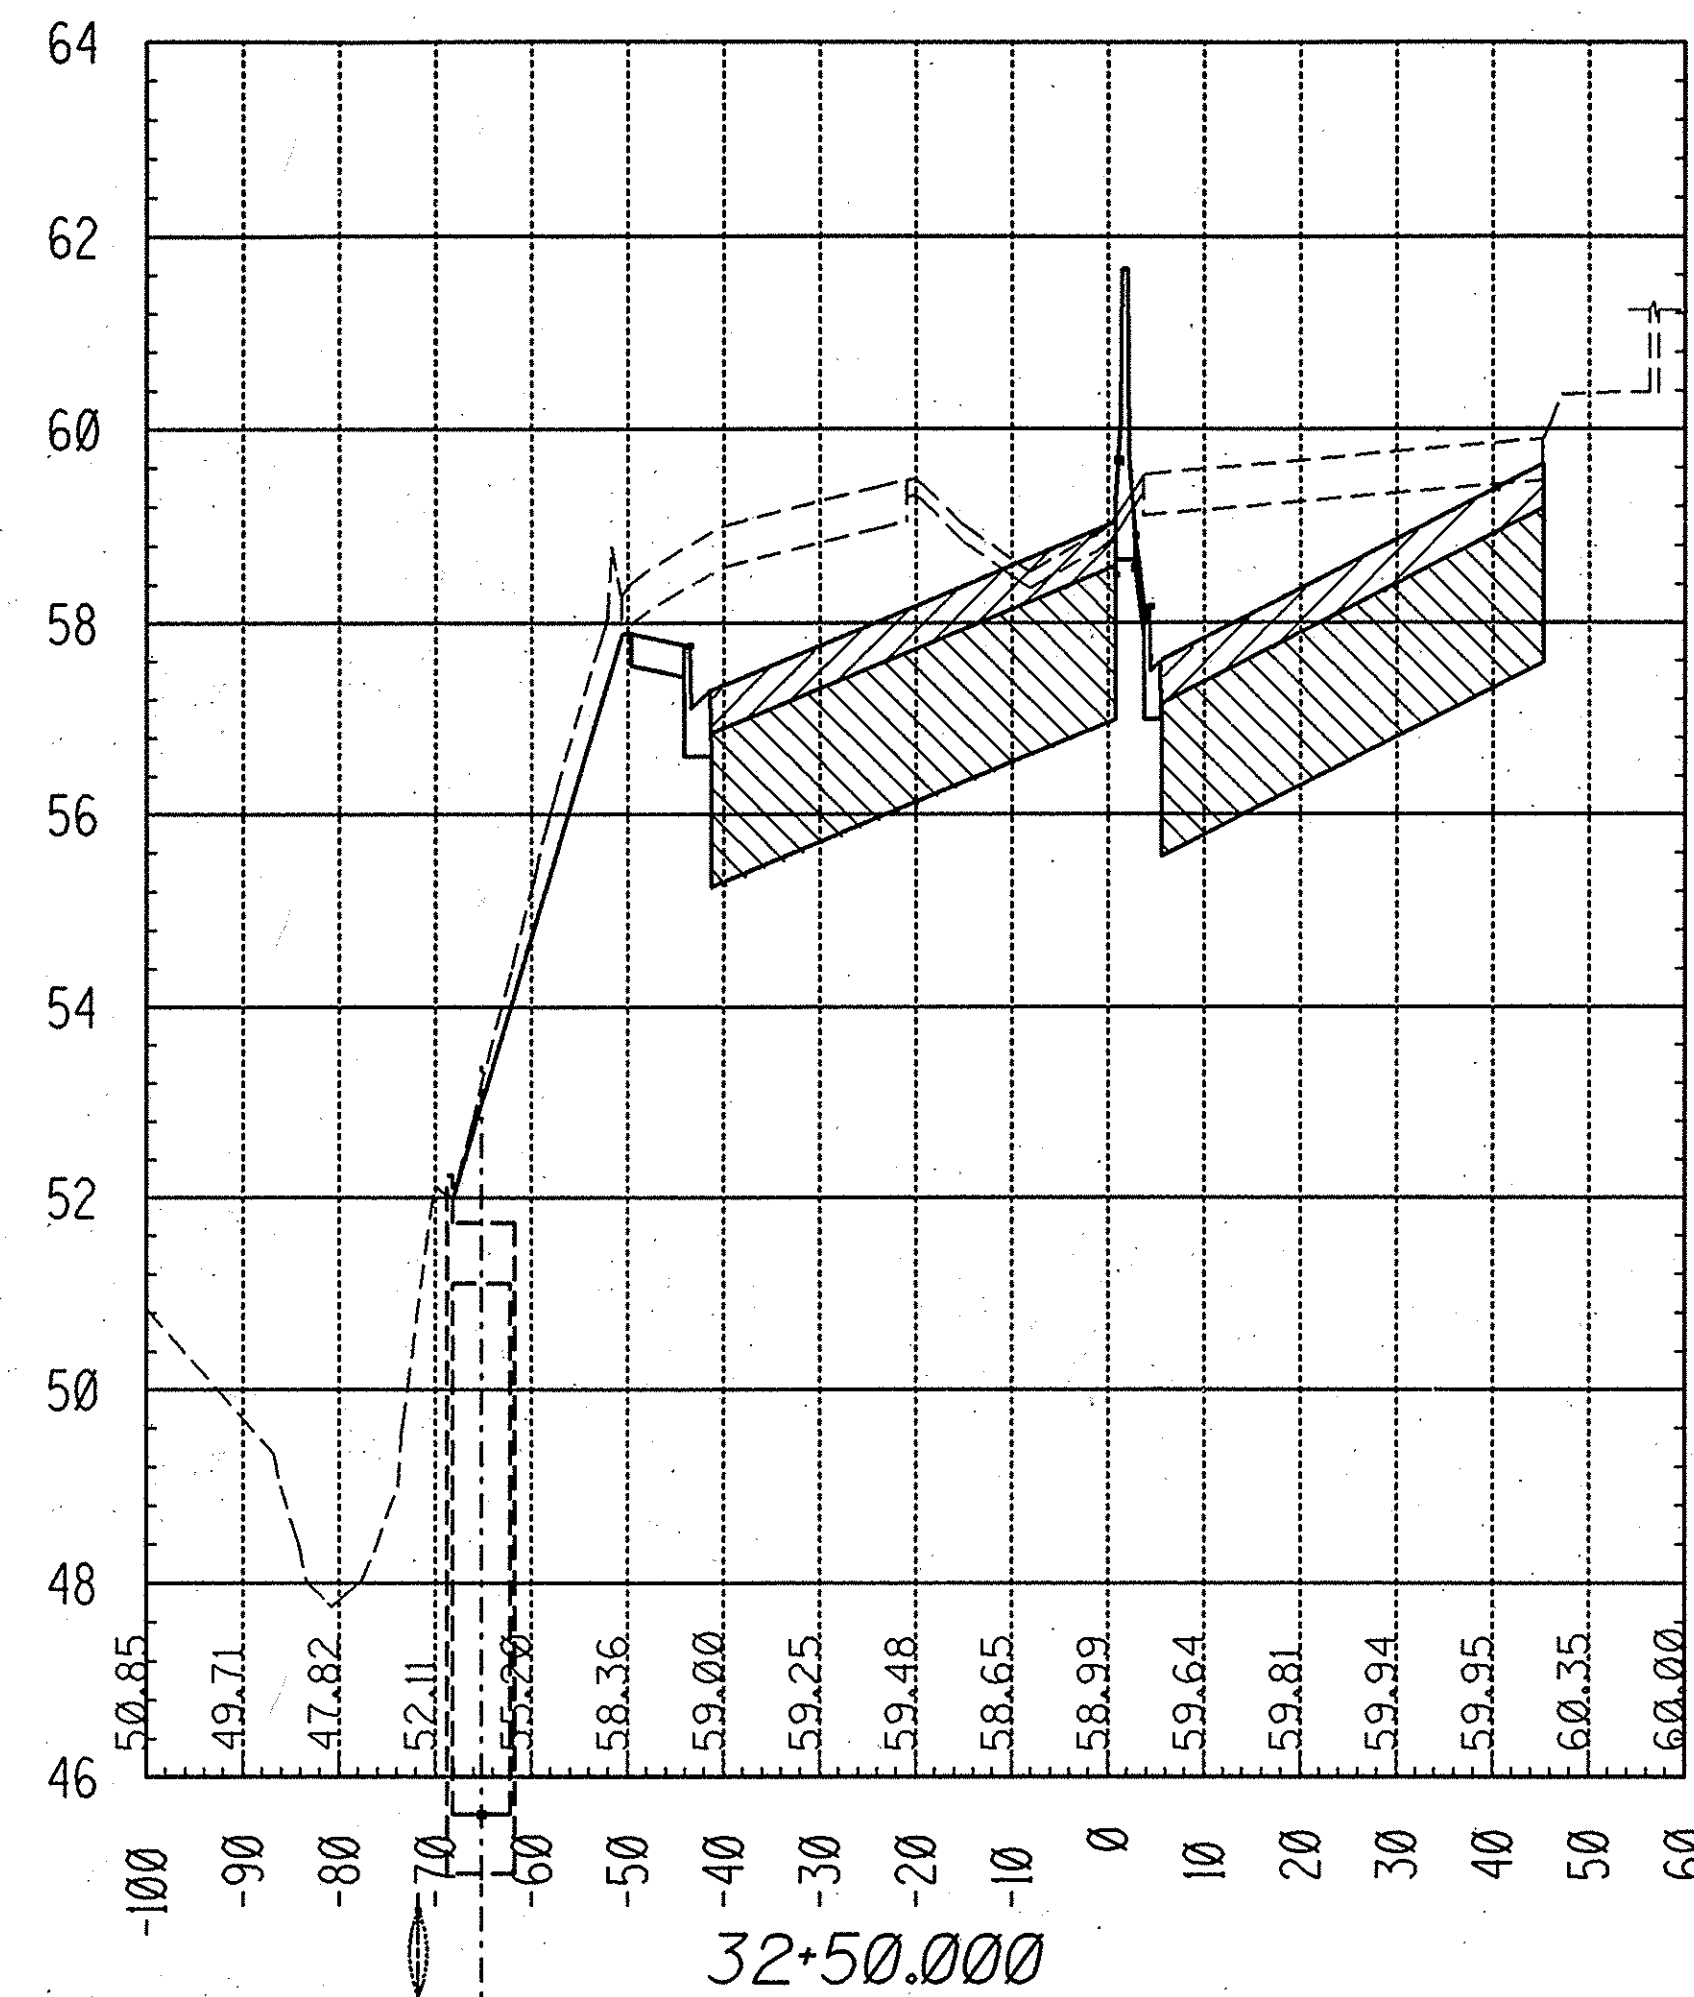
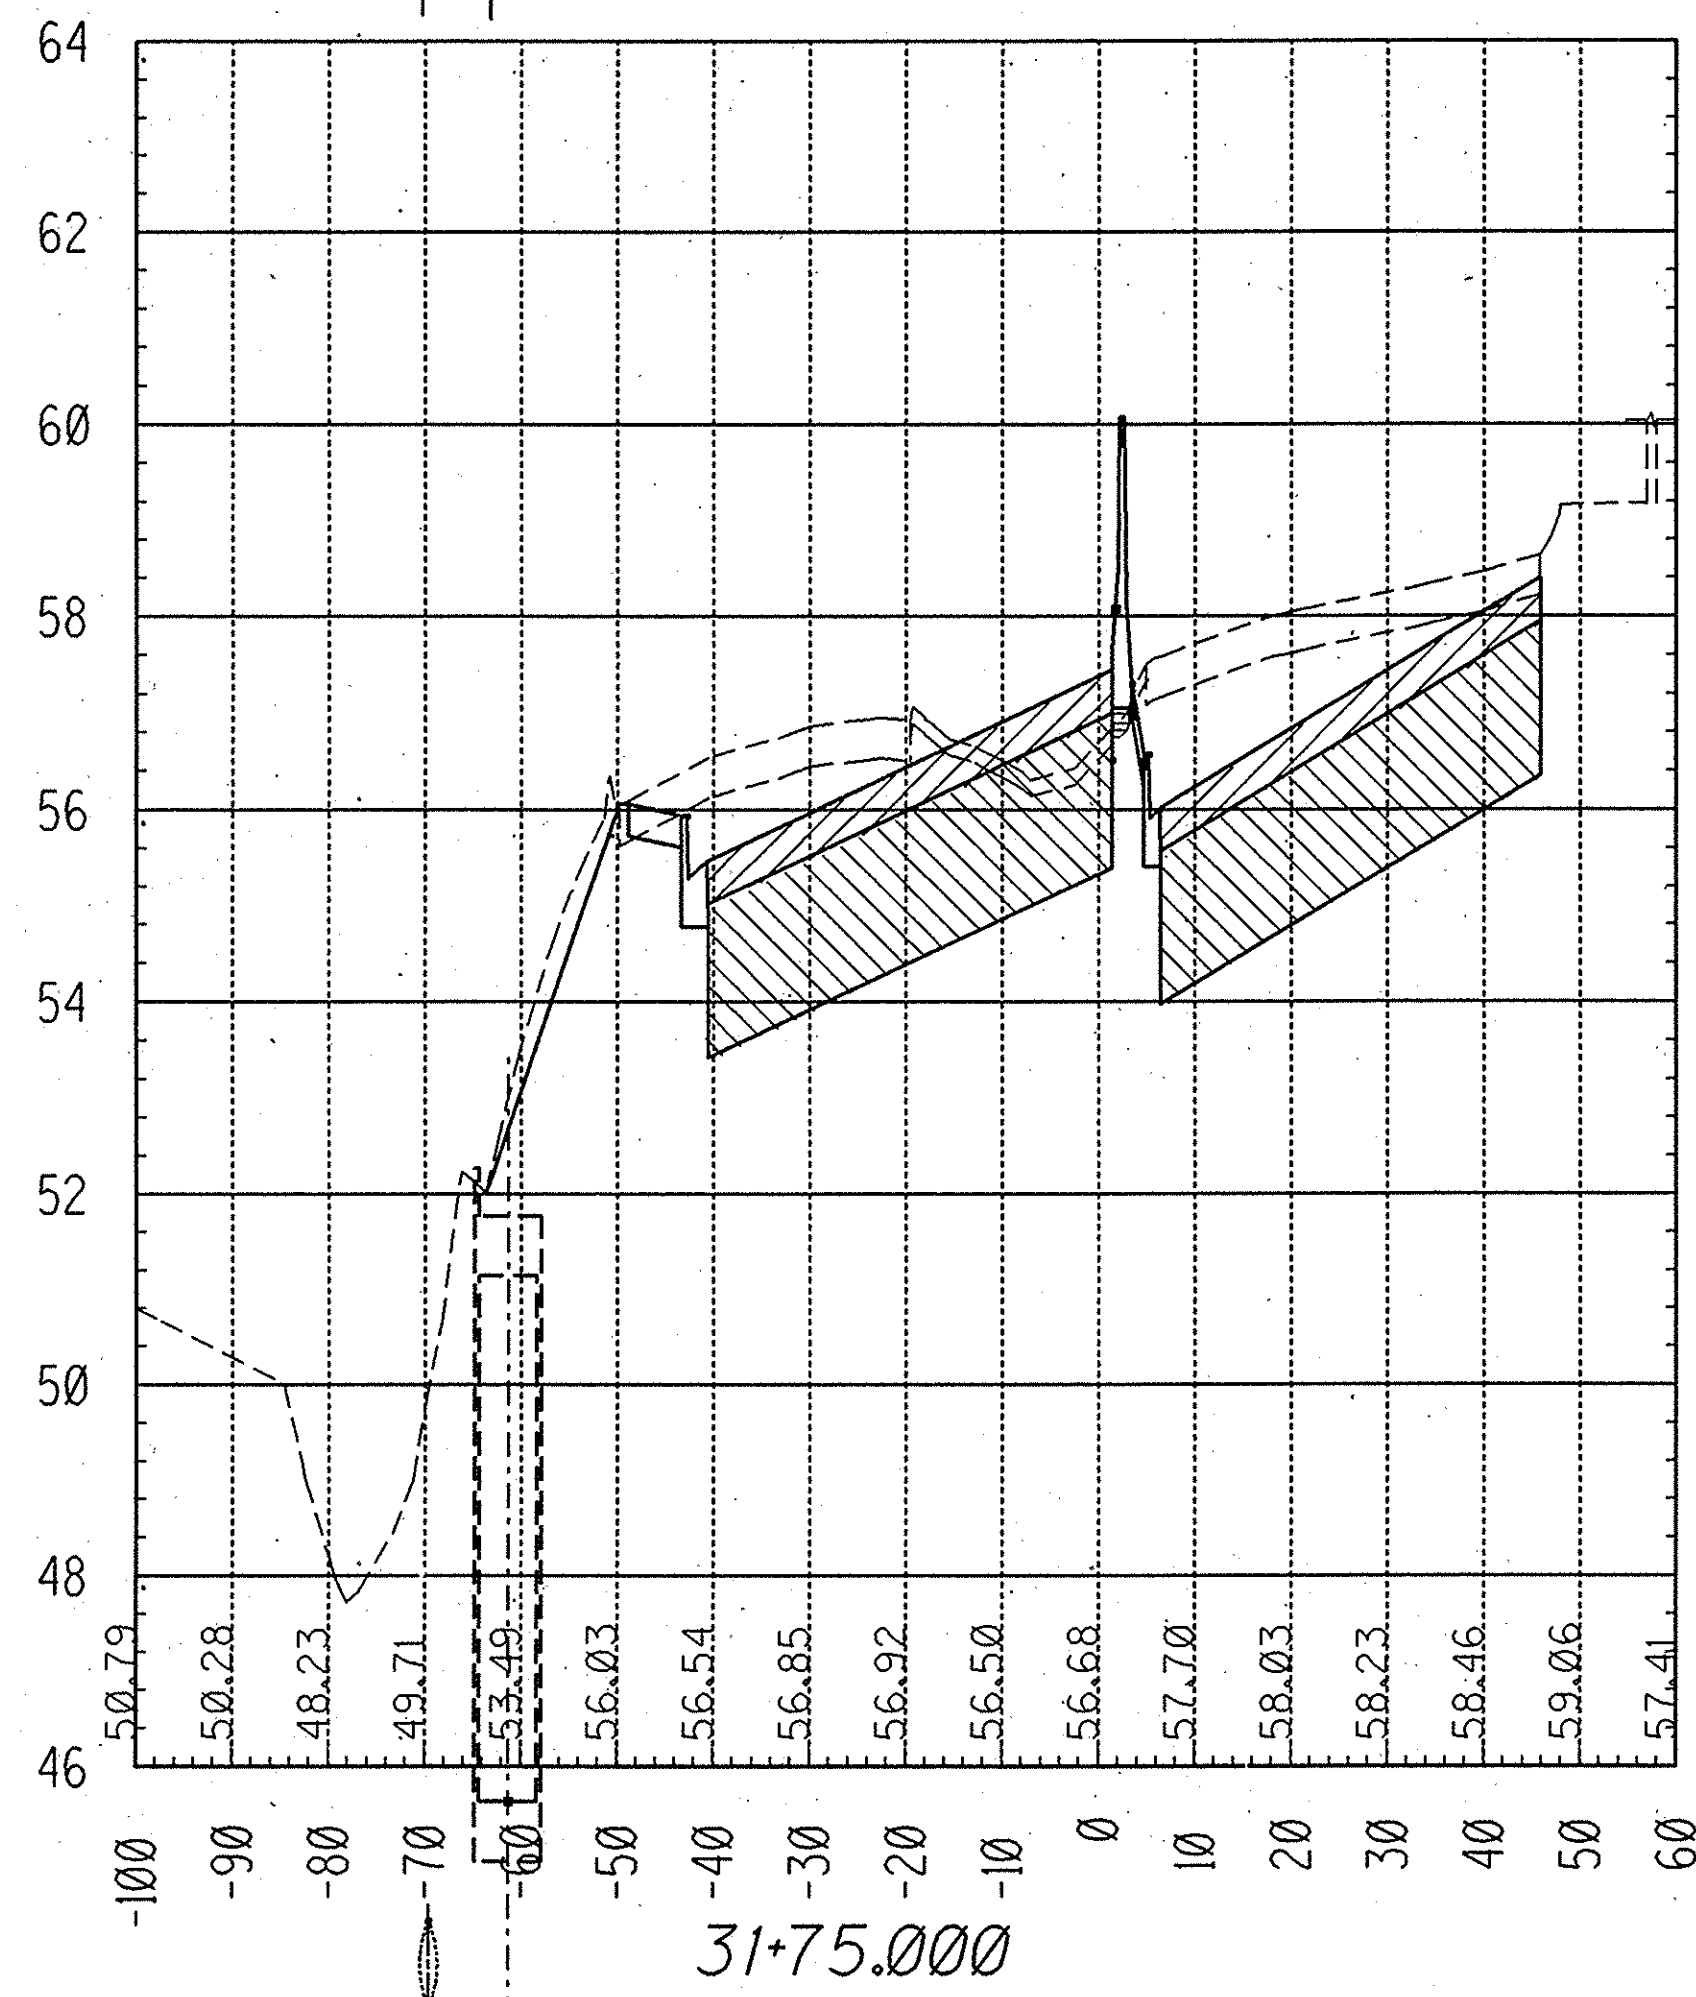


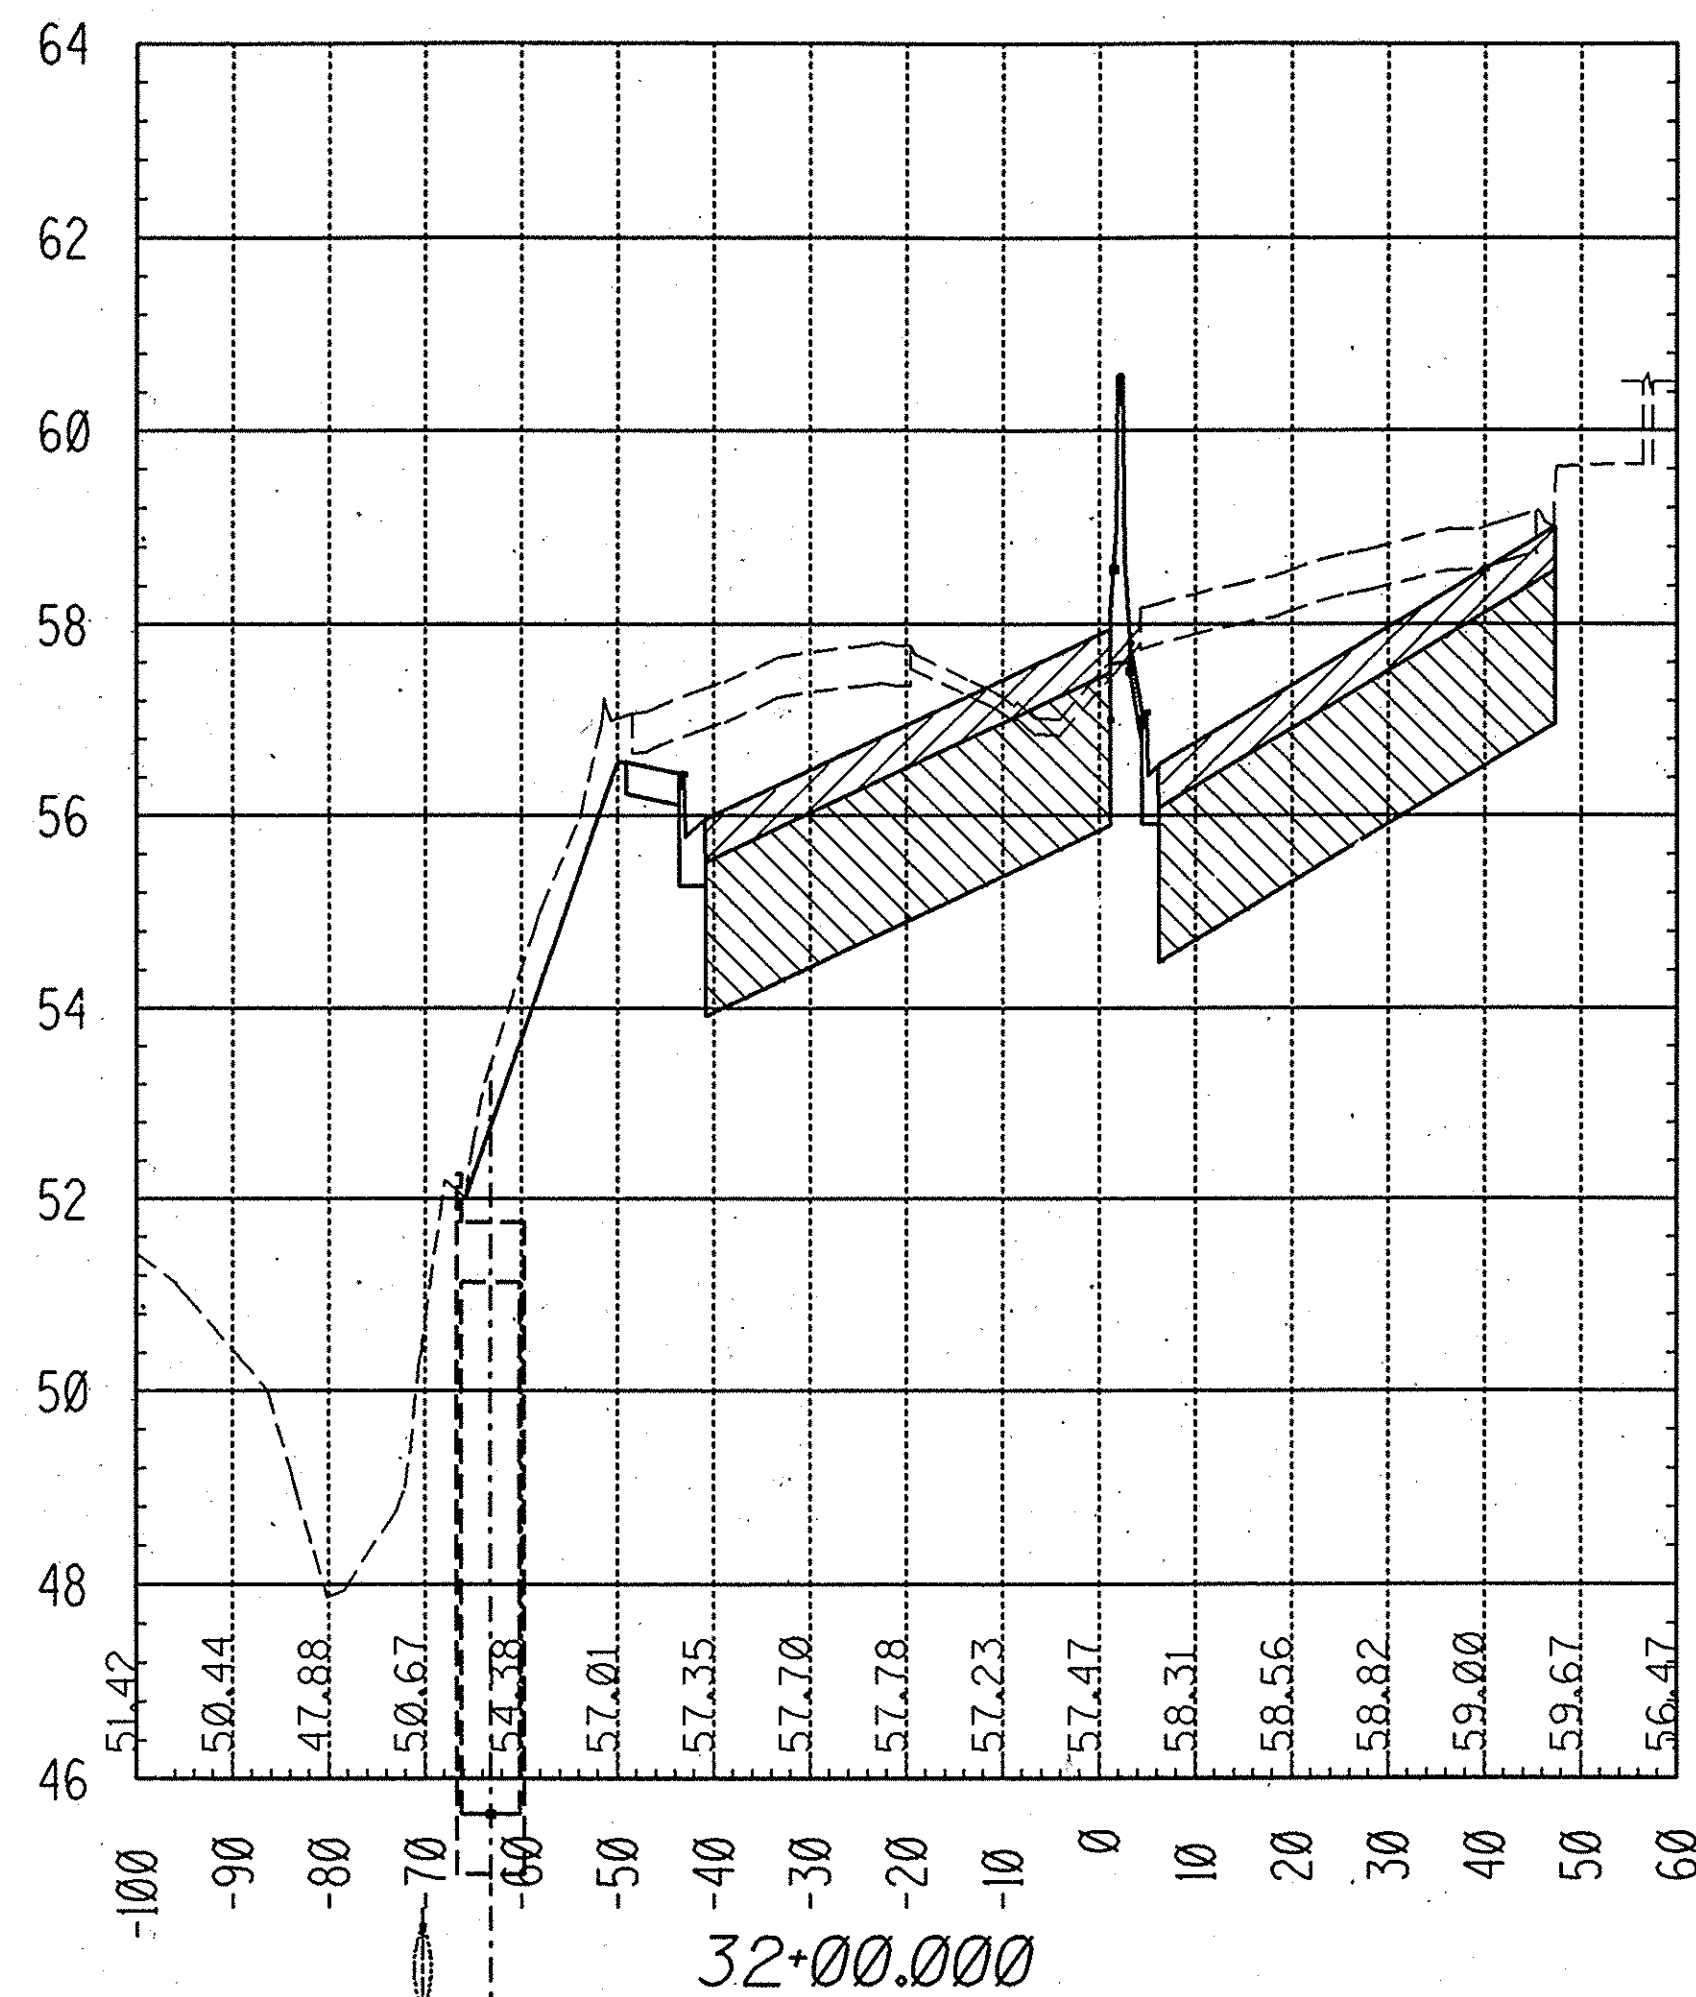

LEGEND

- AGGREGATE BASE MATERIAL
- ASPHALT CONCRETE
- UNCLASSIFIED FILL

PROFILE
HORIZ. 1"=20'
VERT. 1"=2'

1/2 0 2
3 inches on original drawing

RECORD DRAWING

ORANGE COUNTY ENVIRONMENTAL MANAGEMENT AGENCY	
HARBOR BLVD. IMPROVEMENTS	
CROSS SECTIONS 31+75 to 32+75	
DESIGNED: RRS	SHEET 52 OF 60
DRAWN: SG/AHP	CHECKED: RAH
SCALE: AS SHOWN	DATE: 3-93
DRAWING NO.	

REVISIONS

PREPARED UNDER

REGISTERED PROFESSIONAL ENGINEER
No. 39595
Exp. 12/31/93
CIVIL
STATE OF CALIFORNIA

RICHARD HART
RCE 39595 (exp. 12-31-93)

3/4/93