
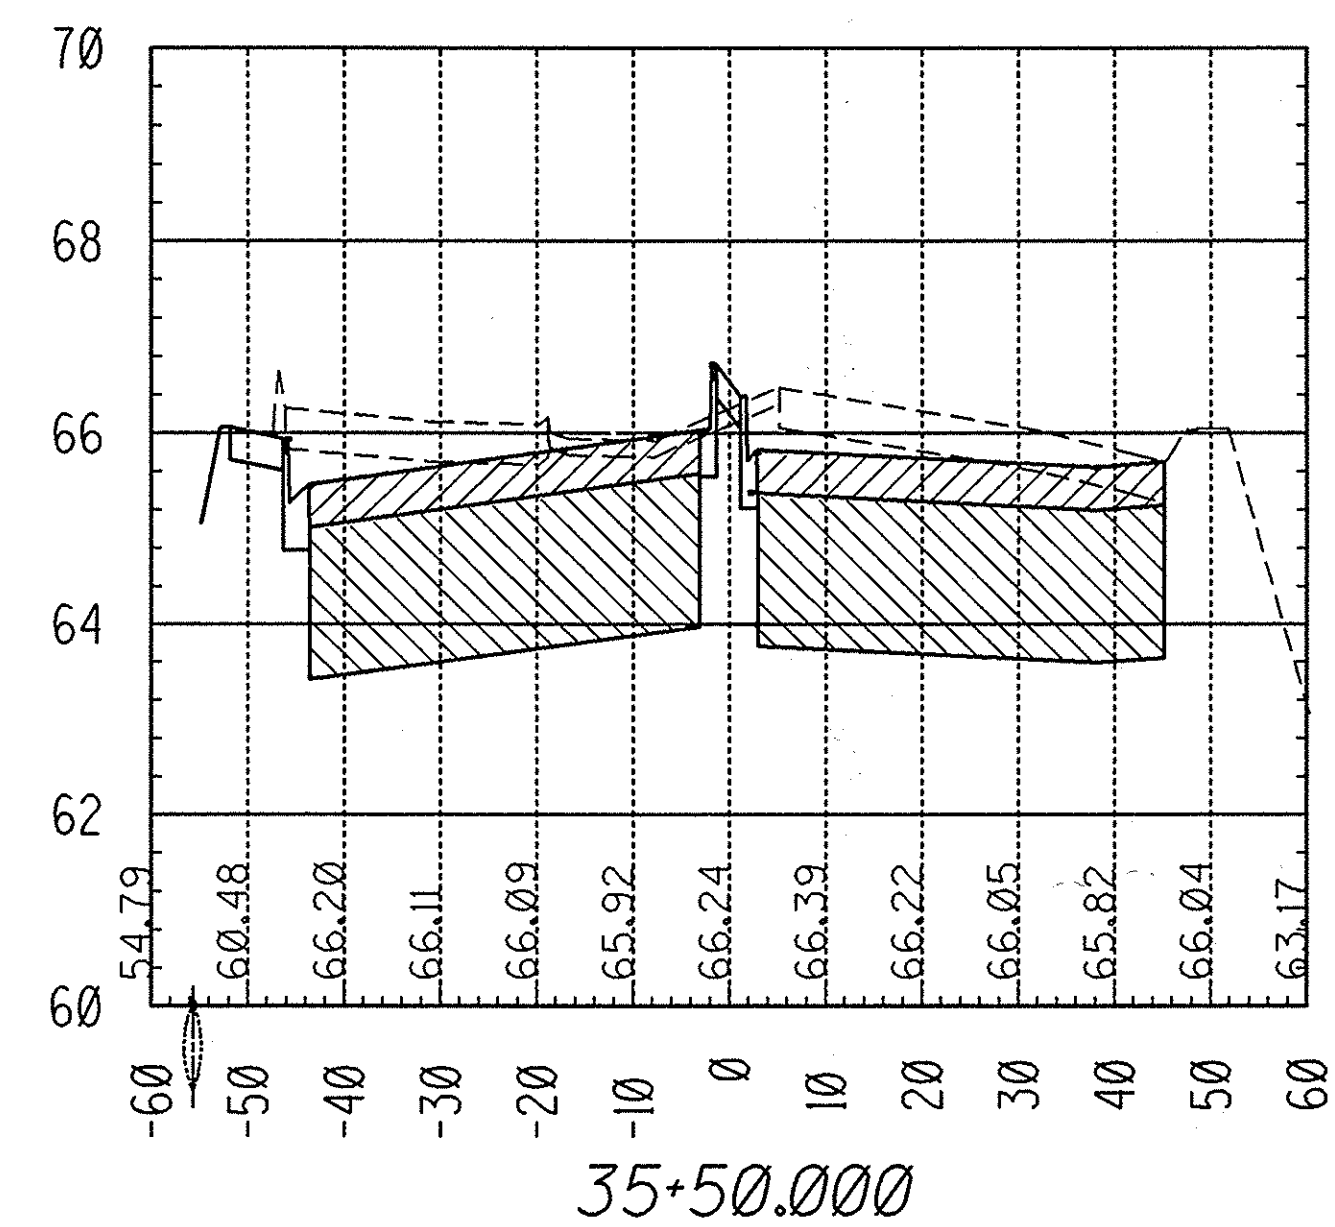
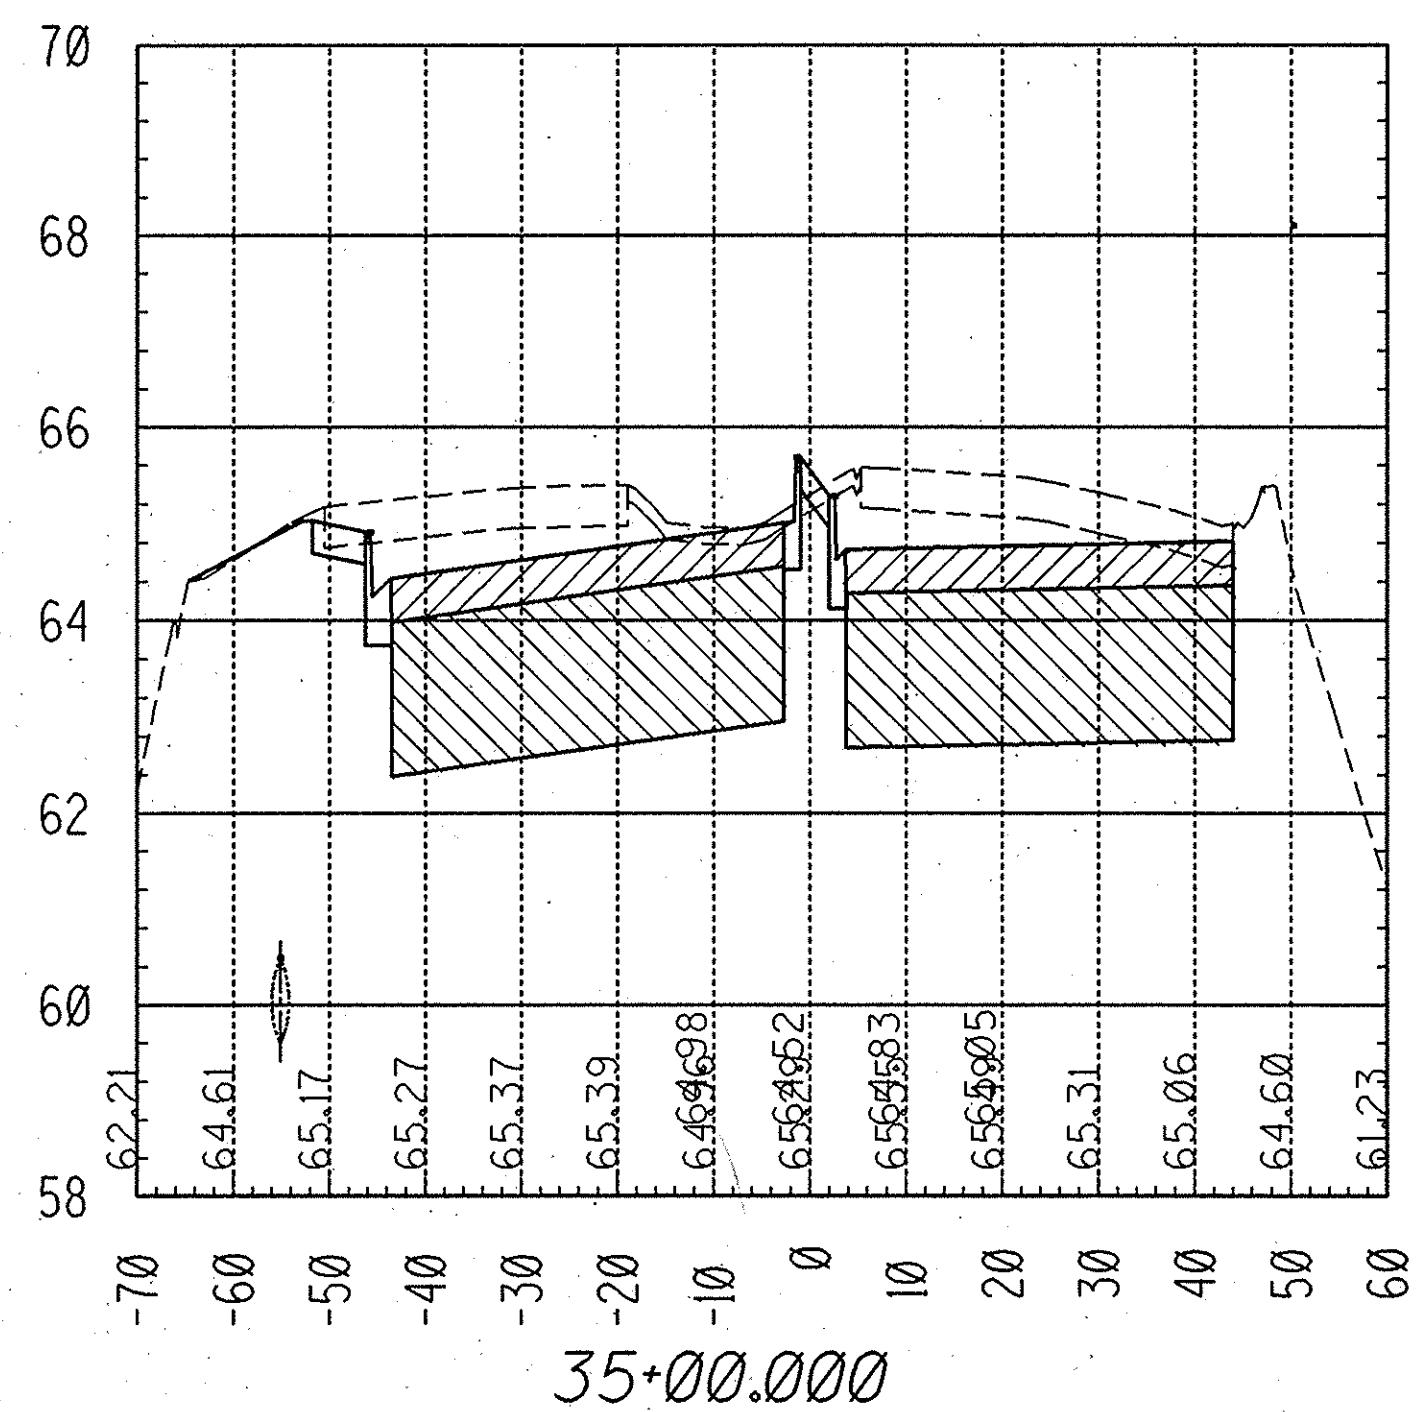
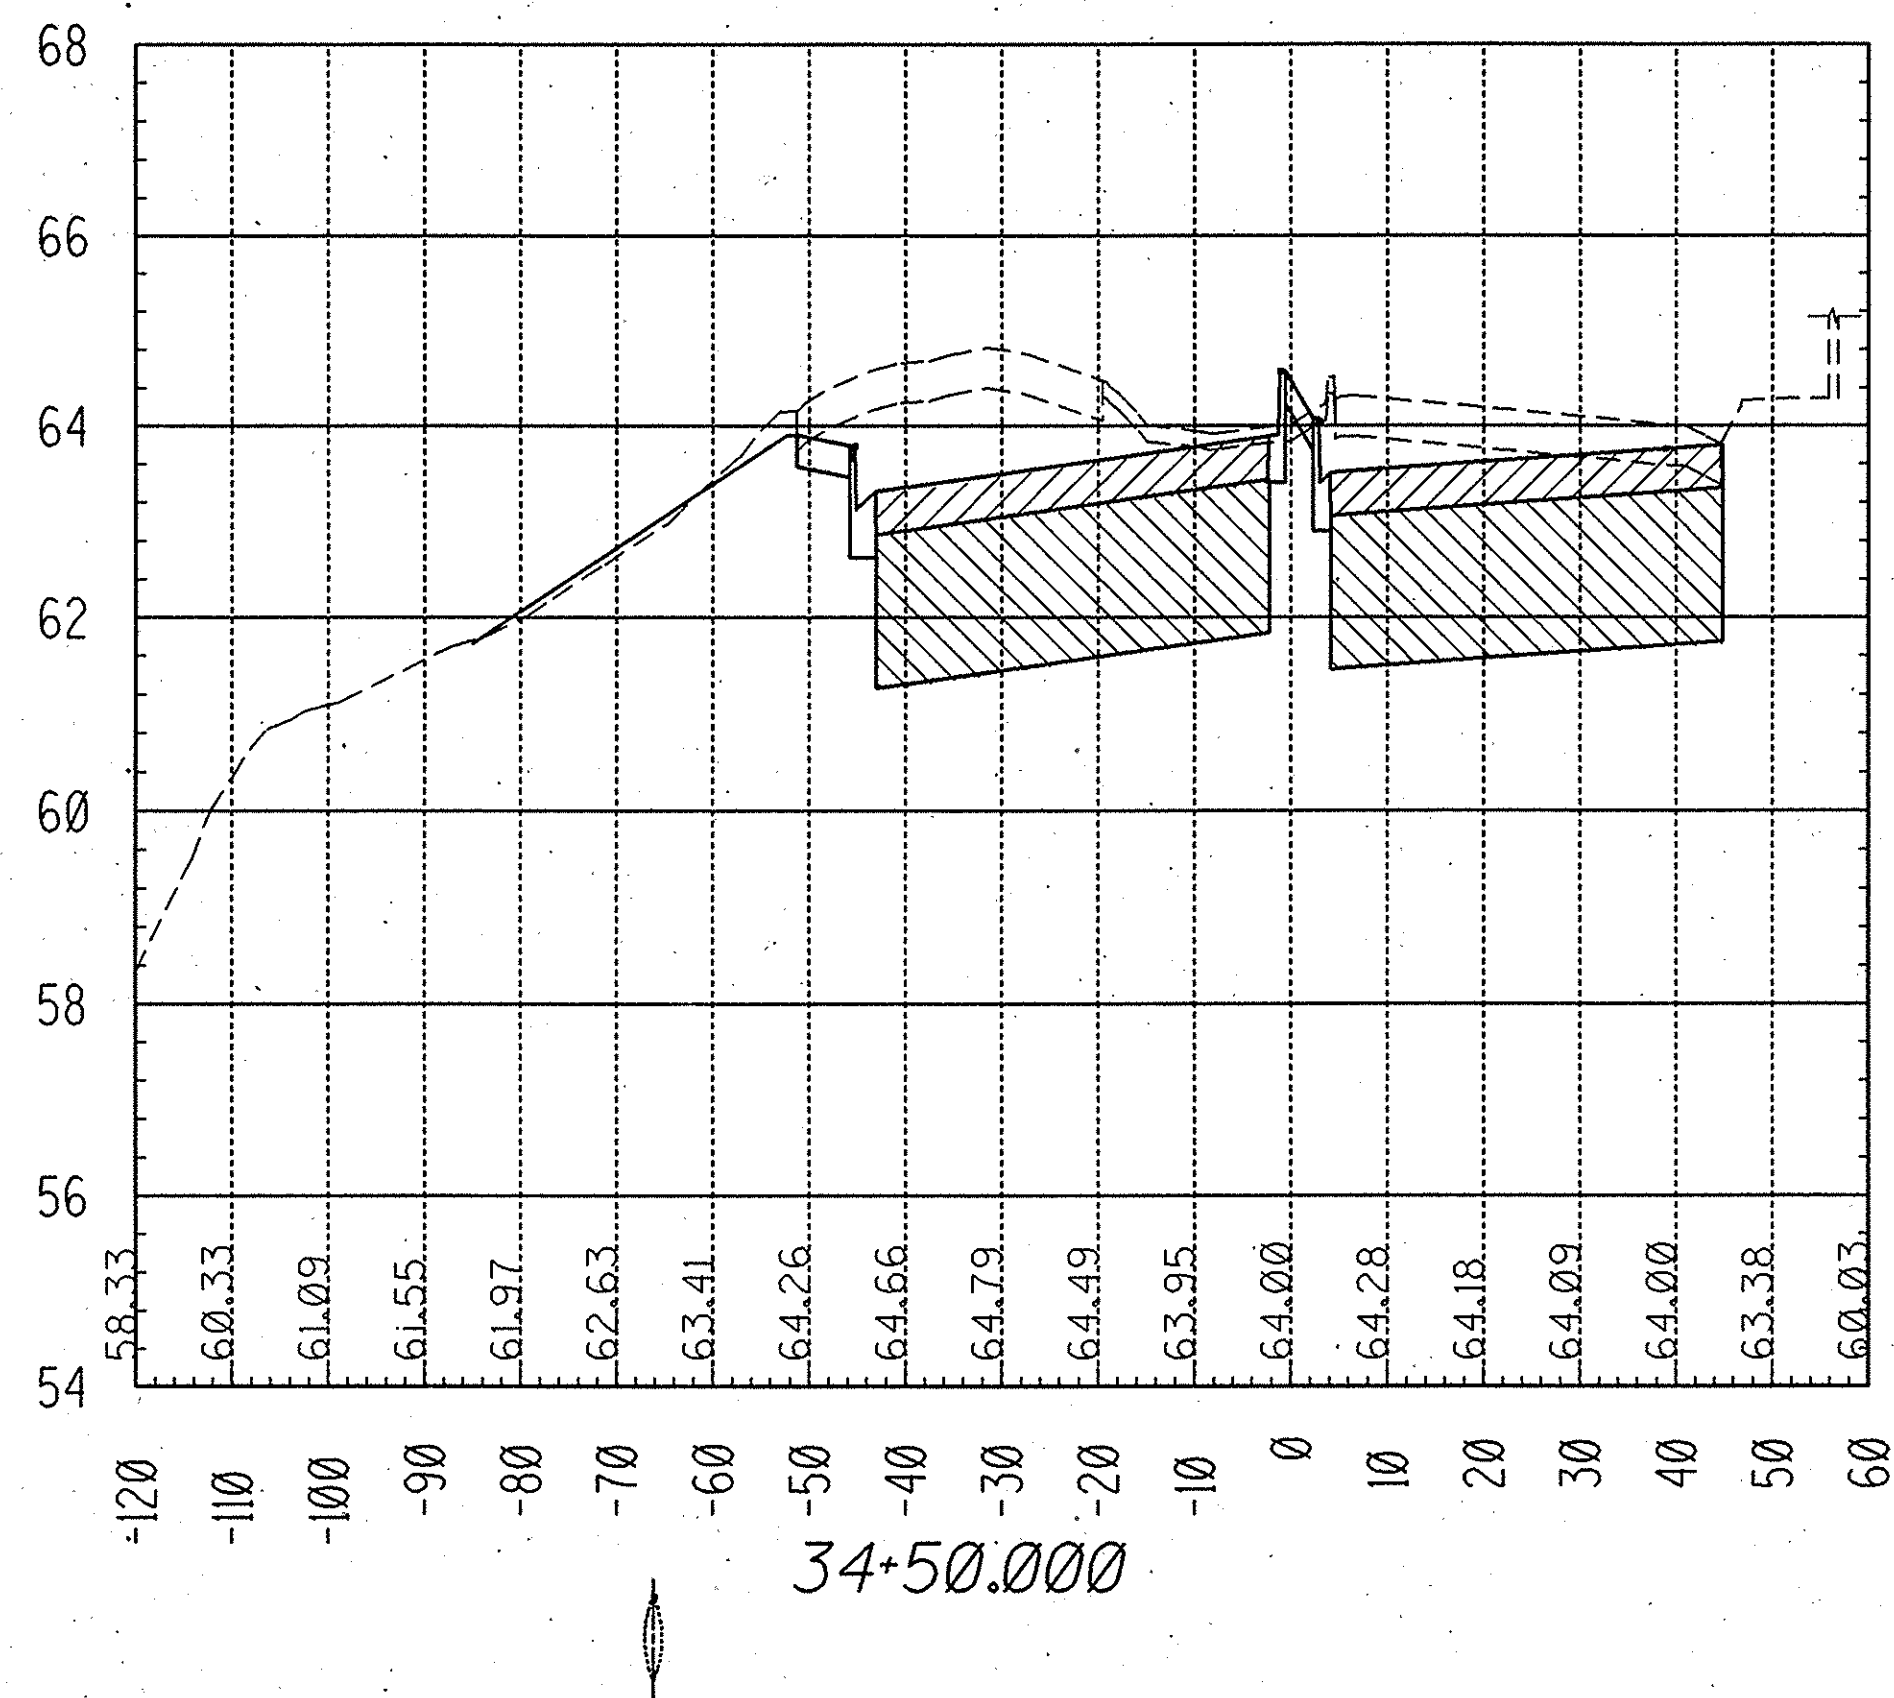
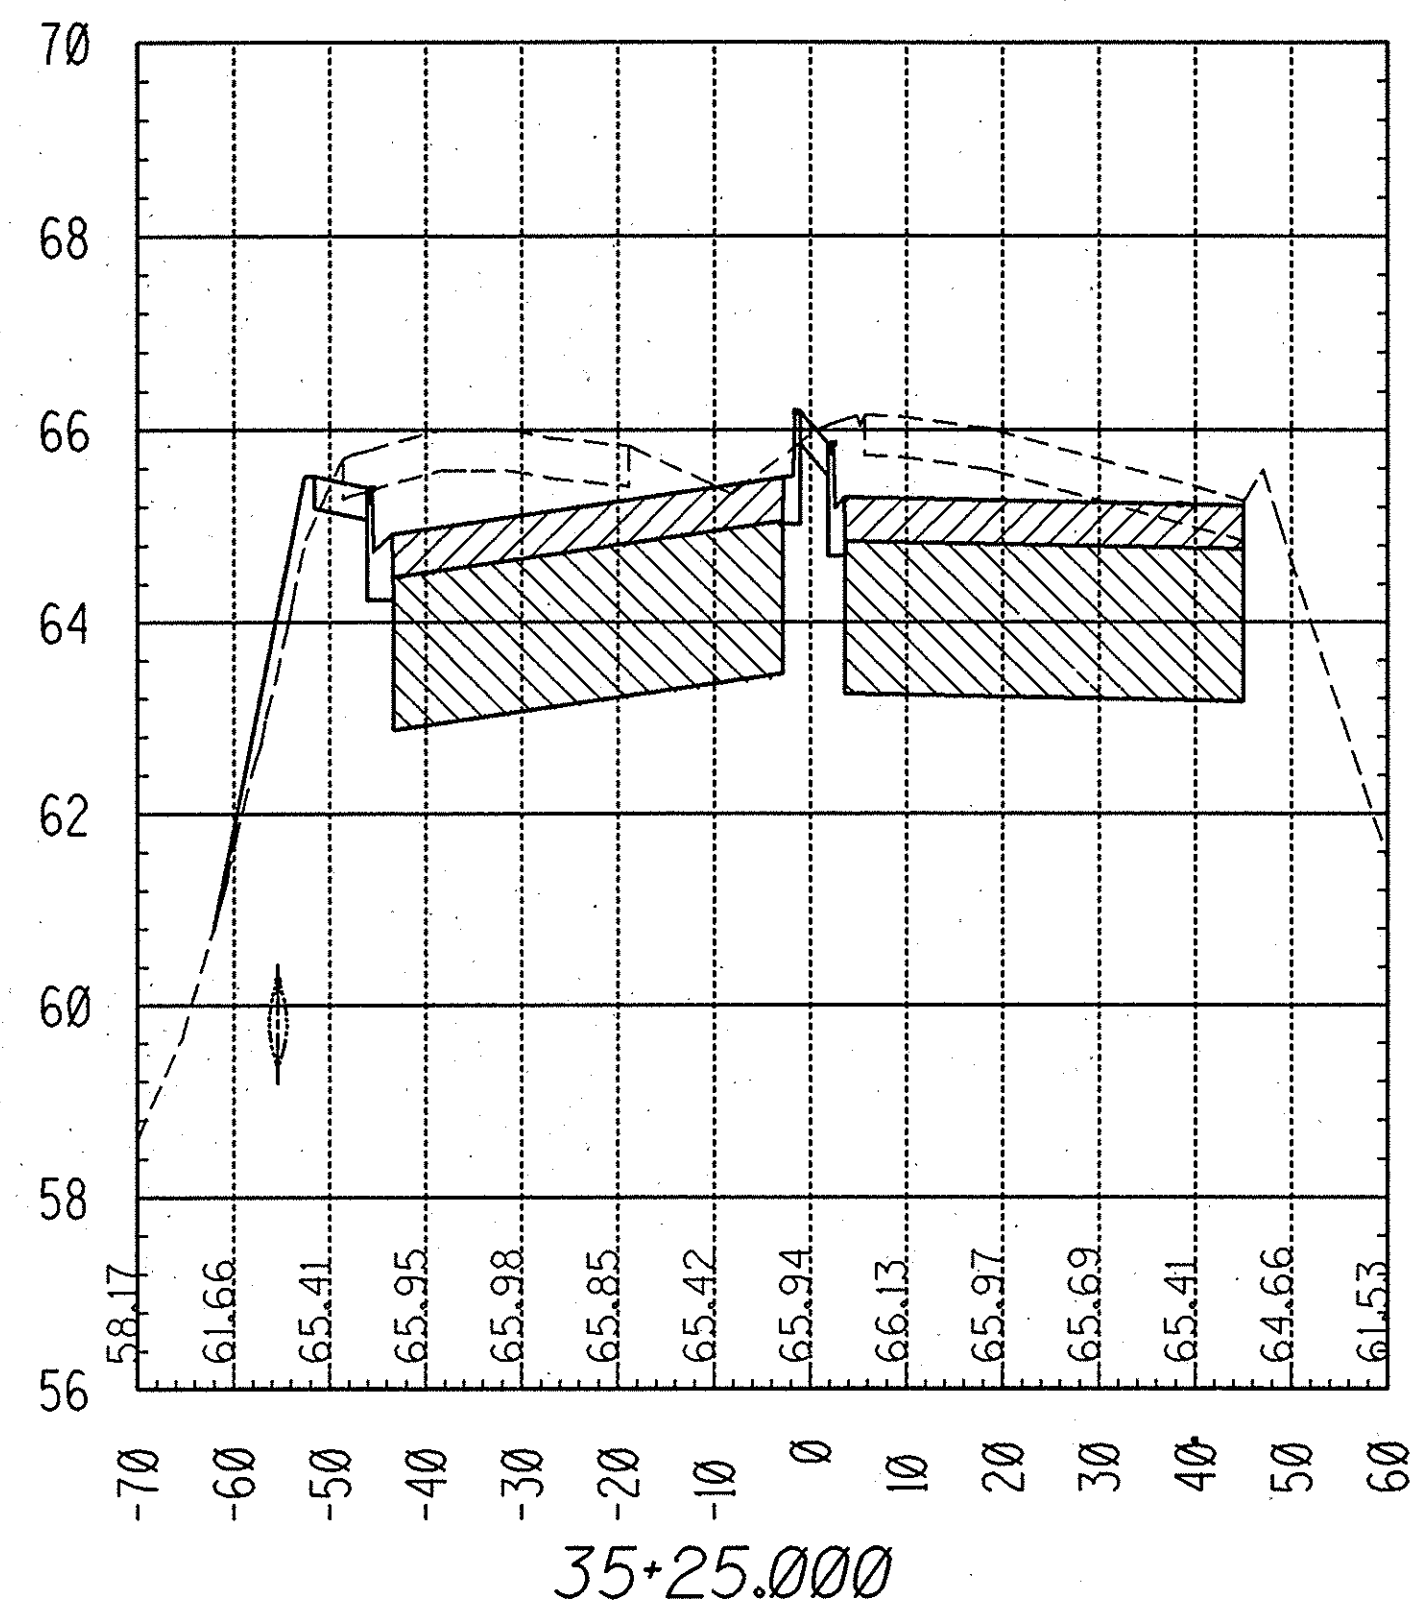


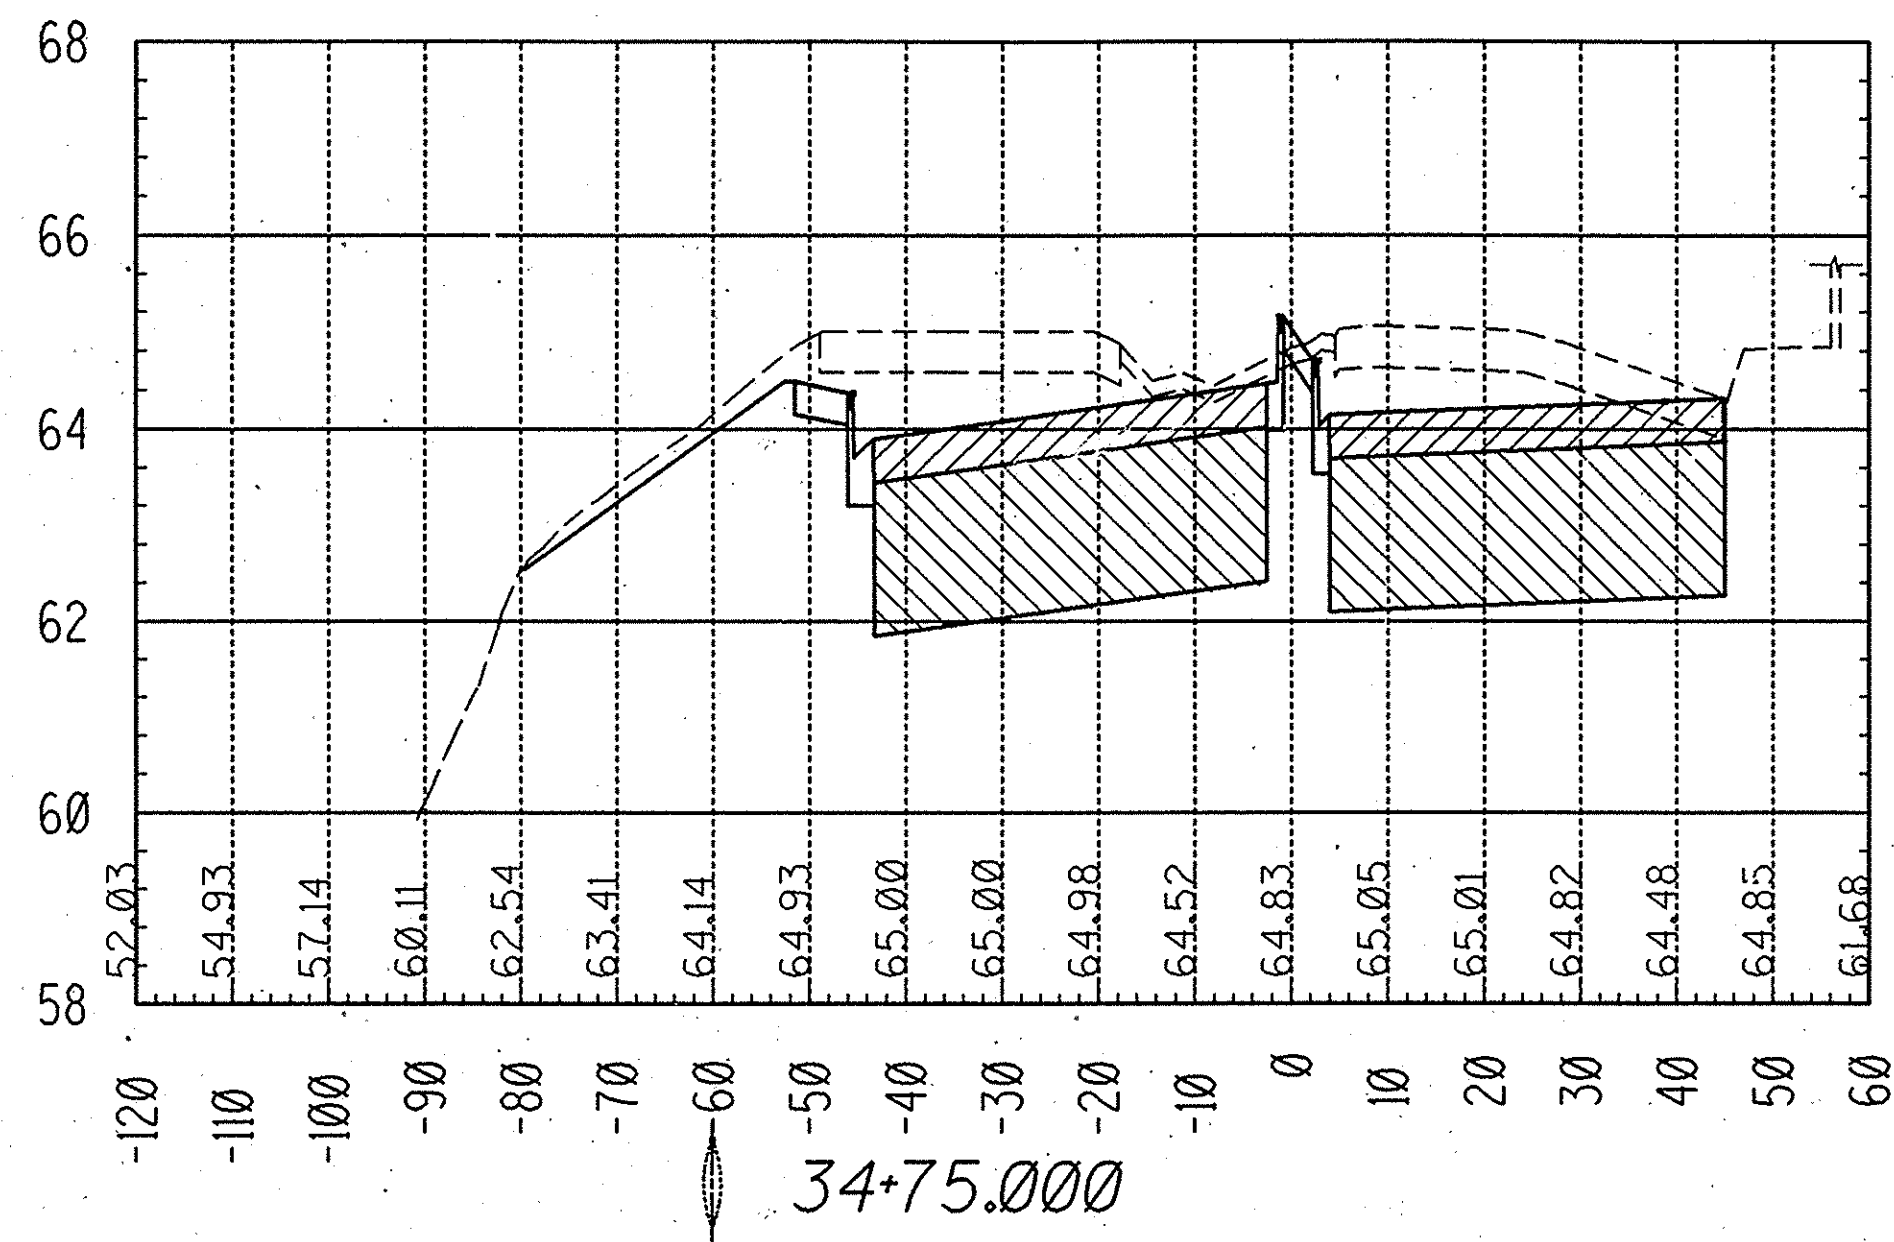

LEGEND

- AGGREGATE BASE MATERIAL
- ASPHALT CONCRETE

PROFILE

HORIZ. 1" = 20'
VERT. 1" = 2'

1/2 0 2
3 inches on original drawing

RECORD DRAWING

ORANGE COUNTY
ENVIRONMENTAL MANAGEMENT AGENCY

HARBOR BLVD. IMPROVEMENTS

CROSS SECTIONS

34+50 to 35+75

MARK	DATE	DESCRIPTION
REVISIONS		
PREPARED UNDER		
DESIGNED - RRS	CHECKED - RAH	SHEET
DRAWN - SG/AHP	DATE	54
SCALE AS SHOWN	3-93	OF 60