
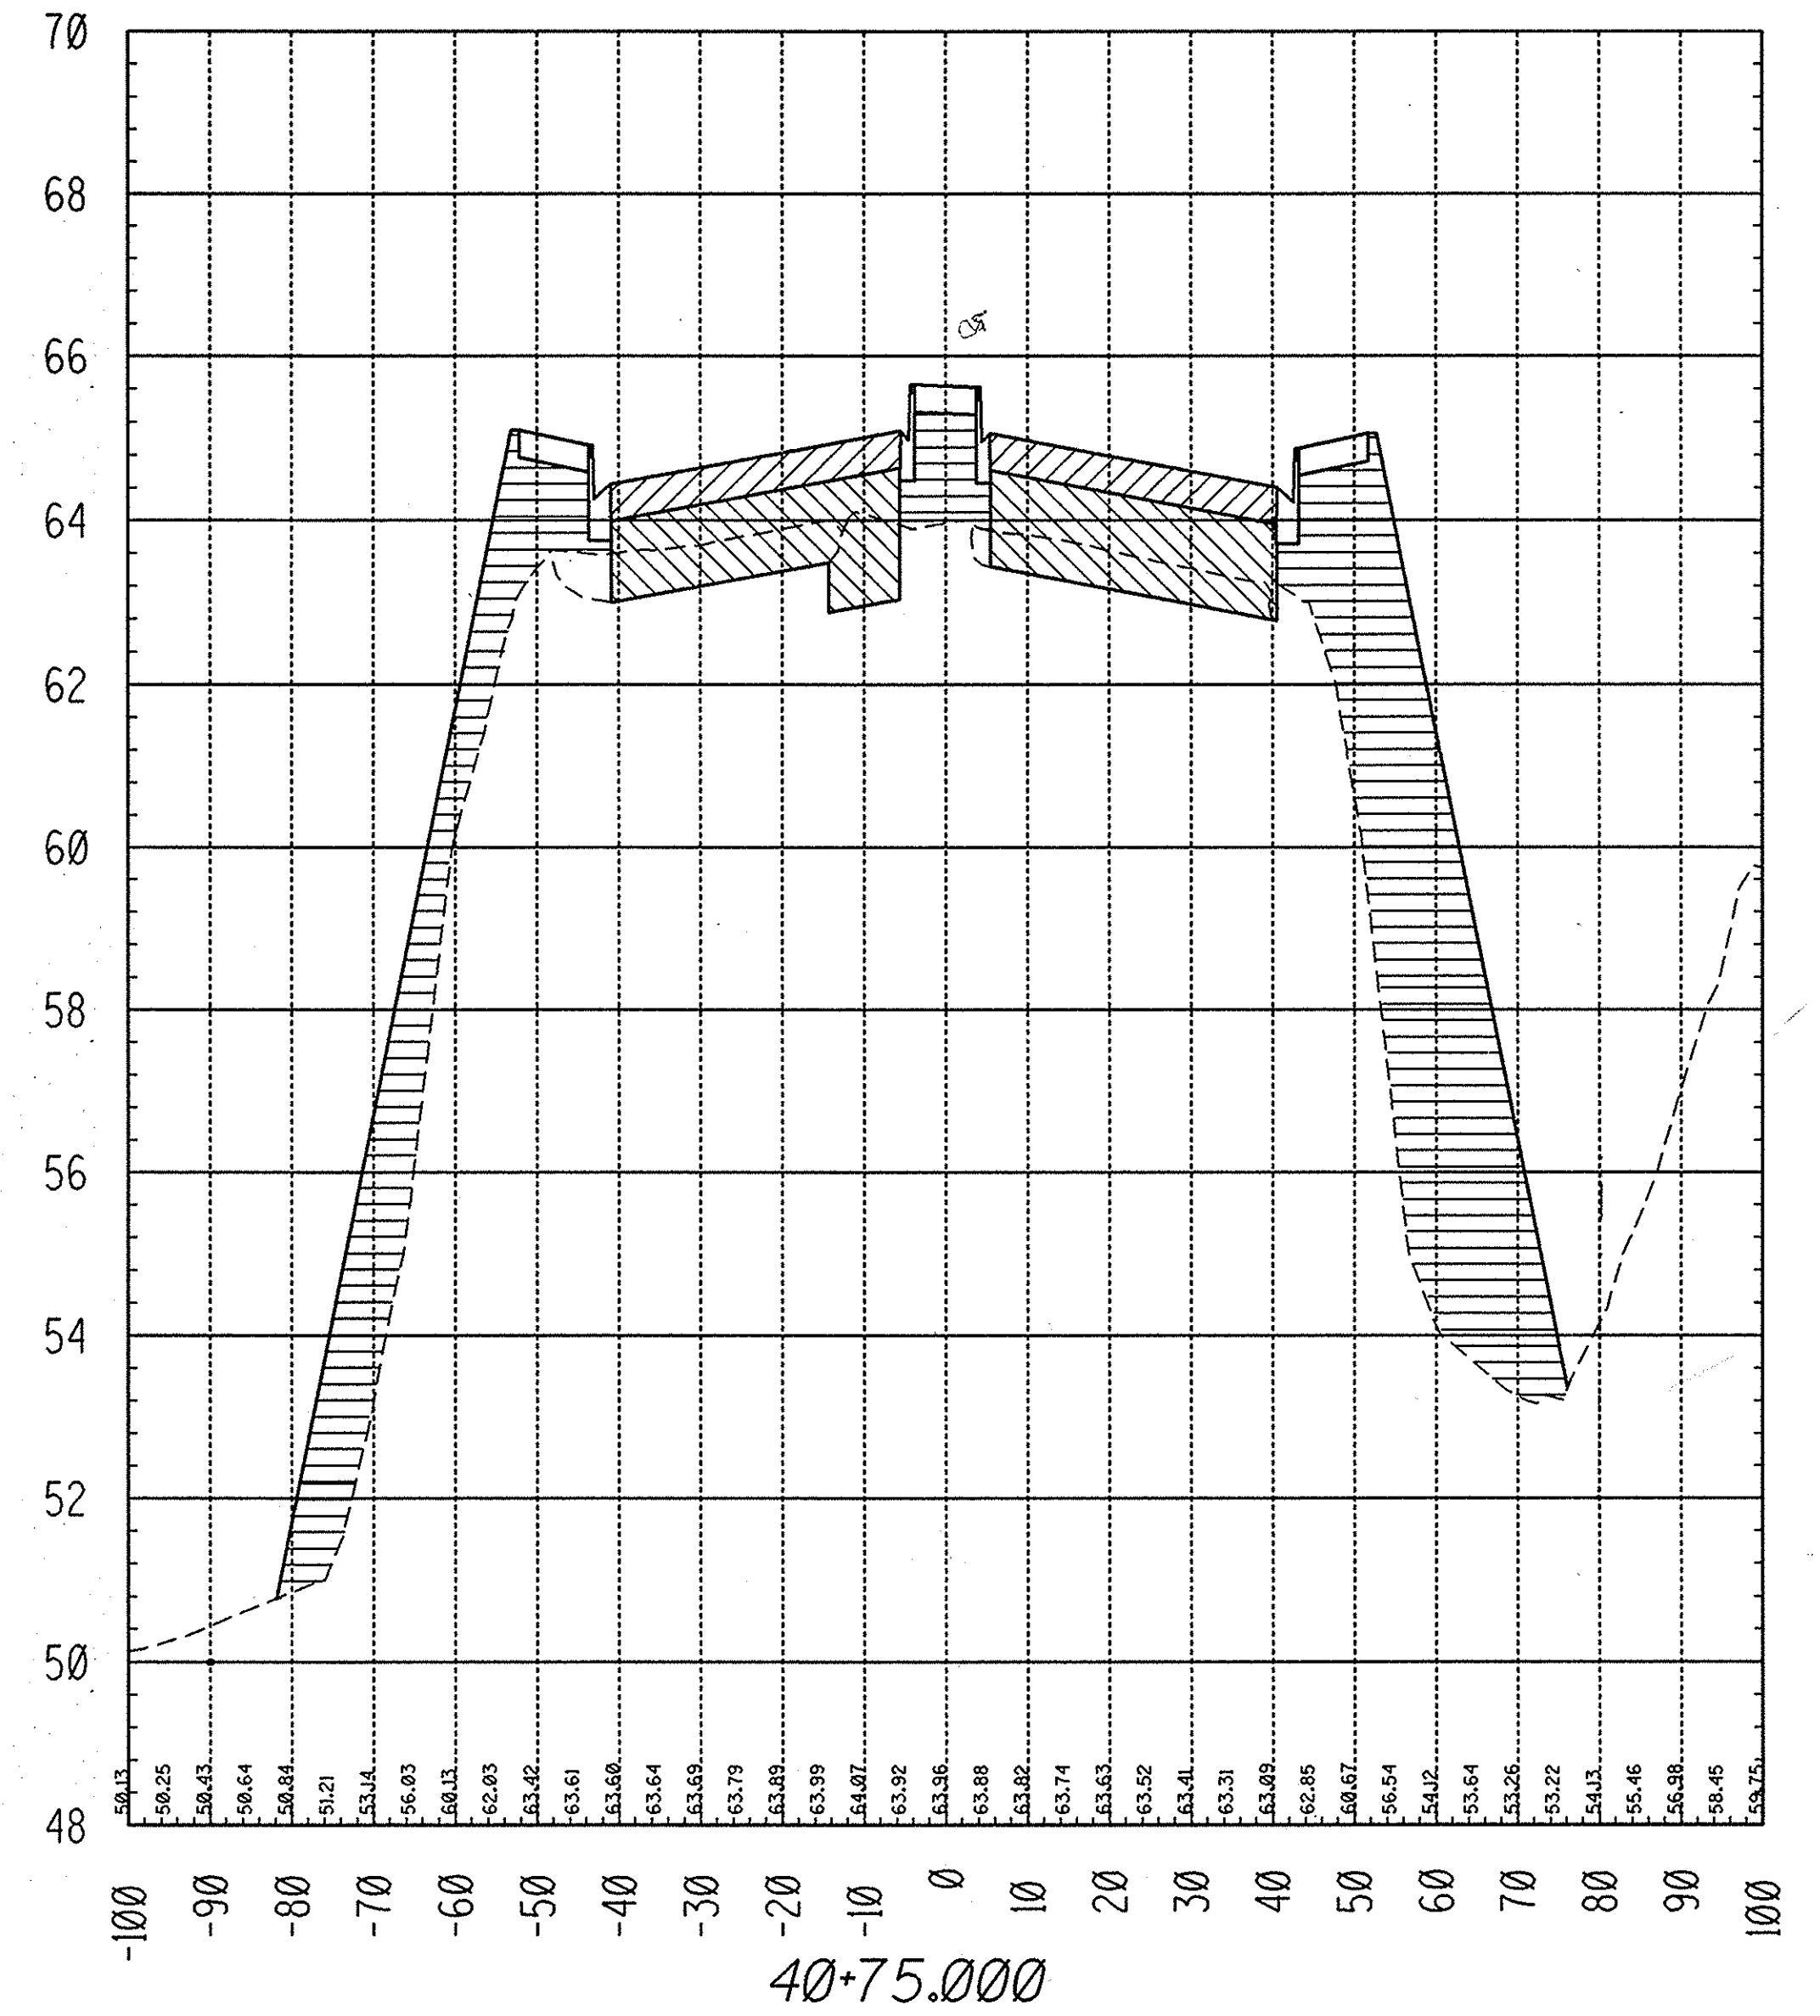
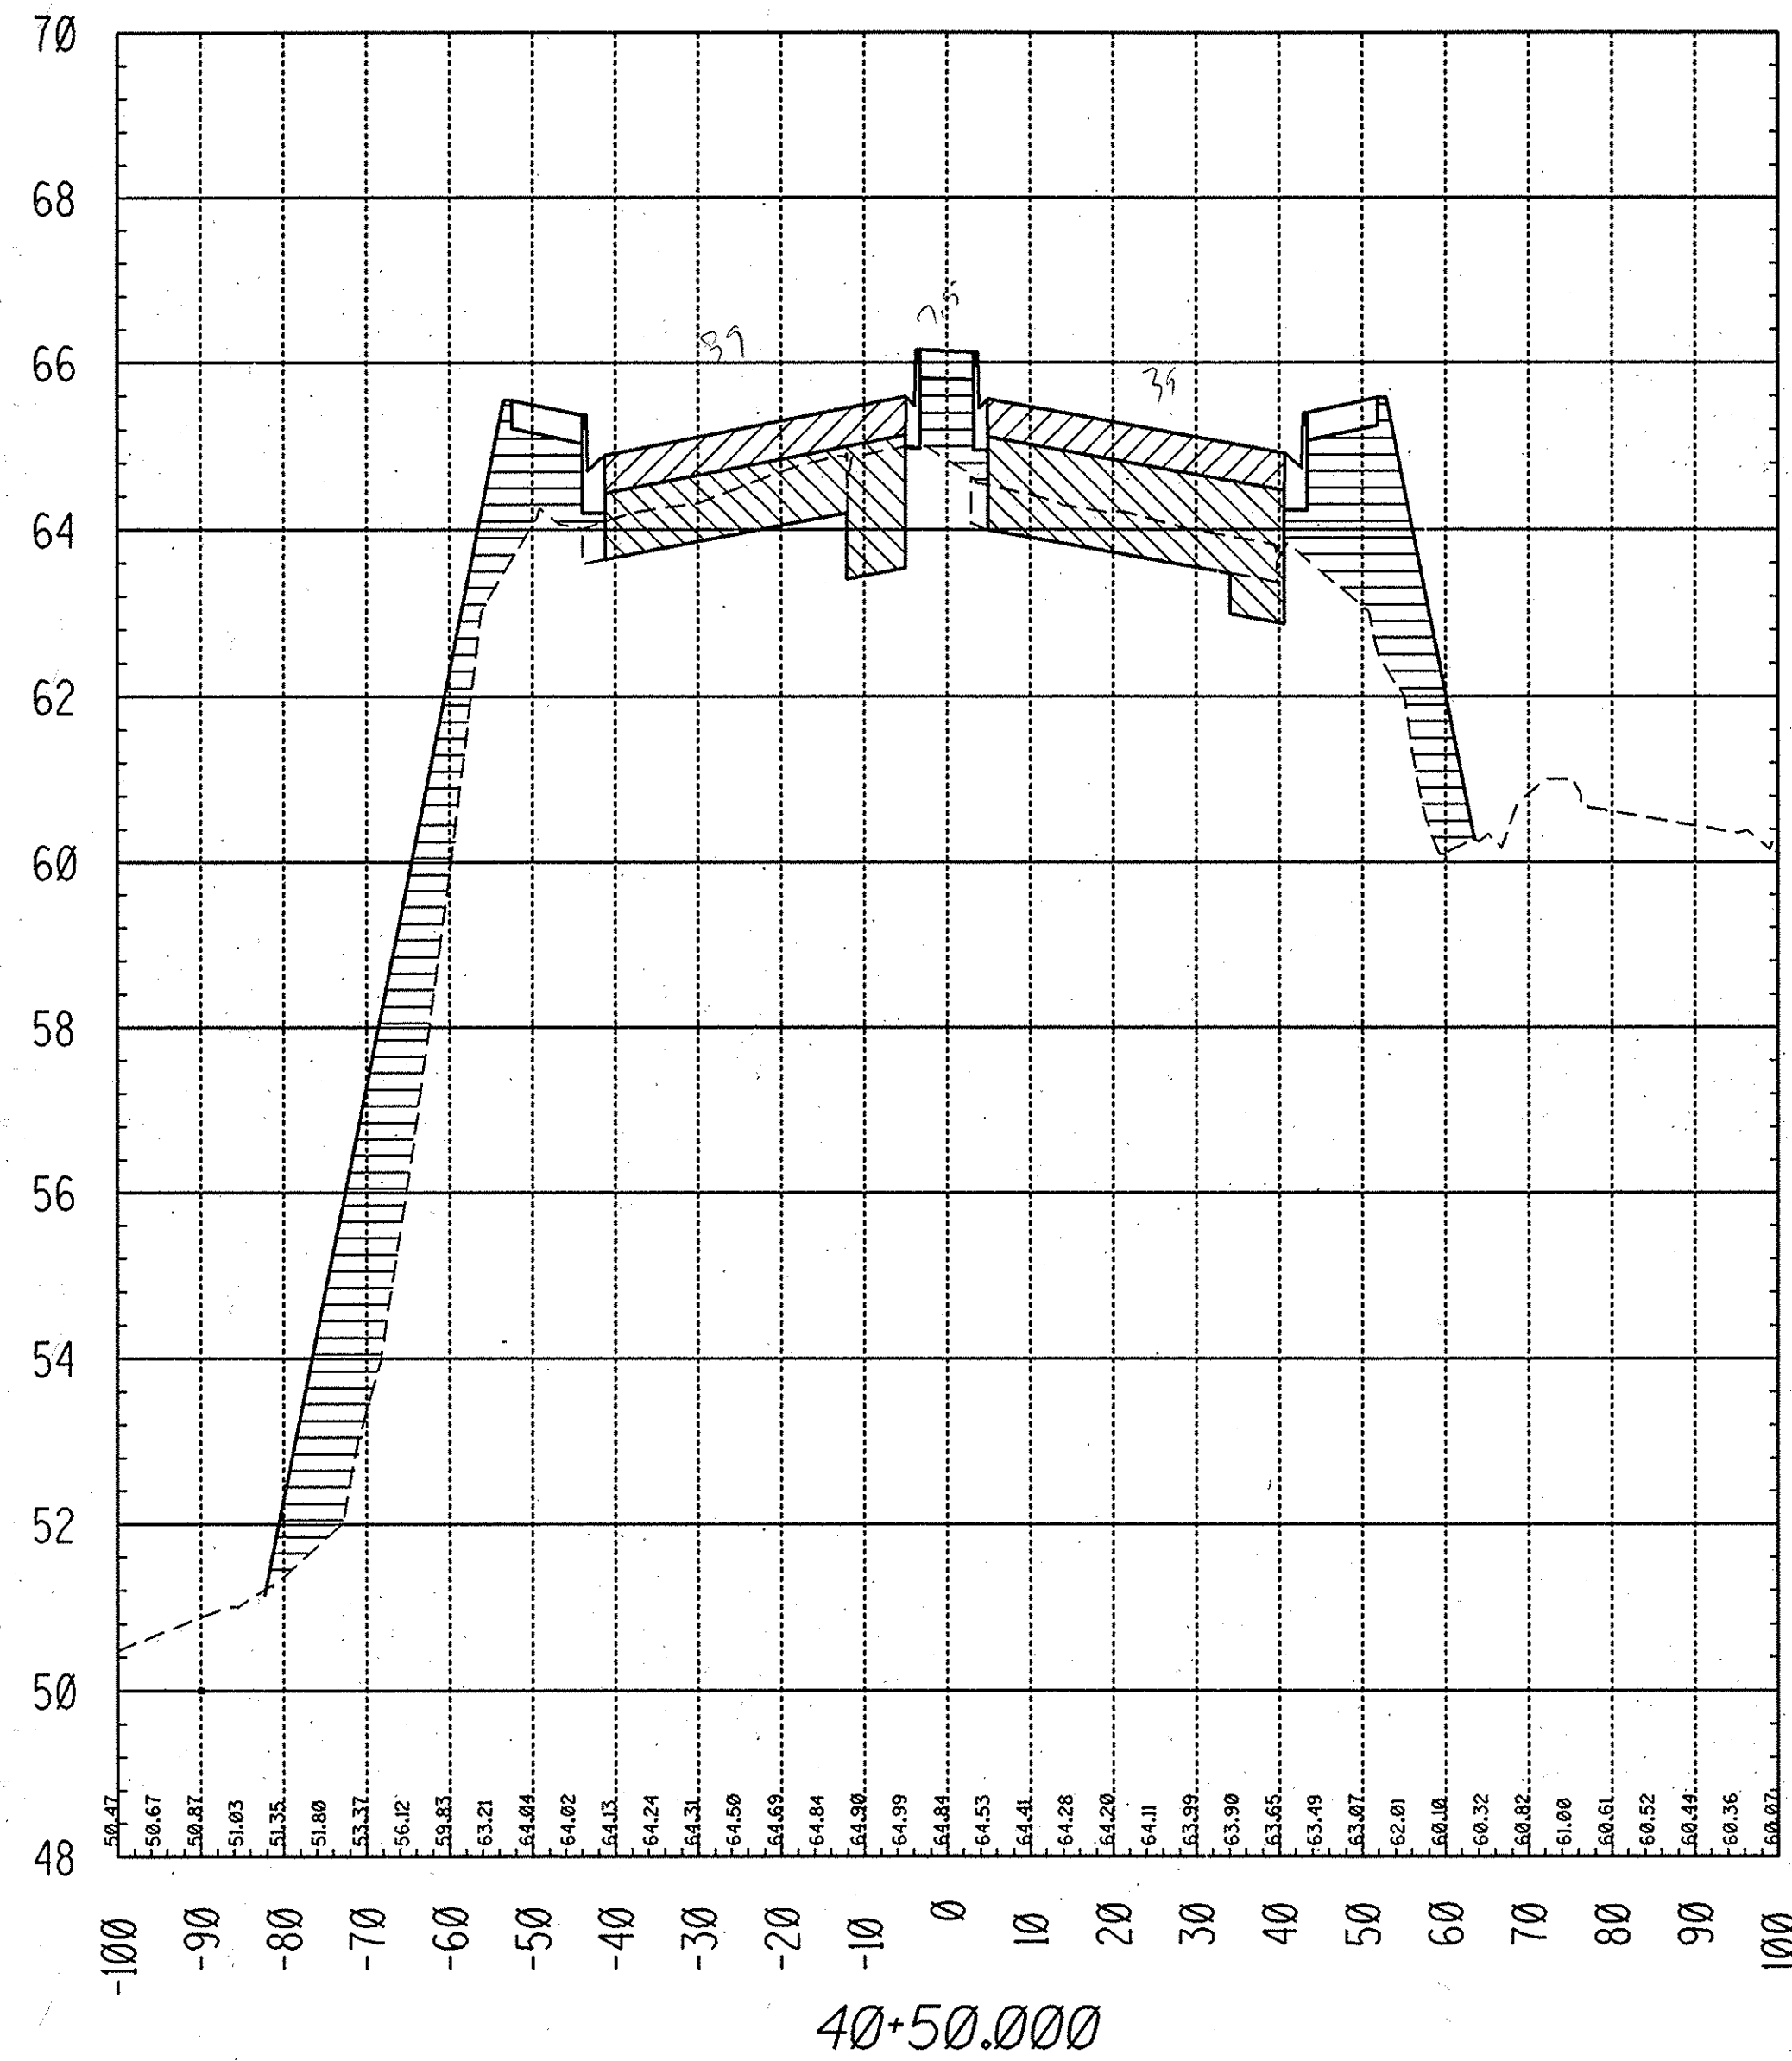


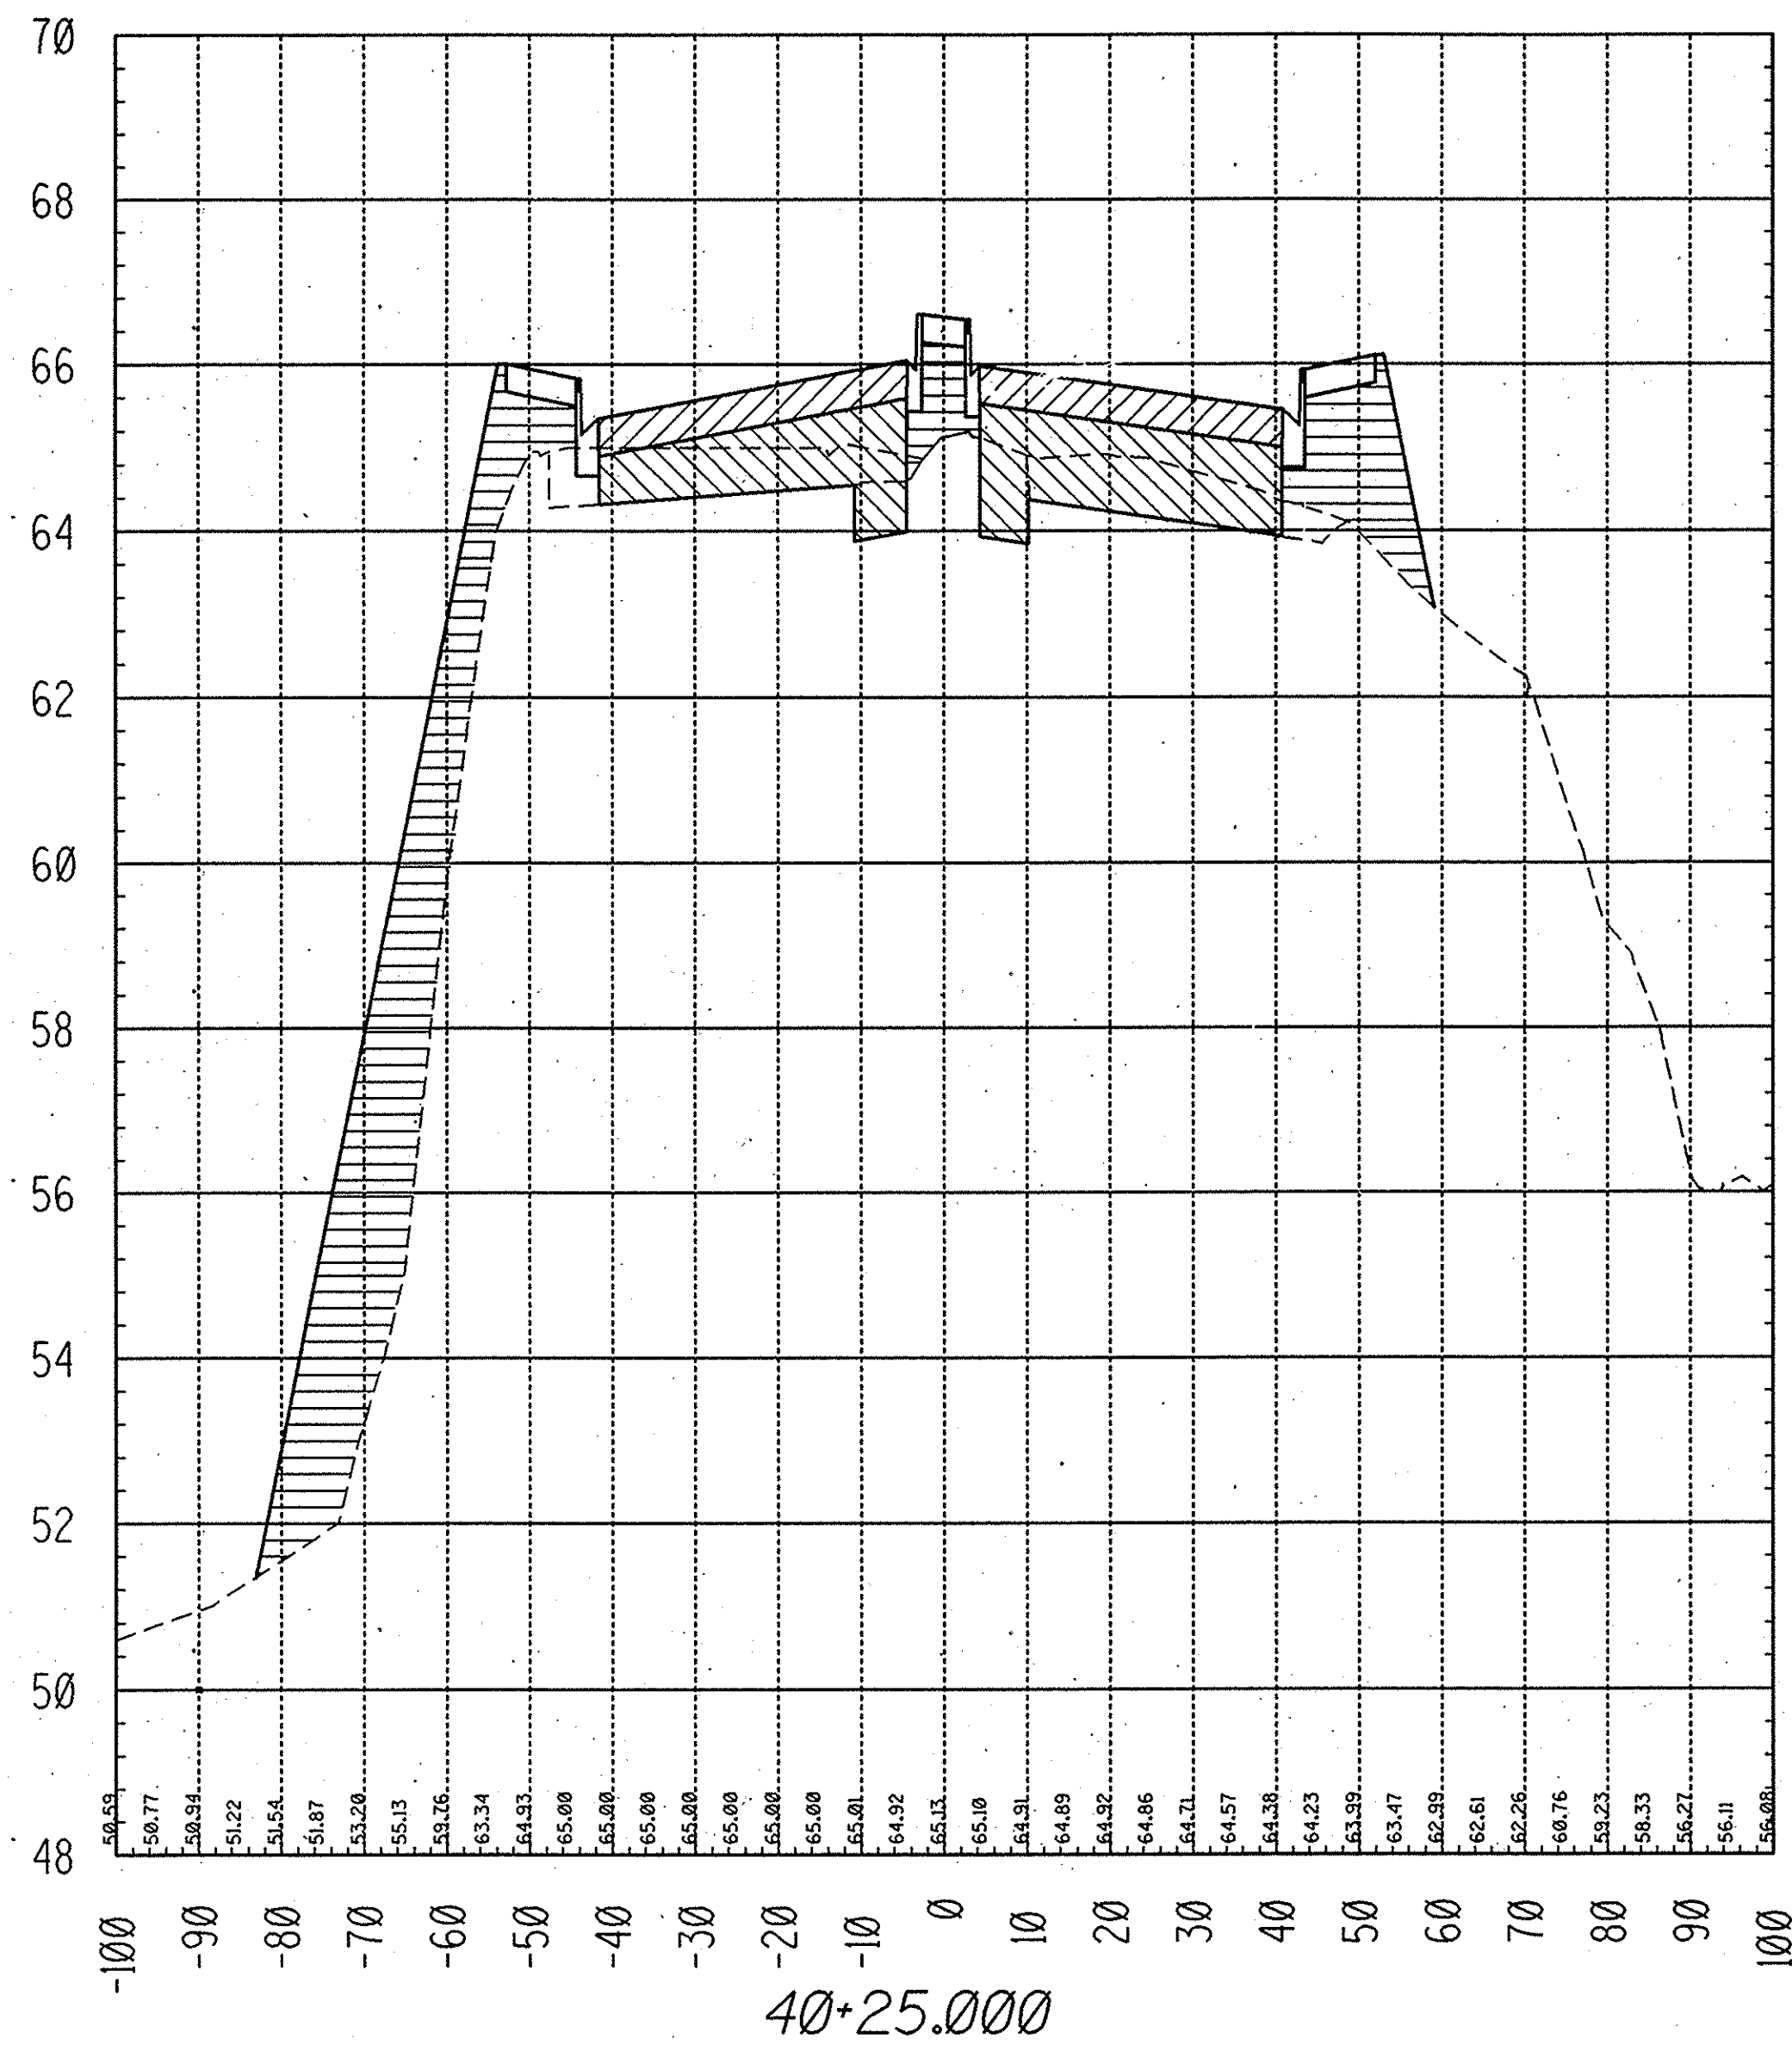

LEGEND

- AGGREGATE BASE MATERIAL
- ASPHALT CONCRETE
- UNCLASSIFIED FILL

PROFILE
HORIZ. 1"= 20'
VERT. 1"= 2'

RECORD DRAWING

ORANGE COUNTY
ENVIRONMENTAL MANAGEMENT AGENCY

HARBOR BLVD. IMPROVEMENTS

CROSS SECTIONS

40+25 to 40+75

MARK	DATE	DESCRIPTION
REVISIONS		
PREPARED UNDER		
RICHARD HAYS RCE 39595 (exp. 12-31-93)		

DESIGNED	RRS	CHECKED	RAH
DRAWN	SG/AHP	DATE	3-93
SCALE	AS SHOWN	DRAWING NO.	

SHEET
55
OF 60