
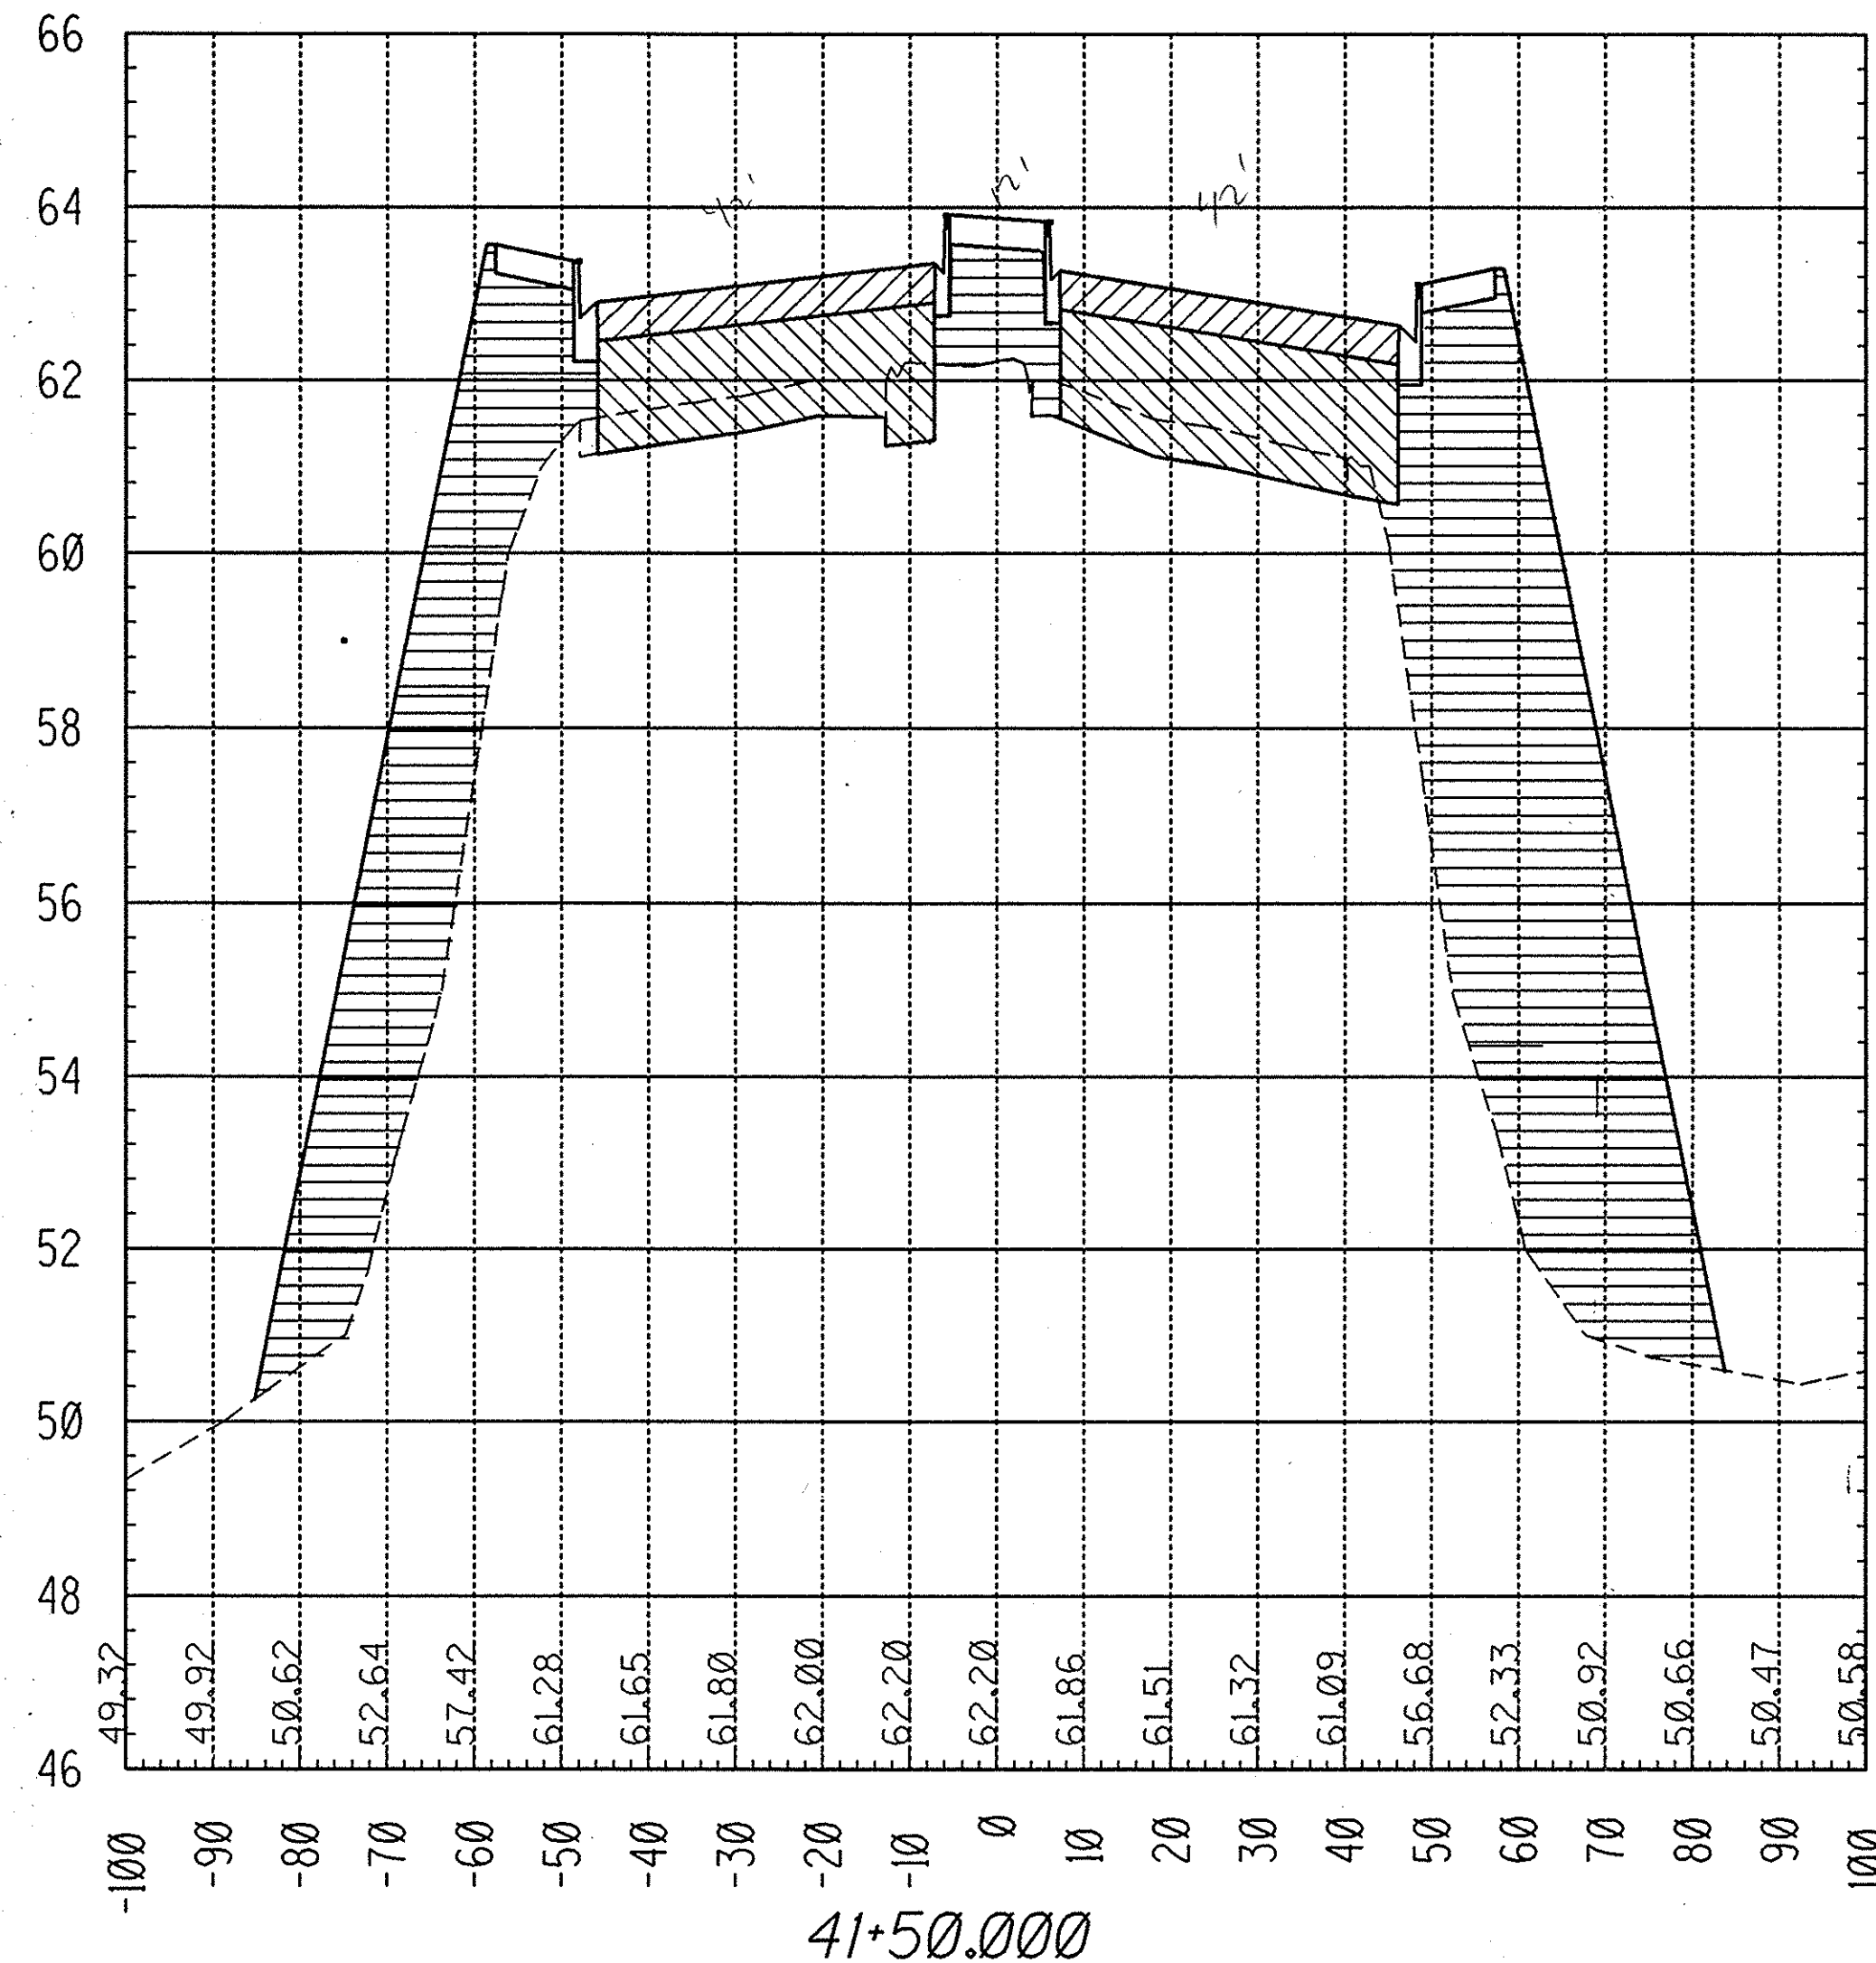
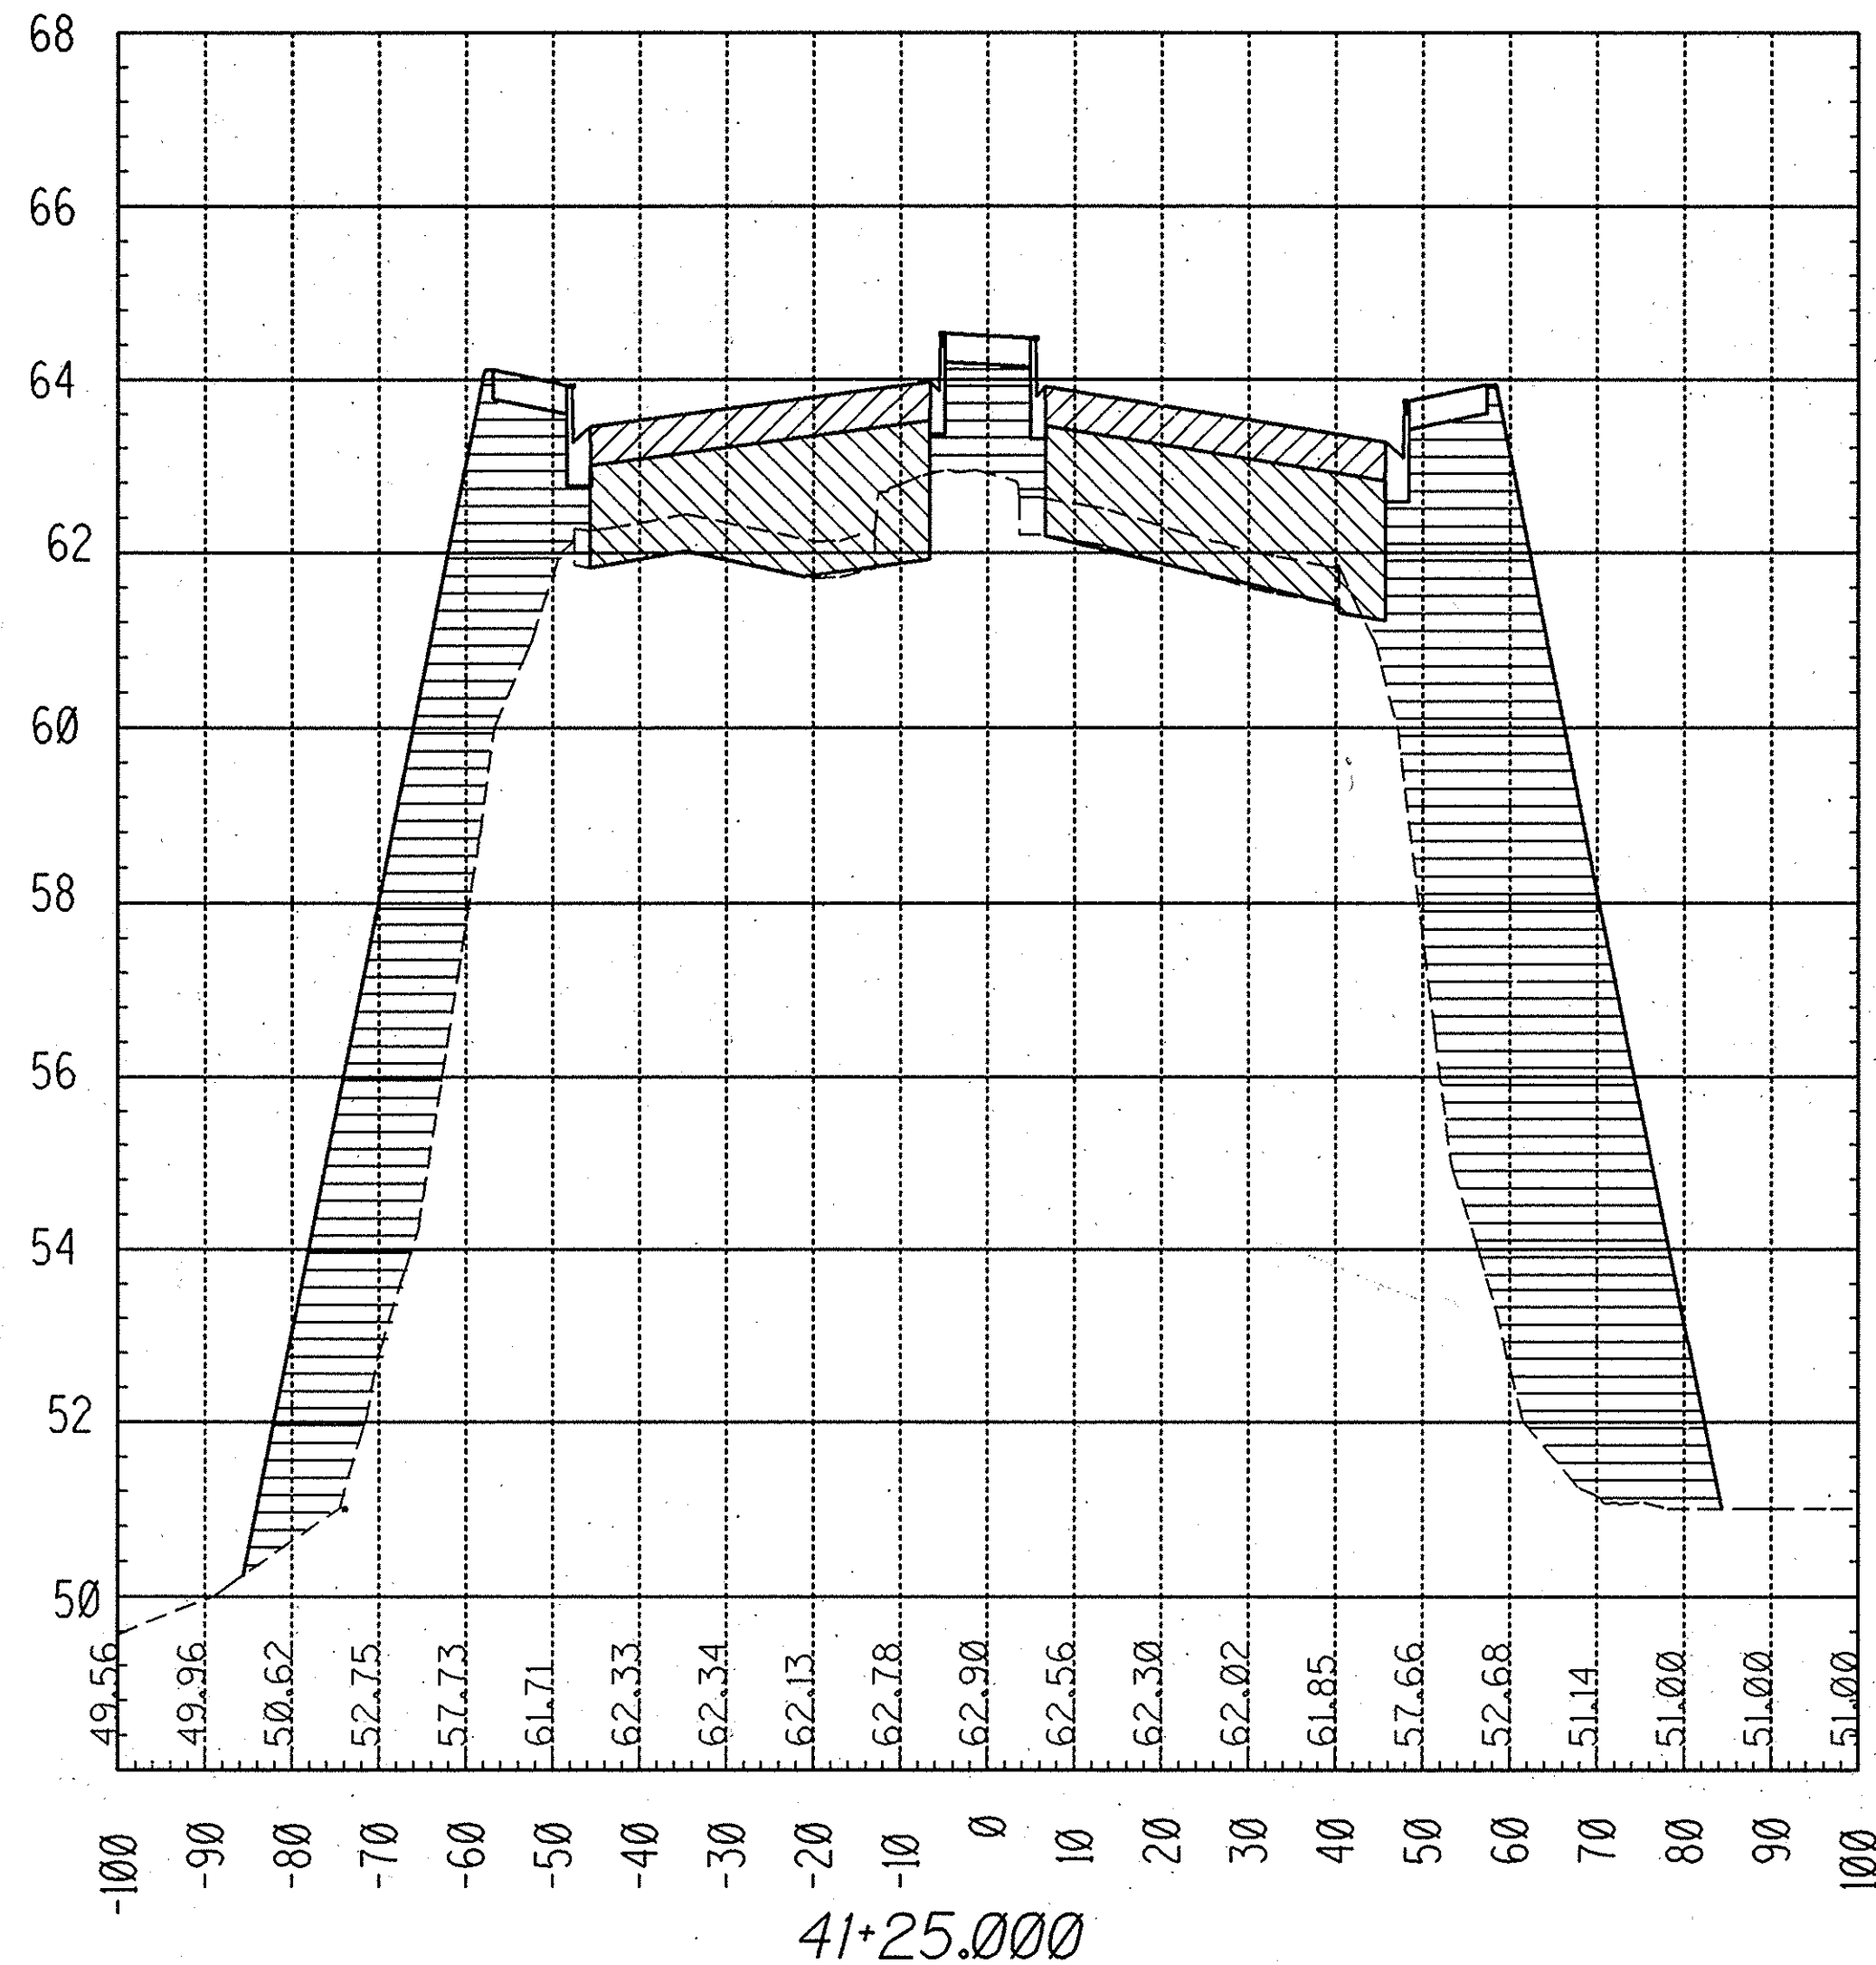


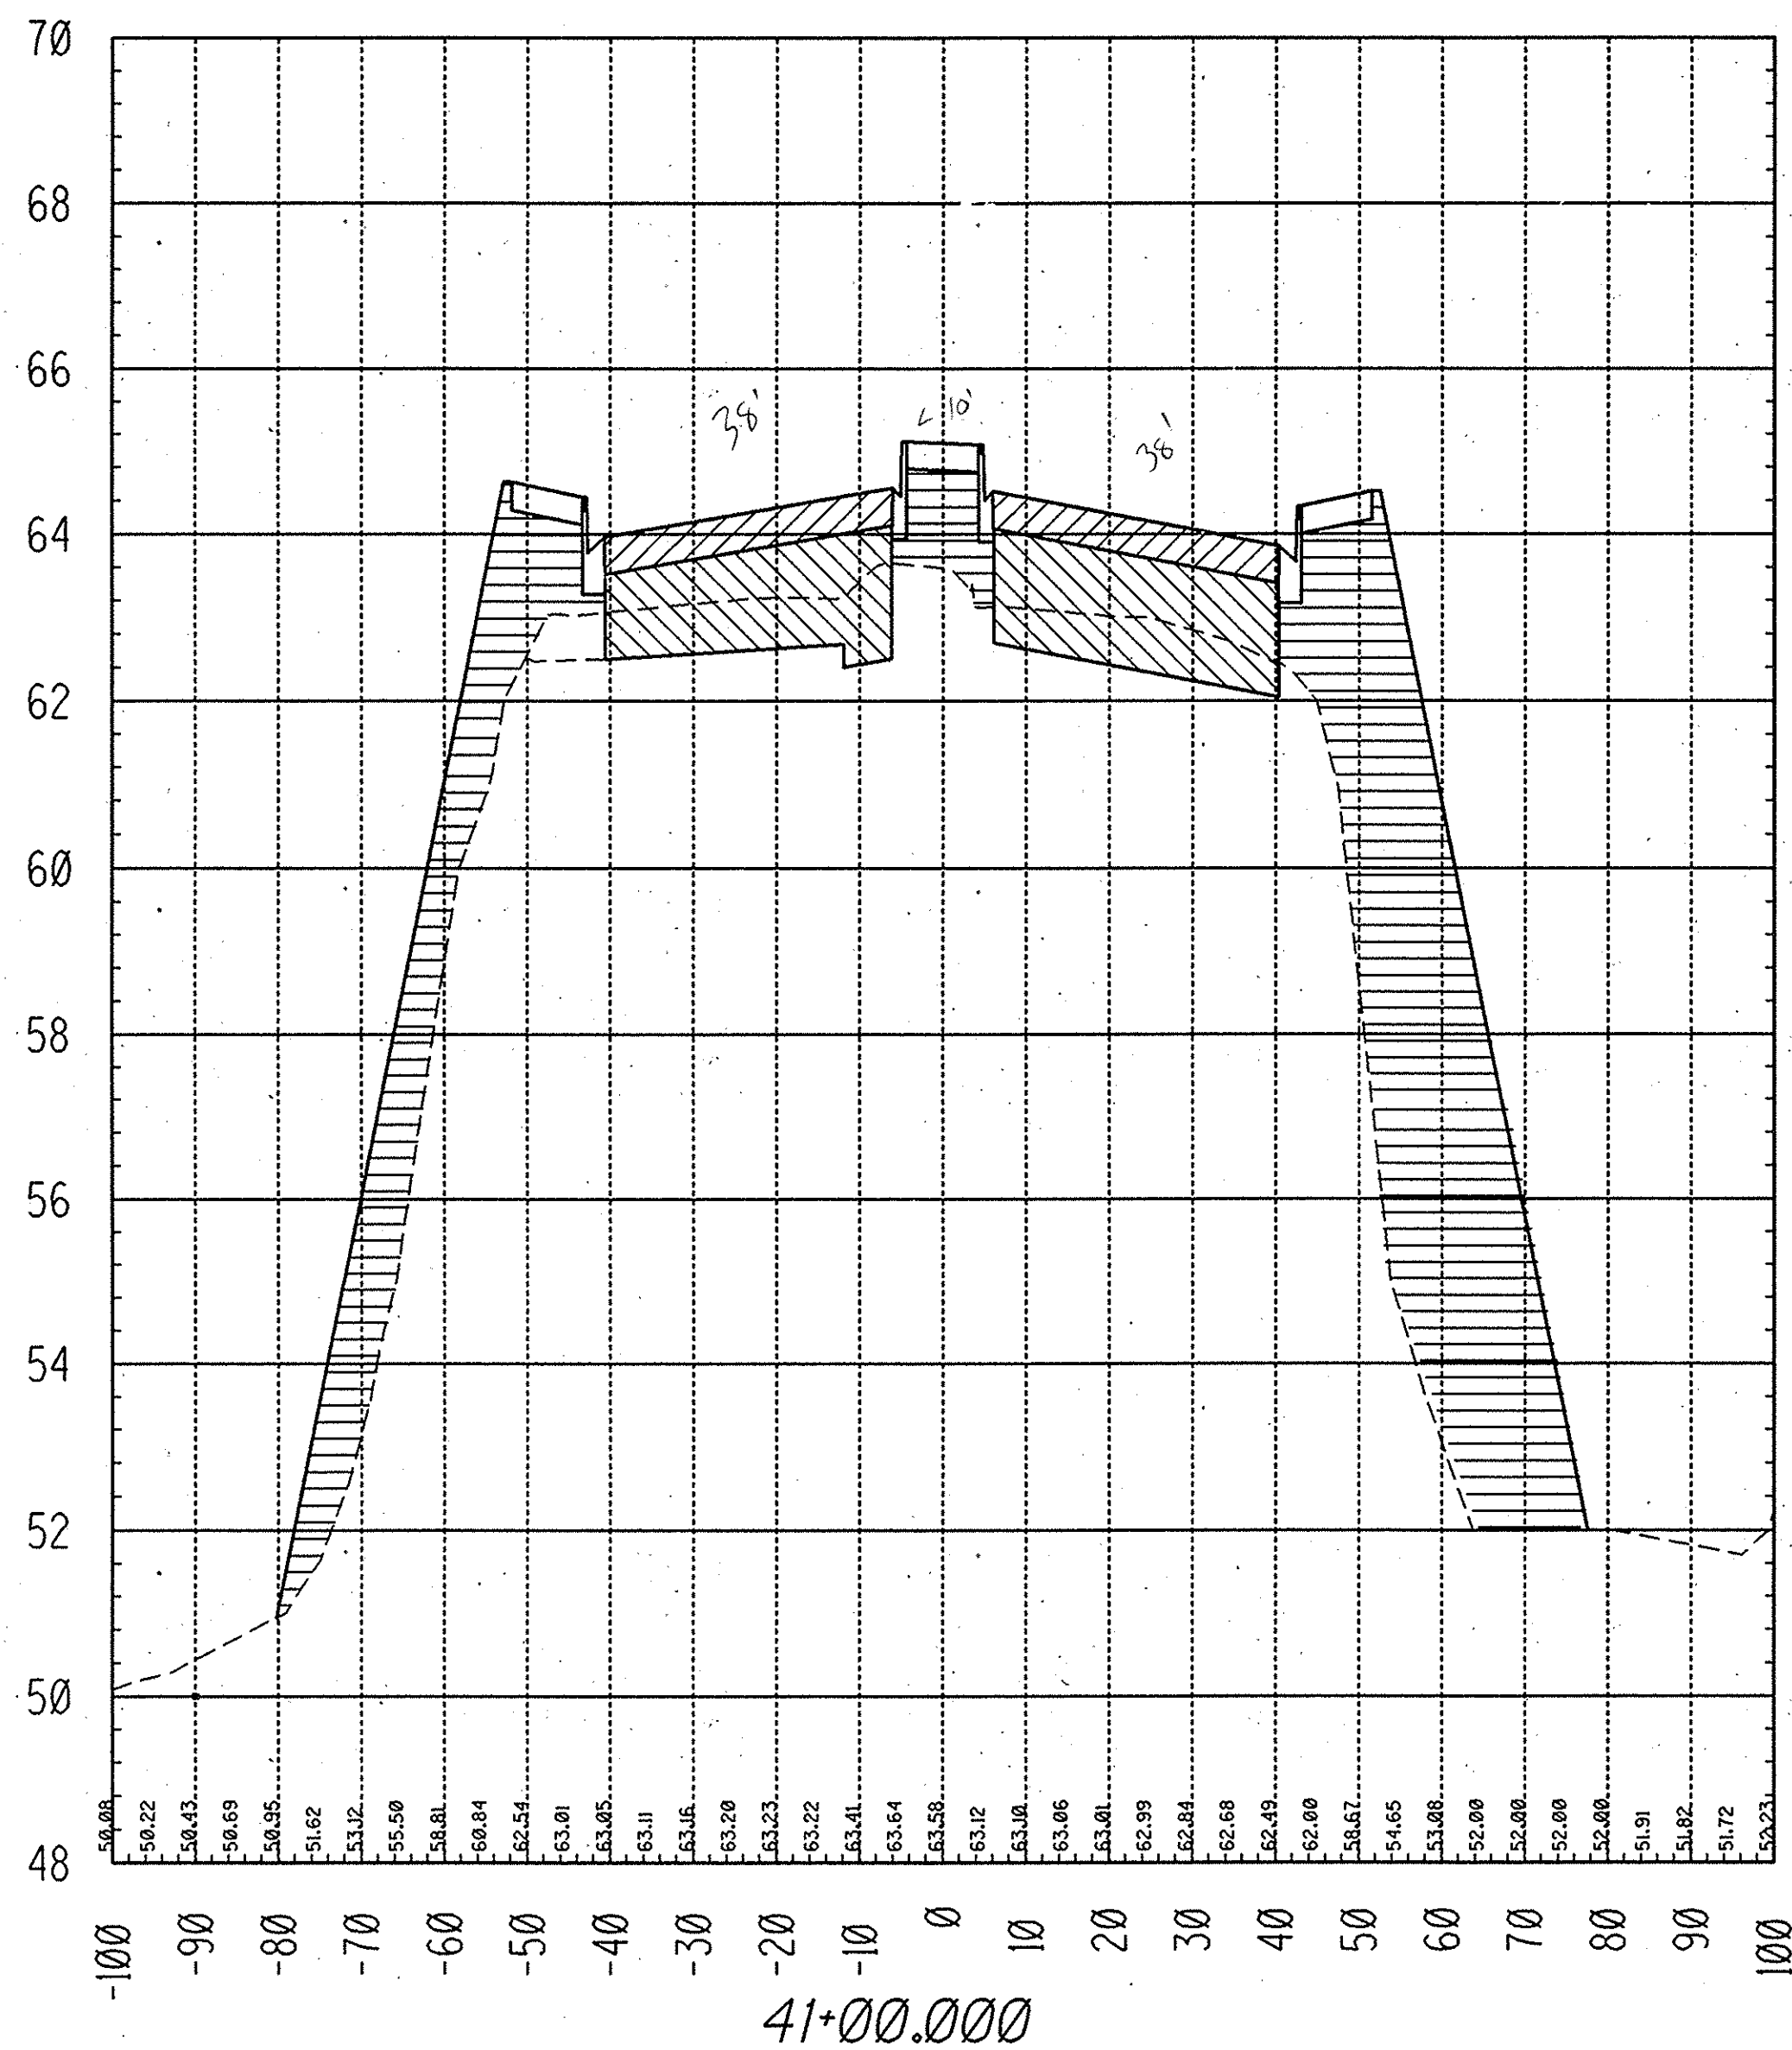

LEGEND

- AGGREGATE BASE MATERIAL
- ASPHALT CONCRETE
- UNCLASSIFIED FILL

PROFILE

HORIZ. 1"=20'
VERT. 1"=2'

1/2 0 2
3 inches on original drawing

RECORD DRAWING

ORANGE COUNTY ENVIRONMENTAL MANAGEMENT AGENCY	
HARBOR BLVD. IMPROVEMENTS	
CROSS SECTIONS 41+00 to 41+50	
DESIGNED: RRS	CHECKED: RAH
DRAWN: SG/AHP	DATE: 3-93
SCALE: AS SHOWN	DRAWING NO.

PREPARED UNDER SUPERVISION OF
RICHARD HANSEN
RCE 39595 (exp. 12-31-93)

REGISTERED PROFESSIONAL ENGINEER
No. 39595
Exp. 12-31-93
CIVIL
3/4/93

SHEET
56
OF 60