
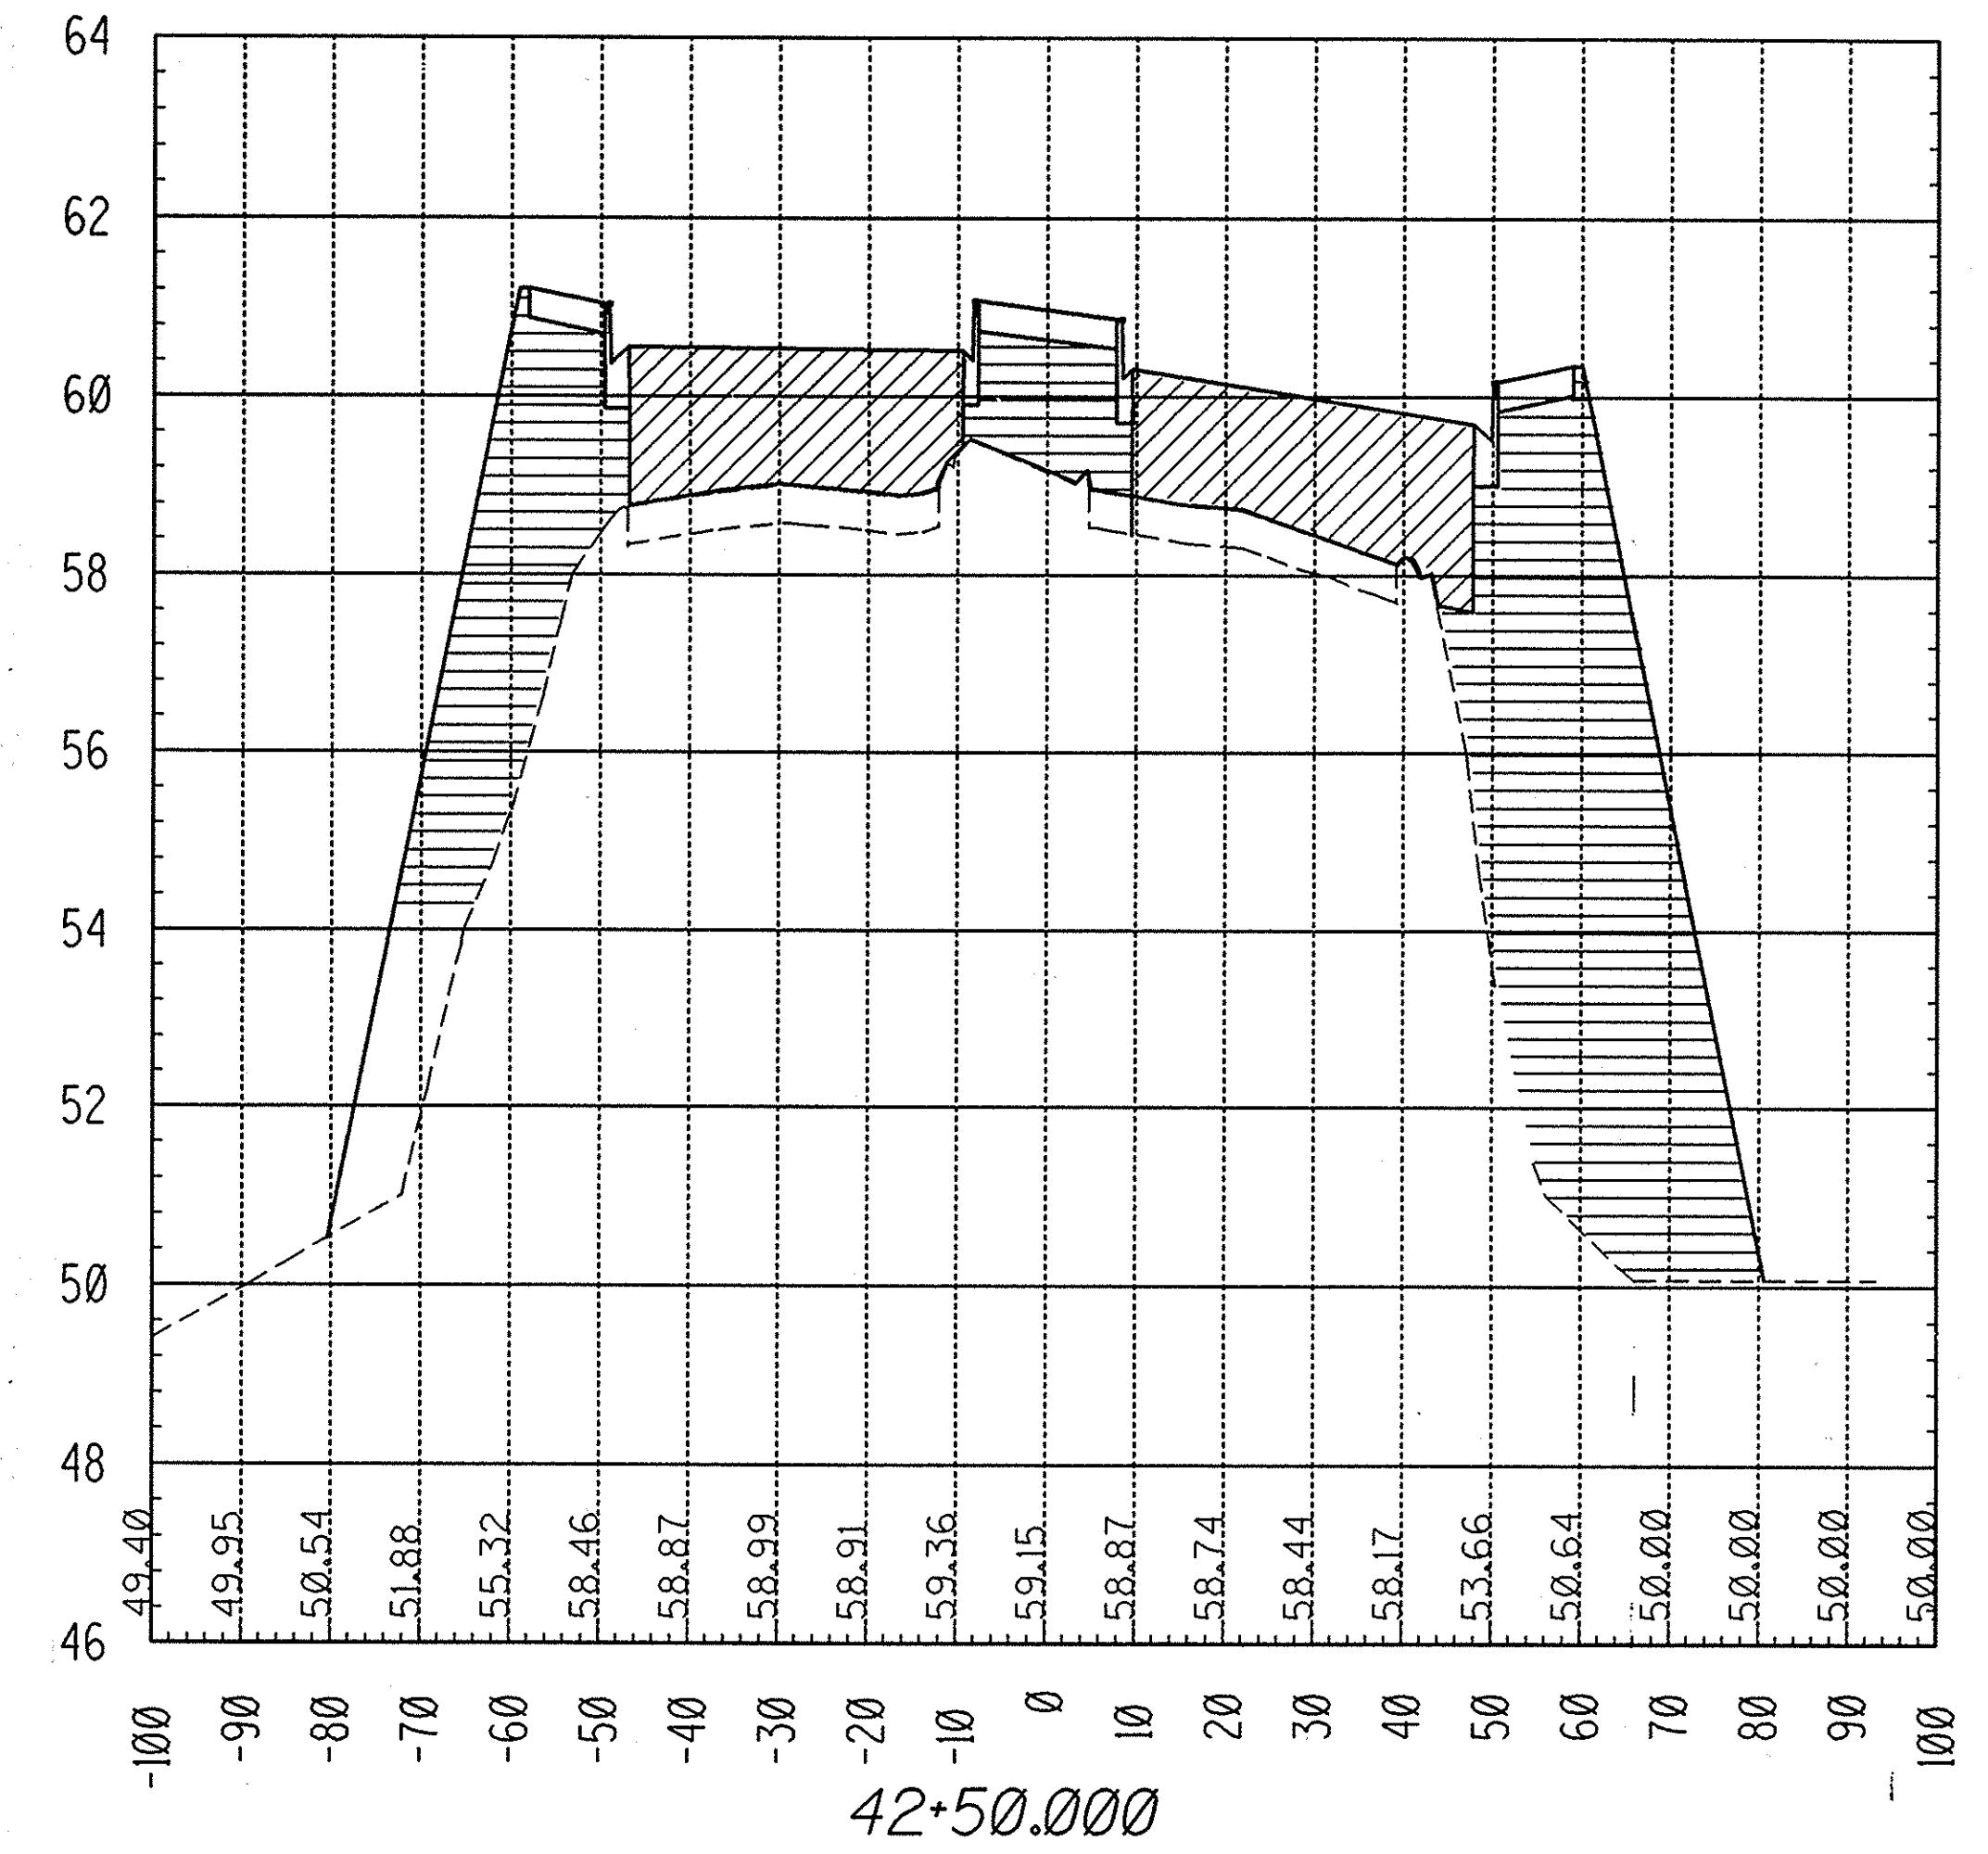
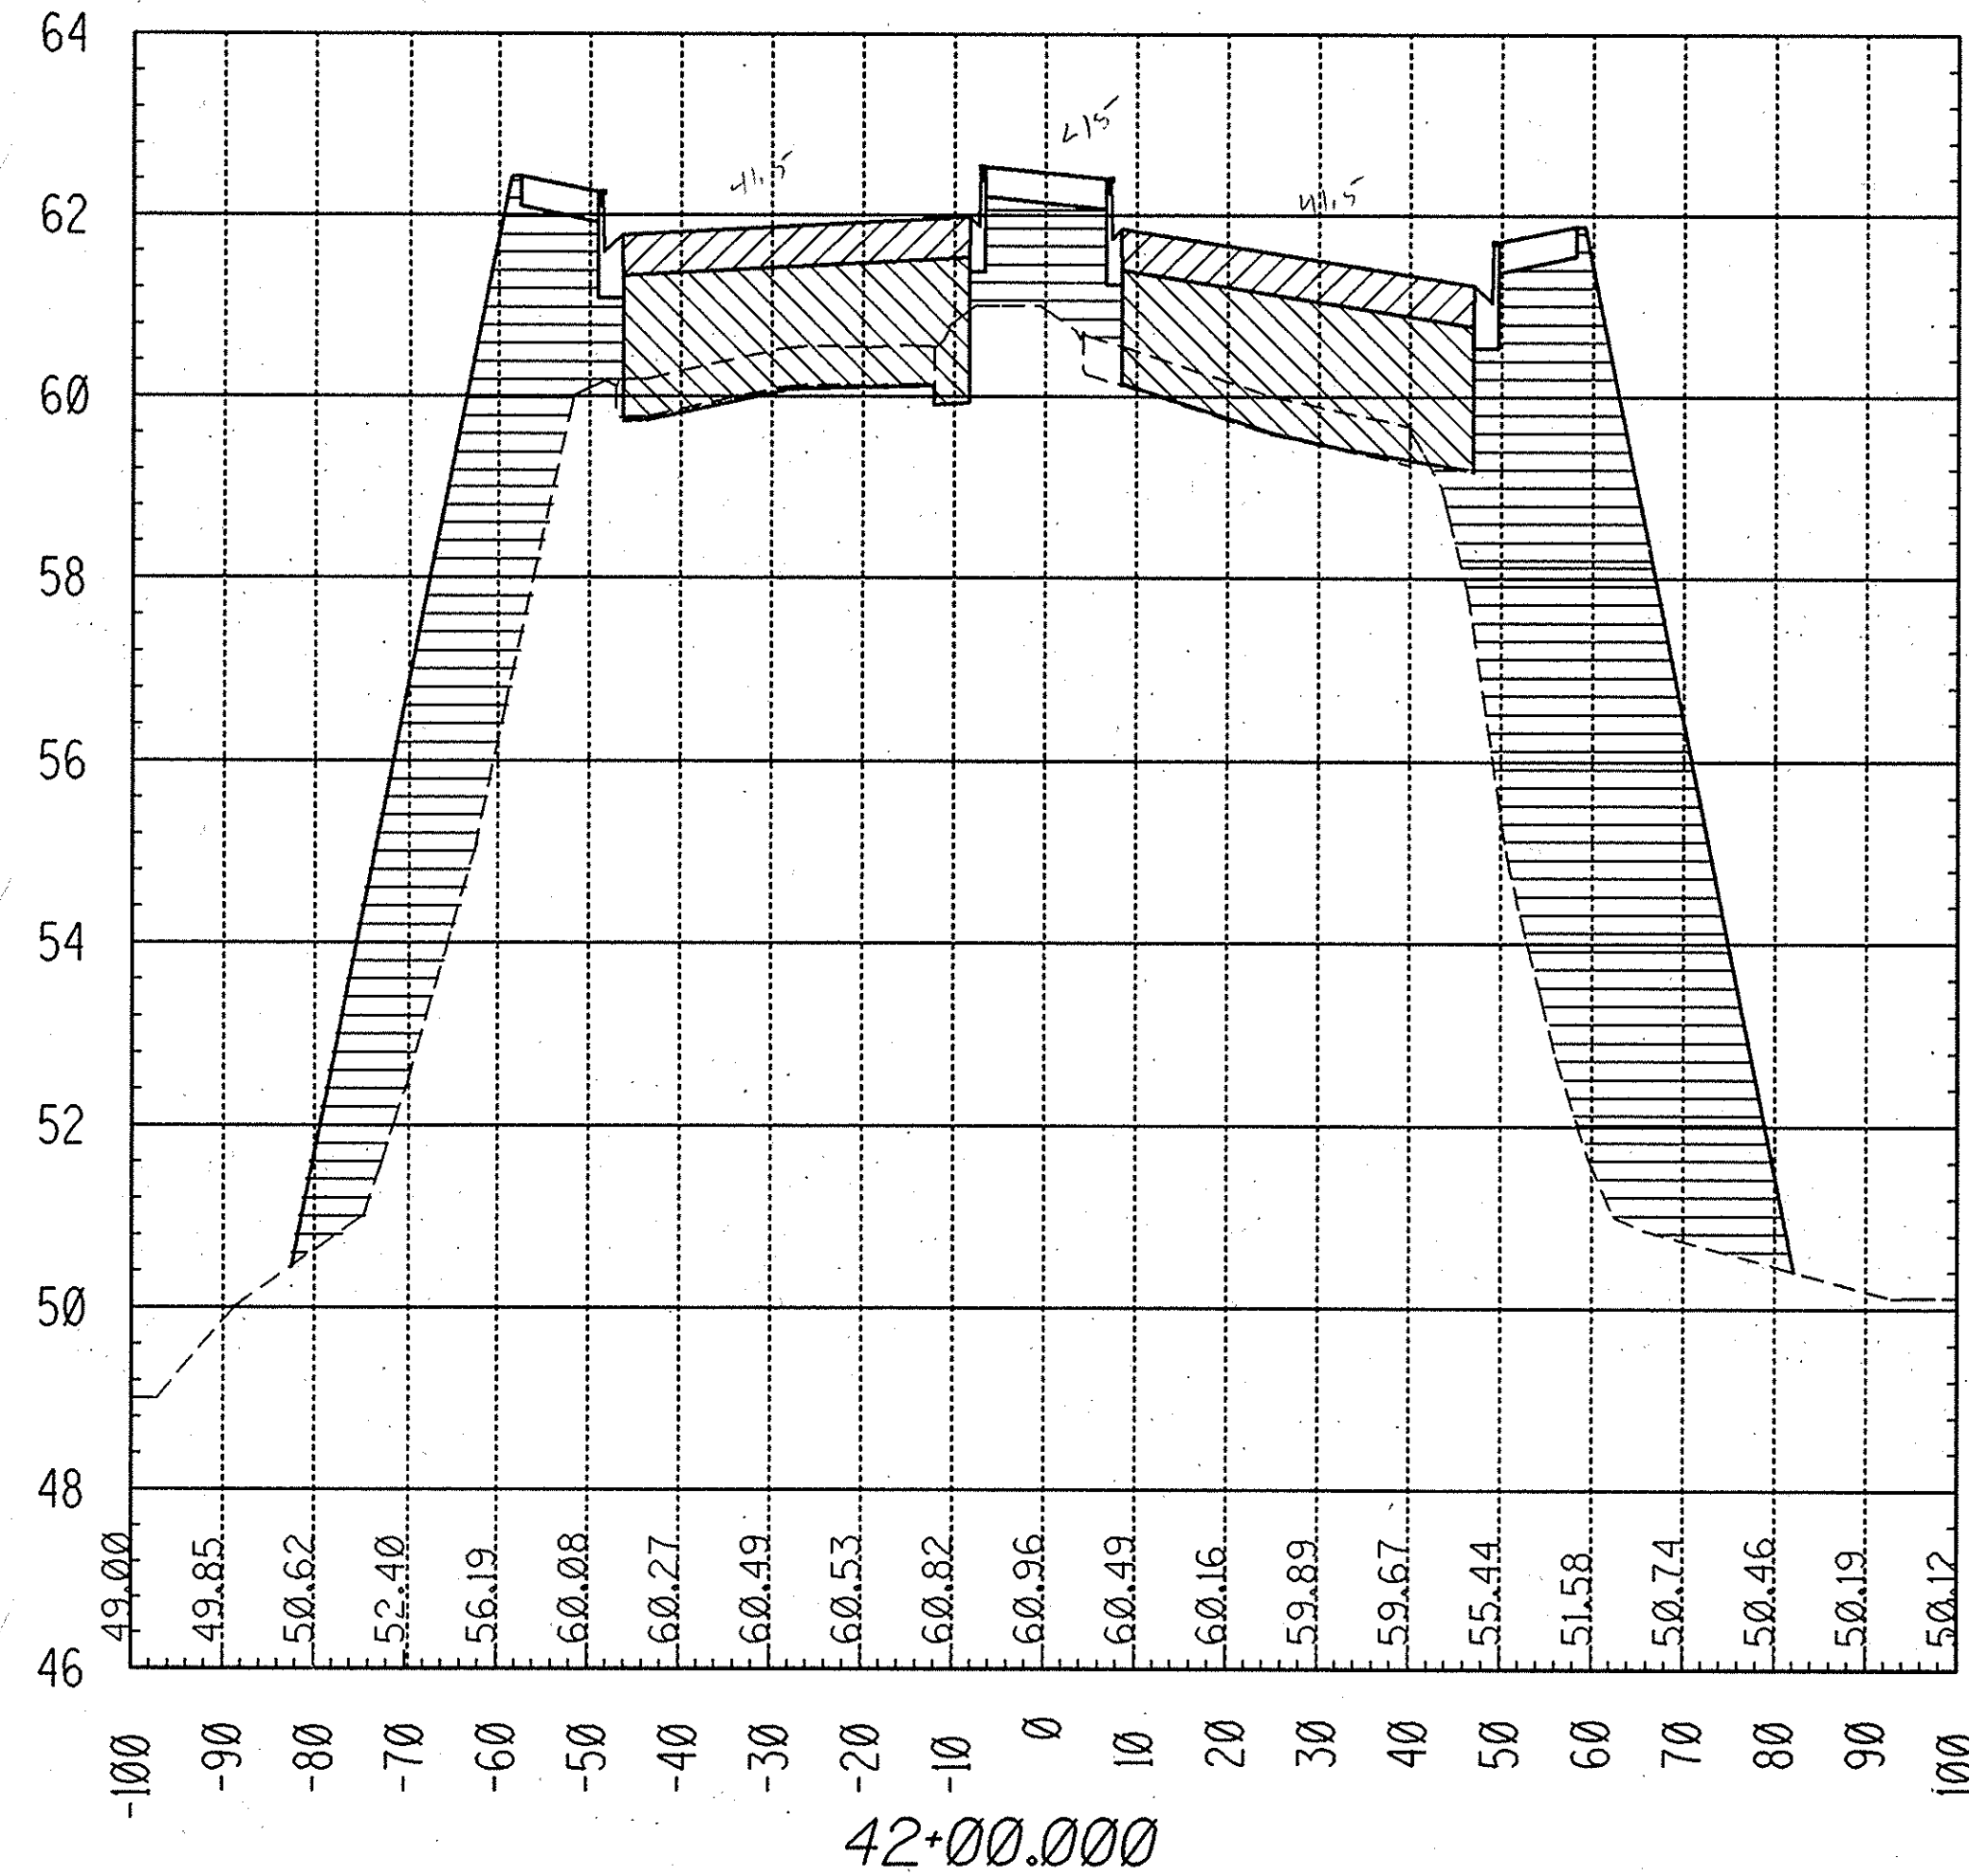
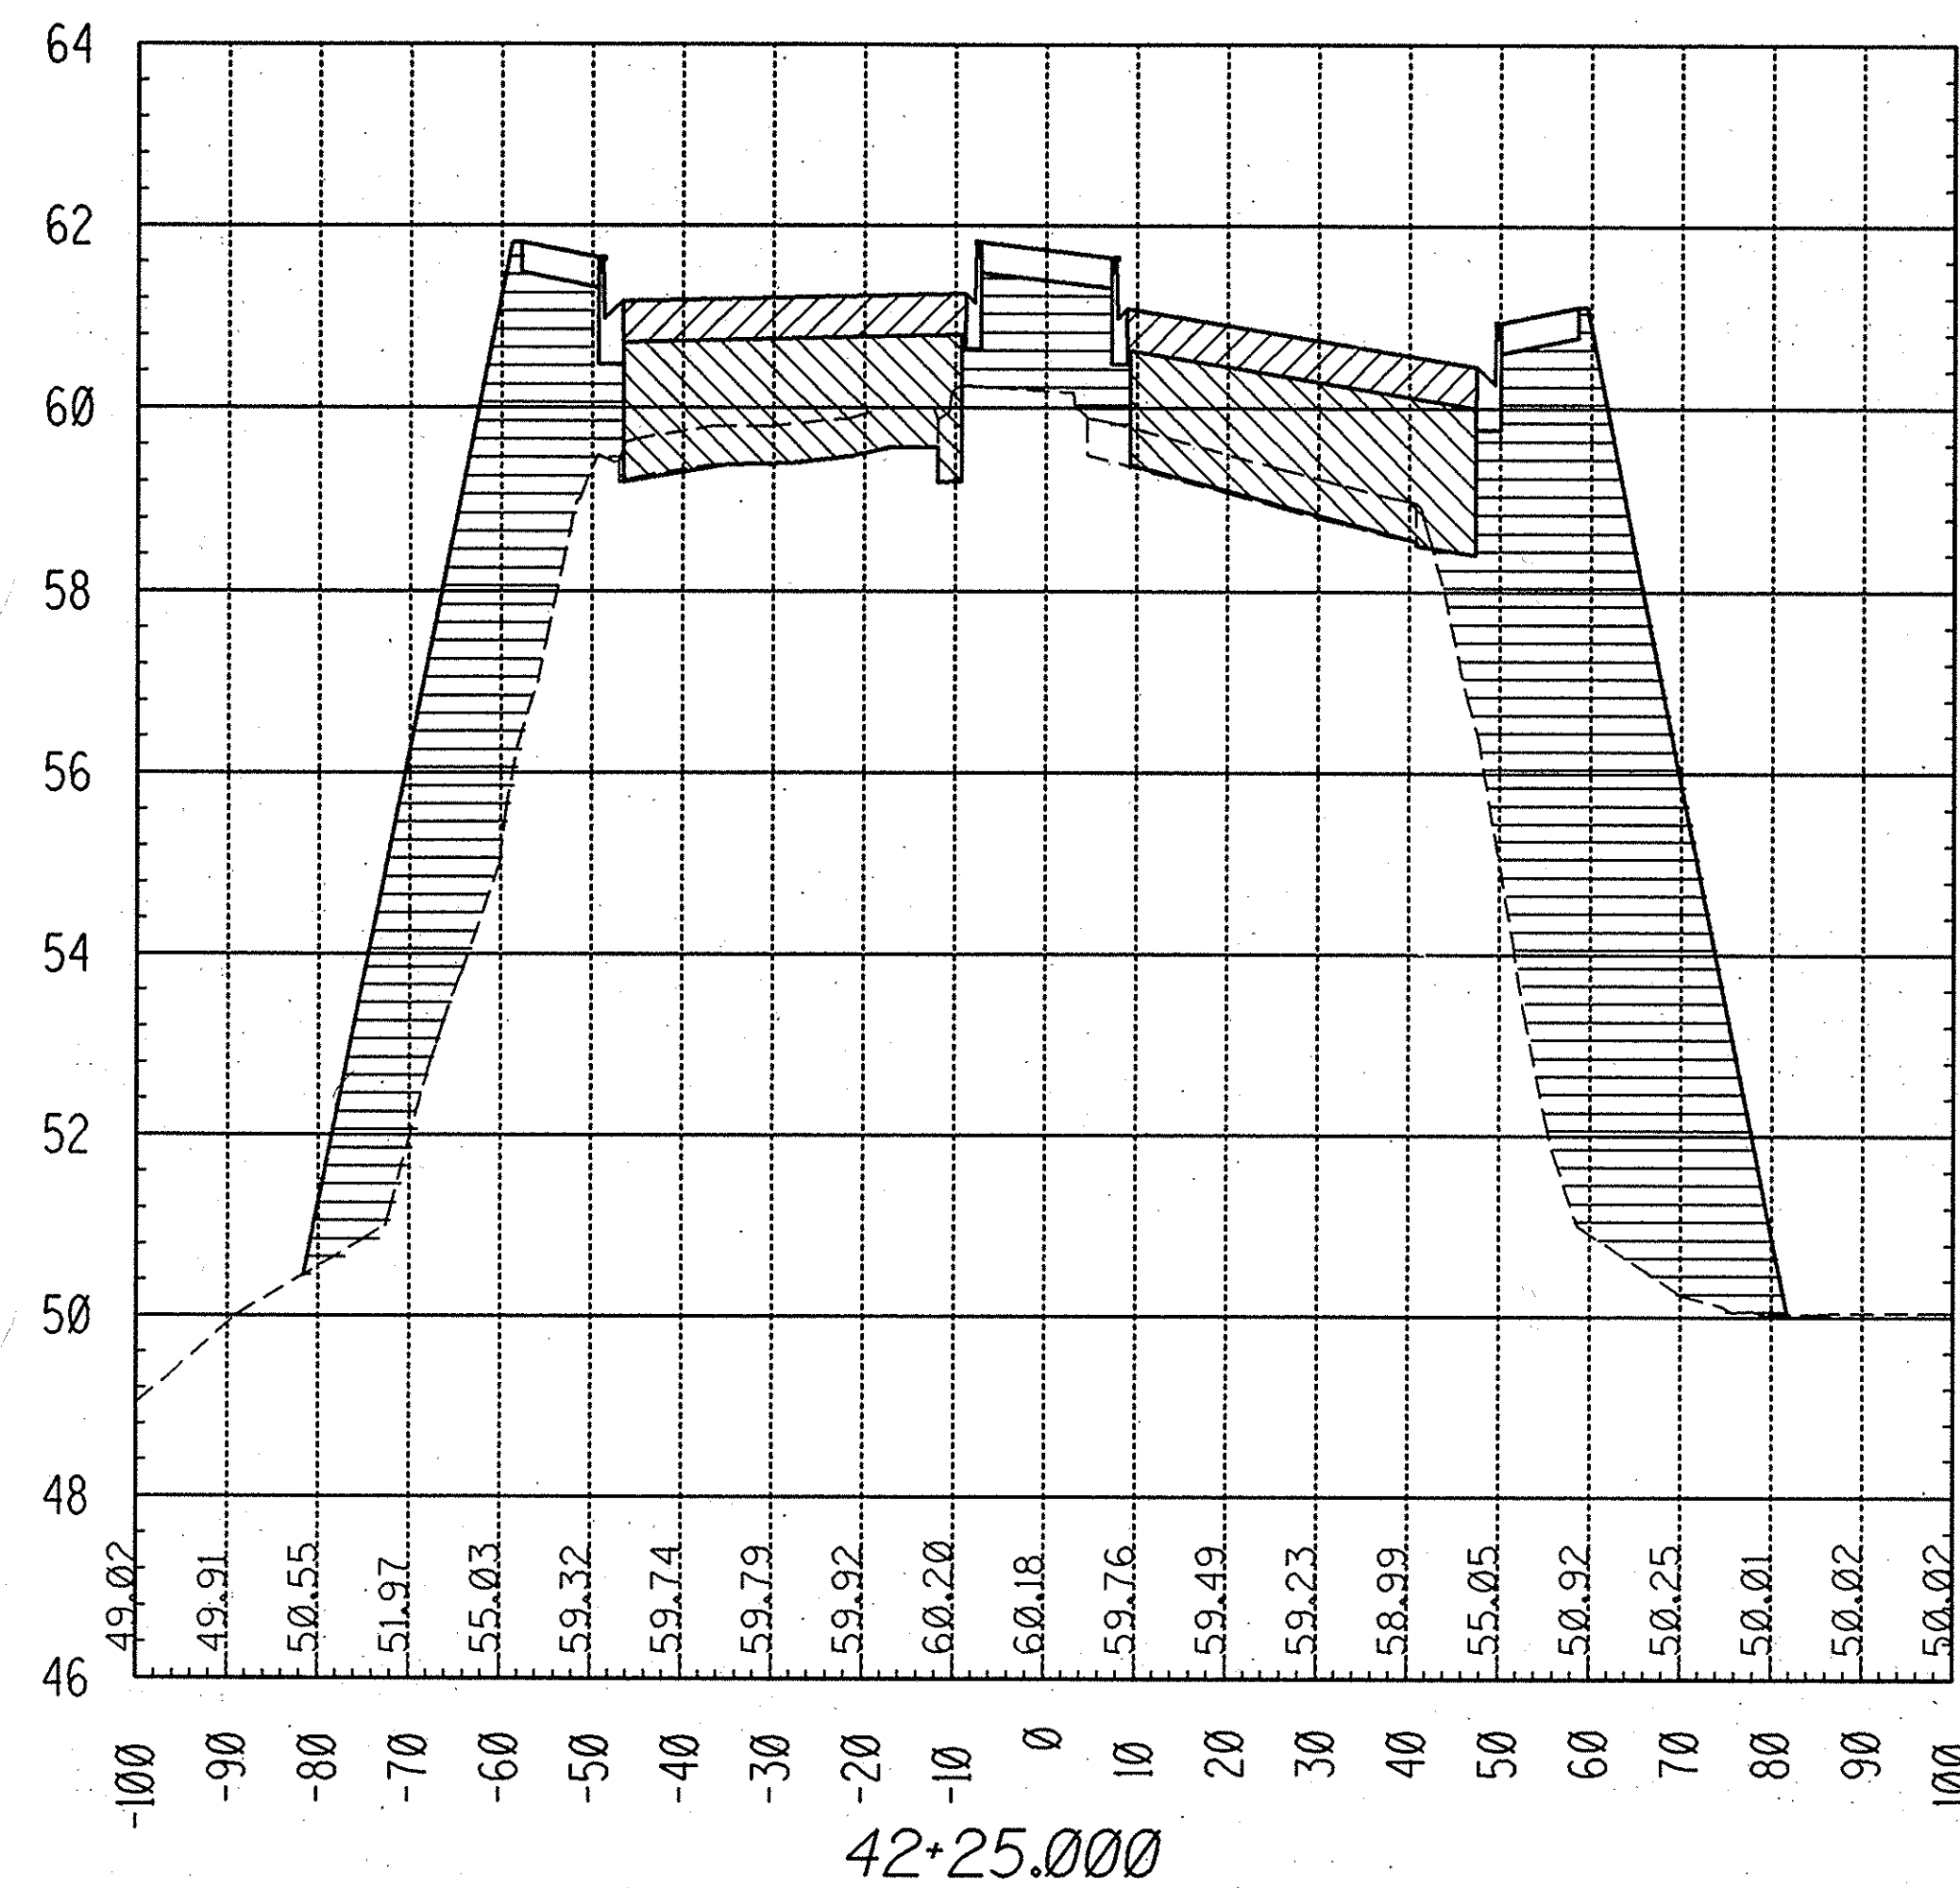


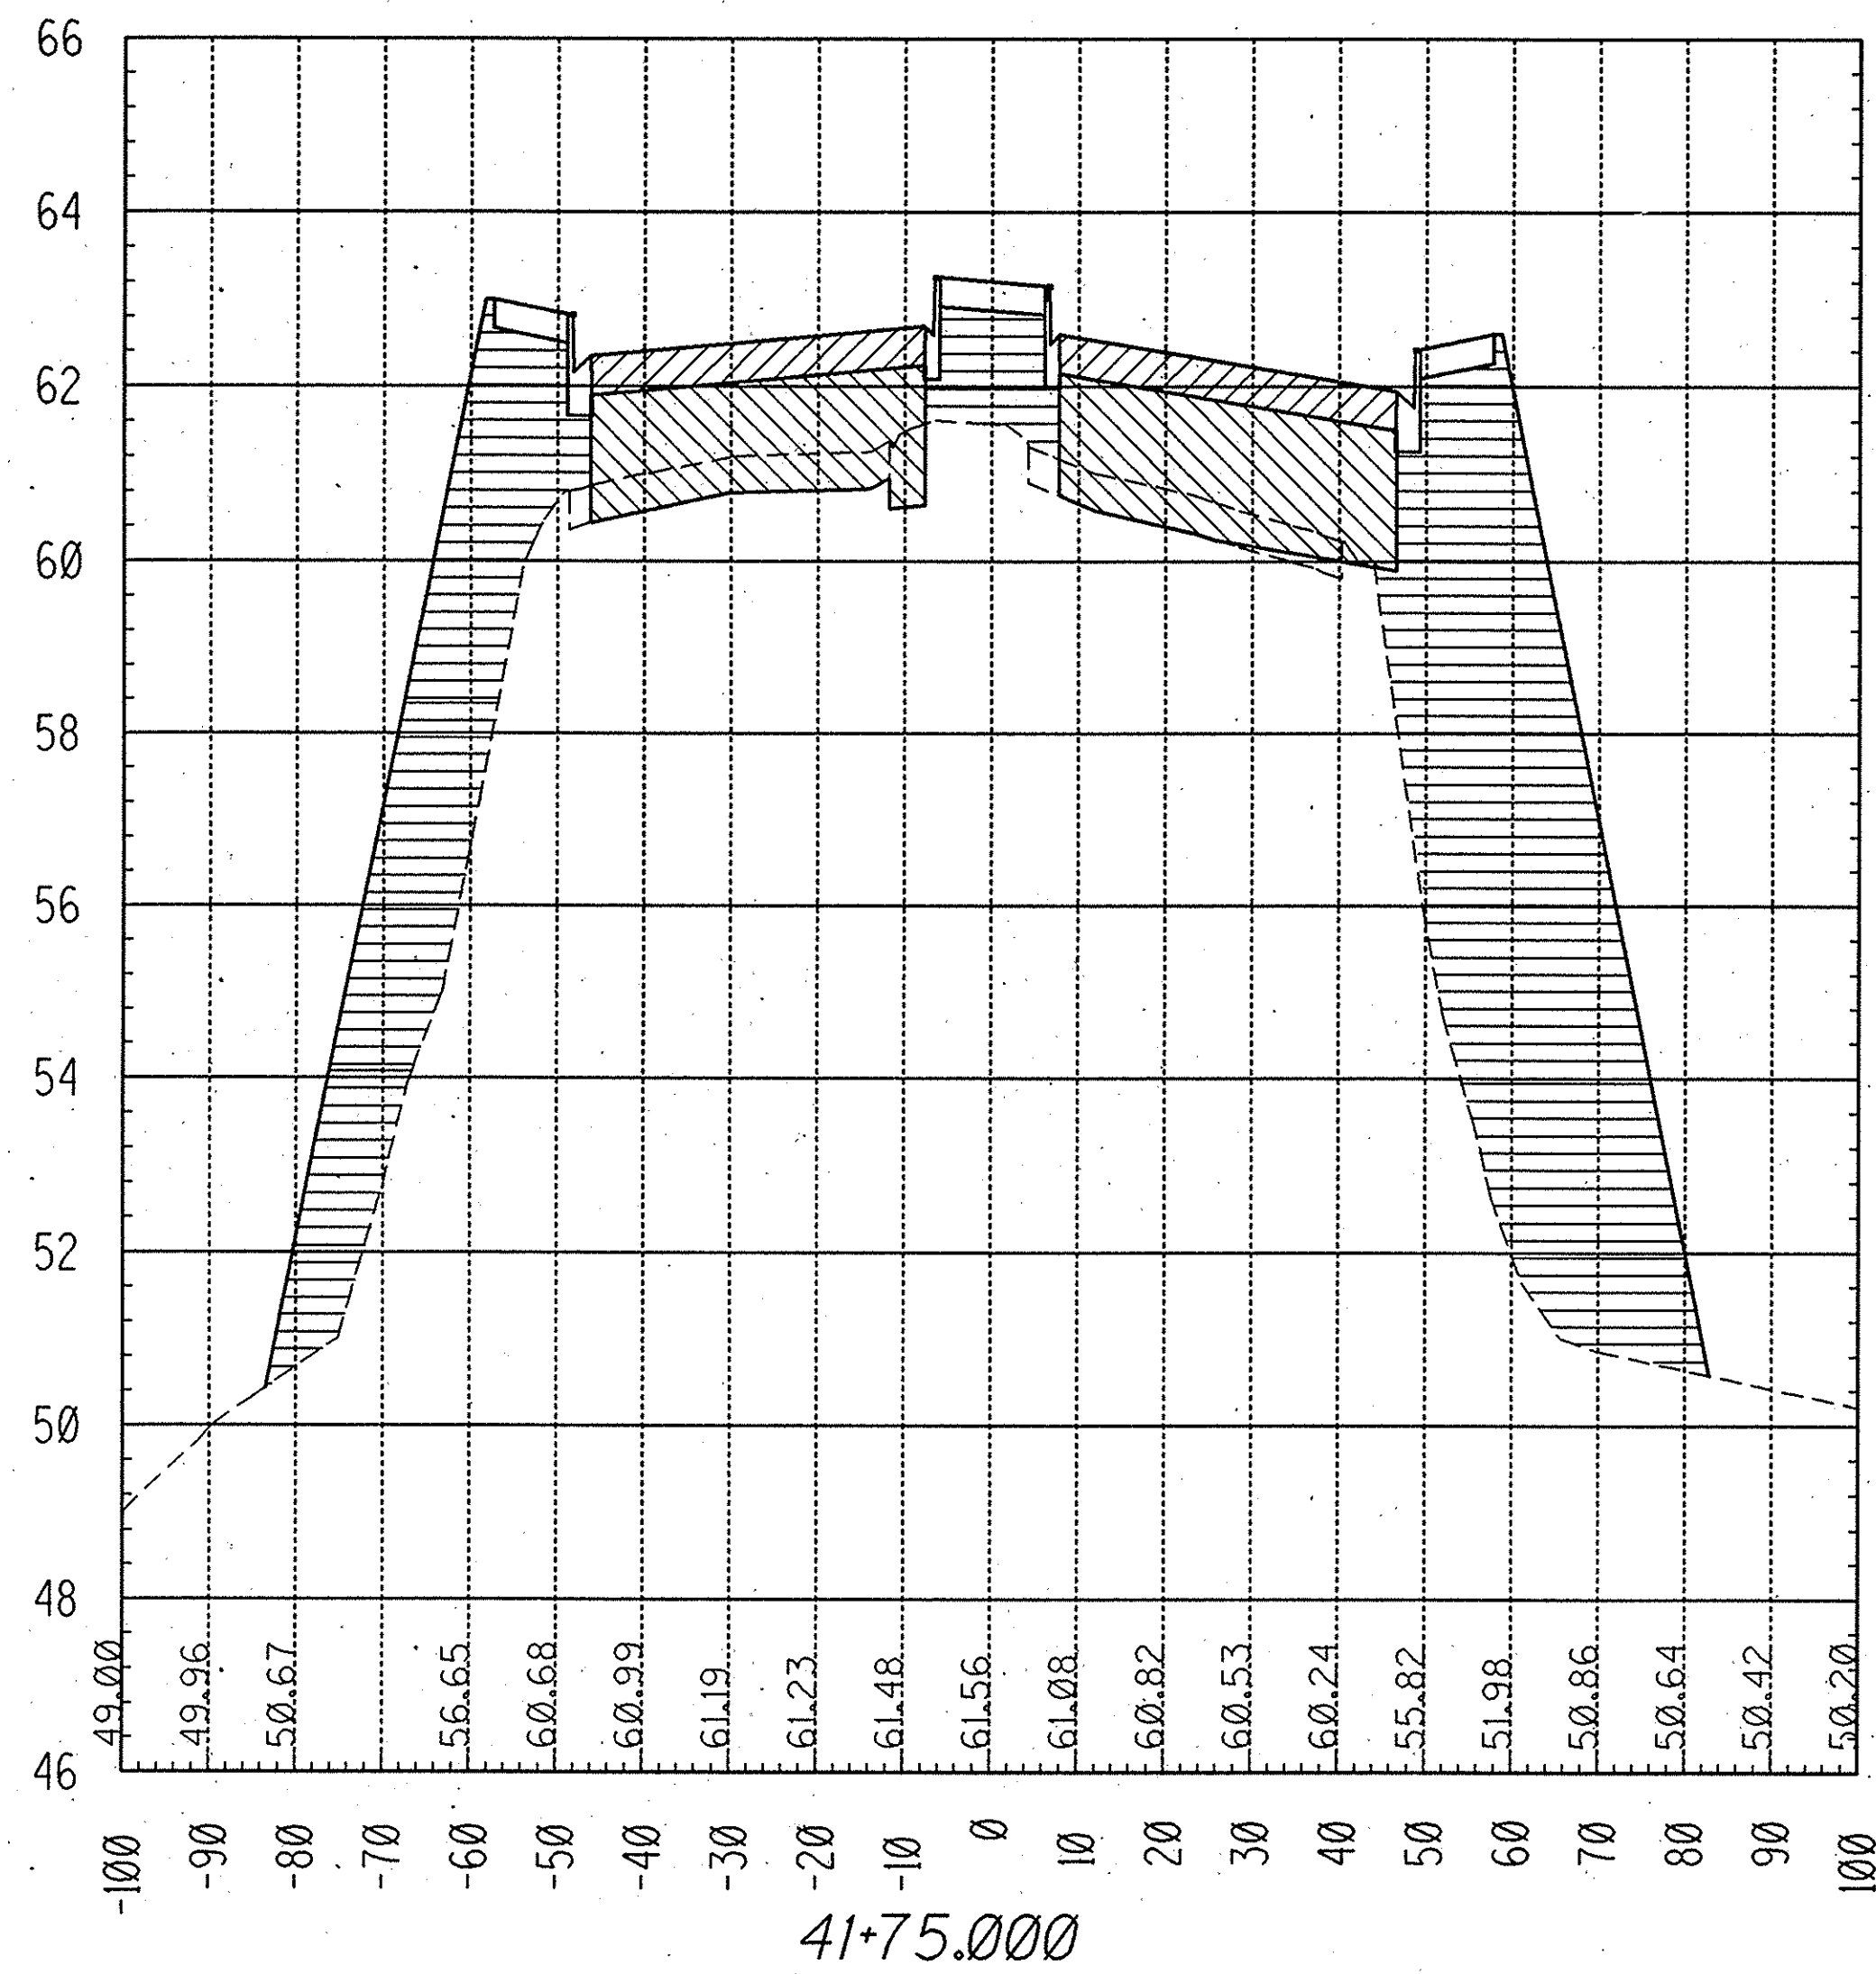

LEGEND

- AGGREGATE BASE MATERIAL
- ASPHALT CONCRETE
- UNCLASSIFIED FILL

1/2 0 2
3 inches on original drawing

RECORD DRAWING

ORANGE COUNTY ENVIRONMENTAL MANAGEMENT AGENCY	
HARBOR BLVD. IMPROVEMENTS	
CROSS SECTIONS 41+75 to 42+50	
DESIGNED - RBS	CHECKED - RAH
DRAWN - SG/AHP	DATE 3-93
SCALE AS SHOWN	DRAWING NO.
PREPARED UNDER RICHARD HARRIS RCE 39595 (exp. 12-31-93)	SHEET 57 OF 60

PROFILE
HORIZ. 1"=20'
VERT. 1"=2'