
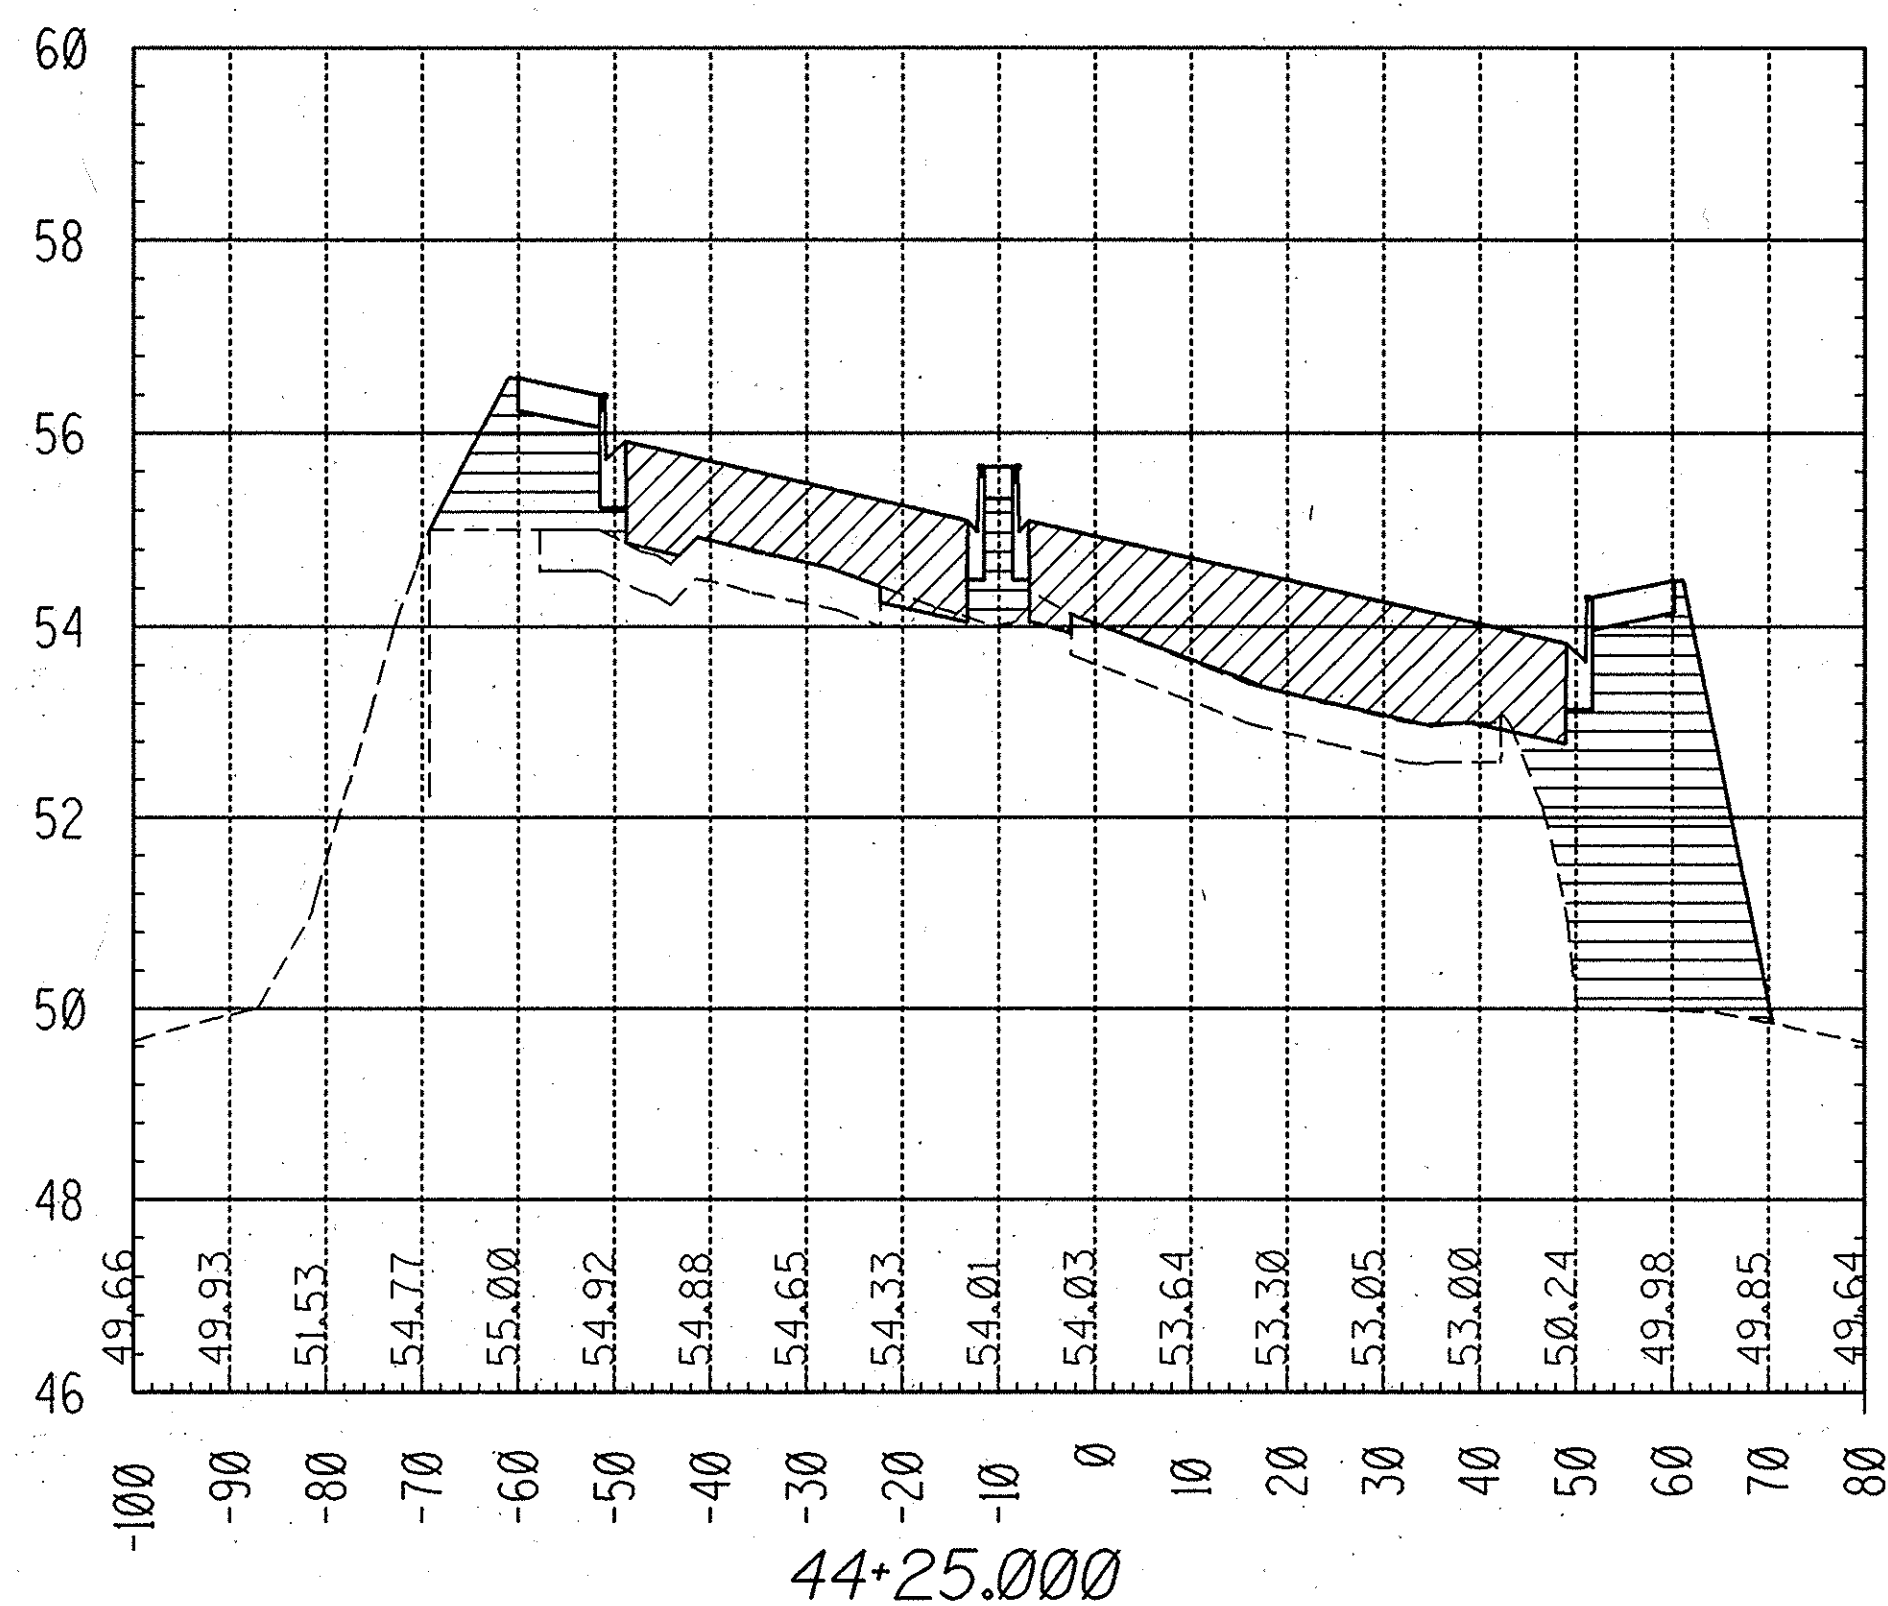
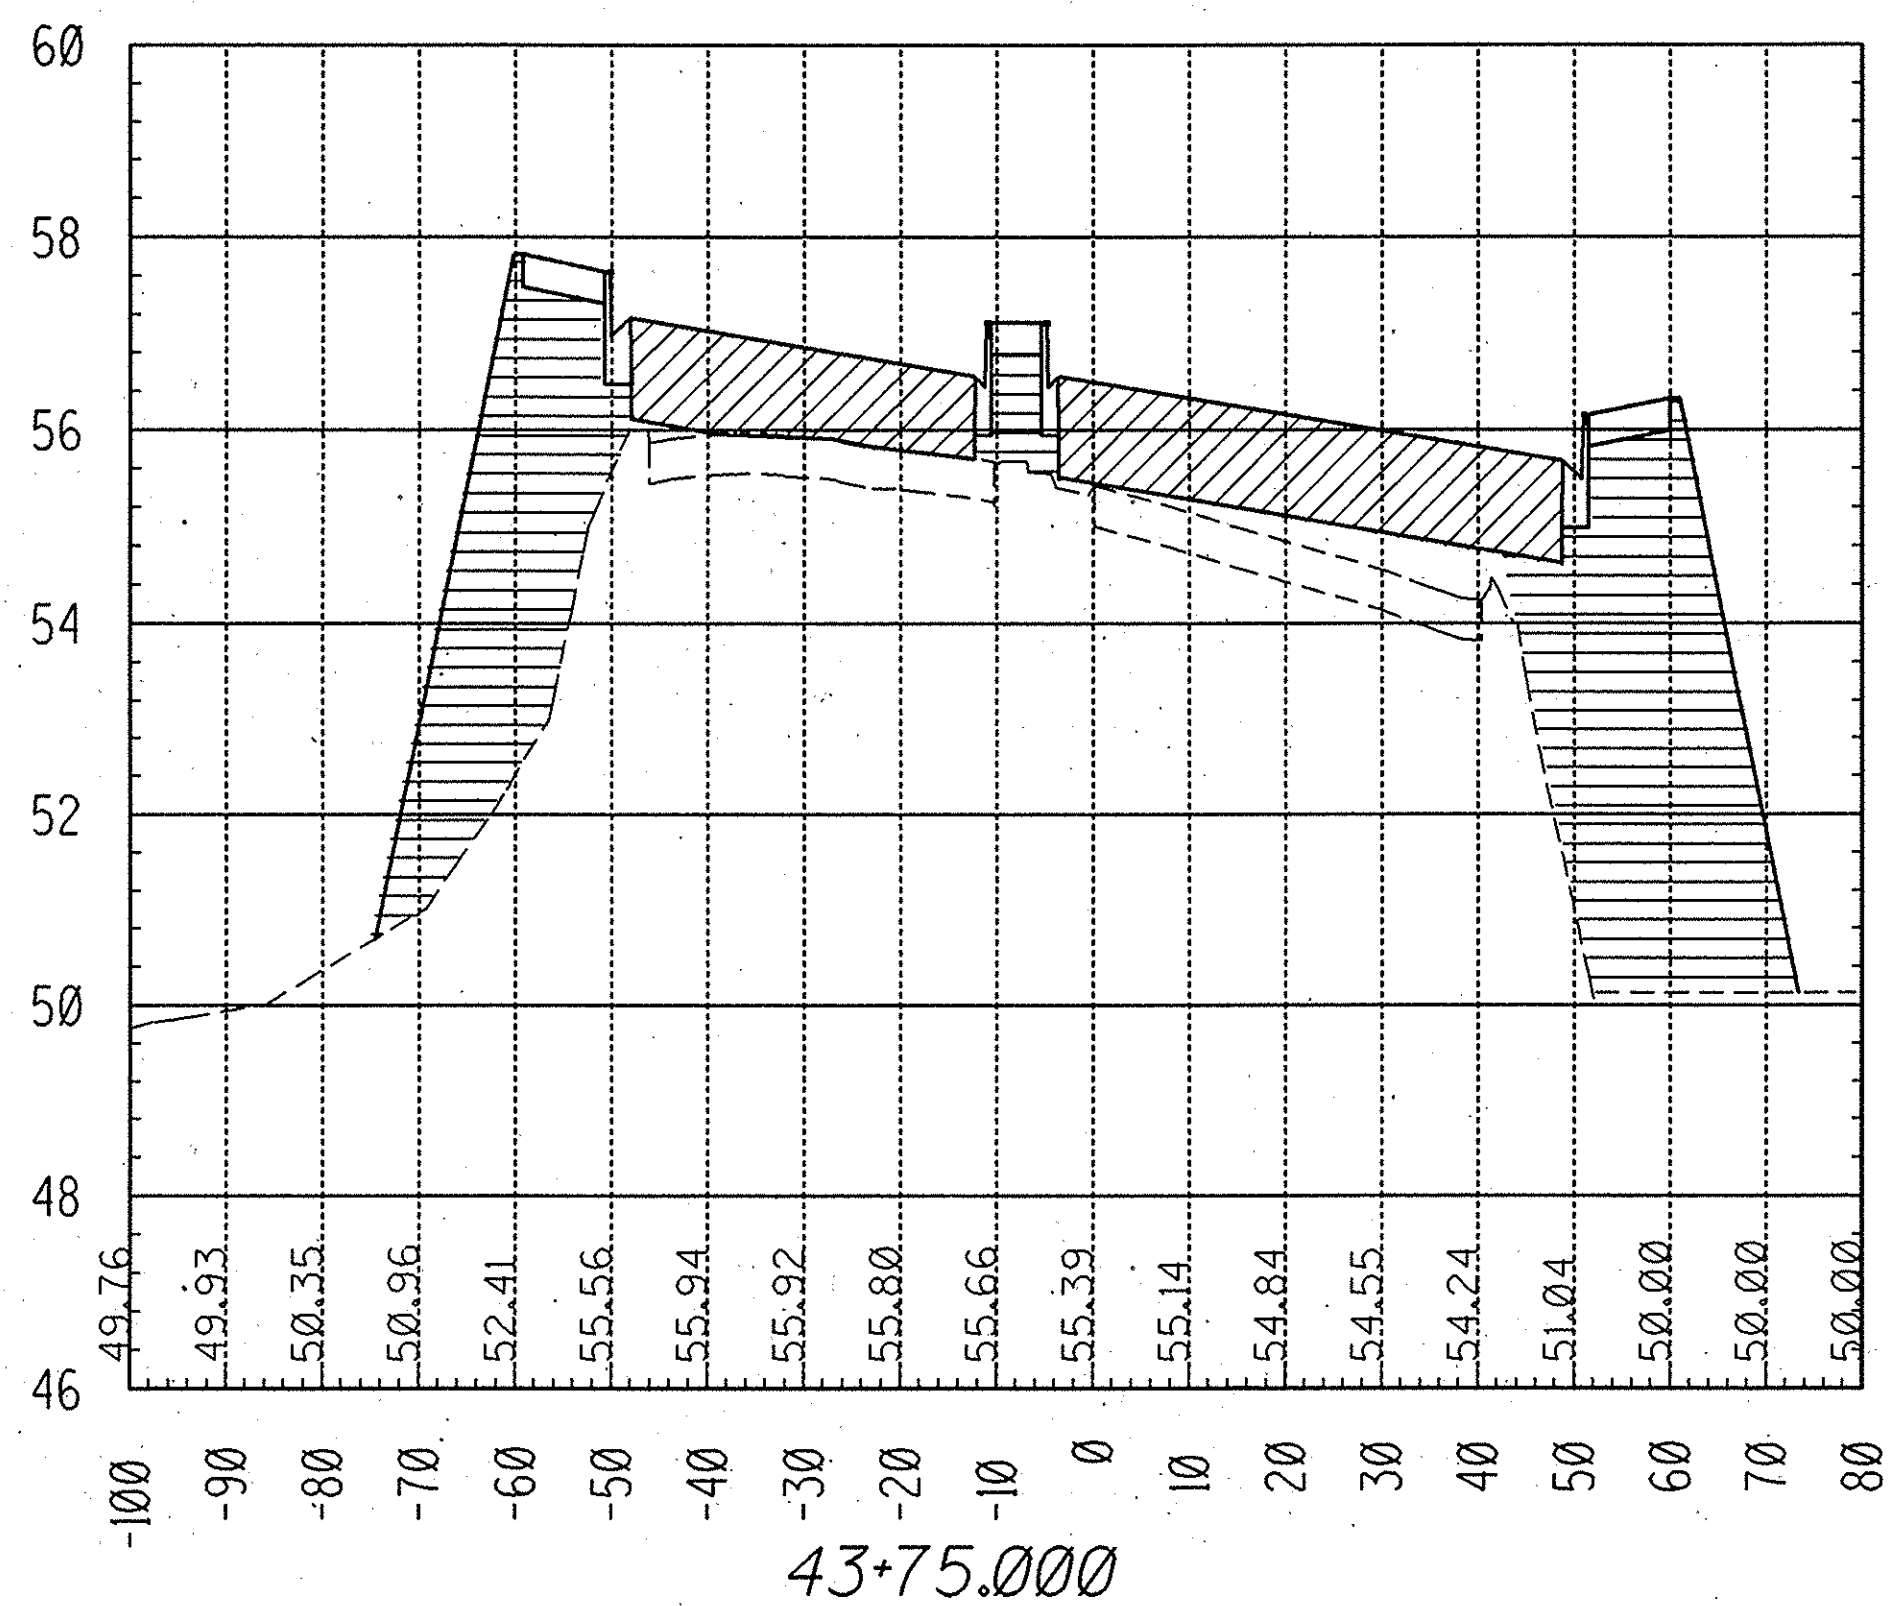
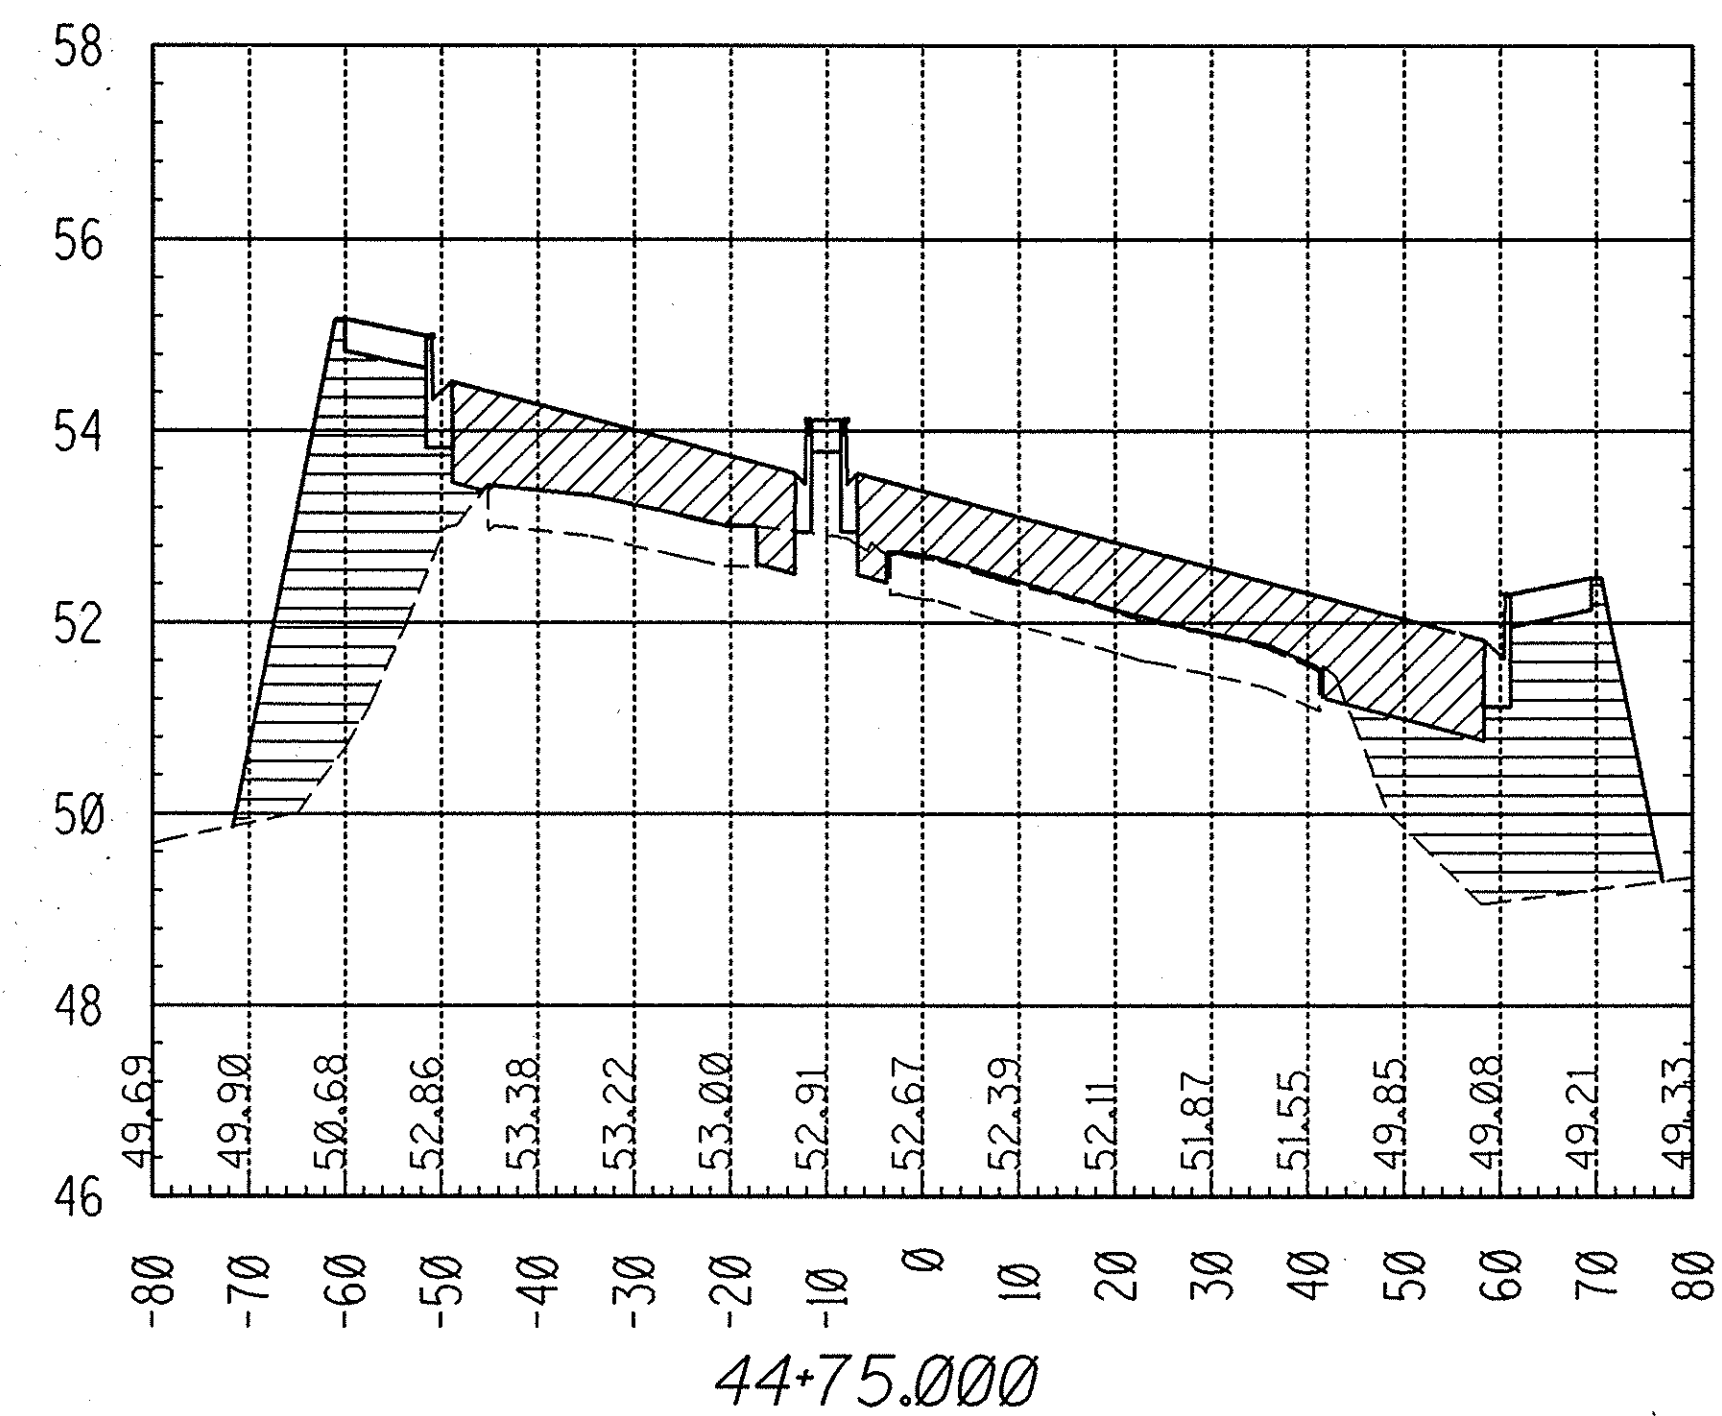
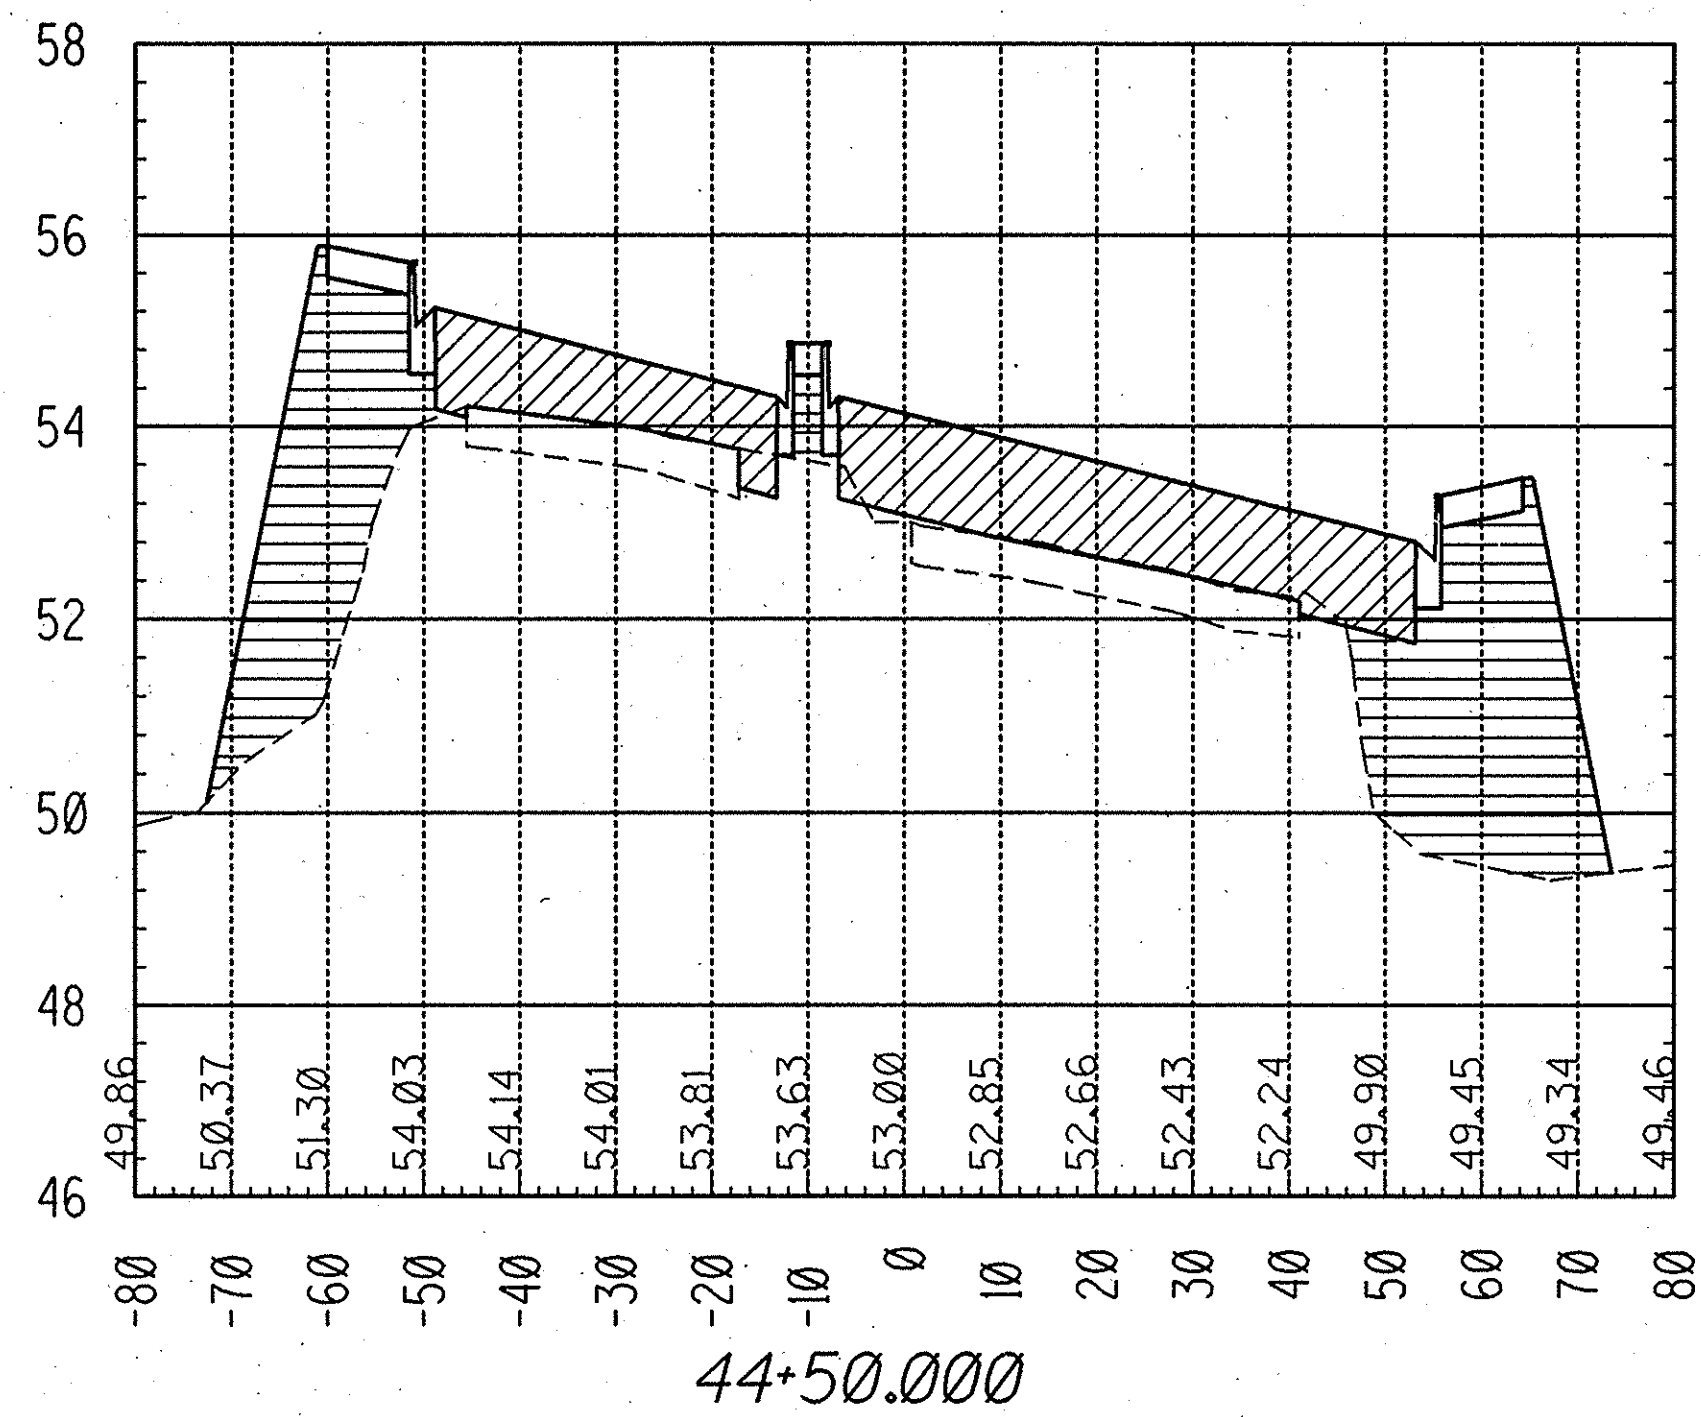


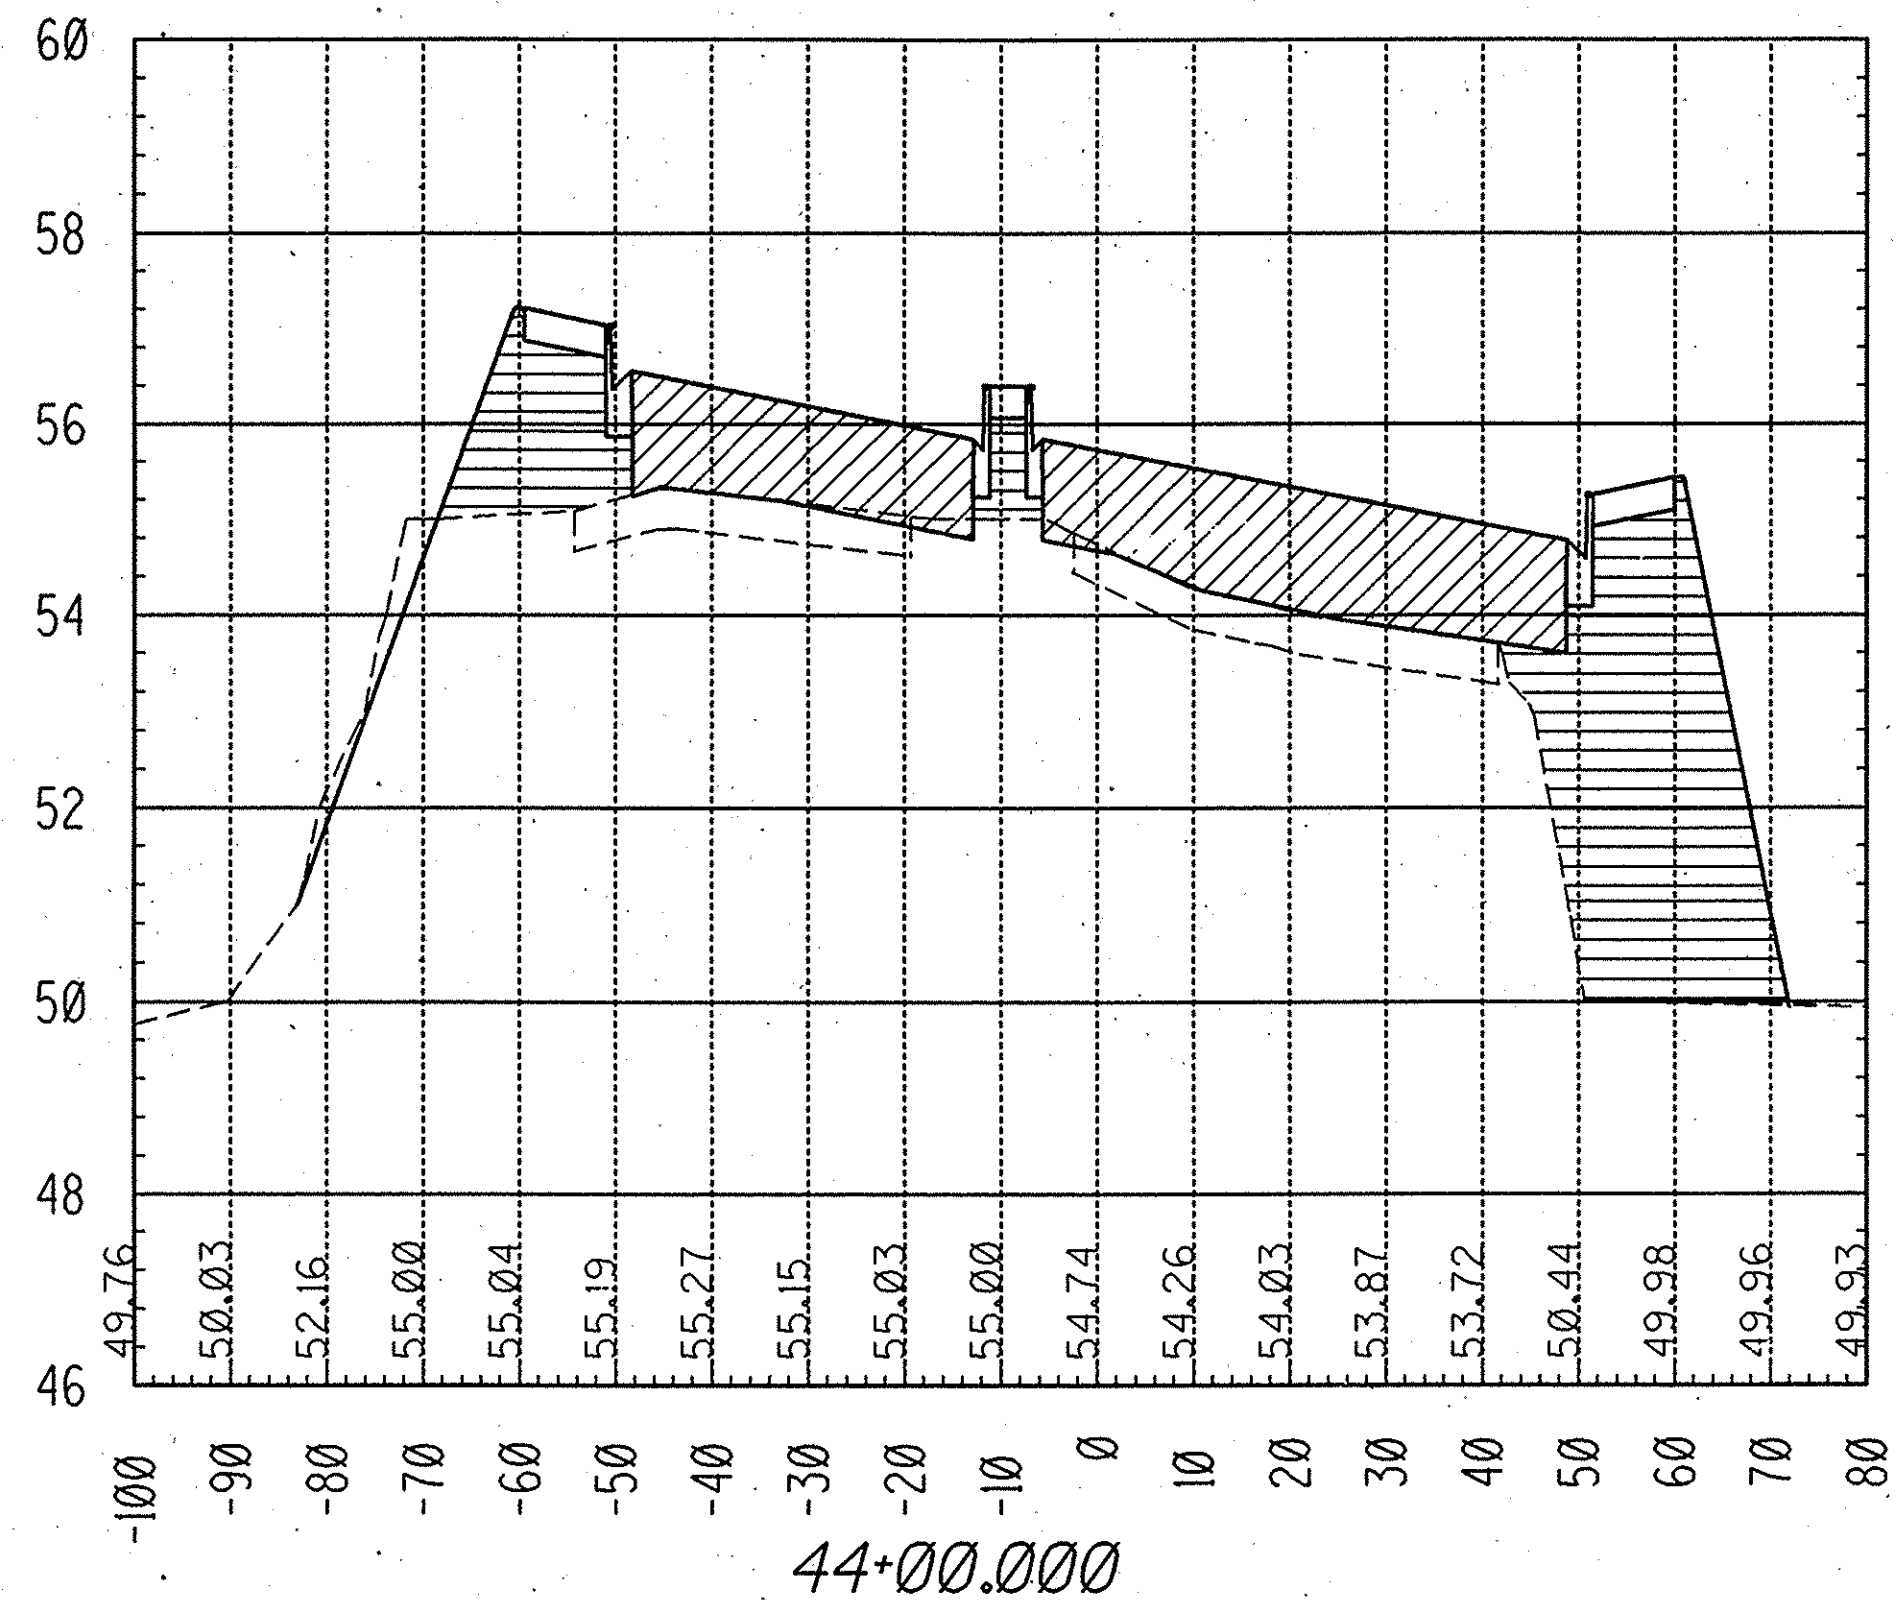

LEGEND

- AGGREGATE BASE MATERIAL
- ASPHALT CONCRETE
- UNCLASSIFIED FILL

RECORD DRAWING

1/2 0 1 2
3 inches on original drawing

ORANGE COUNTY ENVIRONMENTAL MANAGEMENT AGENCY	
HARBOR BLVD. IMPROVEMENTS	
CROSS SECTIONS 43+75 to 44+75	
DESIGNED - RBS	CHECKED - RAH
DRAWN - SGZ	DATE 3-93
SCALE AS SHOWN	DRAWING NO. 59 OF 60

PREPARED UNDER THE SEAL OF RICHARD A. RCE 39595 (exp. 12-31-93)

3/4/93