
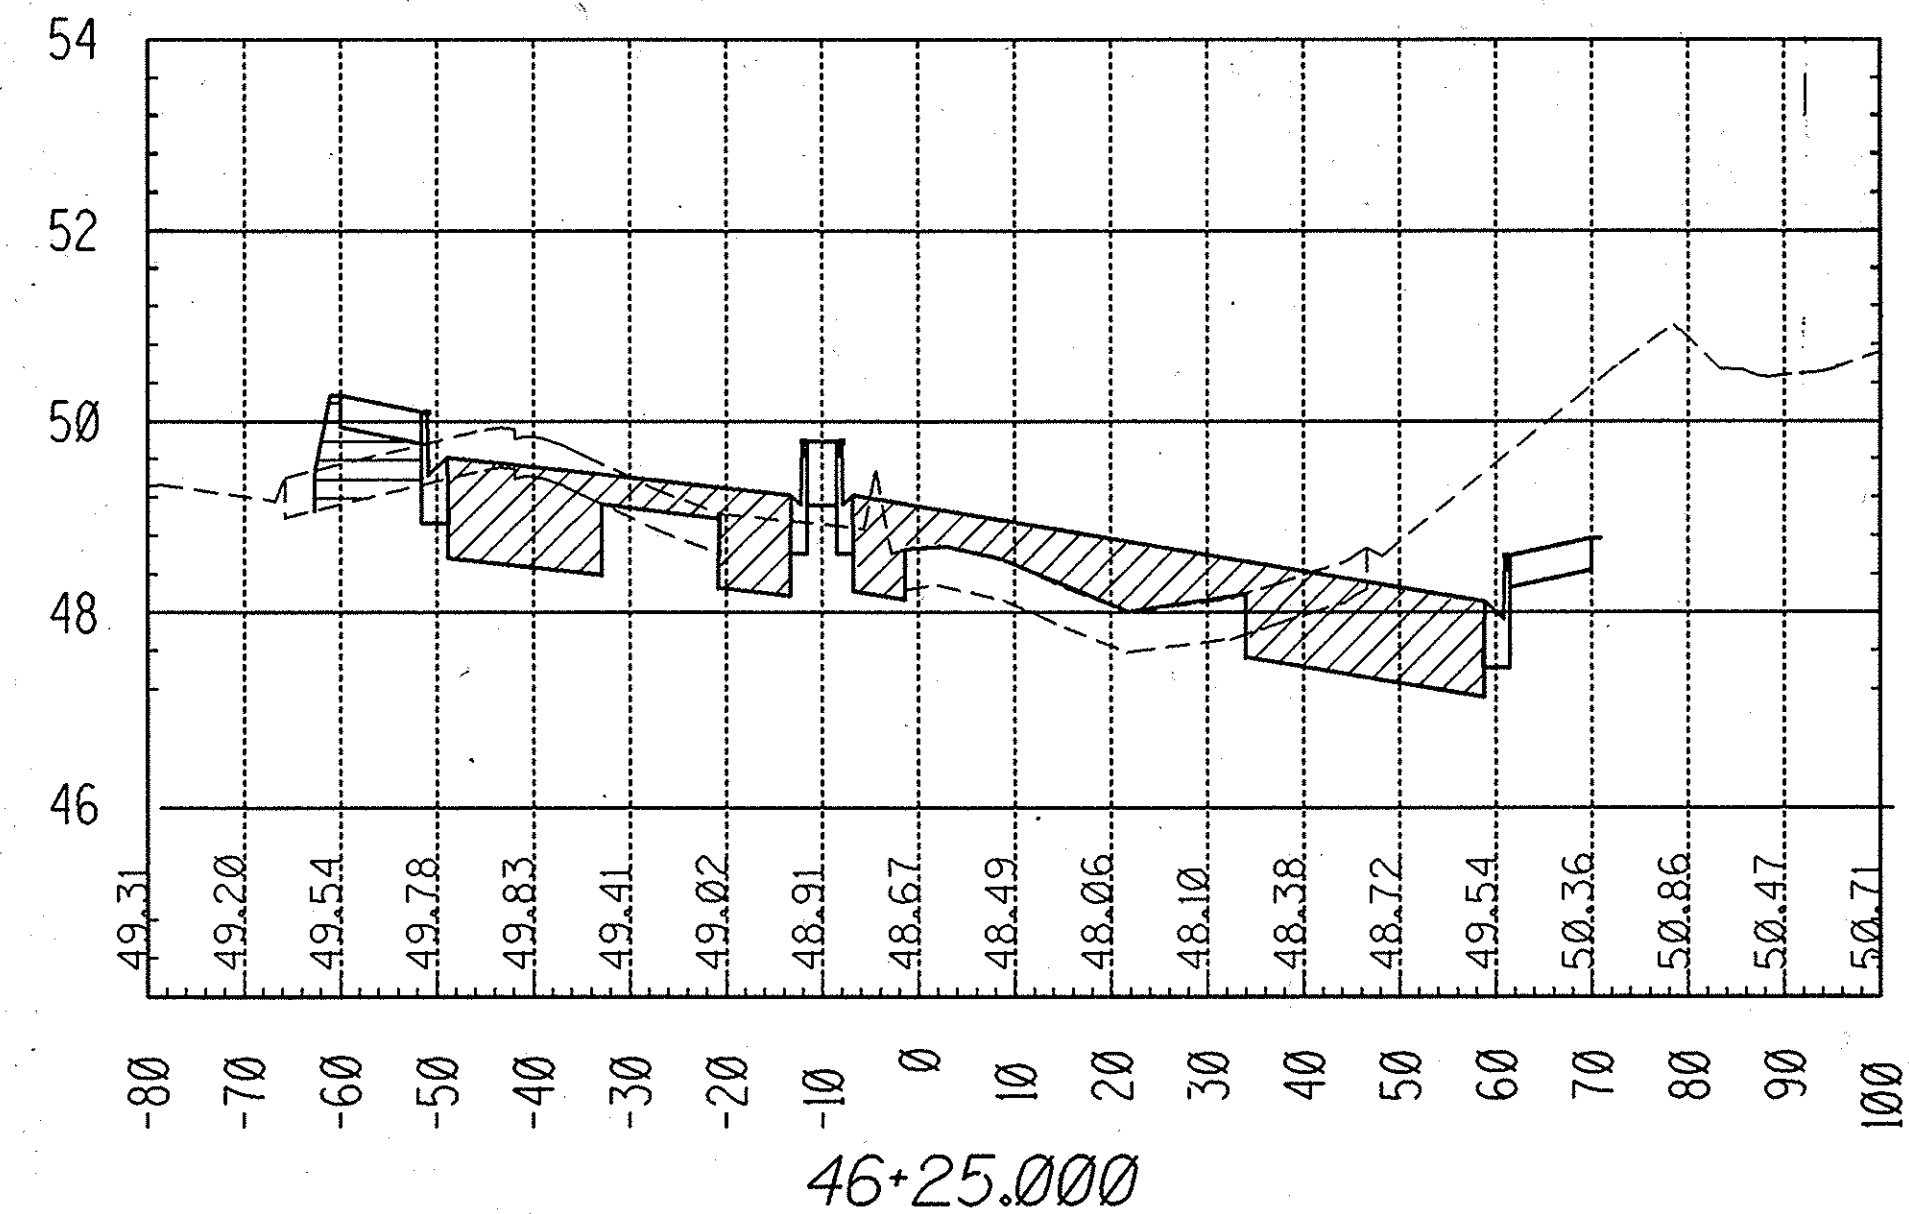
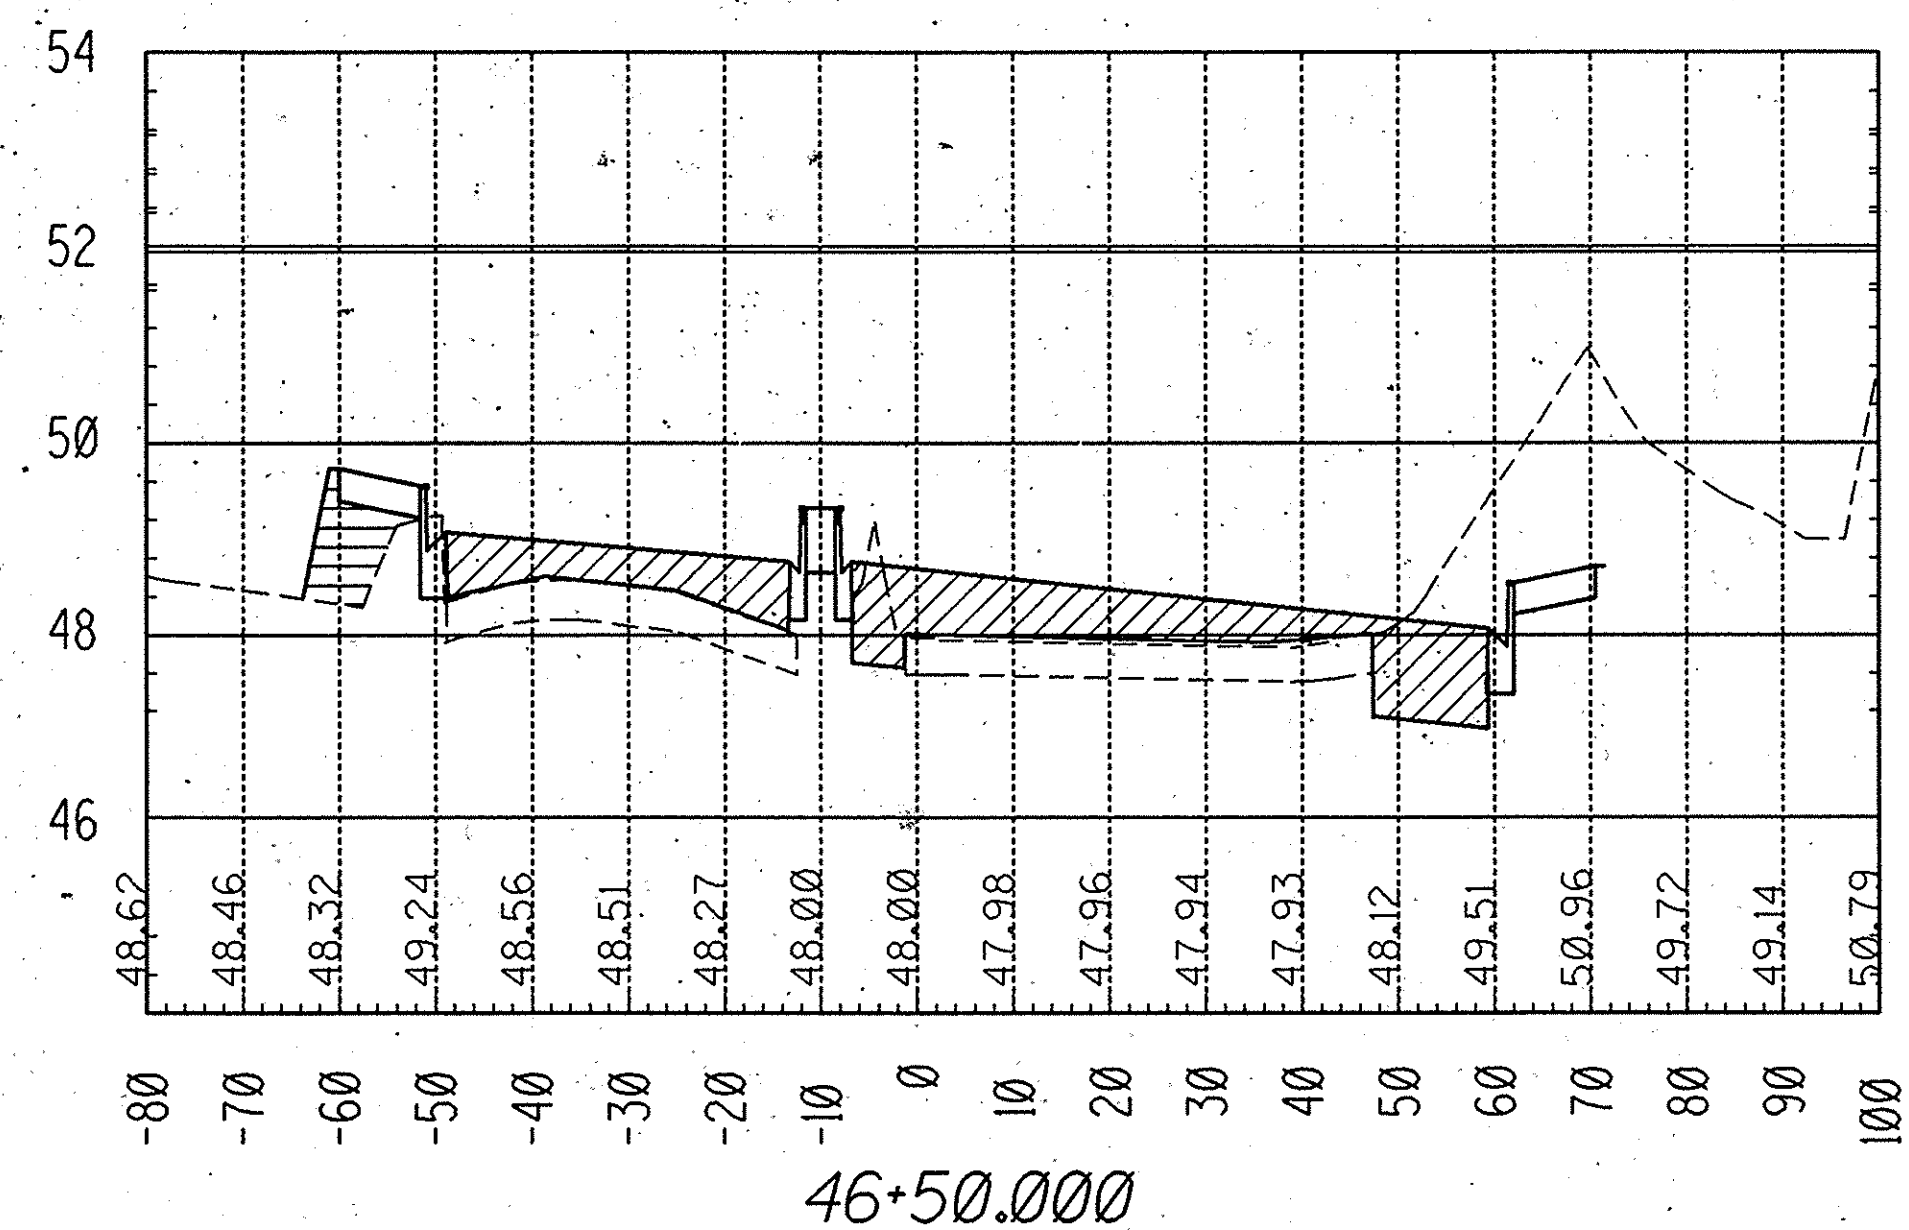
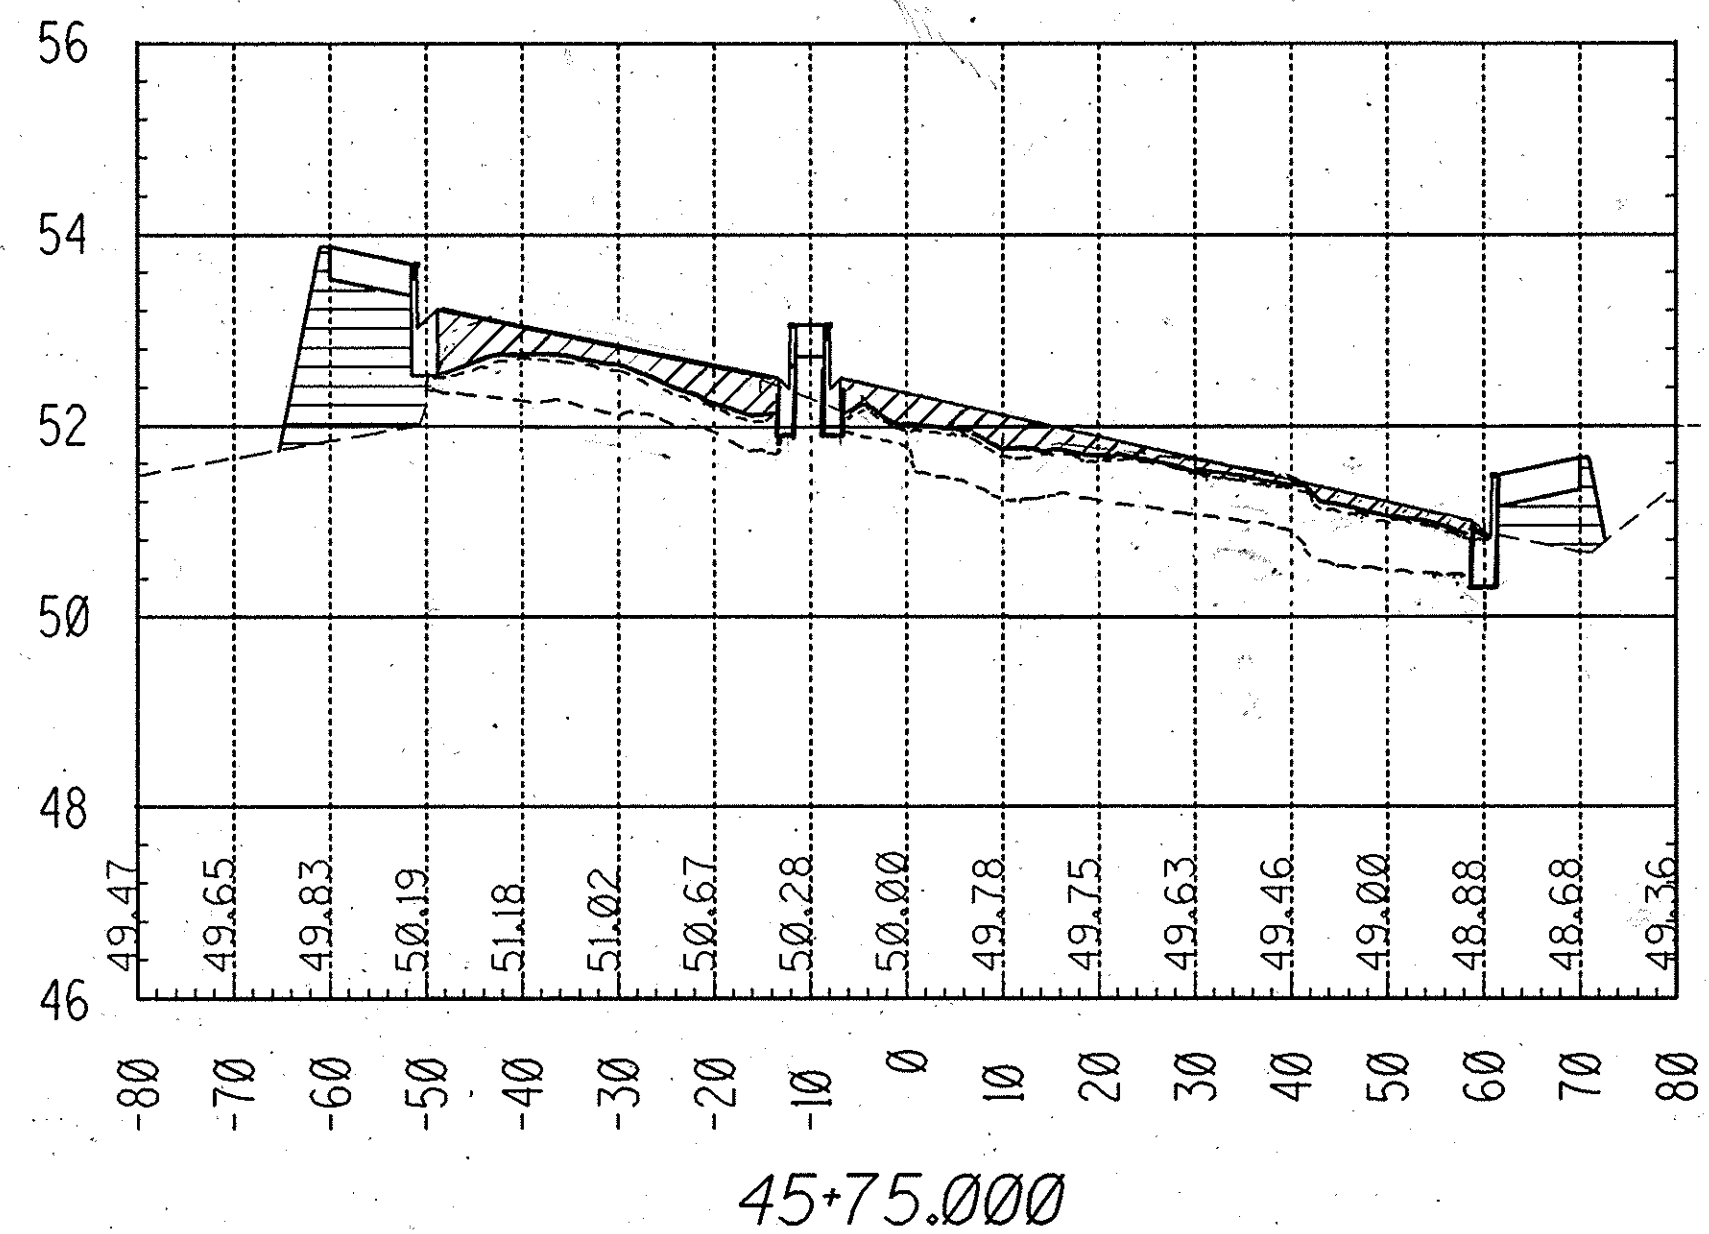
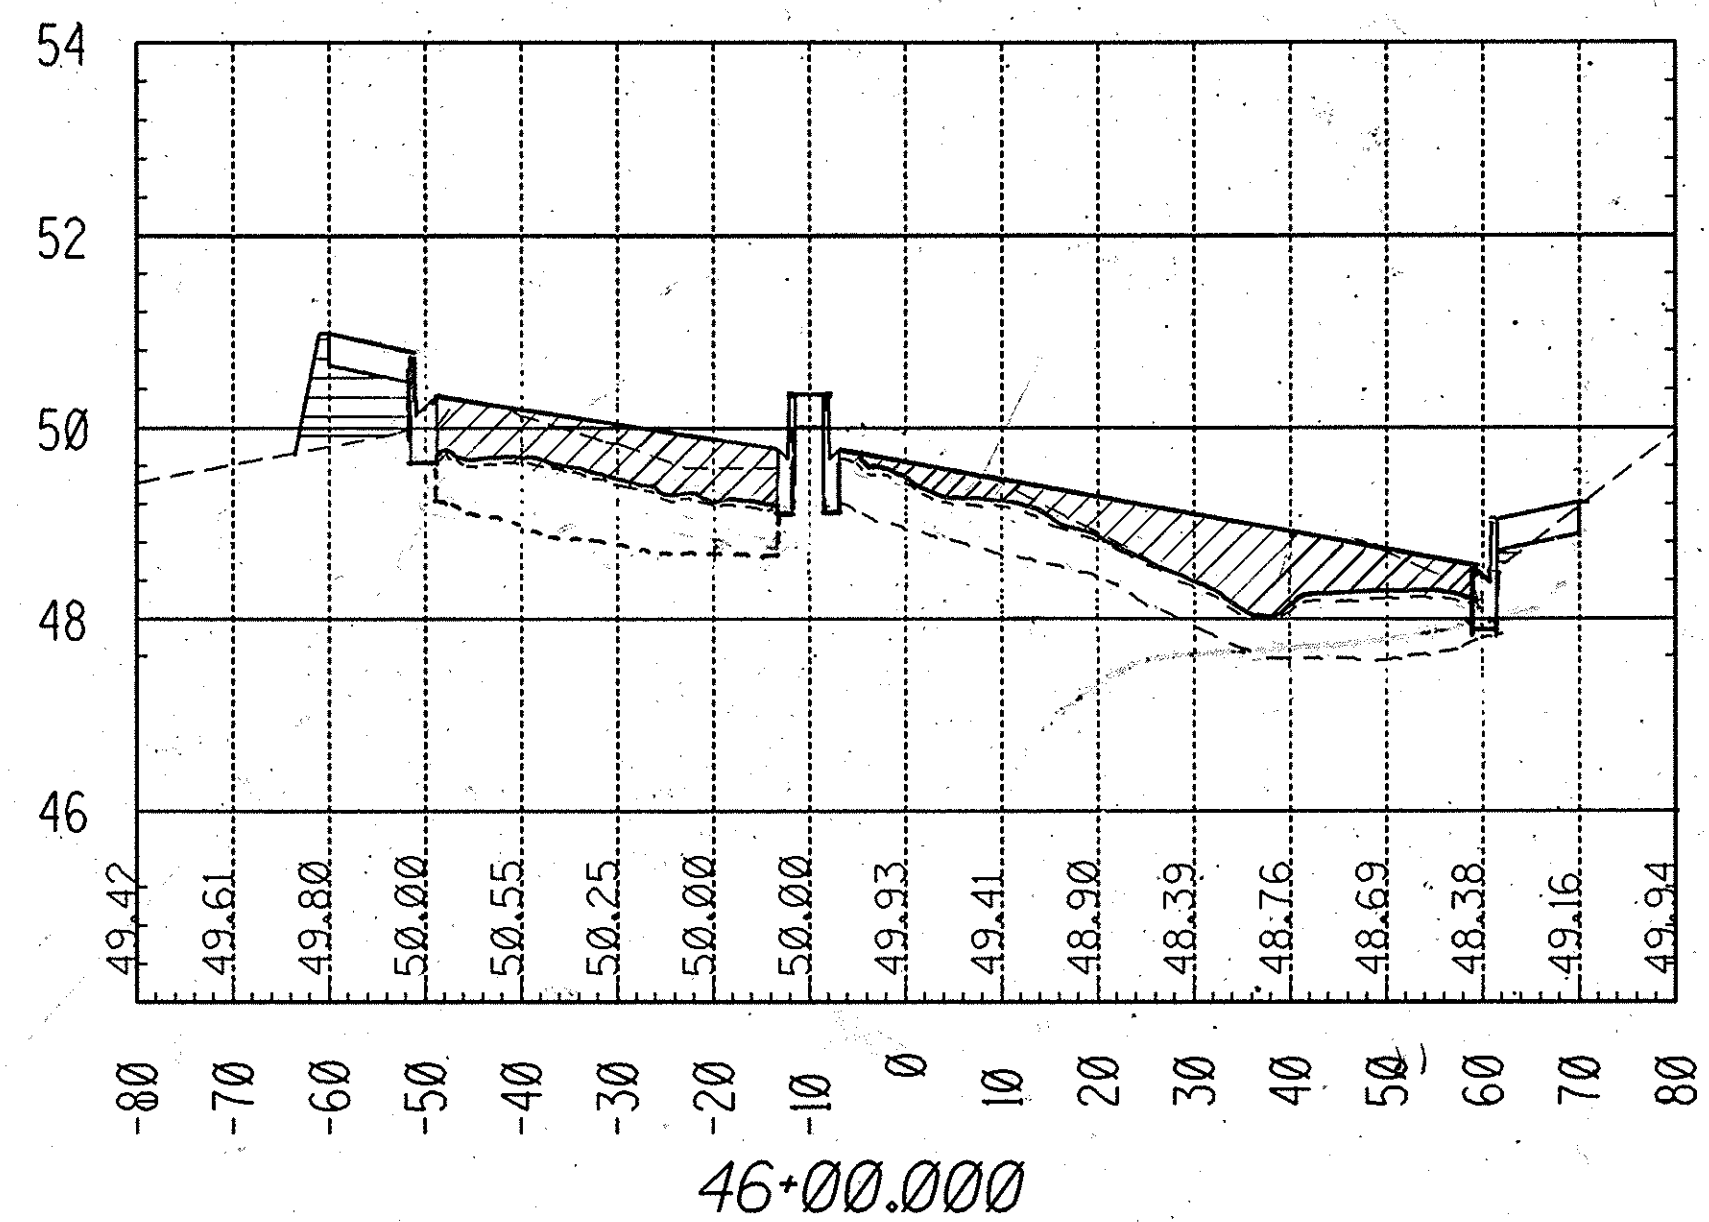
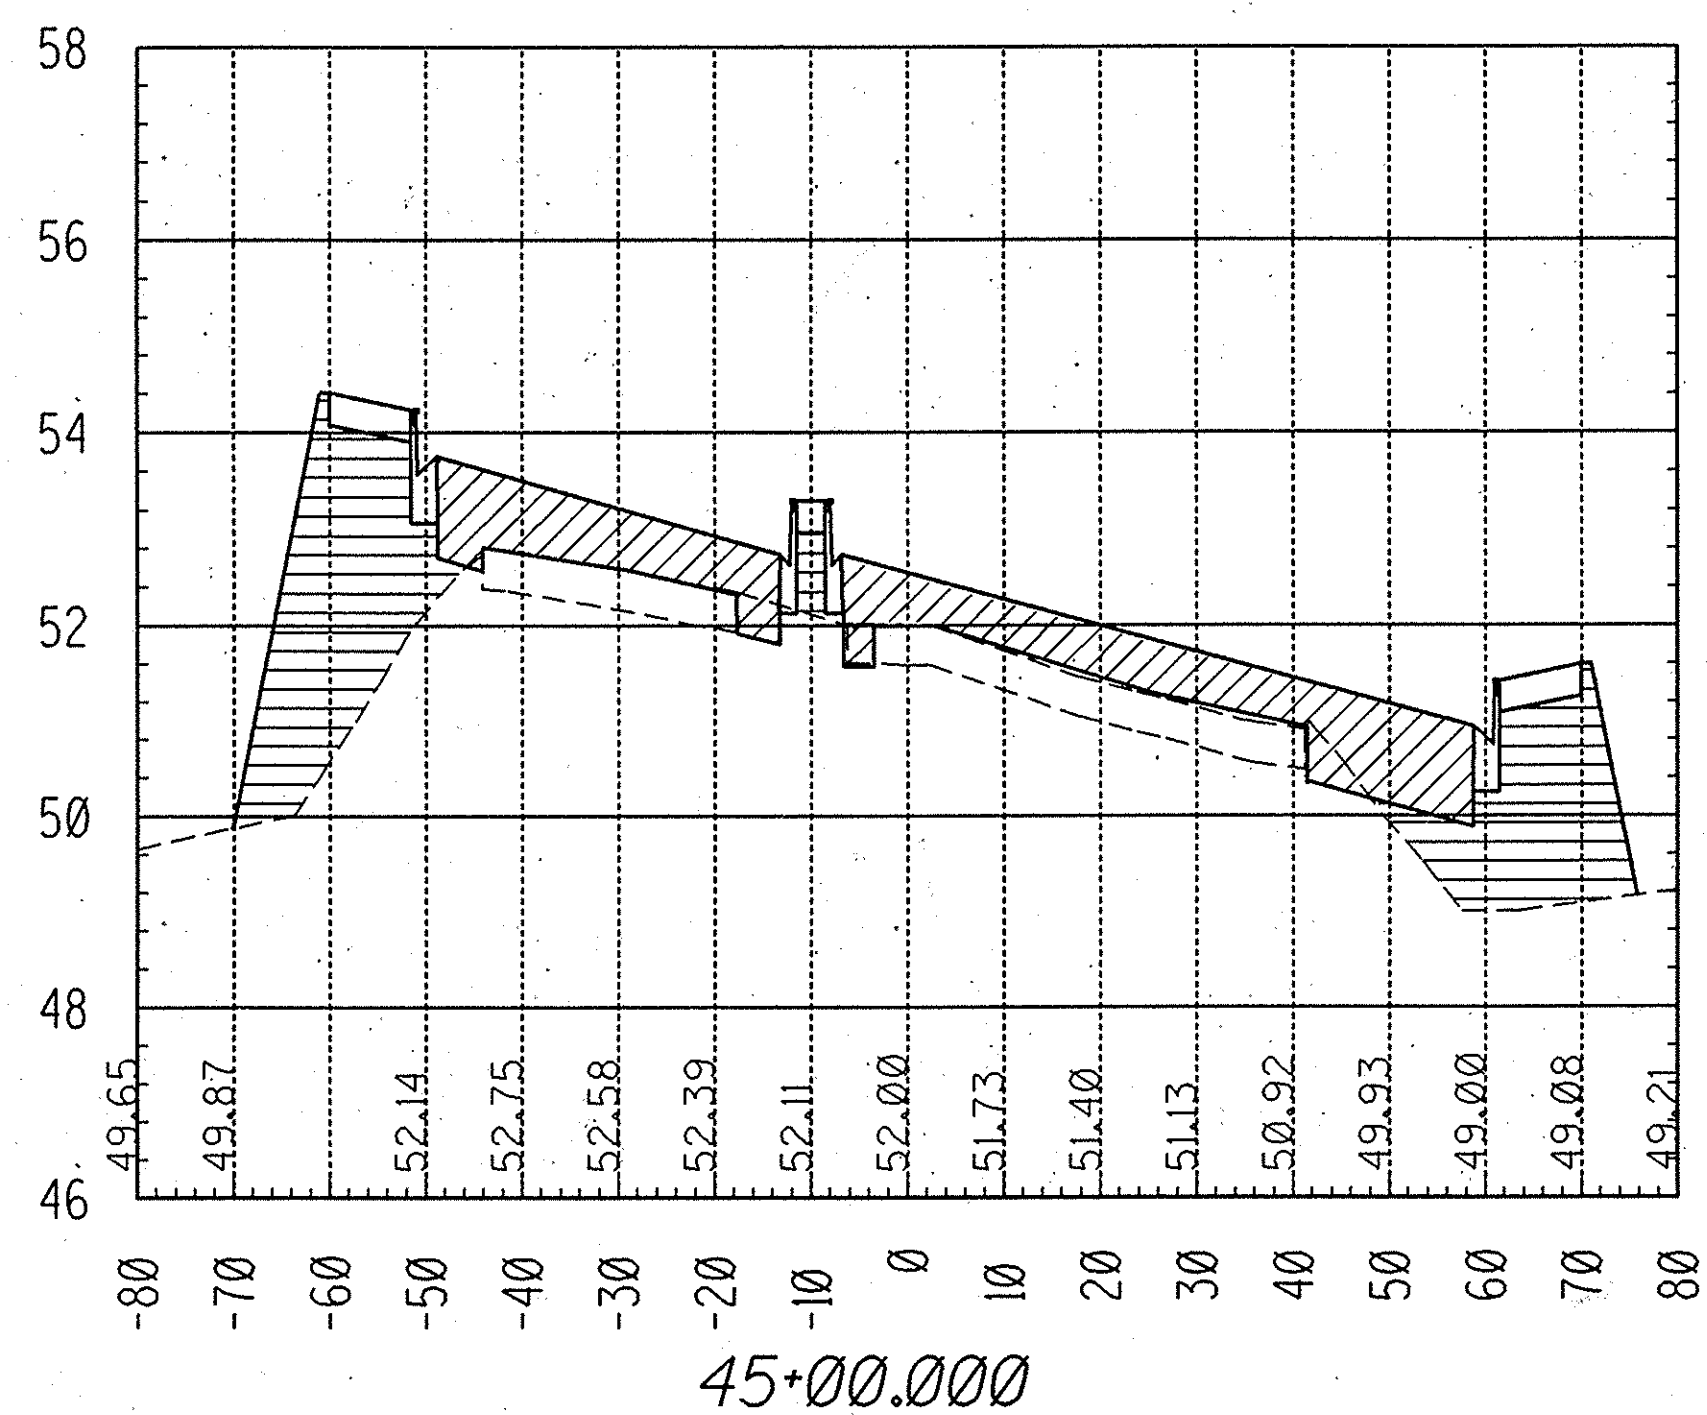
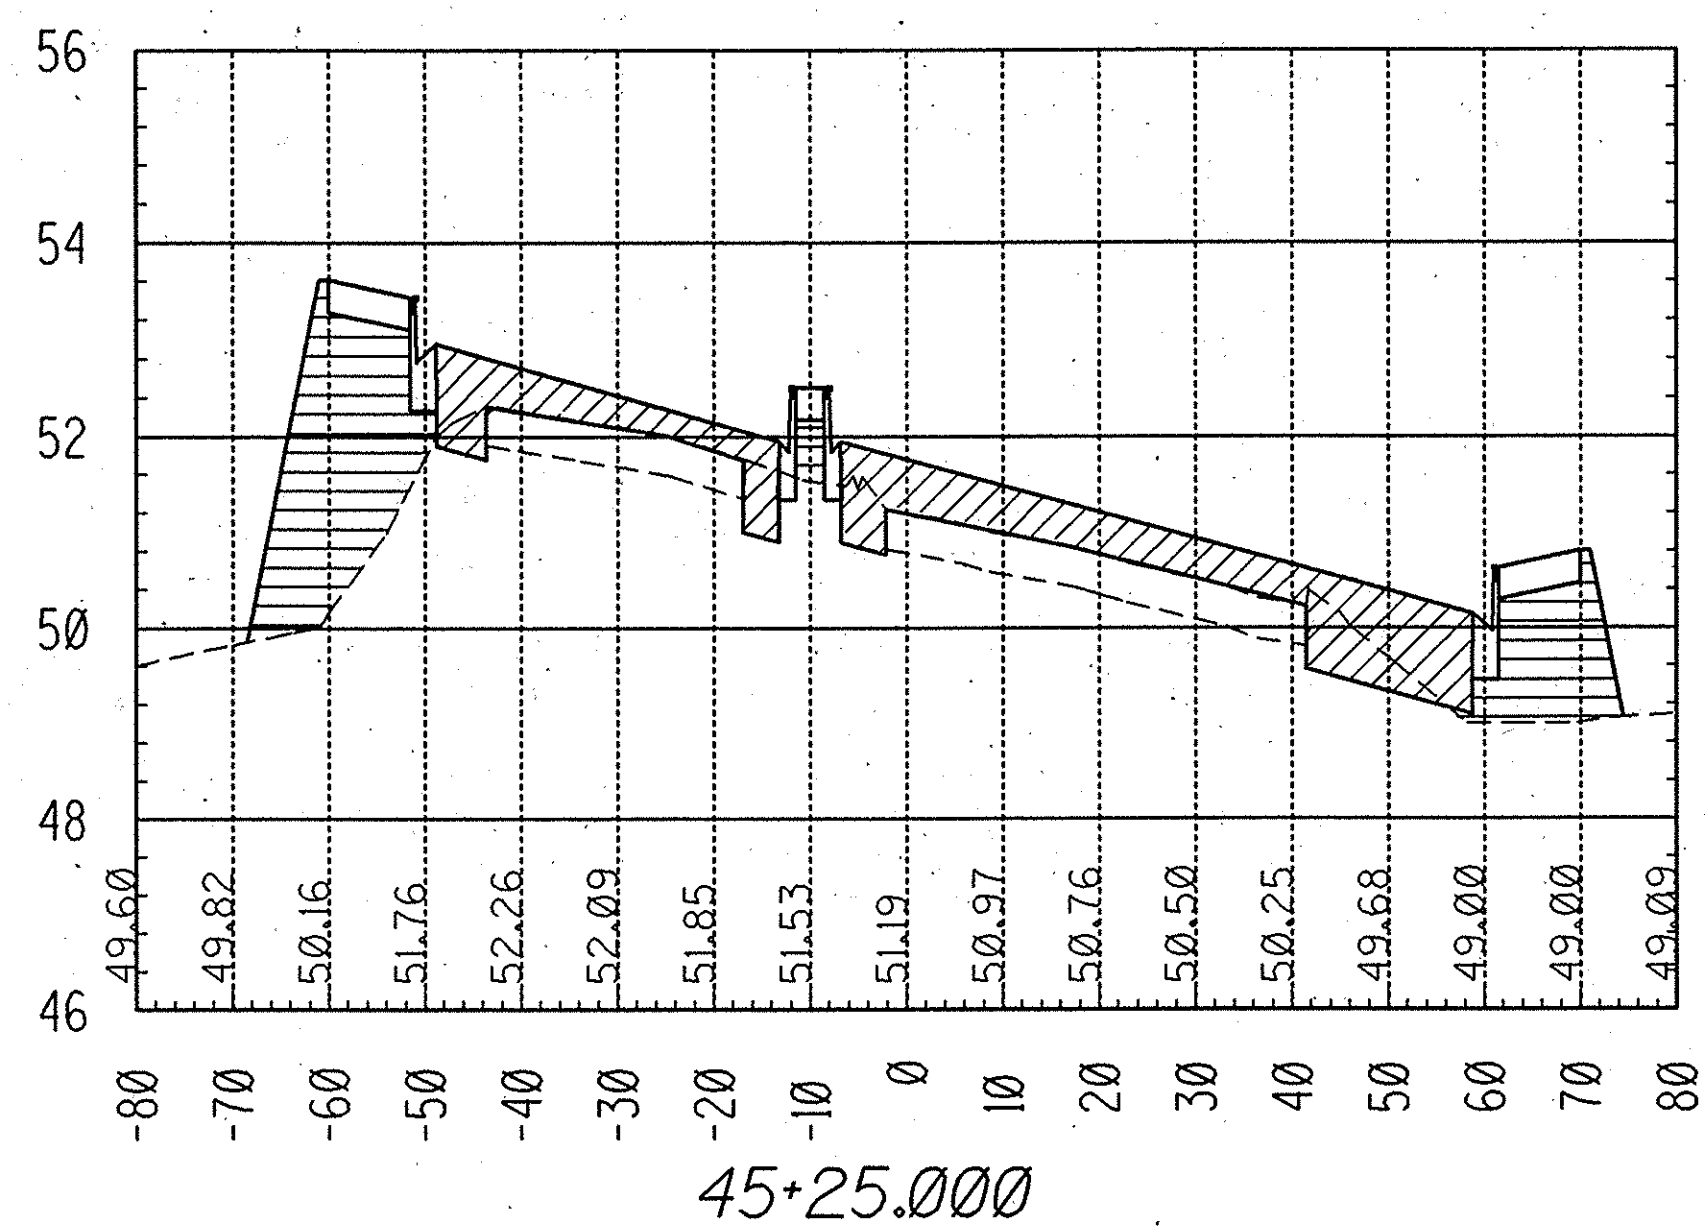


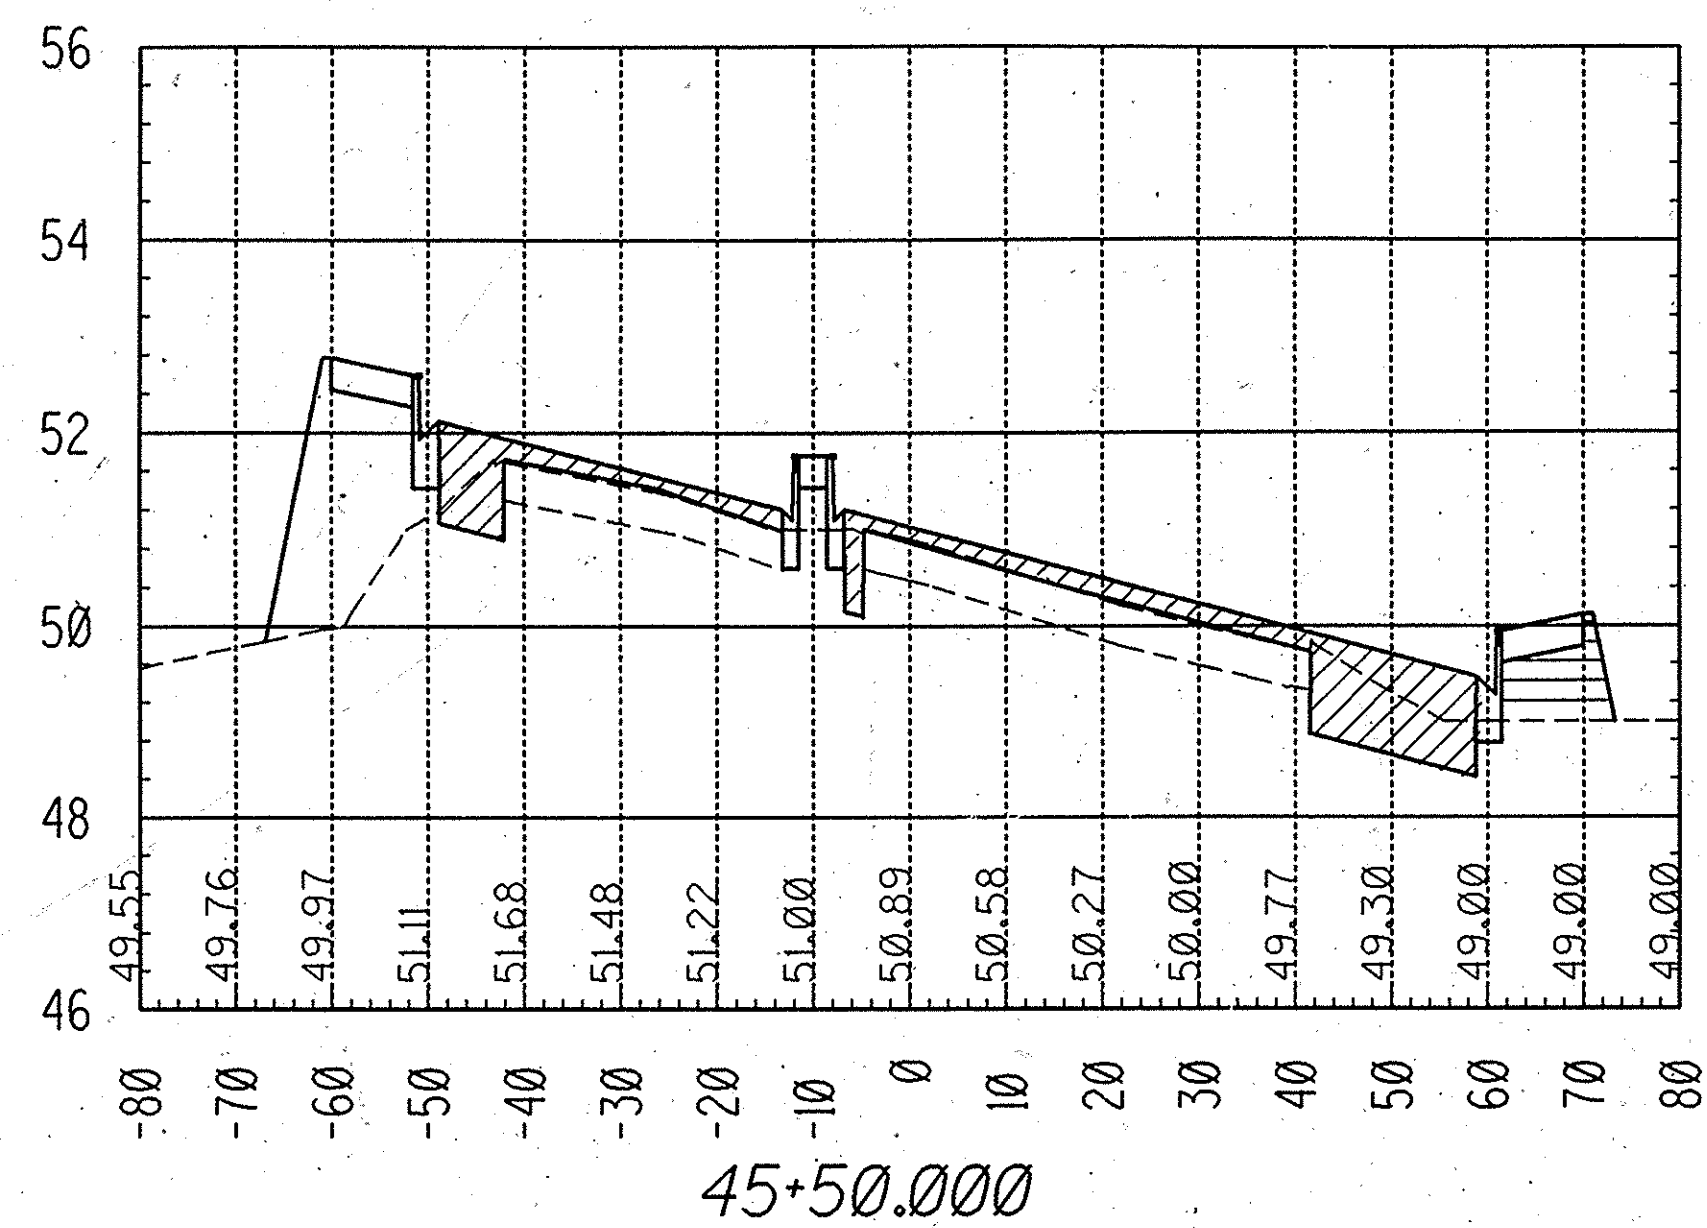

LEGEND

- AGGREGATE BASE MATERIAL
- ASPHALT CONCRETE
- UNCLASSIFIED FILL

RECORD DRAWING

1/2 0 1 2
3 inches on original drawing

ORANGE COUNTY ENVIRONMENTAL MANAGEMENT AGENCY	
HARBOR BLVD. IMPROVEMENTS	
CROSS SECTIONS 45+00 to 46+50	
DESIGNED: RRS	SHEET 60 OF 60
DRAWN: SG/	CHECKED: RAH
SCALE: AS SHOWN	DATE: 3-93
DRAWING NO.	