




CAMBER DIAGRAM DOES NOT INCLUDE ALLOWANCE FOR FALSEWORK SETTLEMENT; THE TOTAL DEFLECTION WILL BE REACHED ABOUT FOUR YEARS AFTER FALSEWORK REMOVAL, FOR VALUES AT TIME OF FALSEWORK REMOVAL, DIVIDE THOSE SUCH AS FOUR TIMES THE PERCENT OF CAMBER FOR CONSTRUCTION WILL BE DETERMINED BY THE ENGINEER.

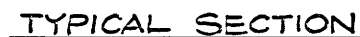


THIS SECTION IS APPLICABLE @ ABUTMENTS ONLY.

- 1.) ALL STATIONING IS ALONG E IRVINE BLVD.
- 2.) ALL ELEVATIONS ARE TOP OF CONC. SLAB.
- 3.) FOR SLAB DETAILS SEE SHEET NO 50 & 51


* DRAINAGE AREA WAS REDUCED DUE TO CHANNEL DIVERSION UPSTREAM

MARK	DATE	DESCRIPTION	PREPARED UNDER SUPERVISION OF	SHEET
		REVISIONS	<i>Barry A. Gaglio</i> R.C.E. 20767 2-25-83	46
DESIGNED	C.L.K.	SCALE	DATE	DWG. NO.
DRAWN	T.C.B. CHECKED J.B.	AS SHOWN		

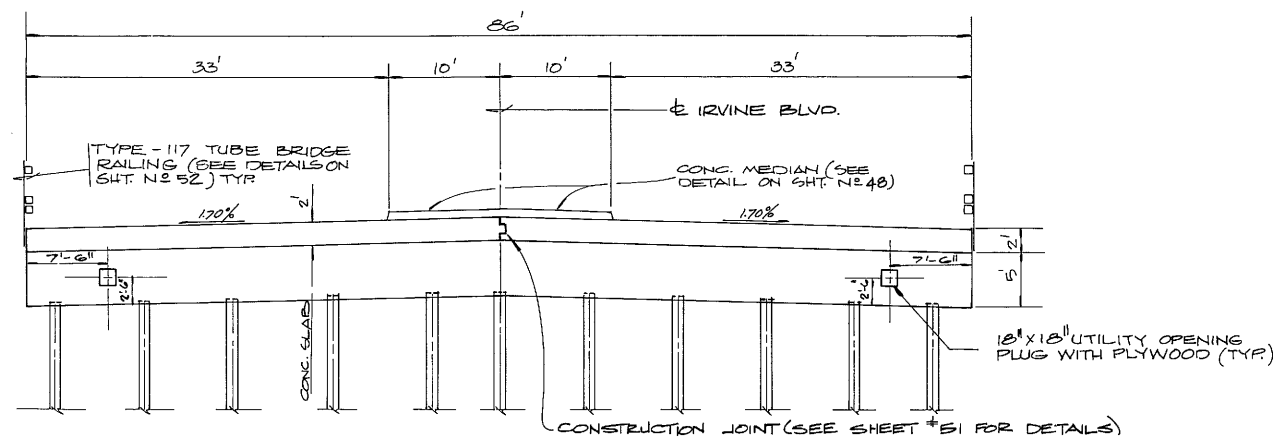

SECTION "B-B" OF ABUT. NO. 1 & NO. 2

SCALE: 1"=8'-0"

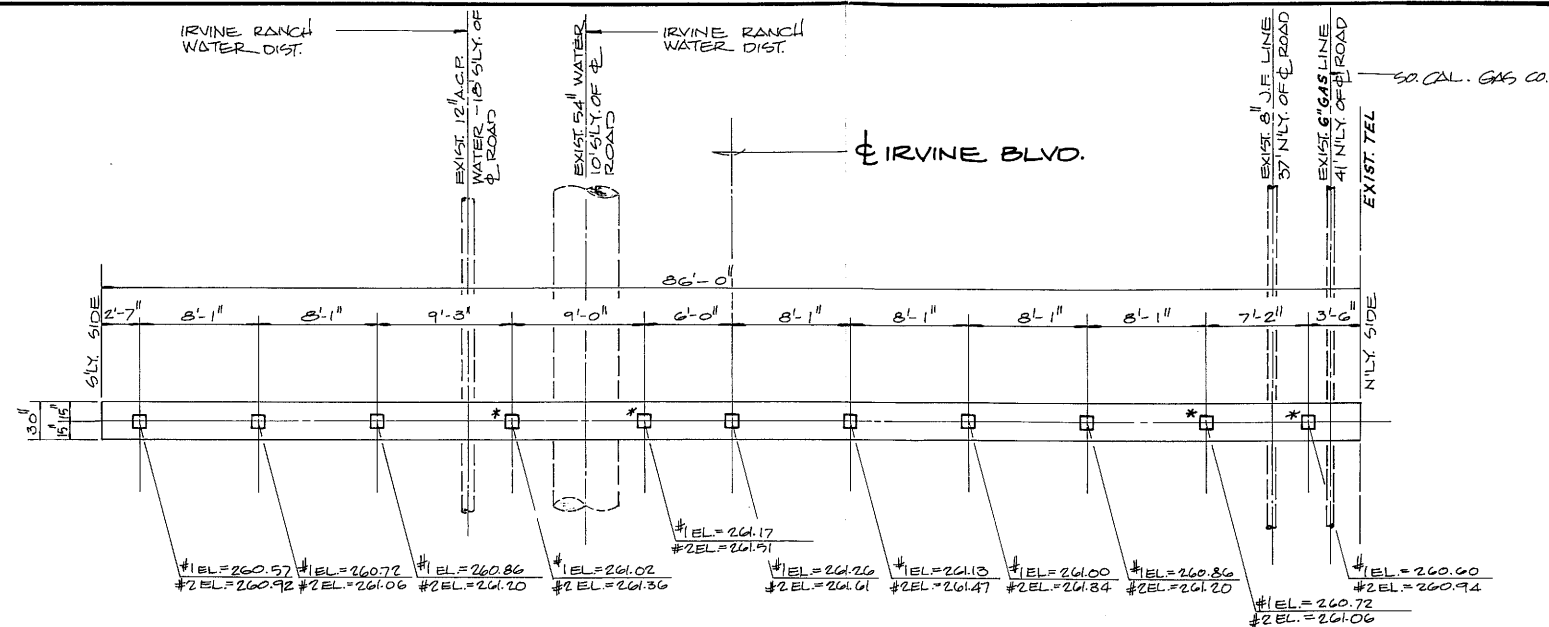

TYPICAL PILE LAYOUT @ ABUT. NO. 1


SCALE: 1"=6'-0"

(UTILITY ORIENTATION IS SHOWN FOR ABUTMENT NO. 1. ABUTMENT NO. 2 UTILITY ORIENTATION SIMILAR BUT OPPOSITE HAND)

SPECIFIED PILE TIP ELEV. = 211.0'
ESTIMATED PILE TIP ELEV. = 206.0'


*NOTE: PILING TO BE PREDRILLED TO 5' BELOW INVERT OF ADJACENT UTILITIES.

ALL HIGH HAZARD UTILITIES ARE TO BE LOCATED AND EXPOSED PRIOR TO START OF PILE DRIVING OR PREDRILLING.

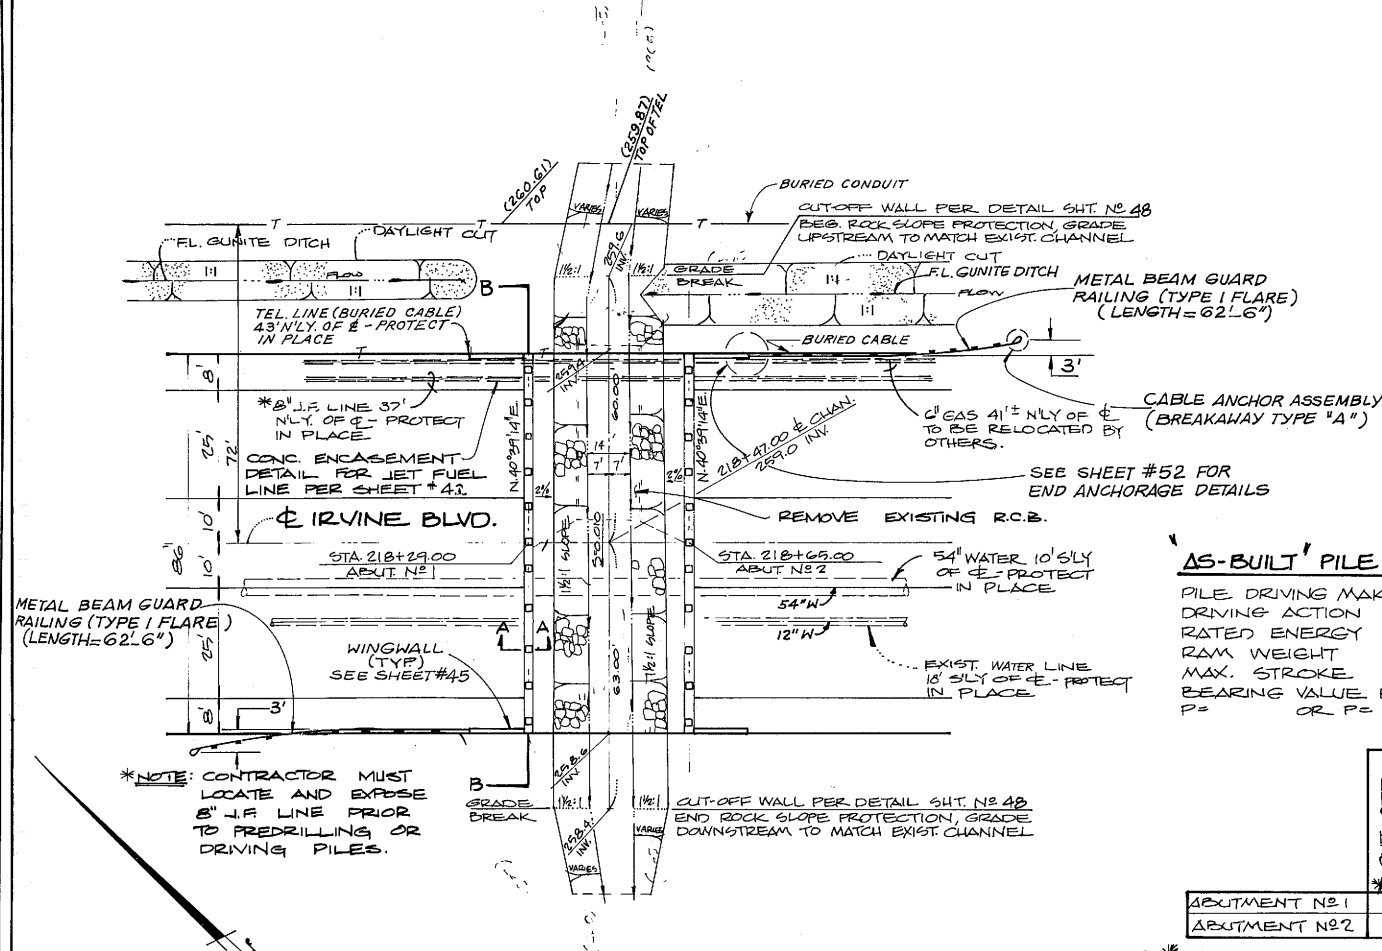

FOUNDATION PLAN

SCALE: 1"=20'

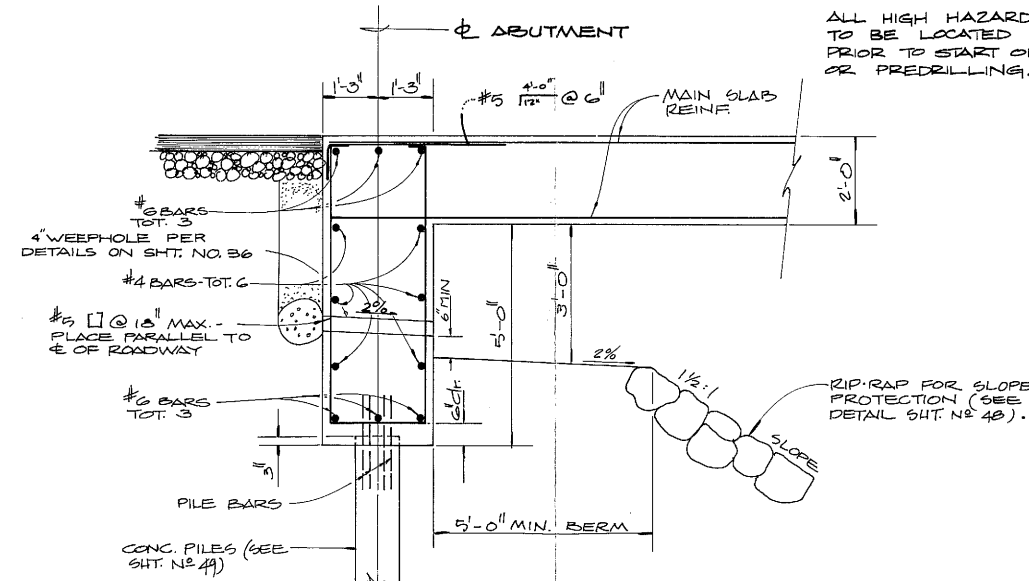

SECTION "A-A" SHOWING TYP. ABUT. DETAIL

SCALE: 1/2"=1'-0"

1 1/2 0 1 2
3 inches on original drawing

'AS-BUILT' PILE DRIVING DATA

PILE DRIVING MAKE & MODEL
DRIVING ACTION
RATED ENERGY
RAM WEIGHT
MAX. STROKE
BEARING VALUE FORMULA
P= OR P=

STD. SPEC. SEC. 49-1.08

	* CUT-OFF ELEV.	* MAX TIP ELEV.	* MIN. TIP LENGTH	* ANG. 'AS-BUILT' PILE TIP ELEV.	* ANG. STROKE HEIGHT	* ANG. BLOWS PER FOOT	* ANG. BEARING VALUE (TONS)
ABUTMENT NO. 1							
ABUTMENT NO. 2							

* NEW BRIDGE CONSTRUCTION

NOTE: TABLE & DATA ABOVE FOR USE OF RESIDENT ENG'R. UPON COMPLETION OF CONSTRUCTION.




CHECKED BY:

Shawn A. Sullivan
RCE 23831

MARK	DATE	DESCRIPTION
DESIGNED		REVISIONS
DRAWN		CHECKED



ORANGE COUNTY ENVIRONMENTAL MANAGEMENT AGENCY
IRVINE BLVD. BRIDGE OVER CENTRAL IRVINE CHANNEL
55C-450
ABUTMENT & FOUNDATION PLAN

PREPARED UNDER SUPERVISION OF *Shawn A. Sullivan*
RCE 20727
SCALE DATE DWG. NO.
AS SHOWN
SHEET 47

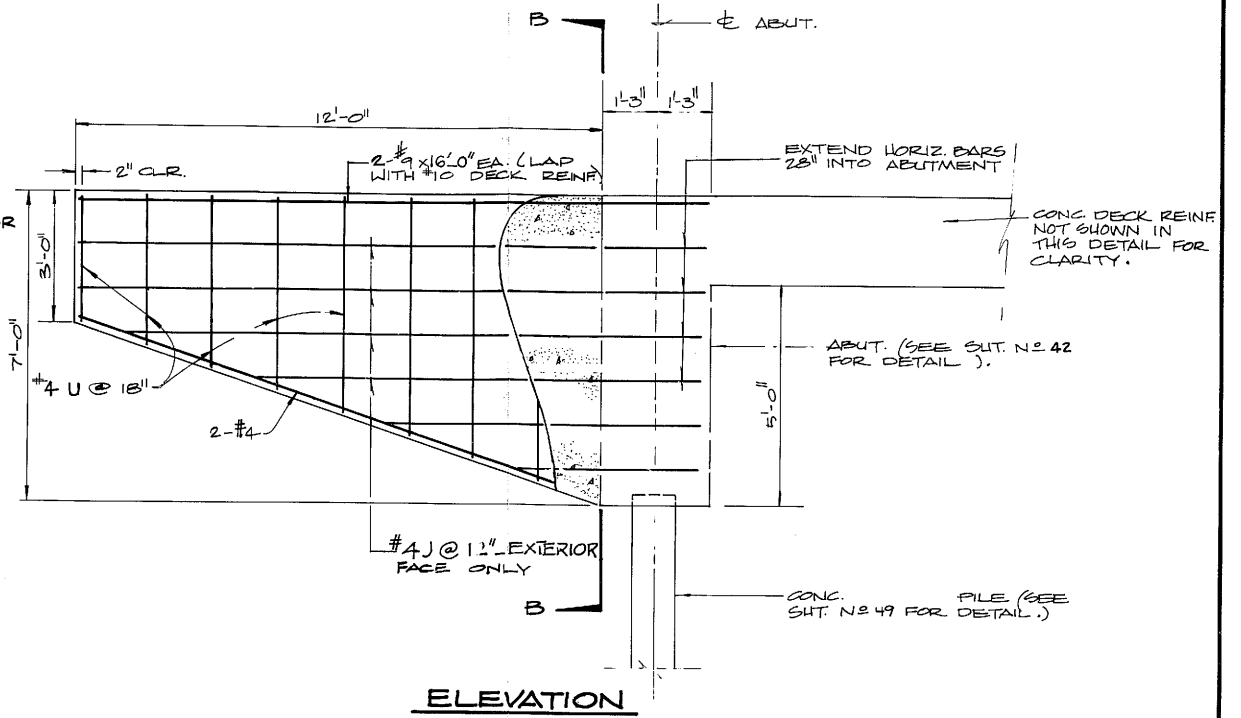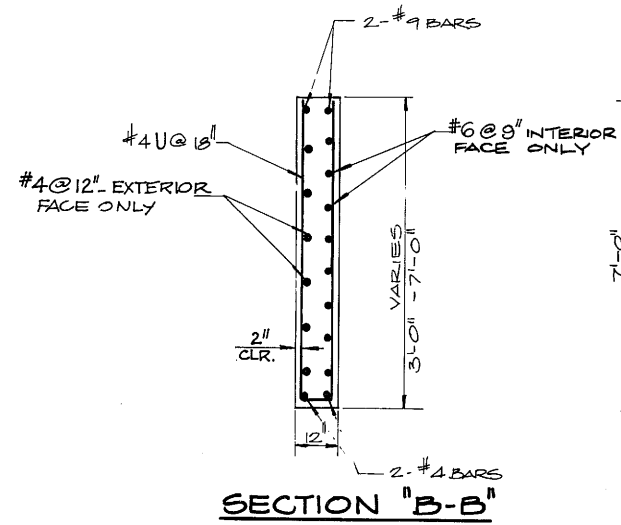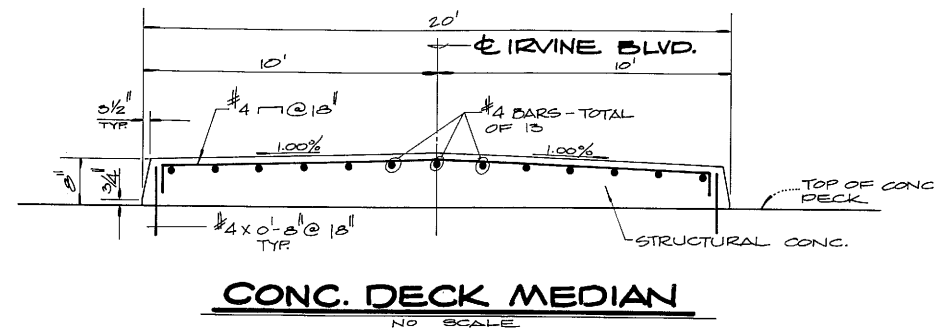


TYPICAL WINGWALL DETAIL
SCALE: 1/2" = 1'-0"


- NOTE:
- 1) BARRIER RAILING TYPE 117 NOT SHOWN IN THIS DETAIL. SEE SUT. N° 52
 - 2) FOR CORNER DETAIL SEE SUT. N° 51

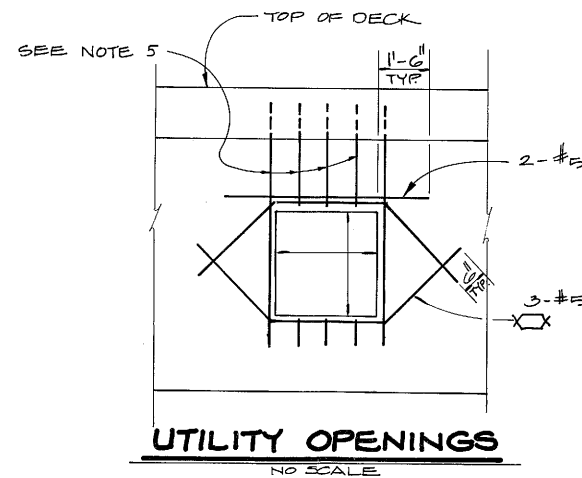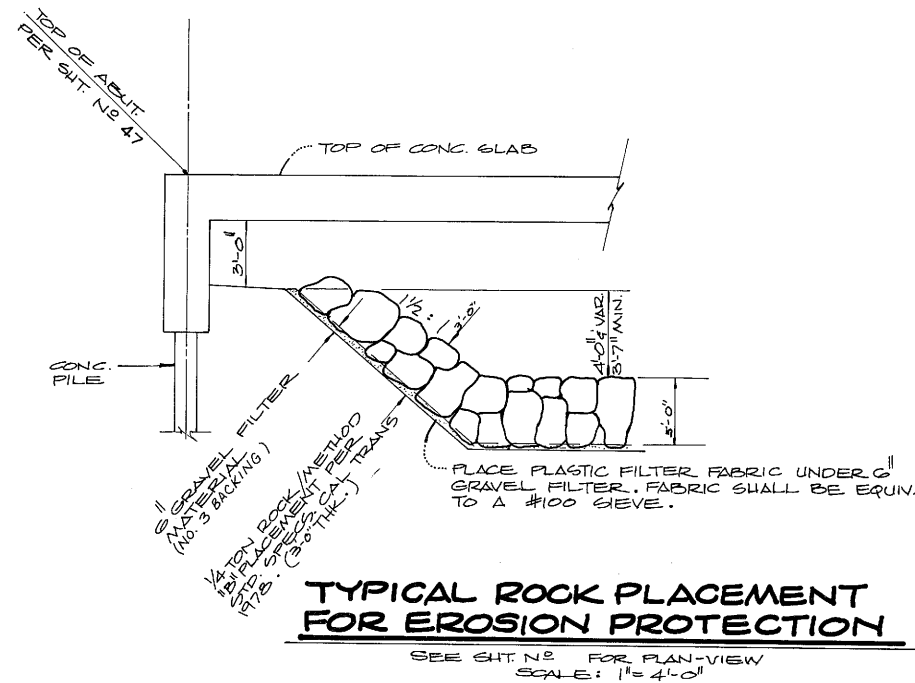

- NOTES:
1. THE EXACT LOCATION, ELEVATION, SIZE & DIRECTION OF OPENING SHALL BE IN ACCORDANCE WITH THE PROJECT PLANS & AS DIRECTED BY THE ENGINEER.
 2. ALL REINF. DETAIL TO BE PLACED IN ADDITION TO REINF. SHOWN ON PROJECT PLANS.
 3. SEAL UTILITIES AT ABUTMENTS W/CONC. OR MORTAR, AFTER TIGHTLY WRAPPING UTILITY W/2 LAYERS OF 15# BUILDING PAPER.
 4. MAIN REINF. TO CLEAR OPENING.
 5. REINF. TO BE SAME BAR SIZE, & 2/3 THE SPACING OF ADJACENT REINF. SHOWN ON PROJECT PLANS.

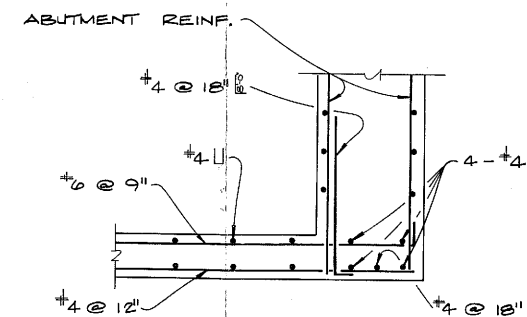

1 1/2 0 2
3 inches on original drawing

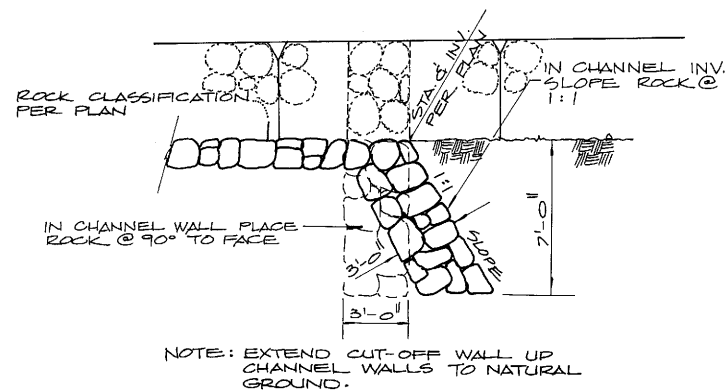

ROCK CUT-OFF WALL
SCALE: 1" = 4'-0"

CHECKED BY:


DESIGNED BY: *James William Little*
DATE: 6-1-83
RCE 23831

MARK	DATE	DESCRIPTION	PREPARED UNDER SUPERVISION OF	DATE	SHEET
		REVISIONS	Orange A. Gagliardi	2-8-83	48
		SCALE	DATE	DWG. NO.	
		AS SHOWN			


ORANGE COUNTY
ENVIRONMENTAL MANAGEMENT AGENCY
IRVINE BLVD. BRIDGE OVER
CENTRAL IRVINE CHANNEL
550-450
**MISC.
DETAILS**

**CONC.
PILE DETAILS**


MARK	DATE	DESCRIPTION	PREPARED UNDER SUPERVISION OF	DATE	SHEET
DESIGNED					49
DRAWN					
CHECKED					
SCALE	AS SHOWN	DATE	DWG. NO.		

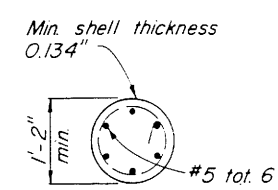


SECTION U-U
(Mandrel driven)

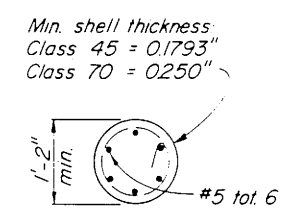


SECTION V-V

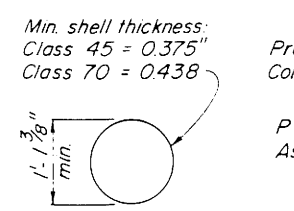


SECTION W-W

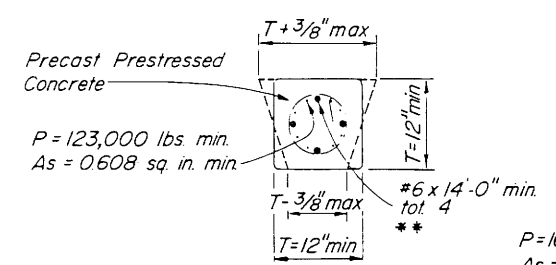


SECTION X-X

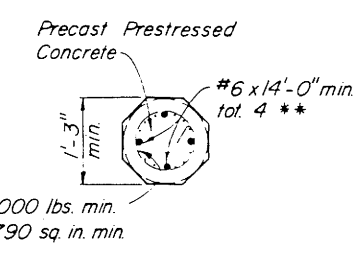

SECTION Y-Y

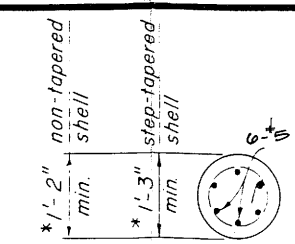


SECTION Z-Z

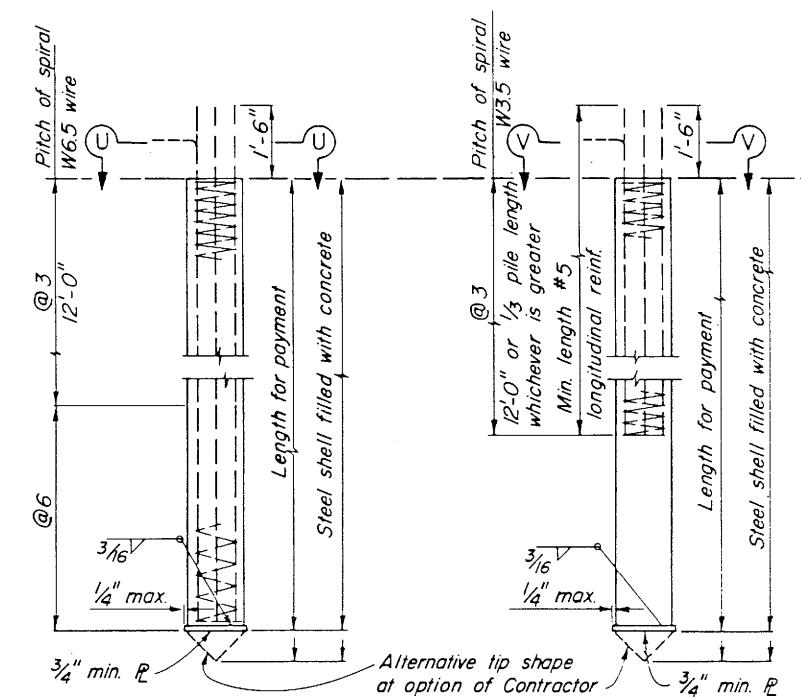


ALTERNATIVE "U"


ALTERNATIVE "V"

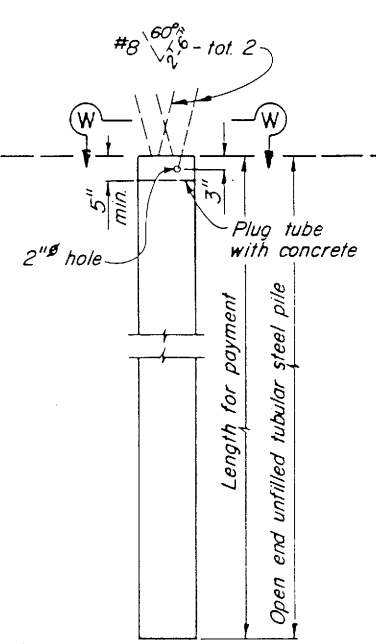


ALTERNATIVE "W"

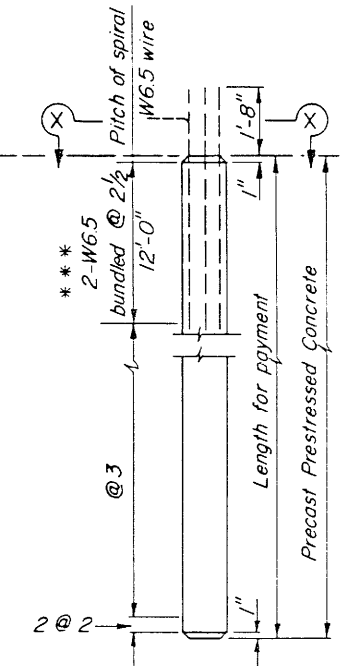


ALTERNATIVE "X"

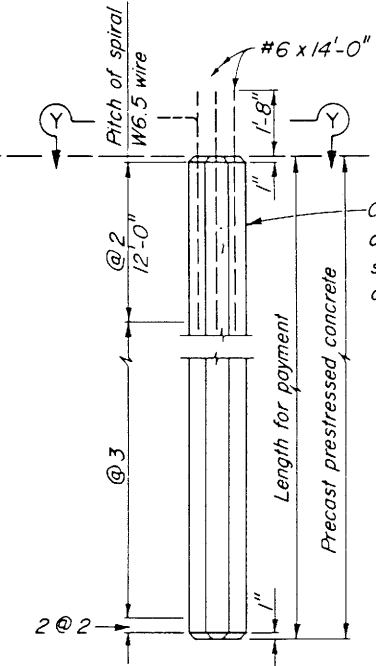

ALTERNATIVE "Y"

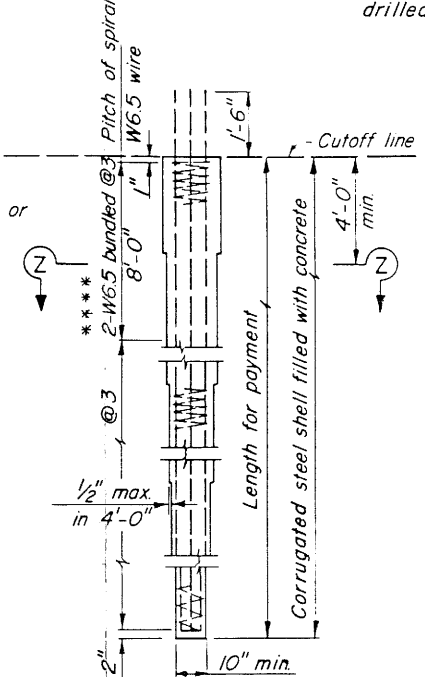


ALTERNATIVE "Z"

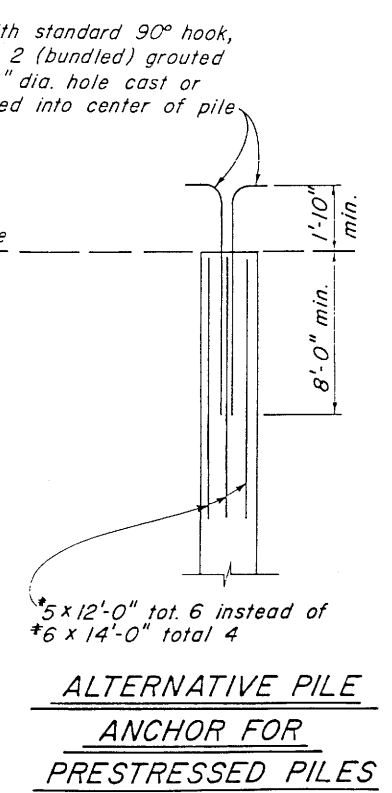

**ALTERNATIVE PILE
ANCHOR FOR
PRESTRESSED PILES**


Notes:
Details are the same for both Class 45 and Class 70 piles unless noted otherwise.
A 10" minimum diameter pipe extension (thickness = 0.1798" min. for Class 45 and 0.250" min. for Class 70) may be used at the tip of Alternative "Z" when taper is 30' or more in length.
Pile reinforcement extending into a footing shall be hooked as required to provide clearance to top of footing. Piles shall be extended only in accordance with details shown elsewhere in these plans.
Lapped splices in spiral pile reinforcement shall be lapped 80 wire diameters minimum. Spiral pile reinforcement at splices and at ends shall be terminated by a 135° hook with 6" tail hooked around a longitudinal bar or strand.
2" clearance to spiral reinforcement shall be maintained if section used is larger than the minimum section shown.

PRECAST PRESTRESSED PILES:
P = Prestressing Force If section used is larger than the min. section shown, then "P" shall provide 860 psi min.
@ anchorage
As = Minimum area of prestressing steel required.
Concrete Strength: f'c @ 28 days = 6,000 psi (Alternative "X")
5,000 psi (Alternative "Y")
f'ci @ transfer = 4,000 psi
DESIGN LOADING
Class 45 = 45 tons
Class 70 = 70 tons
NOTE: This sheet supersedes Sheet No. B2-1, page 86 and Sheet No. B2-5, page 88 of the Standard Plans dated January, 1981
Supersedes Sheet RSP B2-5 dated April, 1982

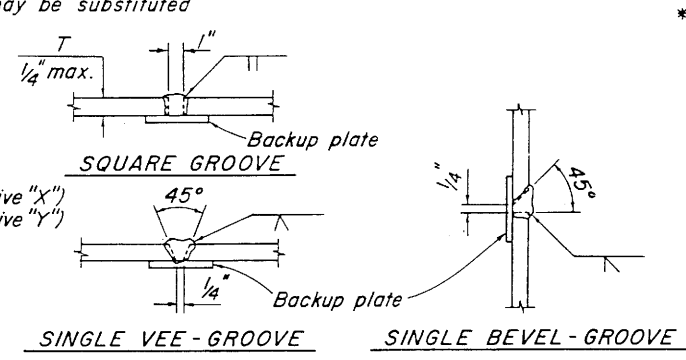


PILE WELDING DETAIL - BUTT JOINTS


Notes:
1. Single Vee-Groove and Square Groove permitted for all positions.
2. Single Bevel-Groove permitted for horizontal joints only.

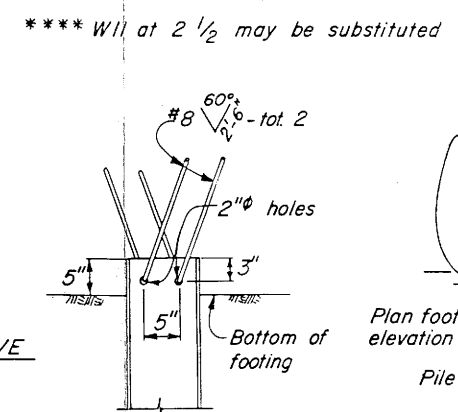

STEEL PILE ANCHOR
Steel piles, except for "Alternative W" to be used only when shown on plans or permitted by the Special Provisions.

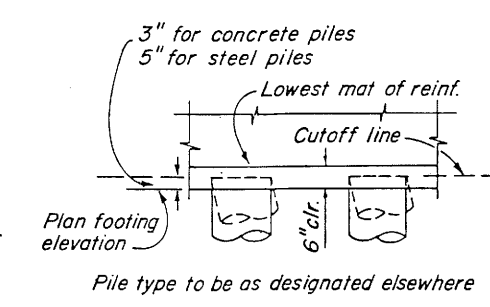

PILE EMBEDMENT
Pile type to be as designated elsewhere

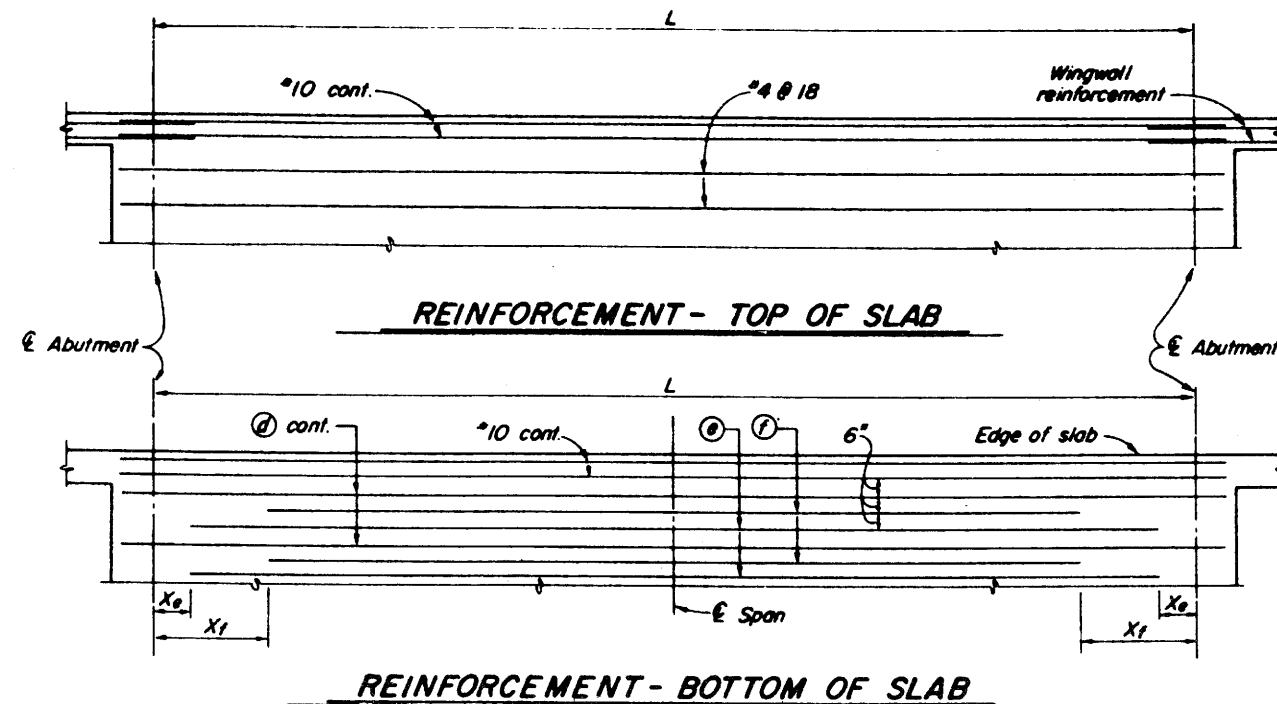


L = Length of Span			16'	18'	20'	22'	24'	26'	28'	30'	32'	34'	36'	38'	40'	42'	44'		
REINF.	Bottom of Slab	Ⓢ	Size	#8	#8	#9	#9	#9	#9	#10	#10	#10	#10	#10	#11	#11	#11	#11	
		Length	Continuous																
		Ⓢ	Size	#8	#8	#8	#8	#9	#9	#9	#9	#10	#10	#10	#10	#11	#11	#11	#11
		Length	15'-0"	17'-0"	18'-0"	20'-0"	22'-0"	24'-0"	26'-0"	28'-0"	30'-0"	31'-0"	34'-0"	36'-0"	37'-0"	40'-0"			
		X _c	0'-6"	0'-6"	1'-0"	1'-0"	1'-0"	1'-0"	2'-0"	2'-0"	2'-0"	2'-0"	2'-6"	2'-0"	2'-0"	2'-6"	2'-0"		
		Ⓢ	Size	#7	#7	#8	#8	#8	#9	#8	#9	#8	#9	#10	#10	#10	#11	#11	
		Length	11'-0"	12'-0"	12'-0"	14'-0"	15'-0"	17'-0"	17'-0"	19'-0"	19'-0"	22'-0"	22'-0"	25'-0"	25'-0"	27'-0"	29'-0"		
		X ₁	2'-6"	3'-0"	4'-0"	4'-0"	4'-6"	4'-6"	5'-6"	5'-6"	6'-6"	6'-0"	7'-0"	6'-6"	7'-6"	7'-6"	7'-6"		
		T = Thickness of slab Ⓢ			13"	14"	15"	16"	18"	19"	20"	21"	22"	23"	24"	25"	26"	28"	31"
		Approx. Quantities per ft. of width			Conc. ft. ³	18.3	22.1	26.3	30.6	37.5	42.8	48.6	54.4	60.5	67.4	74.3	81.5	89.3	100.6
			Steel lbs.	110	120	145	165	185	210	230	260	280	315	340	390	450	475	505	
Deflection at Midspan Δ			01'	02'	03'	03'	04'	04'	05'	06'	07'	09'	10'	11'	13'	13'	13'		

④ Add 1/2" for "Marine Environment" & adjust concrete quantity.

SLAB DETAILS - SINGLE SPAN

CENTRAL IRVINE CHANNEL BRIDGE, L = 36'

LIVE LOADING: HS 20-44 & ALT.

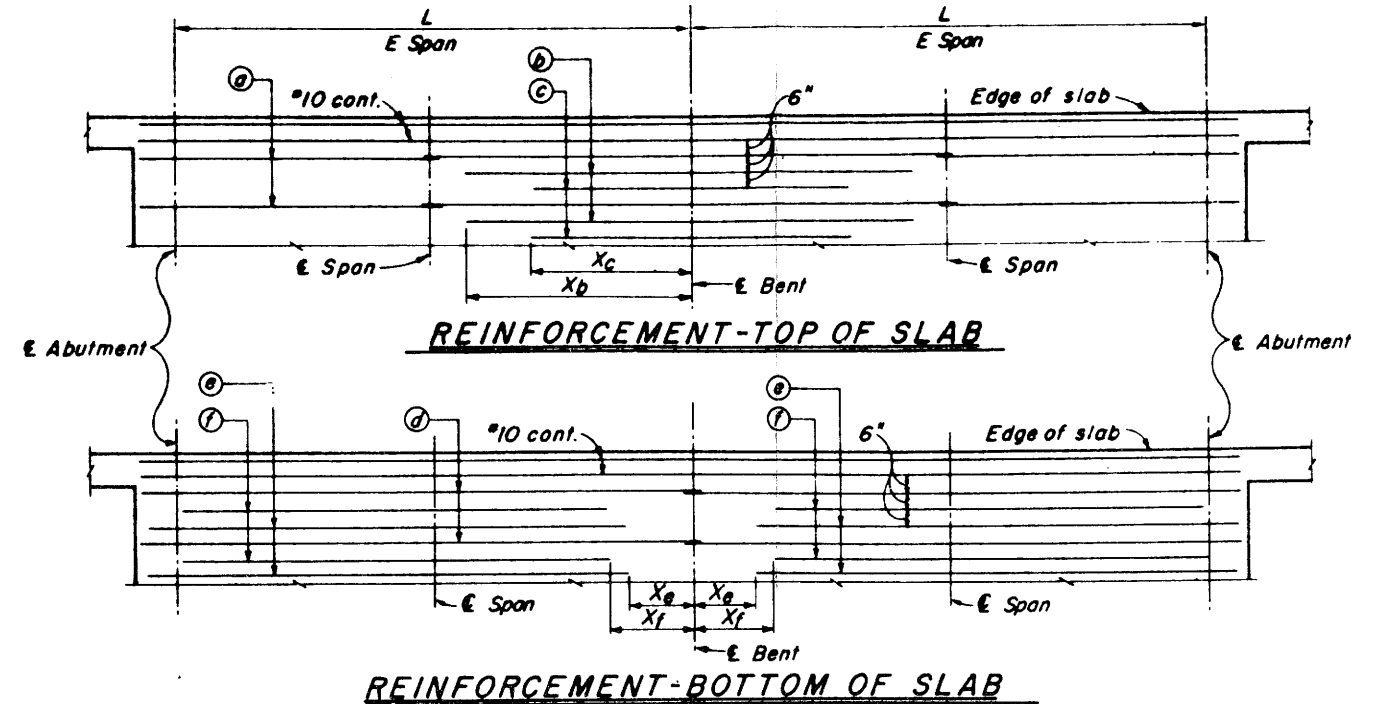

L = Length of Span		16'	18'	20'	22'	24'	26'	28'	30'	32'	34'	36'	38'	40'	42'	44'		
REINFORCEMENT	Top of Slab	Ⓐ bars	Size	#7	#8	#9	#9	#10	#10	#10	#10	#11	#11	#11	#11	#10	#10	#11
		Ⓐ bars	Length	34'-0"	38'-0"	42'-0"	46'-0"	50'-0"	54'-0"	58'-0"	68'-0"	73'-0"	77'-0"	81'-0"	85'-0"	89'-0"	92'-0"	97'-0"
		Ⓐ bars	Size	#7	#7	#8	#7	#8	#8	#8	#8	#8	#9	#7	#8	#11	#11	#11
		Ⓐ bars	Length	12'-0"	11'-0"	12'-0"	11'-0"	12'-0"	13'-0"	13'-0"	13'-0"	13'-0"	13'-0"	15'-0"	16'-0"	21'-0"	22'-0"	21'-0"
		Ⓐ bars	X _b	6'-0"	5'-6"	6'-0"	5'-6"	6'-0"	6'-6"	6'-6"	6'-6"	6'-6"	6'-6"	7'-6"	8'-0"	10'-6"	11'-0"	10'-6"
		Ⓐ bars	Size	#6	#6	#7	#7	#8	#9	#9	#9	#9	#8	#8	#11	#11	#11	#11
	Bottom of Slab	Ⓒ bars	Length	5'-0"	5'-0"	5'-0"	5'-0"	6'-0"	6'-0"	6'-0"	6'-0"	6'-0"	6'-0"	13'-0"	13'-0"	12'-0"	12'-0"	12'-0"
		Ⓒ bars	X _c	2'-6"	2'-6"	2'-6"	2'-6"	3'-0"	3'-0"	3'-0"	3'-0"	3'-0"	3'-0"	6'-6"	6'-6"	6'-0"	6'-0"	6'-0"
		Ⓓ bars	Size	#7	#8	#9	#9	#10	#10	#10	#10	#11	#11	#11	#11	#11	#11	#11
		Ⓓ bars	Length	34'-0"	38'-0"	42'-0"	46'-0"	50'-0"	54'-0"	58'-0"	68'-0"	73'-0"	77'-0"	81'-0"	85'-0"	89'-0"	93'-0"	97'-0"
		Ⓓ bars	Size	#8	#7	#8	#8	#8	#9	#9	#9	#9	#8	#8	#9	#9	#9	#9
		Ⓓ bars	Length	15'-0"	14'-0"	15'-0"	16'-0"	17'-0"	19'-0"	20'-0"	21'-0"	21'-0"	21'-0"	21'-0"	24'-0"	24'-0"	25'-0"	30'-0"
Ⓔ bars		X _e	1'-0"	4'-0"	4'-6"	5'-0"	6'-0"	6'-0"	7'-0"	7'-6"	8'-0"	10'-0"	9'-6"	11'-0"	11'-6"	12'-0"	13'-0"	
Ⓔ bars		Size	#7	#7	#7	#7	#8	#8	#8	#8	#8	#7	#7	#7	#8	#8	#9	#9
Ⓔ bars		Length	10'-0"	11'-0"	10'-0"	12'-0"	13'-0"	14'-0"	15'-0"	16'-0"	15'-0"	16'-0"	16'-0"	18'-0"	19'-0"	22'-0"	23'-0"	
Ⓔ bars		X _f	4'-6"	5'-6"	7'-0"	7'-0"	8'-0"	8'-6"	9'-6"	10'-0"	11'-6"	12'-6"	13'-6"	14'-0"	14'-6"	14'-0"	15'-0"	
T = Thickness of Slab Ⓒ		10 1/2"	11"	11 1/2"	12 1/2"	13 1/2"	14"	15"	16"	17"	18"	18 1/2"	19"	20"	21"	22"		
Approx. Quantities per ft. of width	Conc. ft. ³	14.9	17.4	20.2	24.0	28.1	31.5	36.2	41.3	46.7	52.5	57.0	61.7	68.3	75.3	82.5		
	Steel lbs.	140	160	200	225	275	310	335	340	400	430	470	520	525	570	620		
Deflection at Midspan Δ		00'	02'	02'	03'	04'	04'	05'	05'	06'	06'	07'	08'	09'	10'	10'		

* Length includes allowance for one splice.

④ Add 1/2" for "Marine Environment" & adjust concrete quantity.

SLAB DETAILS - 2 SPANS

PETER'S CYN. BRIDGE, L = 40'
RATTLESNAKE CYN. BRIDGE, L = 34'

LIVE LOADING: HS 20-44 & ALT.

1 1/2 0 1 2
3 inches on original drawing


CHECKED BY:

DATE: 6-1-83
RCE 23831


MARK	DATE	DESCRIPTION	PREPARED UNDER SUPERVISION OF	DATE	SHEET
			George A. Gagliardi		50
REVISIONS					
DESIGNED	SCALE	DATE	DWG. NO.		
	AS SHOWN				

ORANGE COUNTY
ENVIRONMENTAL MANAGEMENT AGENCY
IRVINE BLVD. BRIDGES OVER
PETER'S CYN. WASH
RATTLESNAKE CYN. WASH
CENTRAL IRVINE CHANNEL


SLAB DETAILS

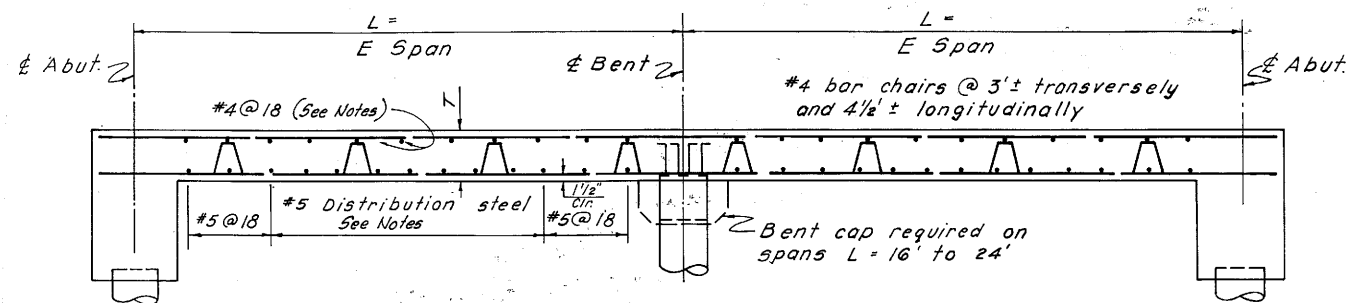


NOTES: Splices in top main bars to be 35 dia. and located near center of span.
 Splices in bottom main bars to be 20 dia. and located near bent.
 Spacing of #4 @ 18 is measured normal to bars.
 Spacing of #5 bars in bottom of slab is measured along roadway. For spacing in center half of span see table.
 Place all transverse bars parallel to bent.

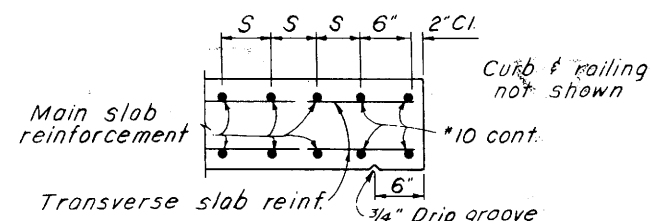


EDGE OF SLAB DETAIL

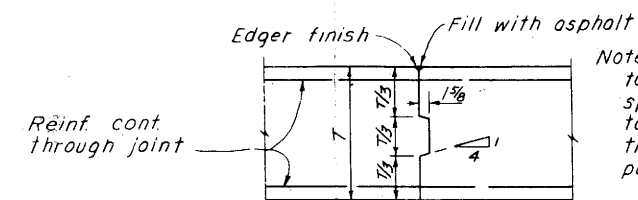

LONGITUDINAL OR TRANSVERSE SLAB CONSTRUCTION JOINT

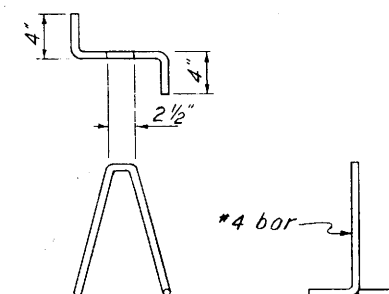

BAR CHAIR DETAIL

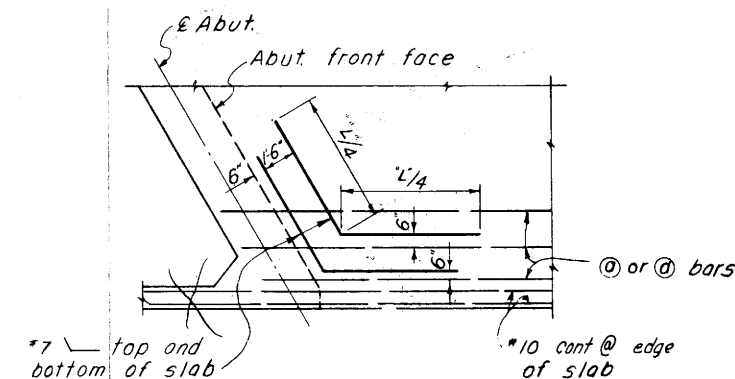

OBTUSE CORNER DETAIL

1 1/2 0 1 2
 3 inches on original drawing

CHECKED BY:

DESIGNED BY:
 RCE 23831








MARK DATE DESCRIPTION
 REVISIONS
 DESIGNED
 DRAWN

ORANGE COUNTY
 ENVIRONMENTAL MANAGEMENT AGENCY
 IRVINE BLVD. BRIDGES OVER
 PETERS CANYON WASH
 RATTLESNAKE CREEK
 CENTRAL IRVINE CHANNEL


SLAB DETAILS

PREPARED UNDER SUPERVISION OF:
 SCALE DATE DWG. NO.
 AS SHOWN

SHEET
 51

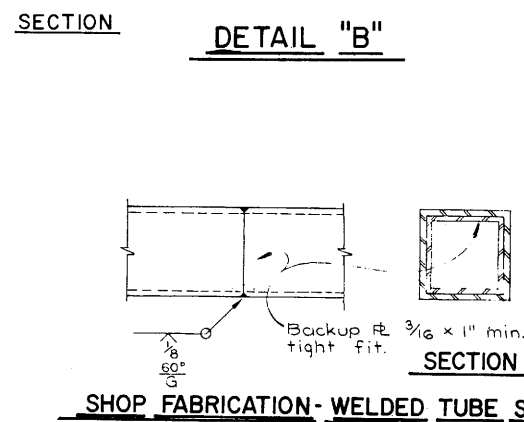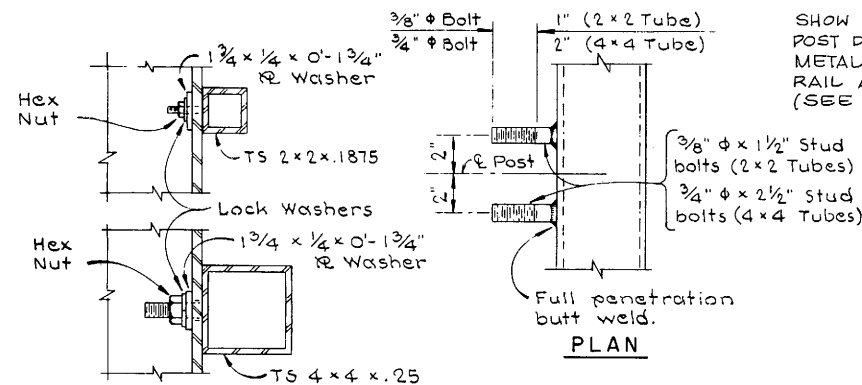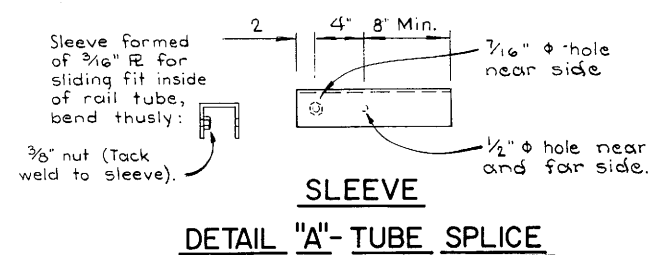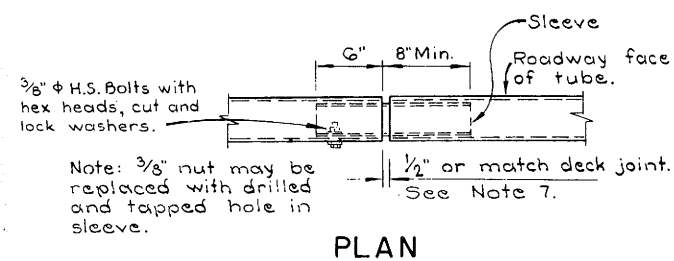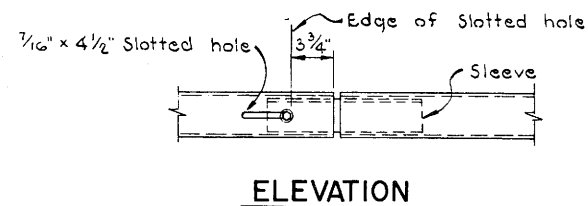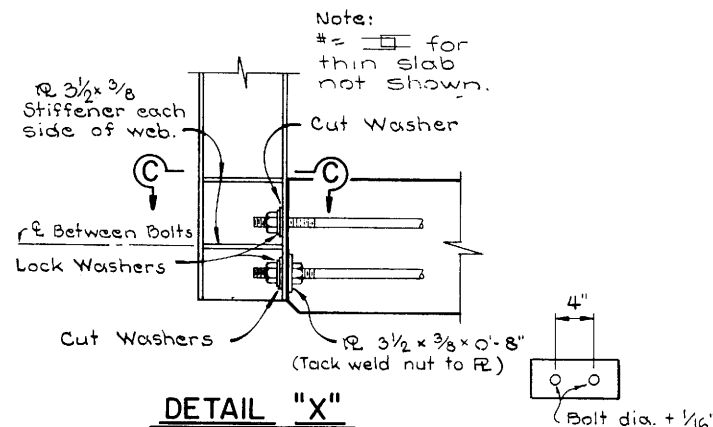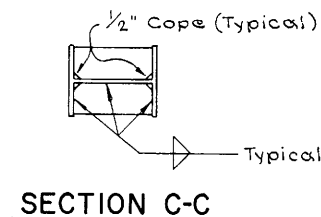


SHOP FABRICATION - WELDED TUBE SPLICE

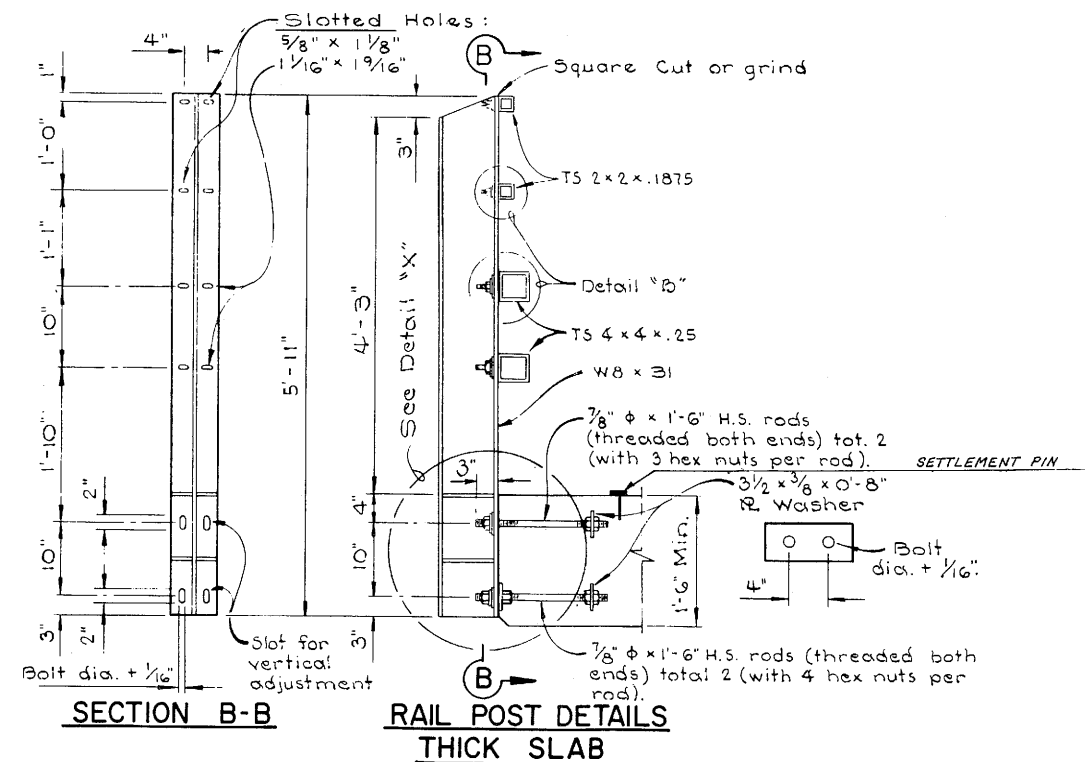



NOTES:

- Posts shall be vertical.
- Tubing shall be shop bent to fit horizontal curve when curve radius is less than 950'.
- Tubing shall be parallel to vertical alignment.
- Tubing shall be continuous over not less than 3 intermediate posts, with a minimum length of 3 panels except as noted.
- No more than one tube splice per panel is permitted, except as noted.
- Space posts to provide 1'-6" min clear between expansion joints and G of post.
- Rail joints in top and bottom tubes at deck expansion joints shall provide allowance for movement equal to width of deck joint with corresponding increase in length of sleeve.
- Railing on bridge wingwalls to be placed after walls are backfilled.
- 3/4" stud bolt nuts shall be torqued to 175 ft lbs, 3/8" stud bolt nuts shall be wrench tight.
- Anchor bolt nuts shall be wrench tight.
- Galvanize rail assembly after fabrication.
- Designed by AASHTO dated 1973 and Interim Specifications dated 1974, 1975 and 1976.
- Design height of rail is based on a future overlay of 3 inches maximum.

SHOW VERTICAL END POST DETAIL WHEN METAL BEAM GUARD RAIL APPROACH EXISTS (SEE DETAILS BELOW)

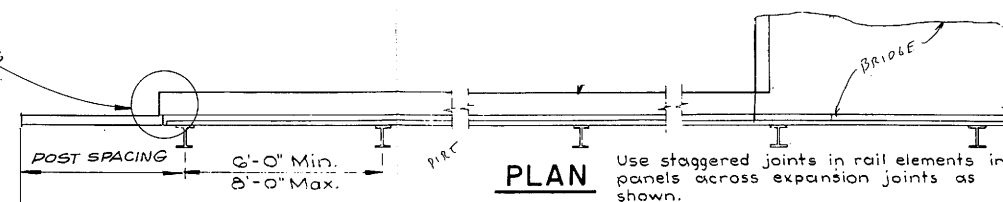


SHOW VERTICAL END POST DETAIL WHEN METAL BEAM GUARD RAIL APPROACH EXISTS (SEE DETAILS BELOW)

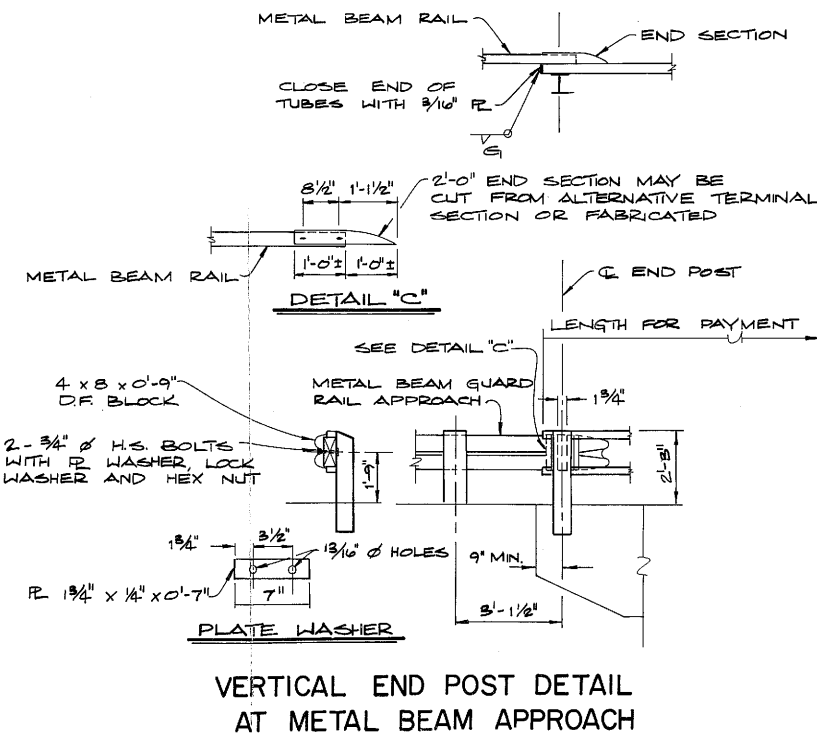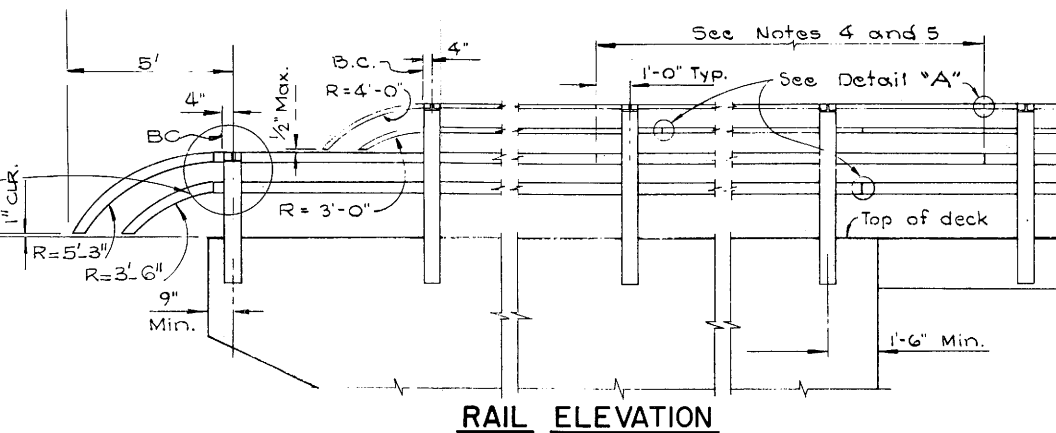


1 1/2 0 1 2
3 inches on original drawing


ORANGE COUNTY ENVIRONMENTAL MANAGEMENT AGENCY			
IRVINE BLVD BRIDGES OVER PETER'S CYN. WASH RATTLESNAKE CYN. WASH CENTRAL IRVINE CHANNEL			
BRIDGE RAILING DETAILS			
CHECKED BY:	DATE	DESCRIPTION	PREPARED UNDER SUPERVISION OF
REVISIONS	DATE	DESCRIPTION	DATE
DESIGNED	DATE	SCALE	DWG. NO.
DRAWN	CHECKED	AS SHOWN	

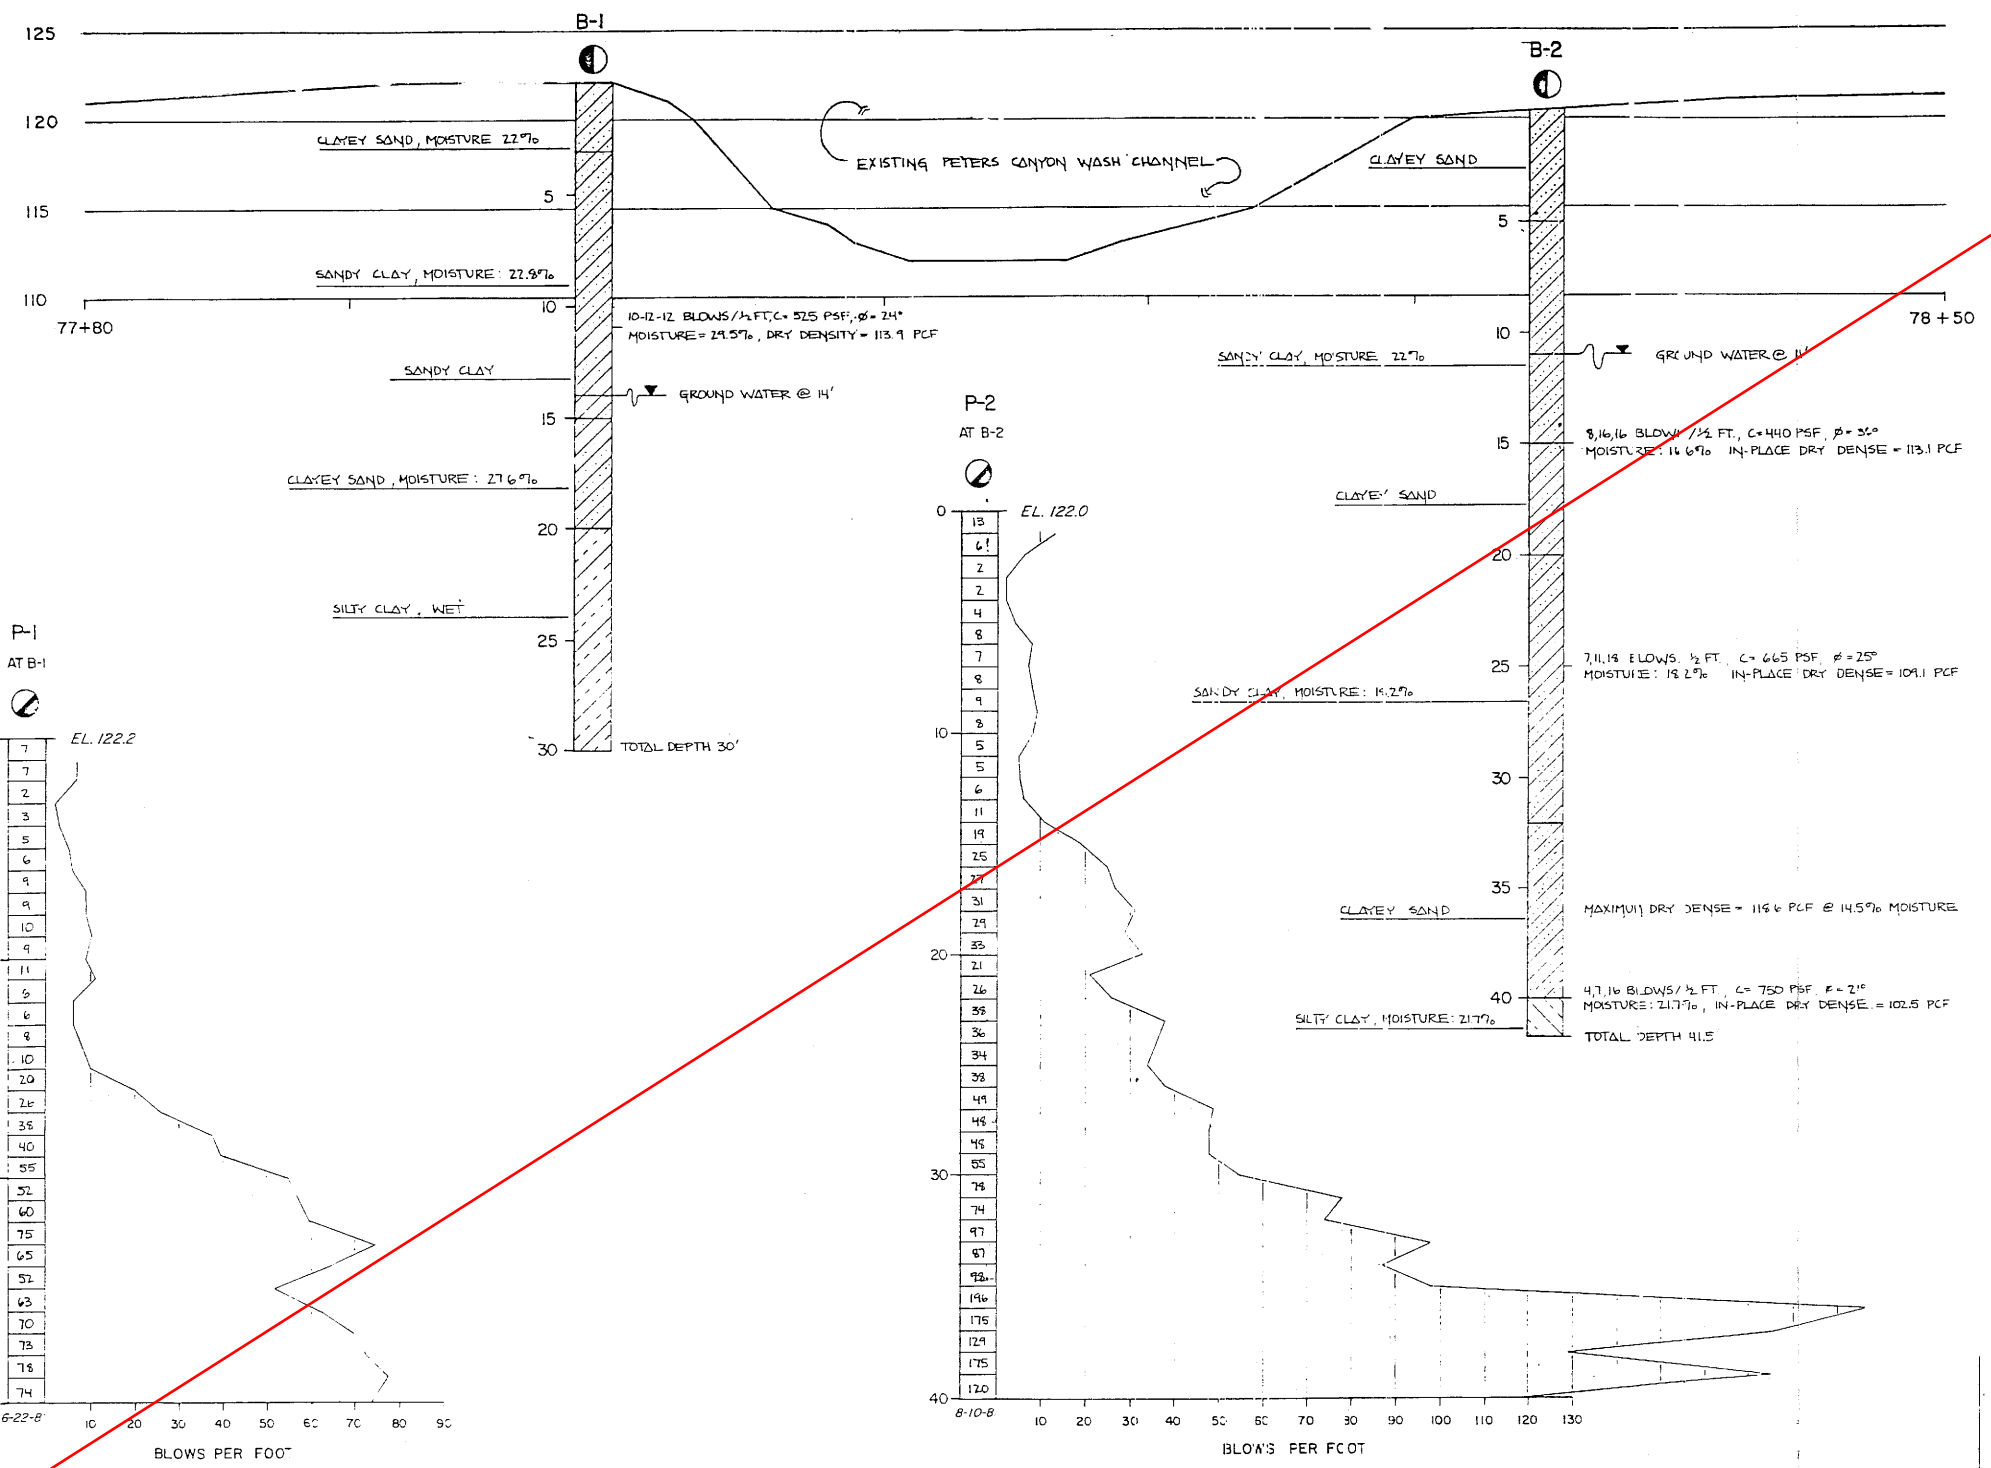





LEGEND OF EARTH MATERIALS



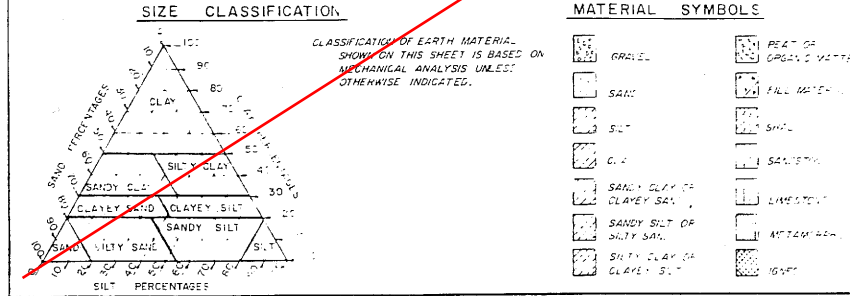


LEGEND OF BORING OPERATIONS

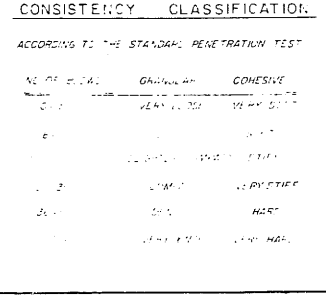


COUNTY OF ORANGE			
ENVIRONMENTAL MANAGEMENT AGENCY			
LOG, BORING / PENETROMETER			
PETERS CANYON WASH			
BRIDGE PROPOSAL			
SHEET 53			
SCALE AS SHOWN	DATE B-81	DRAWING G.E. ANDERSON	CHECKED BY

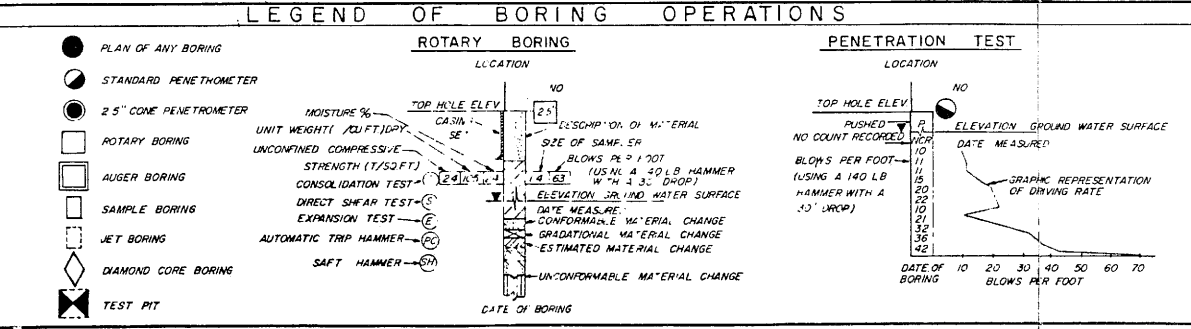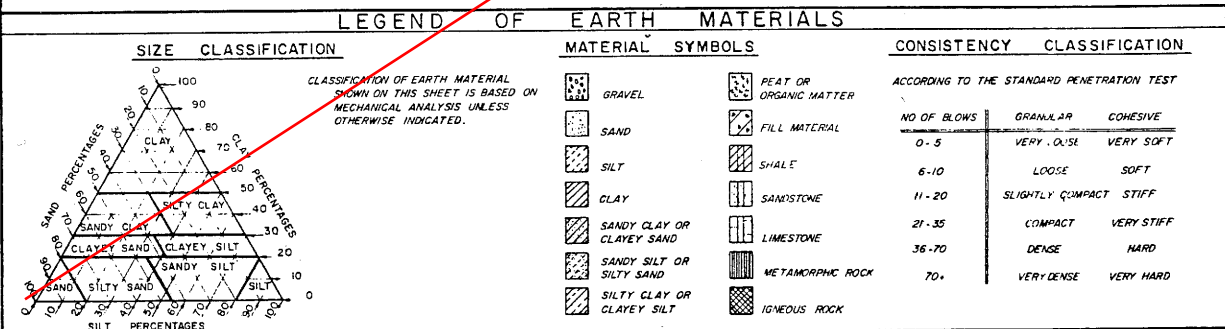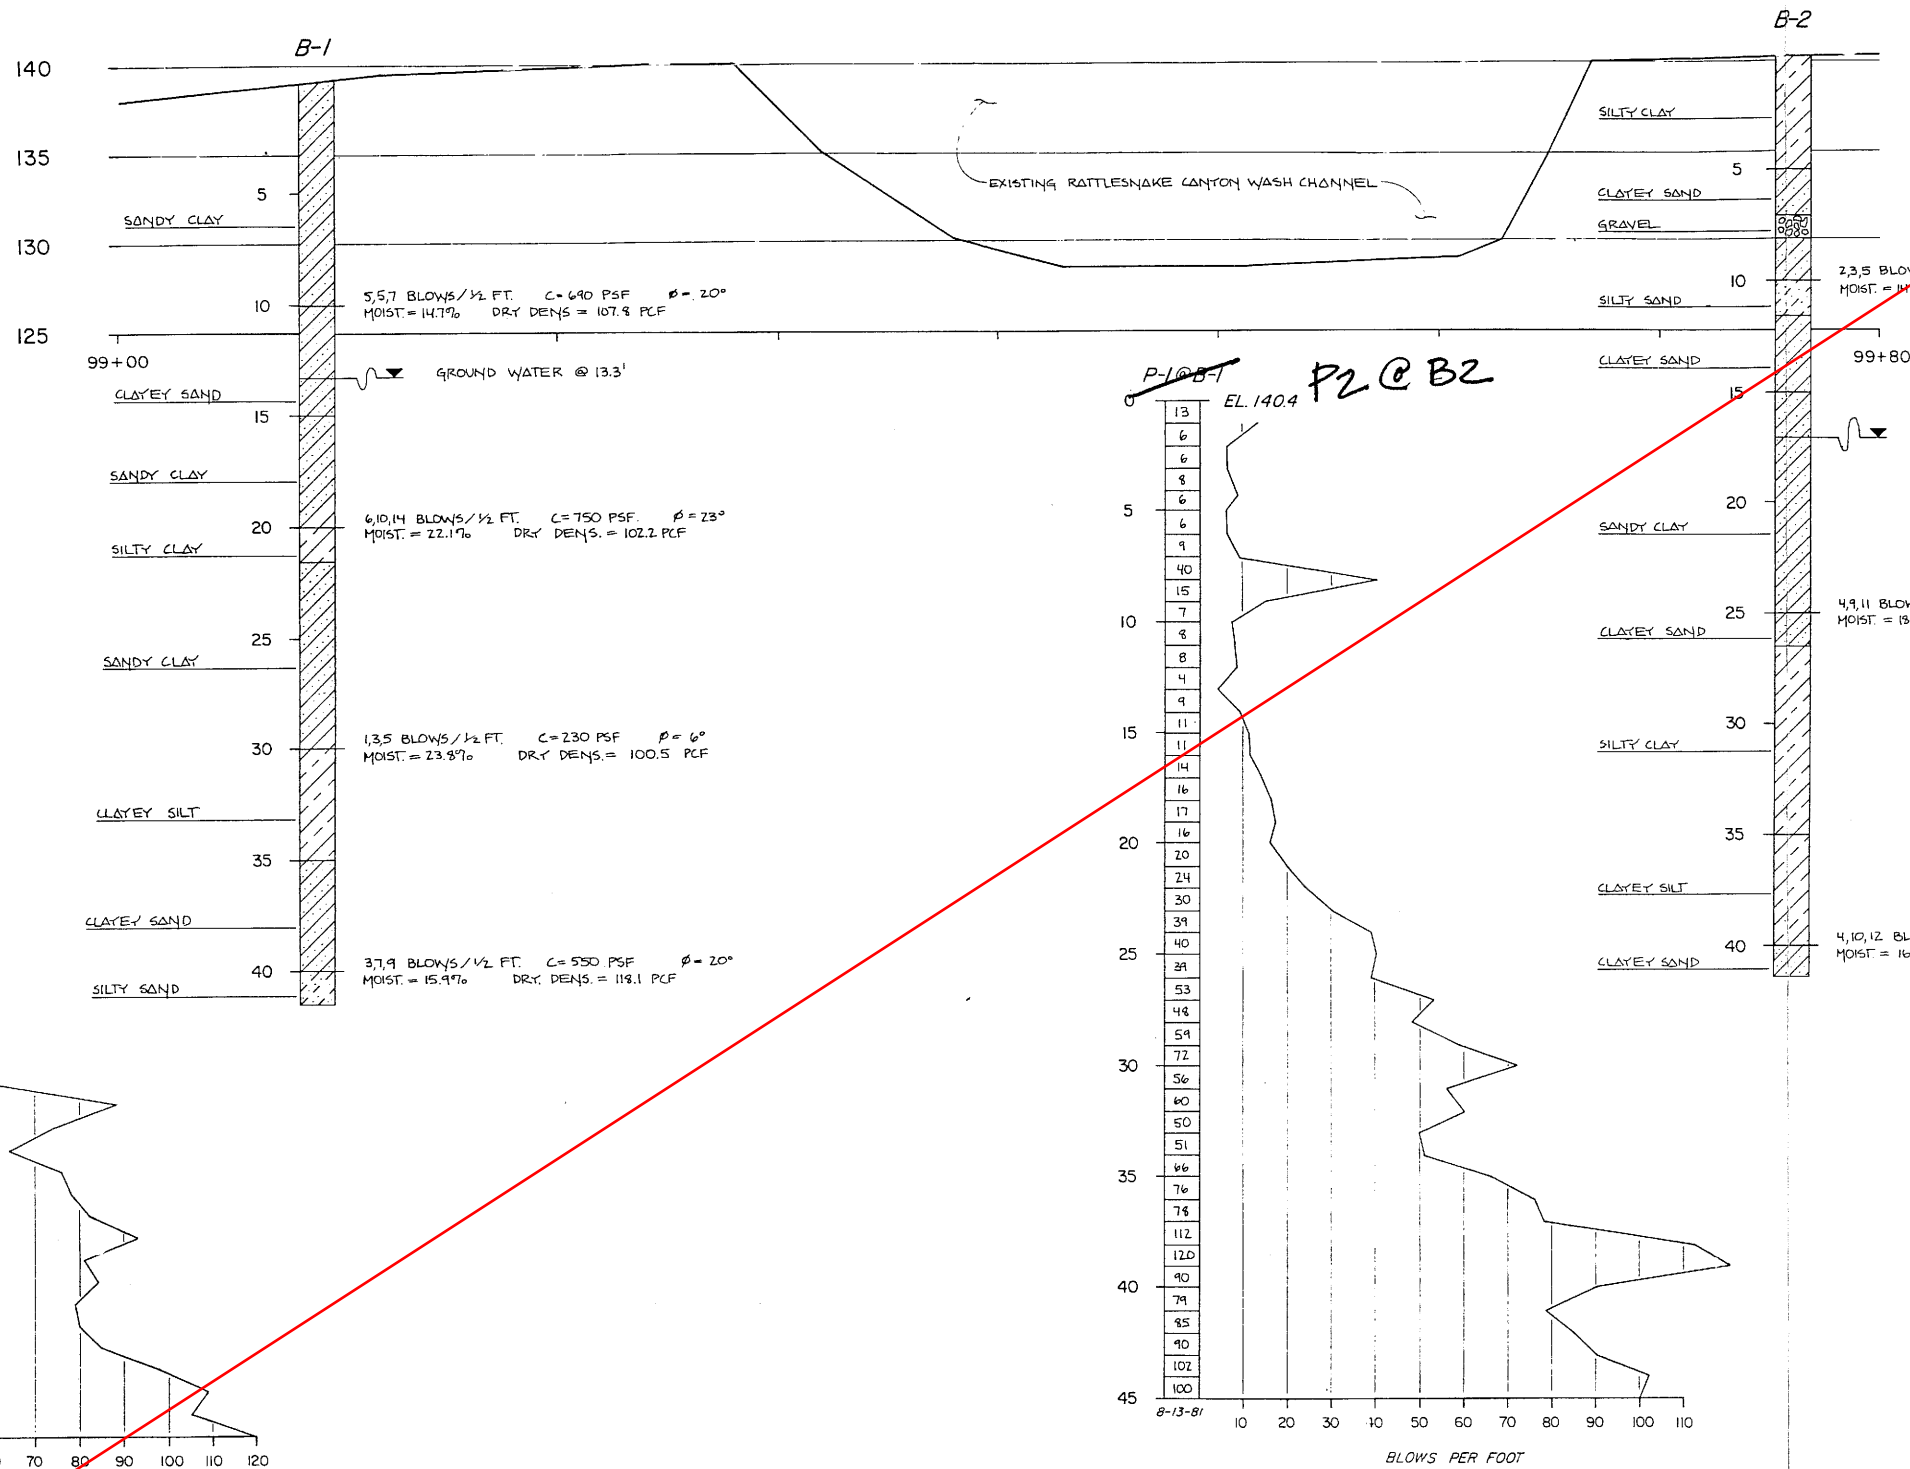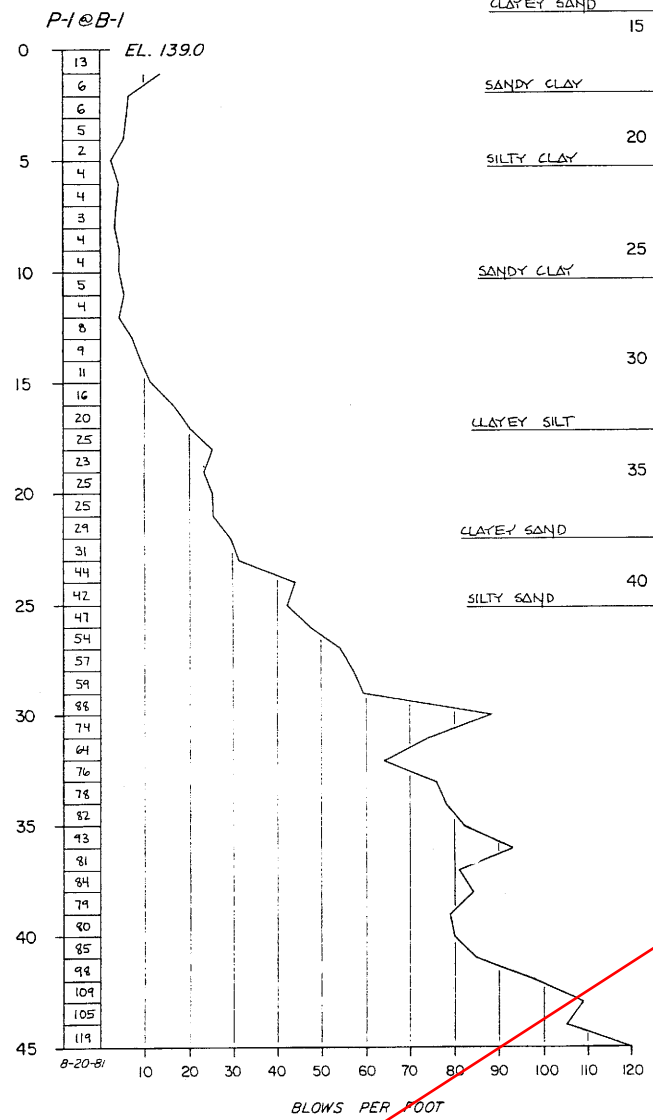


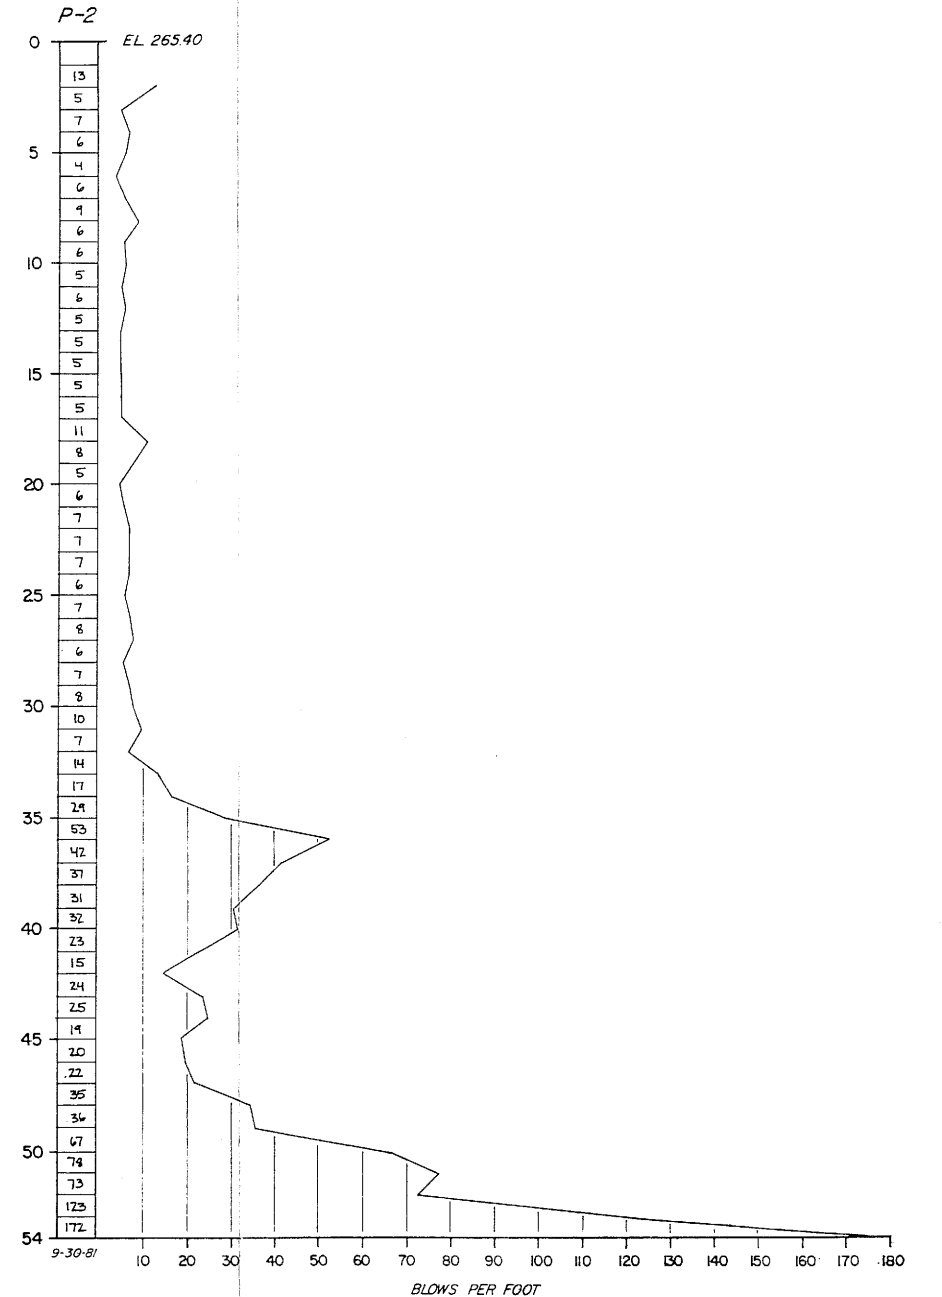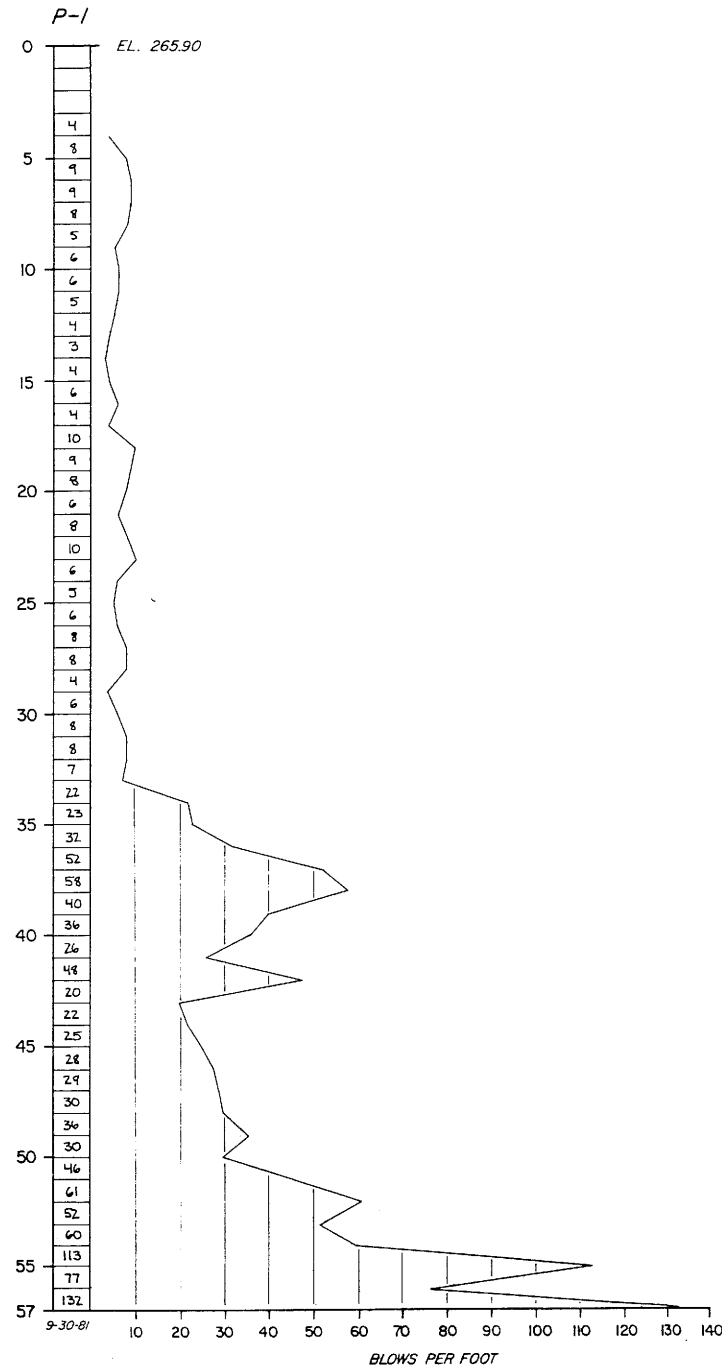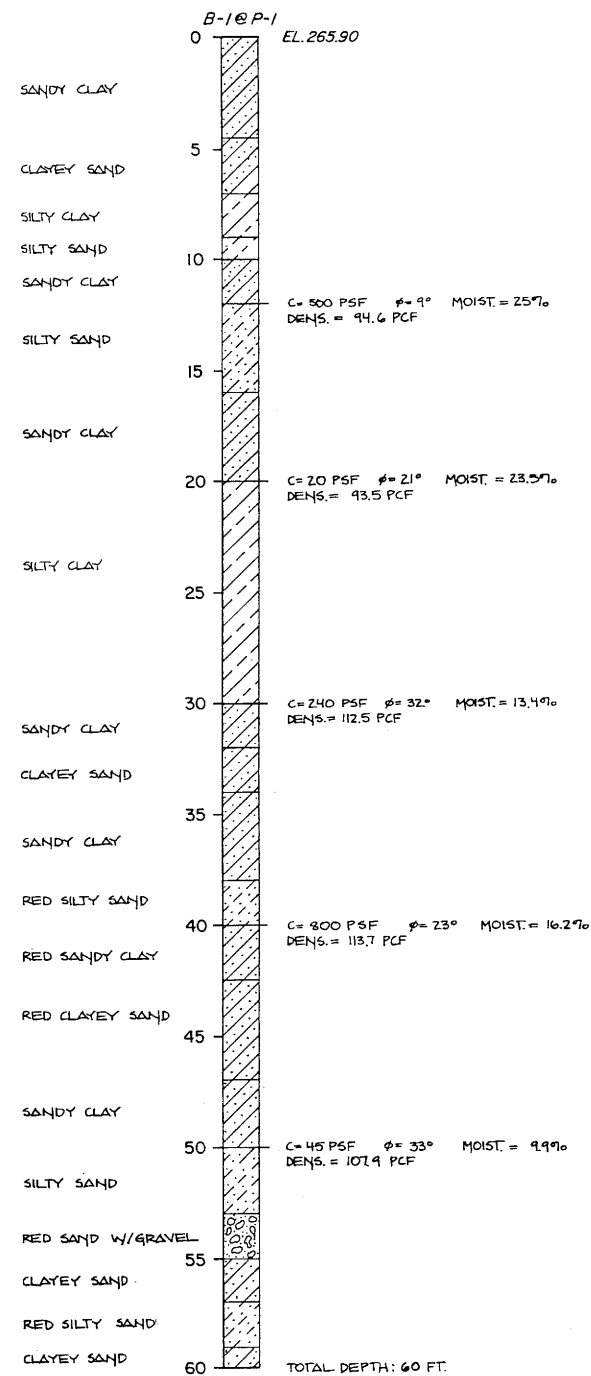

LEGEND OF EARTH MATERIALS

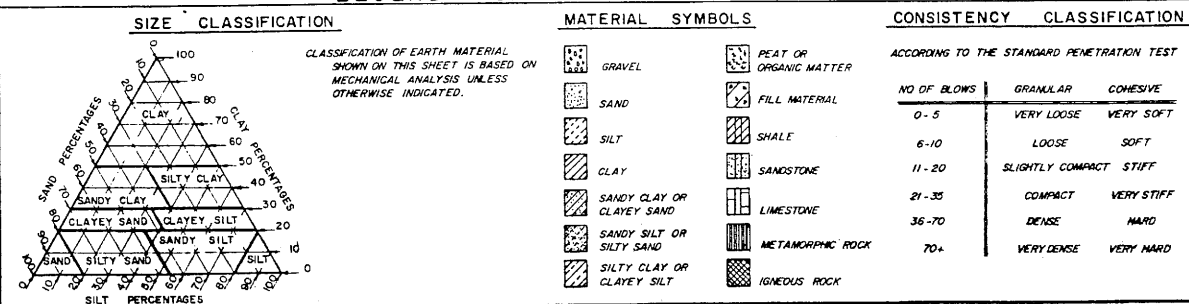

LEGEND OF BORING OPERATIONS

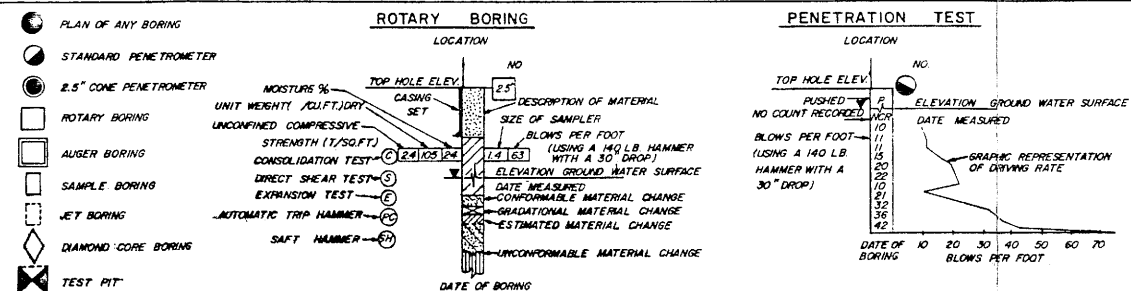

COUNTY OF ORANGE

ENVIRONMENTAL MANAGEMENT AGENCY

LOG, BORING/ PENETROMETER

CENTRAL IRVINE CH.

BRIDGE PROPOSAL

SHEET 55

SCALE AS SHOWN

DATE 12-81

DRAWING GE. ANDERSON