



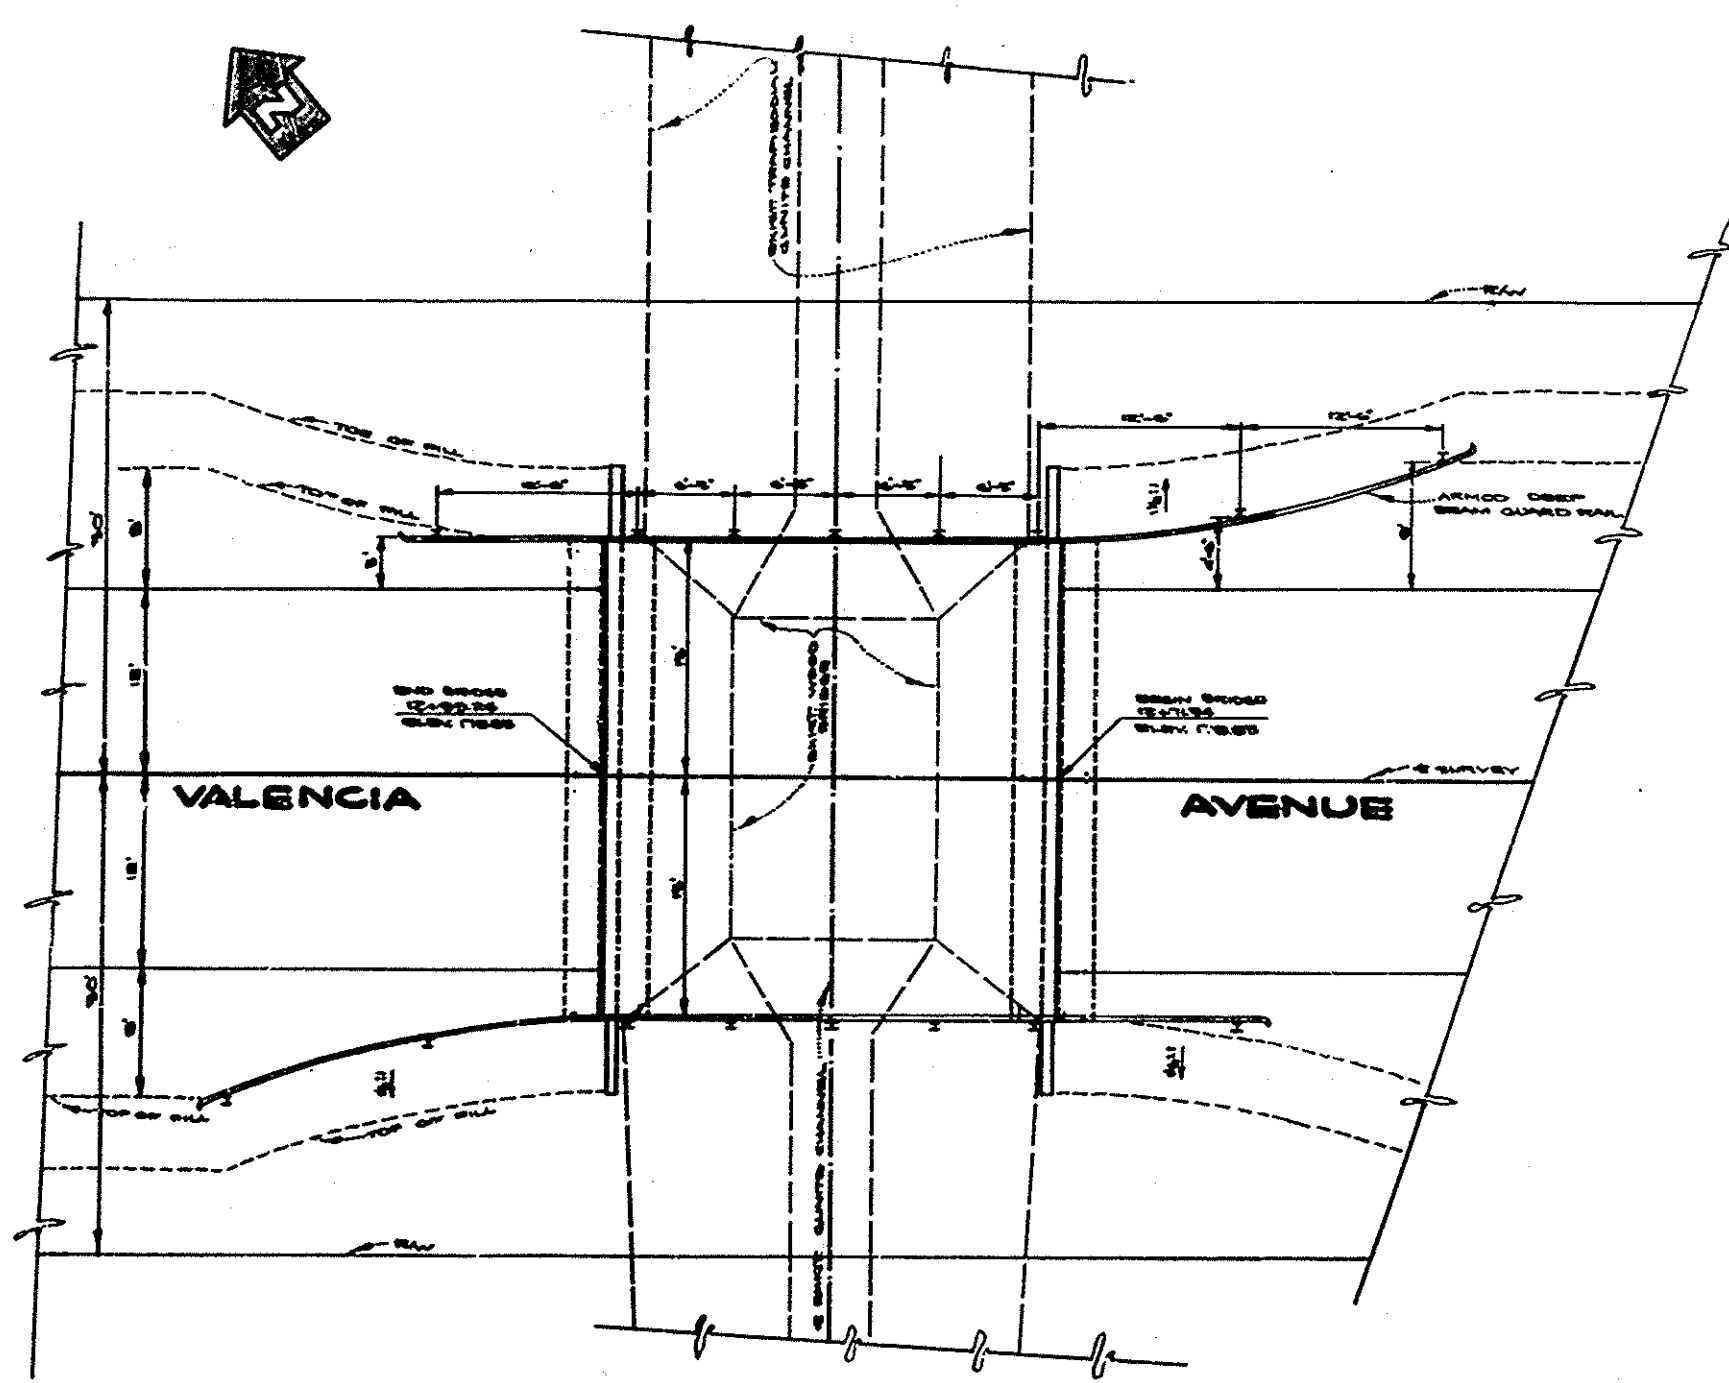


PLAN
SCALE 1/8"=1'

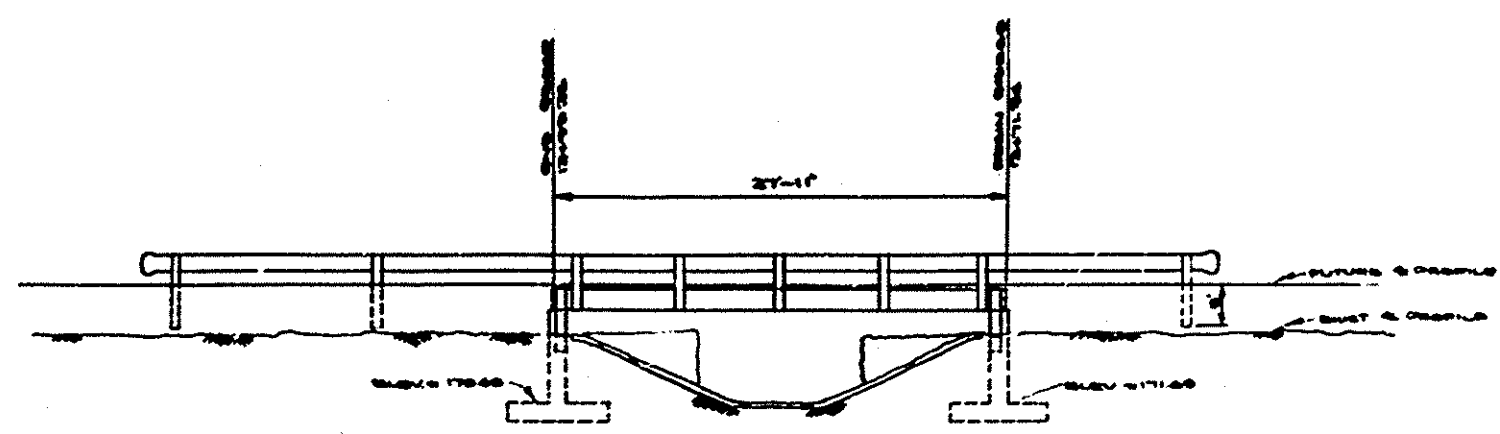


ELEVATION
SCALE 1/8"=1'


B.M. SPONGE IN POWER POLE MARKED
STATION 2+14.25
ELEV. = 100.12

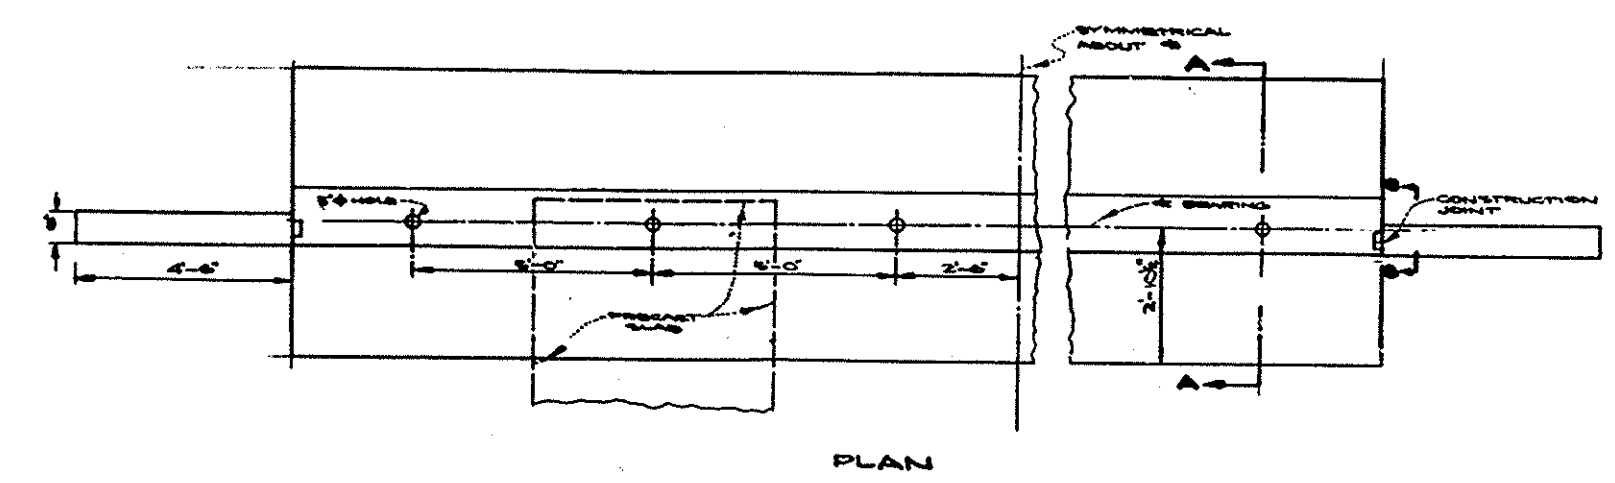


PLAN

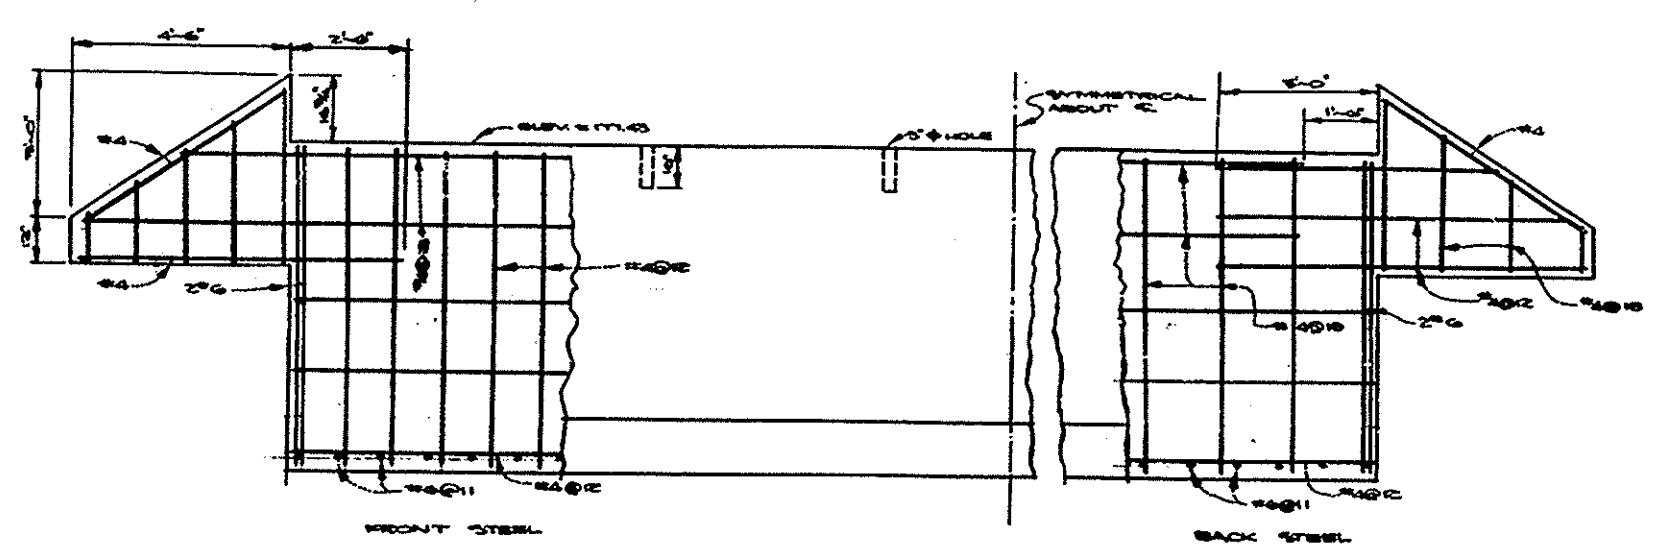

ABUTMENT DETAILS
SCALE 1/8"=1'

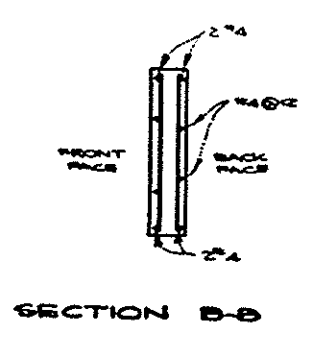

SECTION A-A

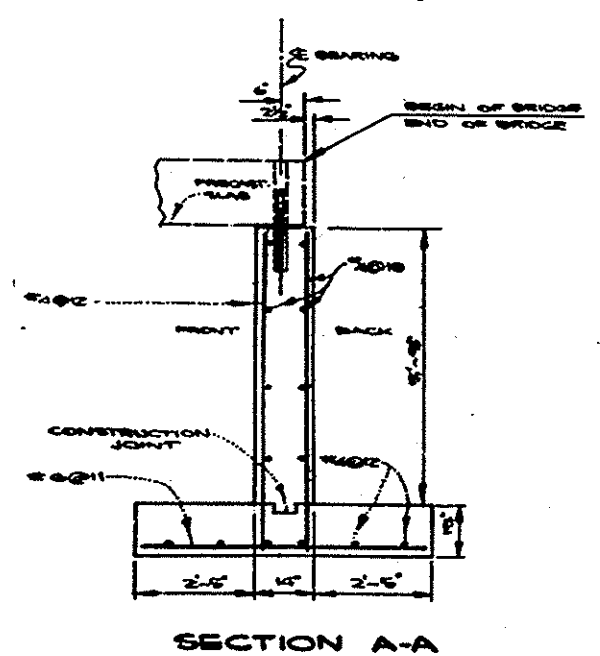

SECTION B-B

NOTES

IN CASE OF CONFLICT IN DIMENSIONS OR DETAILS
BETWEEN SHEET 1 AND SHEET 2, SHEET 1 SHALL
PREVAIL.
ASSUMED ALLOWABLE SOIL PRESSURE = 2000 PSF
MINIMUMS ARE TO BE CAST AFTER PRECAST SLABS
HAVE BEEN PLACED.
PLACE BACKFILL AGAINST ABUTMENTS ONLY AFTER
PRECAST SLABS HAVE BEEN PLACED AND DOWELS
AND DOWEL HOLES HAVE BEEN GROUTED.
BEFORE CASTING THE PRECAST SLABS, THE CASTING
SLAB SHALL BE COVERED WITH AN APPLICATION OF
SLANT PROTECTANT CONCRETE CURING (125) (10) (10) (10)
MANUFACTURED BY THE HUNT PROCESS CO. INC., 1015
STANFORD AVE., LOS ANGELES, CALIF. IT SHALL BE APPLIED
ACCORDING TO THE MANUFACTURER'S INSTRUCTIONS AND
SPECIFICATIONS. THE ABOVE MENTIONED SHALL NOT
BE USED FOR CURING STRIPS SHALL BE WELL SEPARATED
BEFORE USING.

Bridge #8-215
Across Channel
On Valencia Ave 0.24 mi
n/wly of Laguna Rd.
Sheet 1 of 1
Red: Scale as shown
Linen

MICROFILMED
JUL 5 1980

COUNTY OF ORANGE HIGHWAY DEPARTMENT		
PLAN AND DETAILS		
BRIDGE ACROSS CHANNEL		
ON VALENCIA AVE. 0.24 MILES NORTHWESTERLY OF LAGUNA RD.		
STRUCTURE No. 8-215		
APPROVED <i>[Signature]</i> ROAD COMMISSIONER		
SCALE AS SHOWN	DATE NOV. 1960	SHEET 1 OF 2 SHEETS

IRVINE Center DR 1957
(S-215)
50C-594
Thomas 860-16