



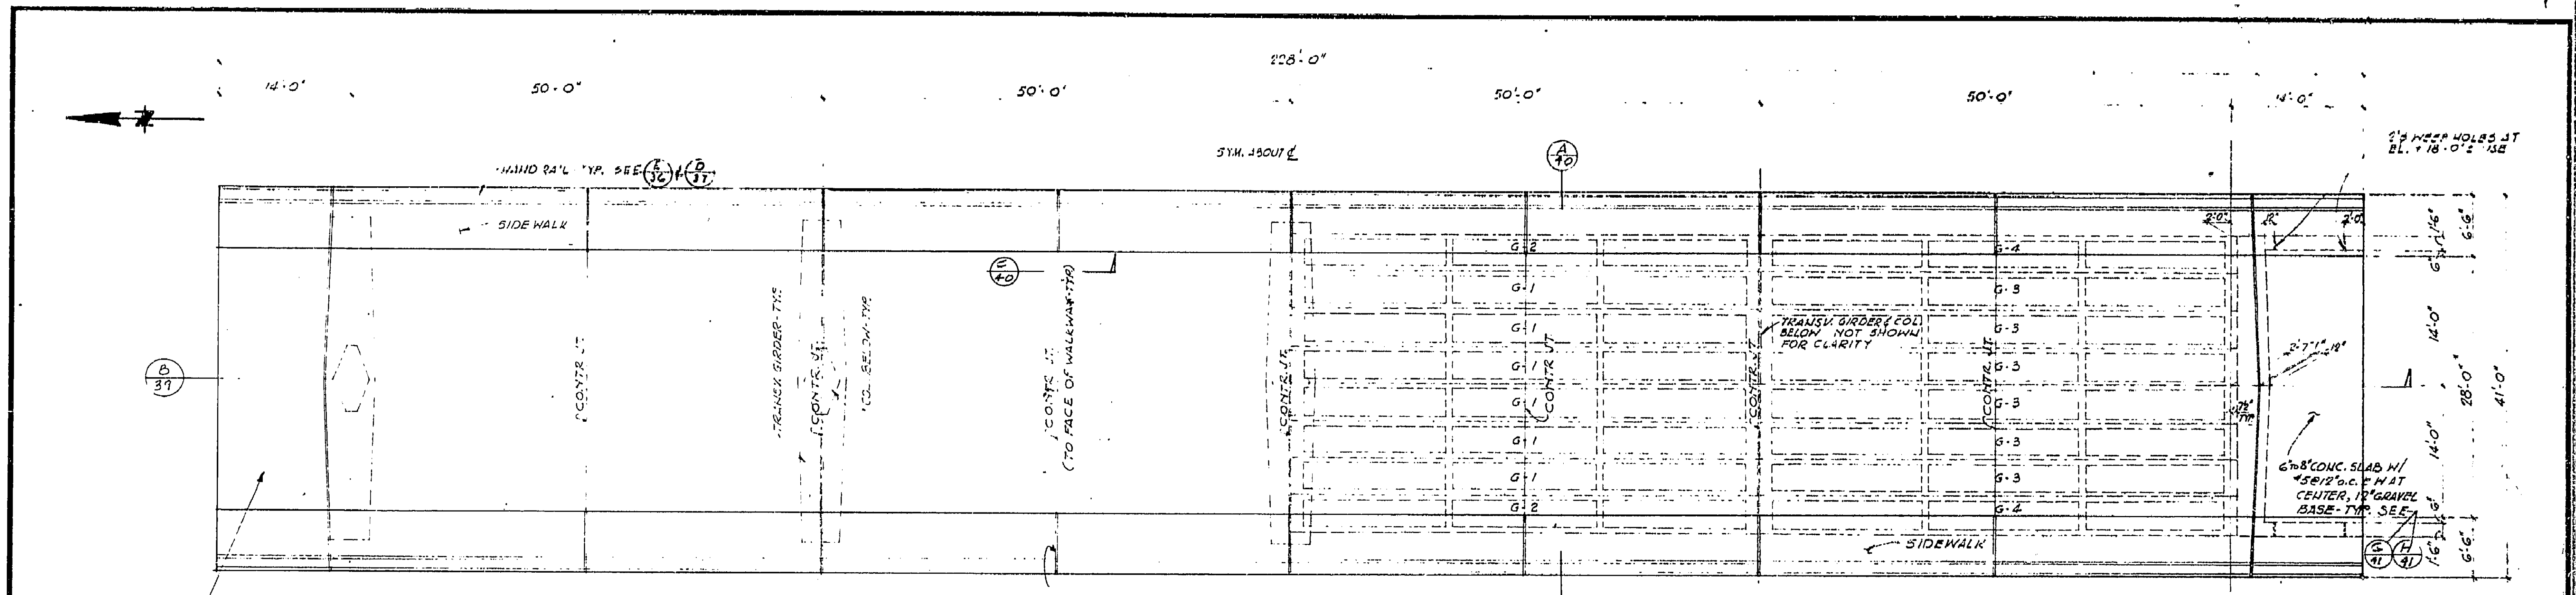

NOTE: APPROACH STRUCTURES TO BE CONSTRUCTED SIX MONTHS AFTER COMPLETION OF FILL. MODIFIED BY CONTRACTOR REQUEST

NOTE: SEE SH. 37 FOR PLAN OF REVETTED SLOPE & BRIDGE SUPPORT.

PLAN A SEE PARTIAL PLAN A

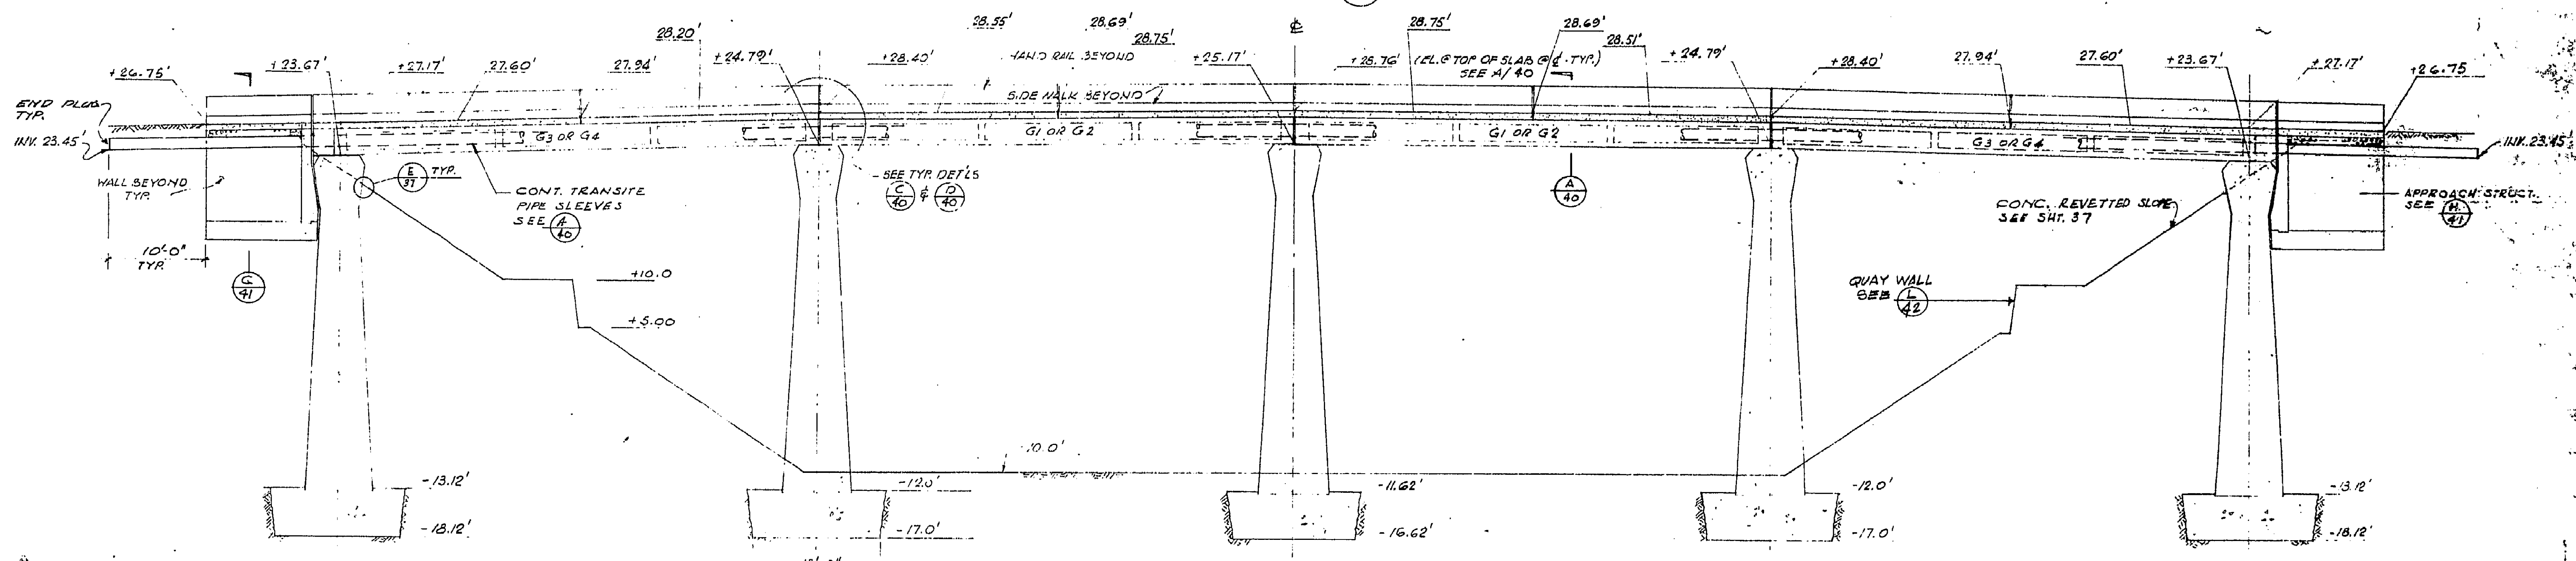

NOTE: CONCRETE FOOTINGS PLACED AGAINST CUT BANK


SECTION B

AS BUILT PLANS
Contract No. **B# 55C-561**
Date Completed
Document No. **Dist 12**

ORANGE COUNTY HARBOR DISTRICT NEWPORT BEACH, CALIFORNIA 1901 BAYSIDE DRIVE 714/834-3800	
DANA POINT HARBOR DANA POINT, CALIFORNIA HEAVY CONSTRUCTION BRIDGE STRUCTURAL PLAN AND SECTION	
PLANS PREPARED BY K KOEHLER & KOEHLER, INC. ENGINEERING ARCHITECTURE PLANNING LOS ANGELES, CALIFORNIA 213/688-3188	JOB NO. 1-417 DATE 9-24-58 APPROVED: <i>[Signature]</i> DATE 9-24-58
DATE OCTOBER 1958 SCALE AS SHOWN	SHEET 39 OF 60 D 10.5-1

29X


I HEREBY CERTIFY THAT THIS IS A TRUE AND ACCURATE COPY OF THE ABOVE DOCUMENT TAKEN UNDER MY DIRECTION AND CONTROL ON THIS DATE IN SACRAMENTO, CALIFORNIA PURSUANT TO AUTHORIZATION BY THE DIRECTOR OF TRANSPORTATION.
3-26-90
[Signature]
 SUPERVISOR OF MICROFILM SERVICES

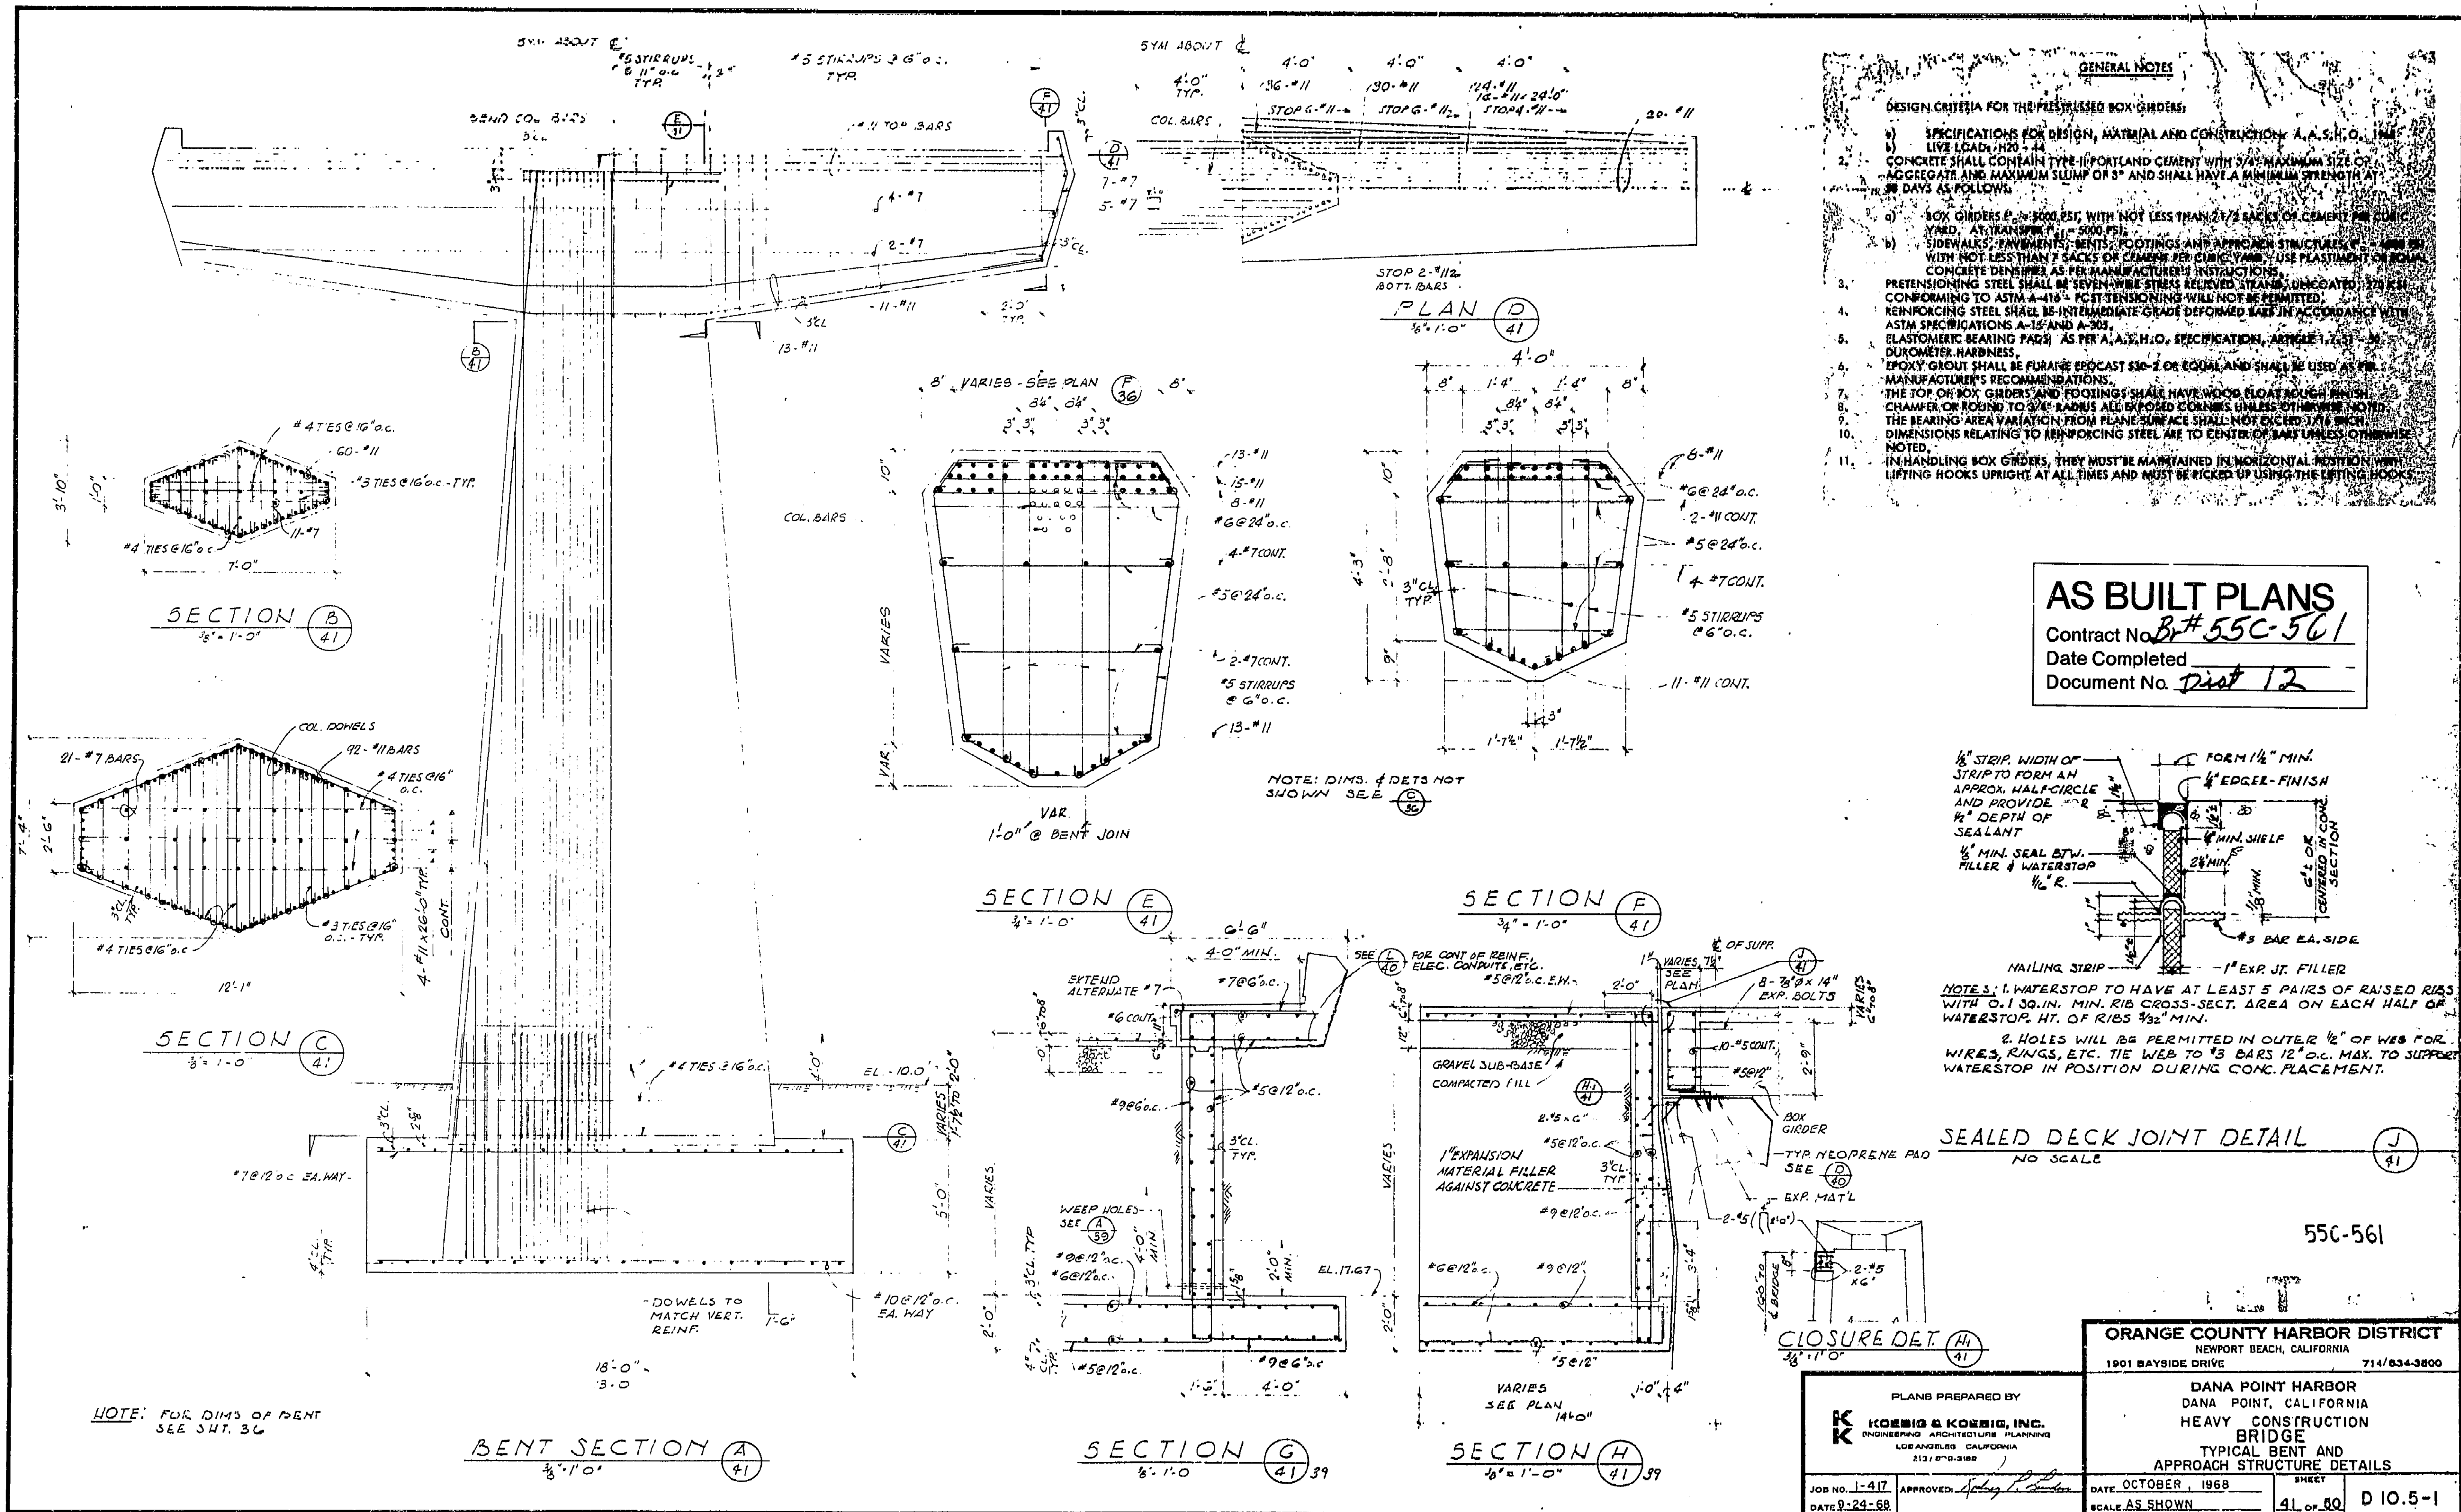


29X

I HEREBY CERTIFY THAT THIS IS A TRUE AND ACCURATE COPY OF THE ABOVE DOCUMENT TAKEN UNDER MY DIRECTION AND CONTROL ON THIS DATE IN SACRAMENTO, CALIFORNIA PURSUANT TO AUTHORIZATION BY THE DIRECTOR OF TRANSPORTATION.


3-26-90 *[Signature]* SUPERVISOR OF MICROFILM SERVICES

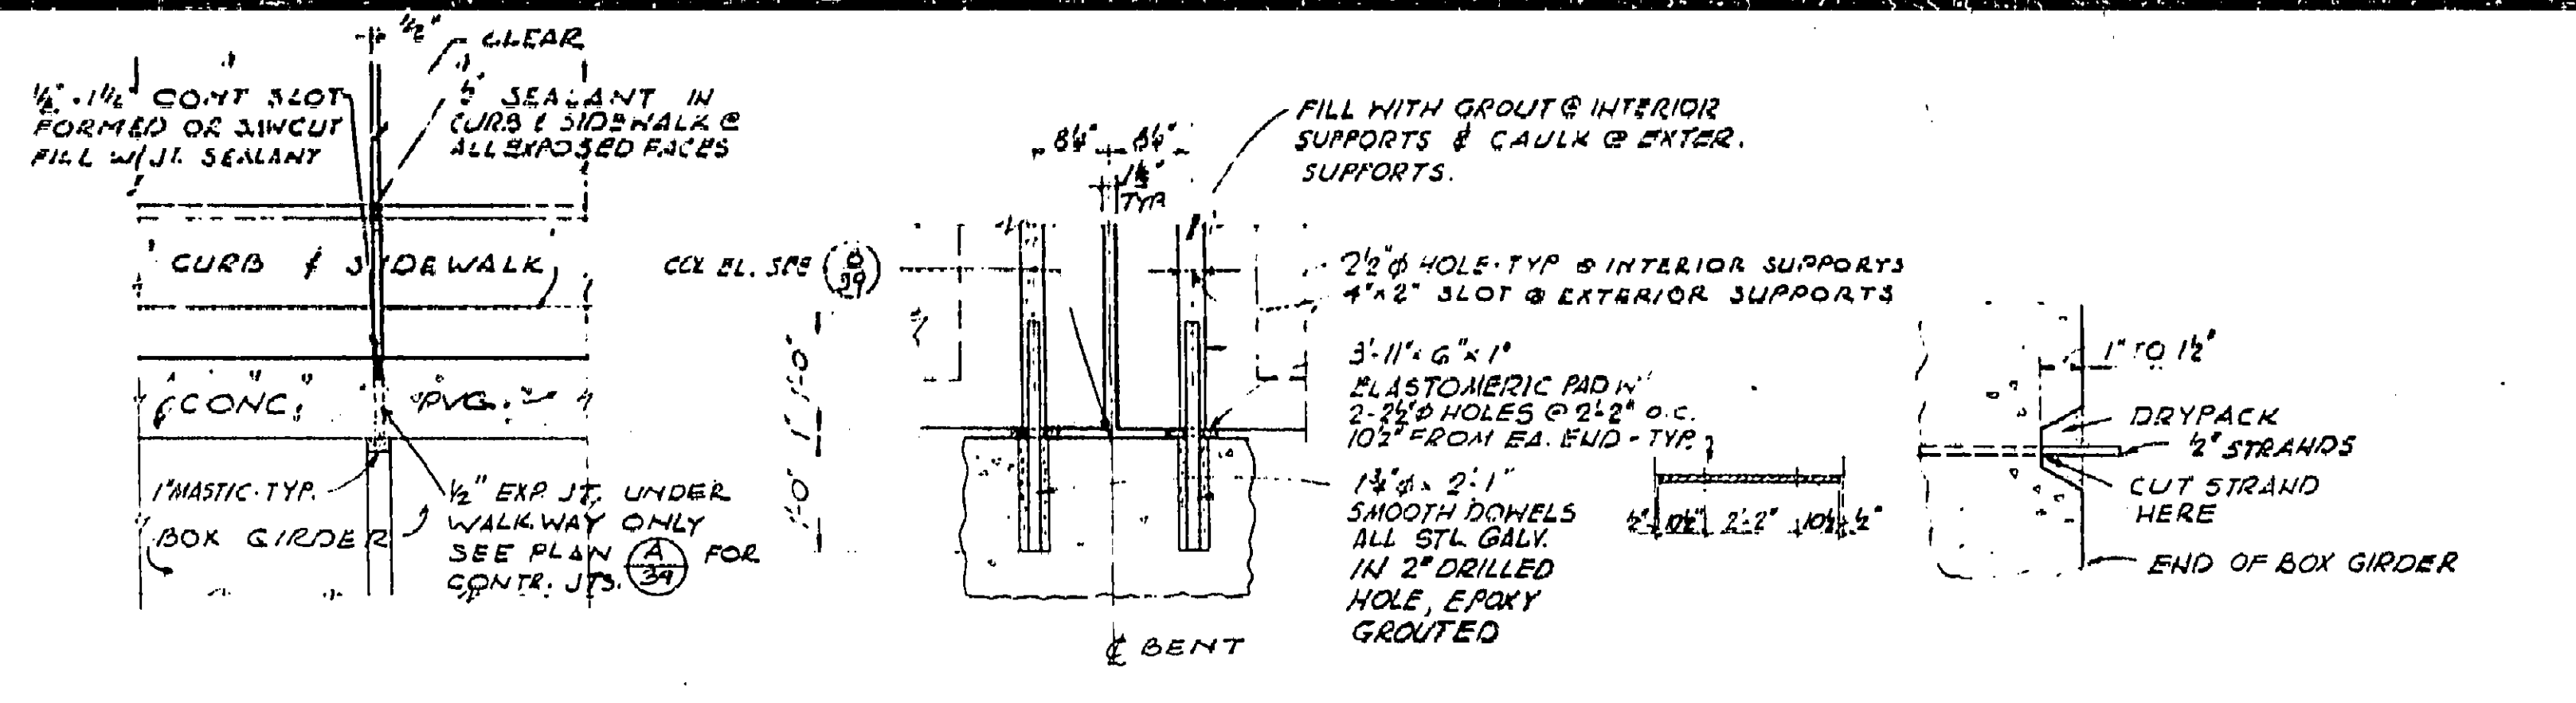


DET. @ ENDS OF PRESTRESSING STRANDS NO SCALE E
40

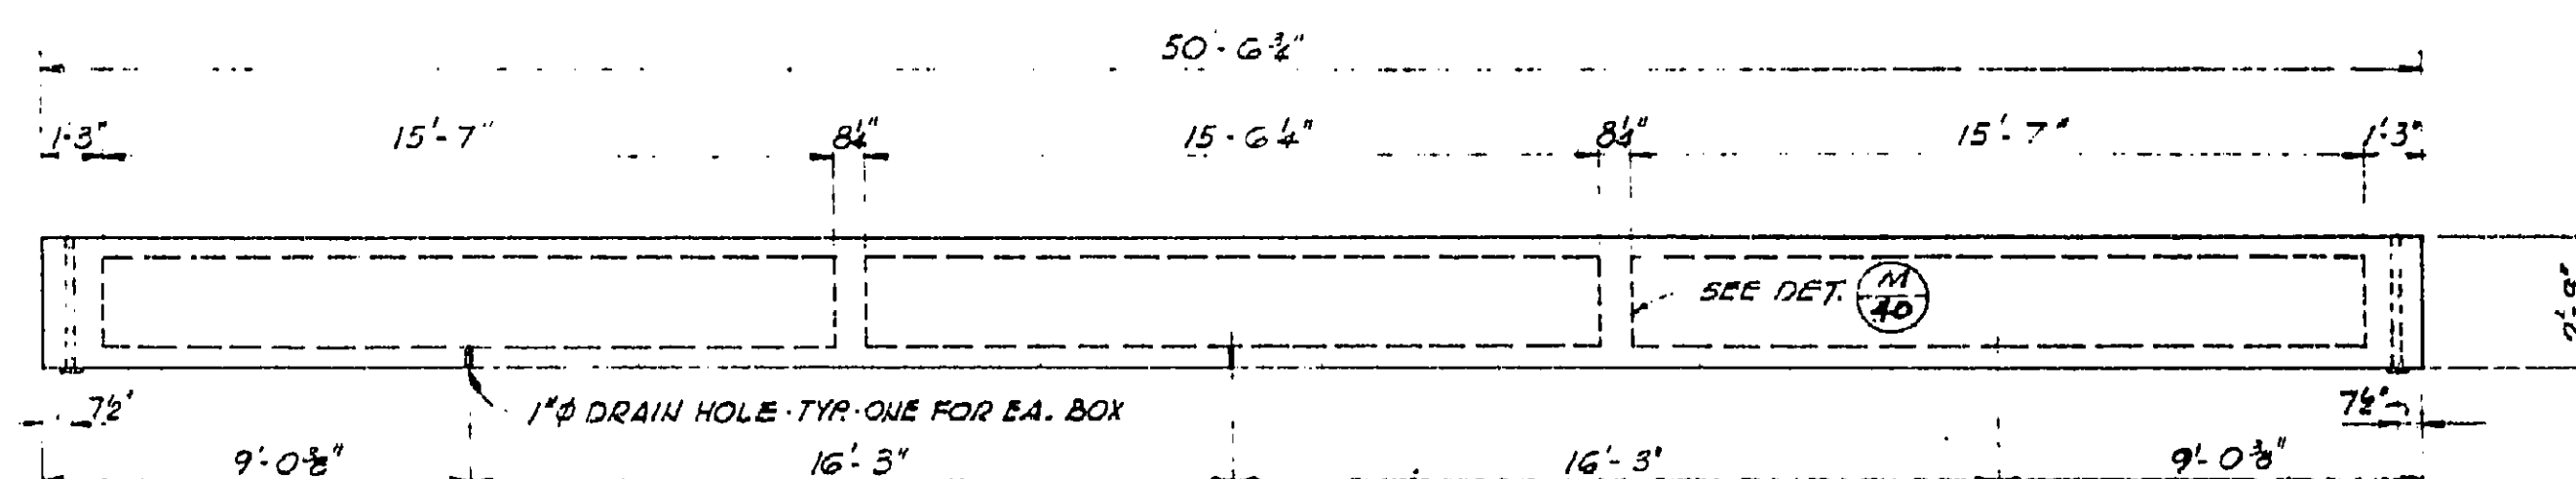

BOX GIRDERS 'G-3' & 'G-4' DETAIL


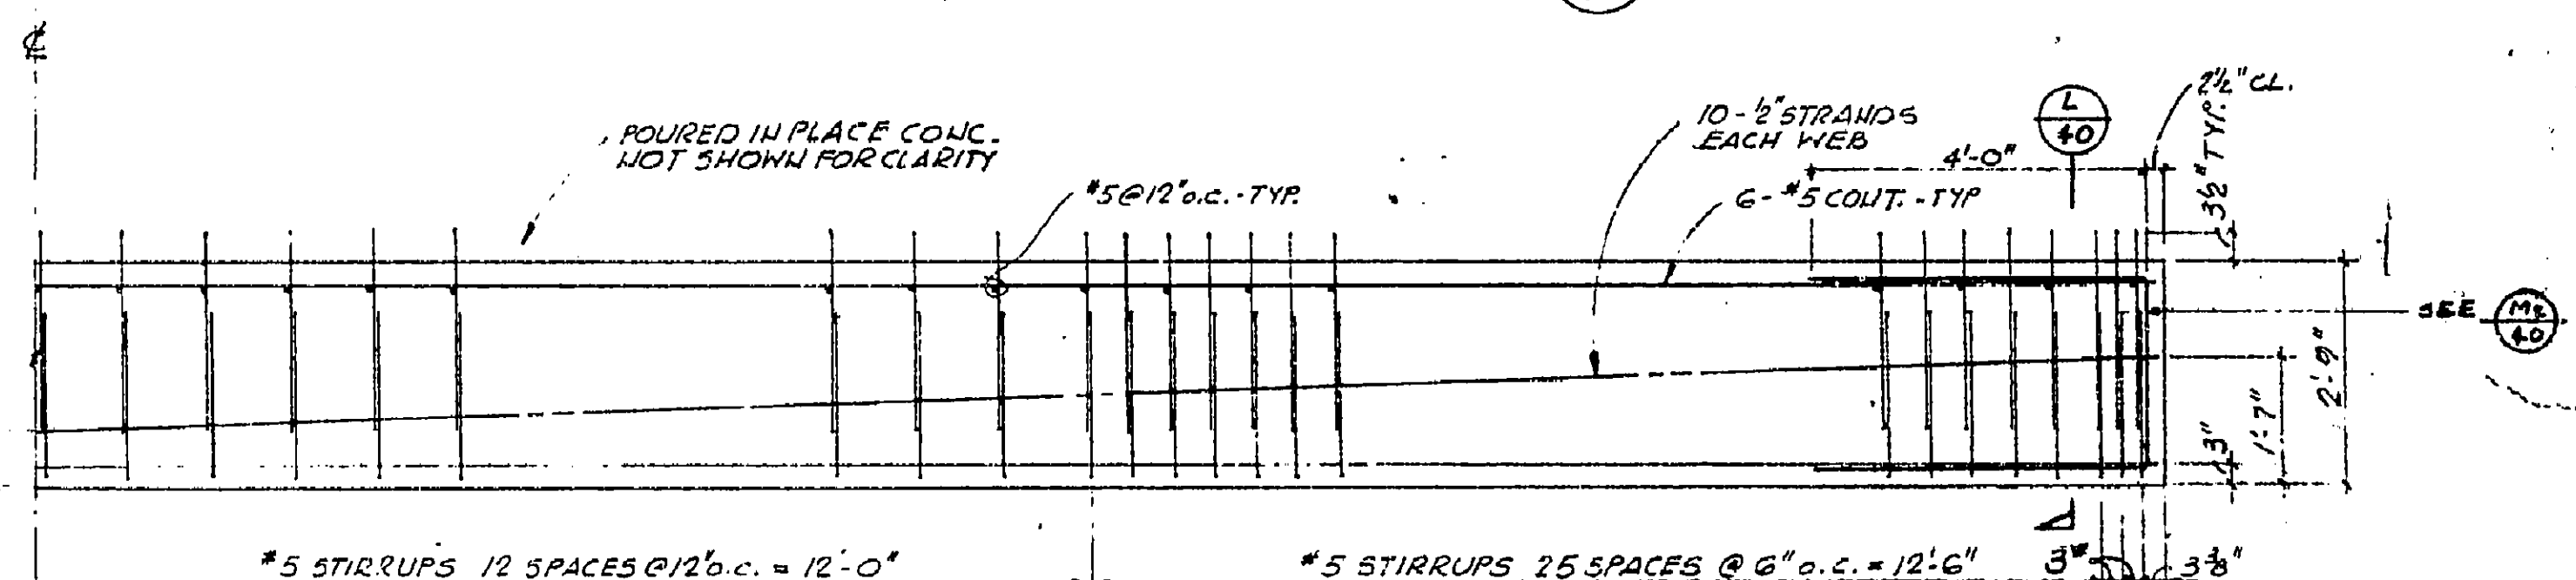


BOX GIRDERS 'G-2' & 'G-4' PRESTRESSING DETAIL

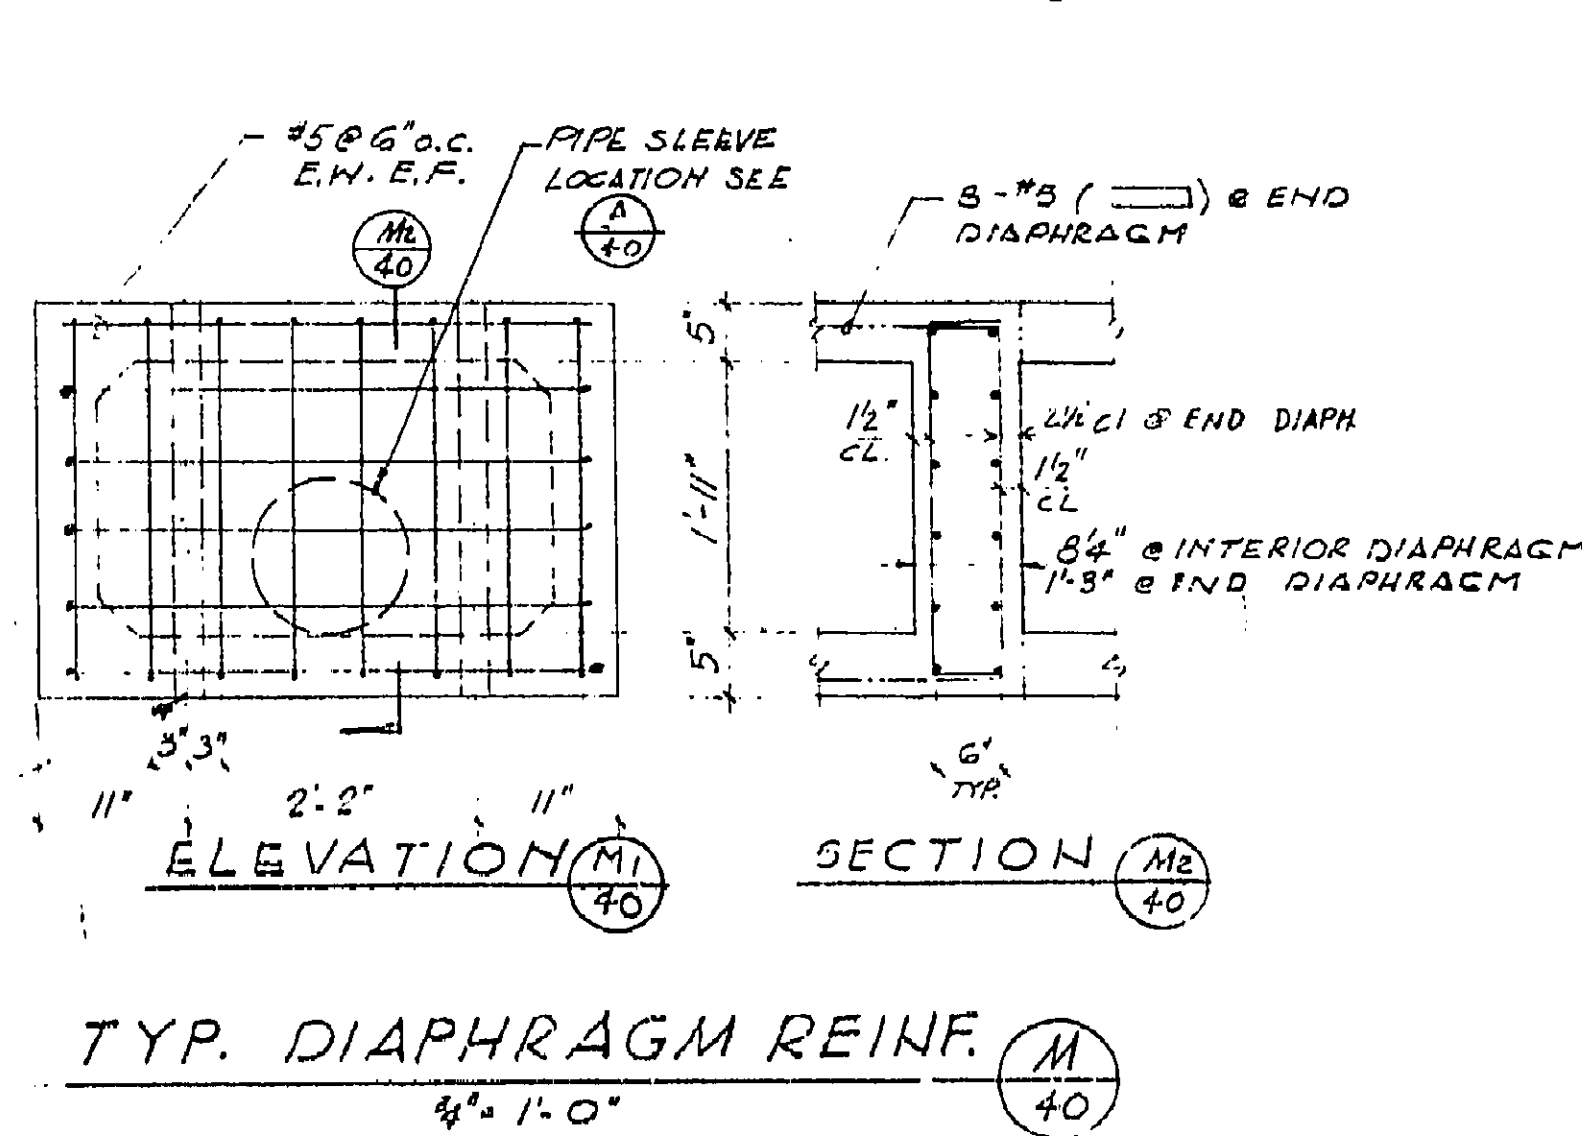


55C-561

DANA POINT HARBOR DANA POINT, CALIFORNIA HEAVY CONSTRUCTION BRIDGE		
TYPICAL SECTIONS AND BOX GIRDER DETAILS		
DATE <u>OCTOBER, 1968</u>	SHEET <u>40 of 50</u>	<u>D 10.5-1</u>
SCALE <u>AS SHOWN</u>		

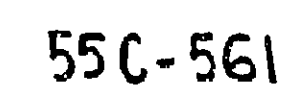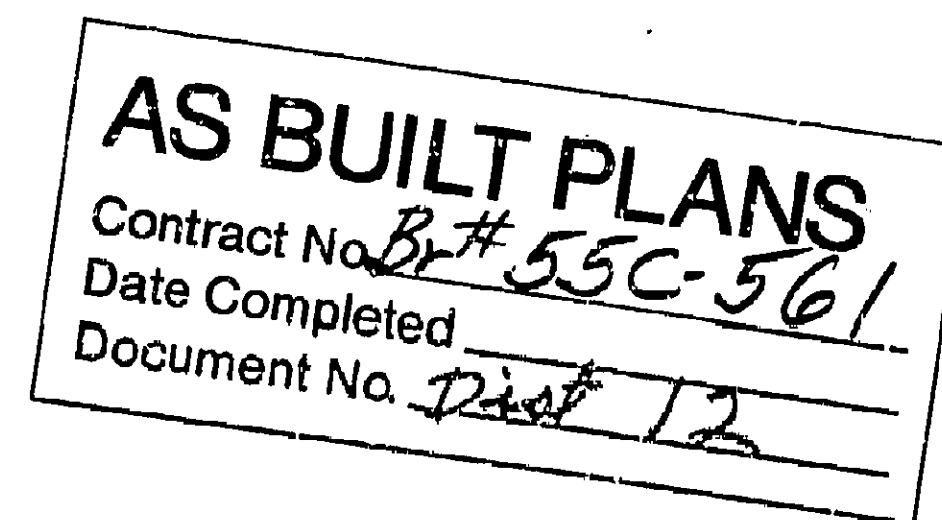

PLANS PREPARED BY K K KOEBIG & KOEBIG, INC. ENGINEERING ARCHITECTURE PLANNING LOS ANGELES CALIFORNIA 211 W. 690-3192		ORANGE COUNTY HARBOR DISTRICT NEWPORT BEACH, CALIFORNIA 1801 BAYSIDE DRIVE 714/634-3800	
JOB NO. <u>1-417</u> DATE <u>9-24-68</u>		DANA POINT HARBOR DANA POINT, CALIFORNIA HAVYAN CONSTRUCTION BRIDGE HAND RAIL AND MISCELLANEOUS DETAILS	
APPROVED: <i>Robert L. Koebig</i>		DATE <u>OCTOBER 1968</u> SCALE <u>AS SHOWN</u> SHEET <u>37 OF 60</u> <u>D 10.5-1</u>	

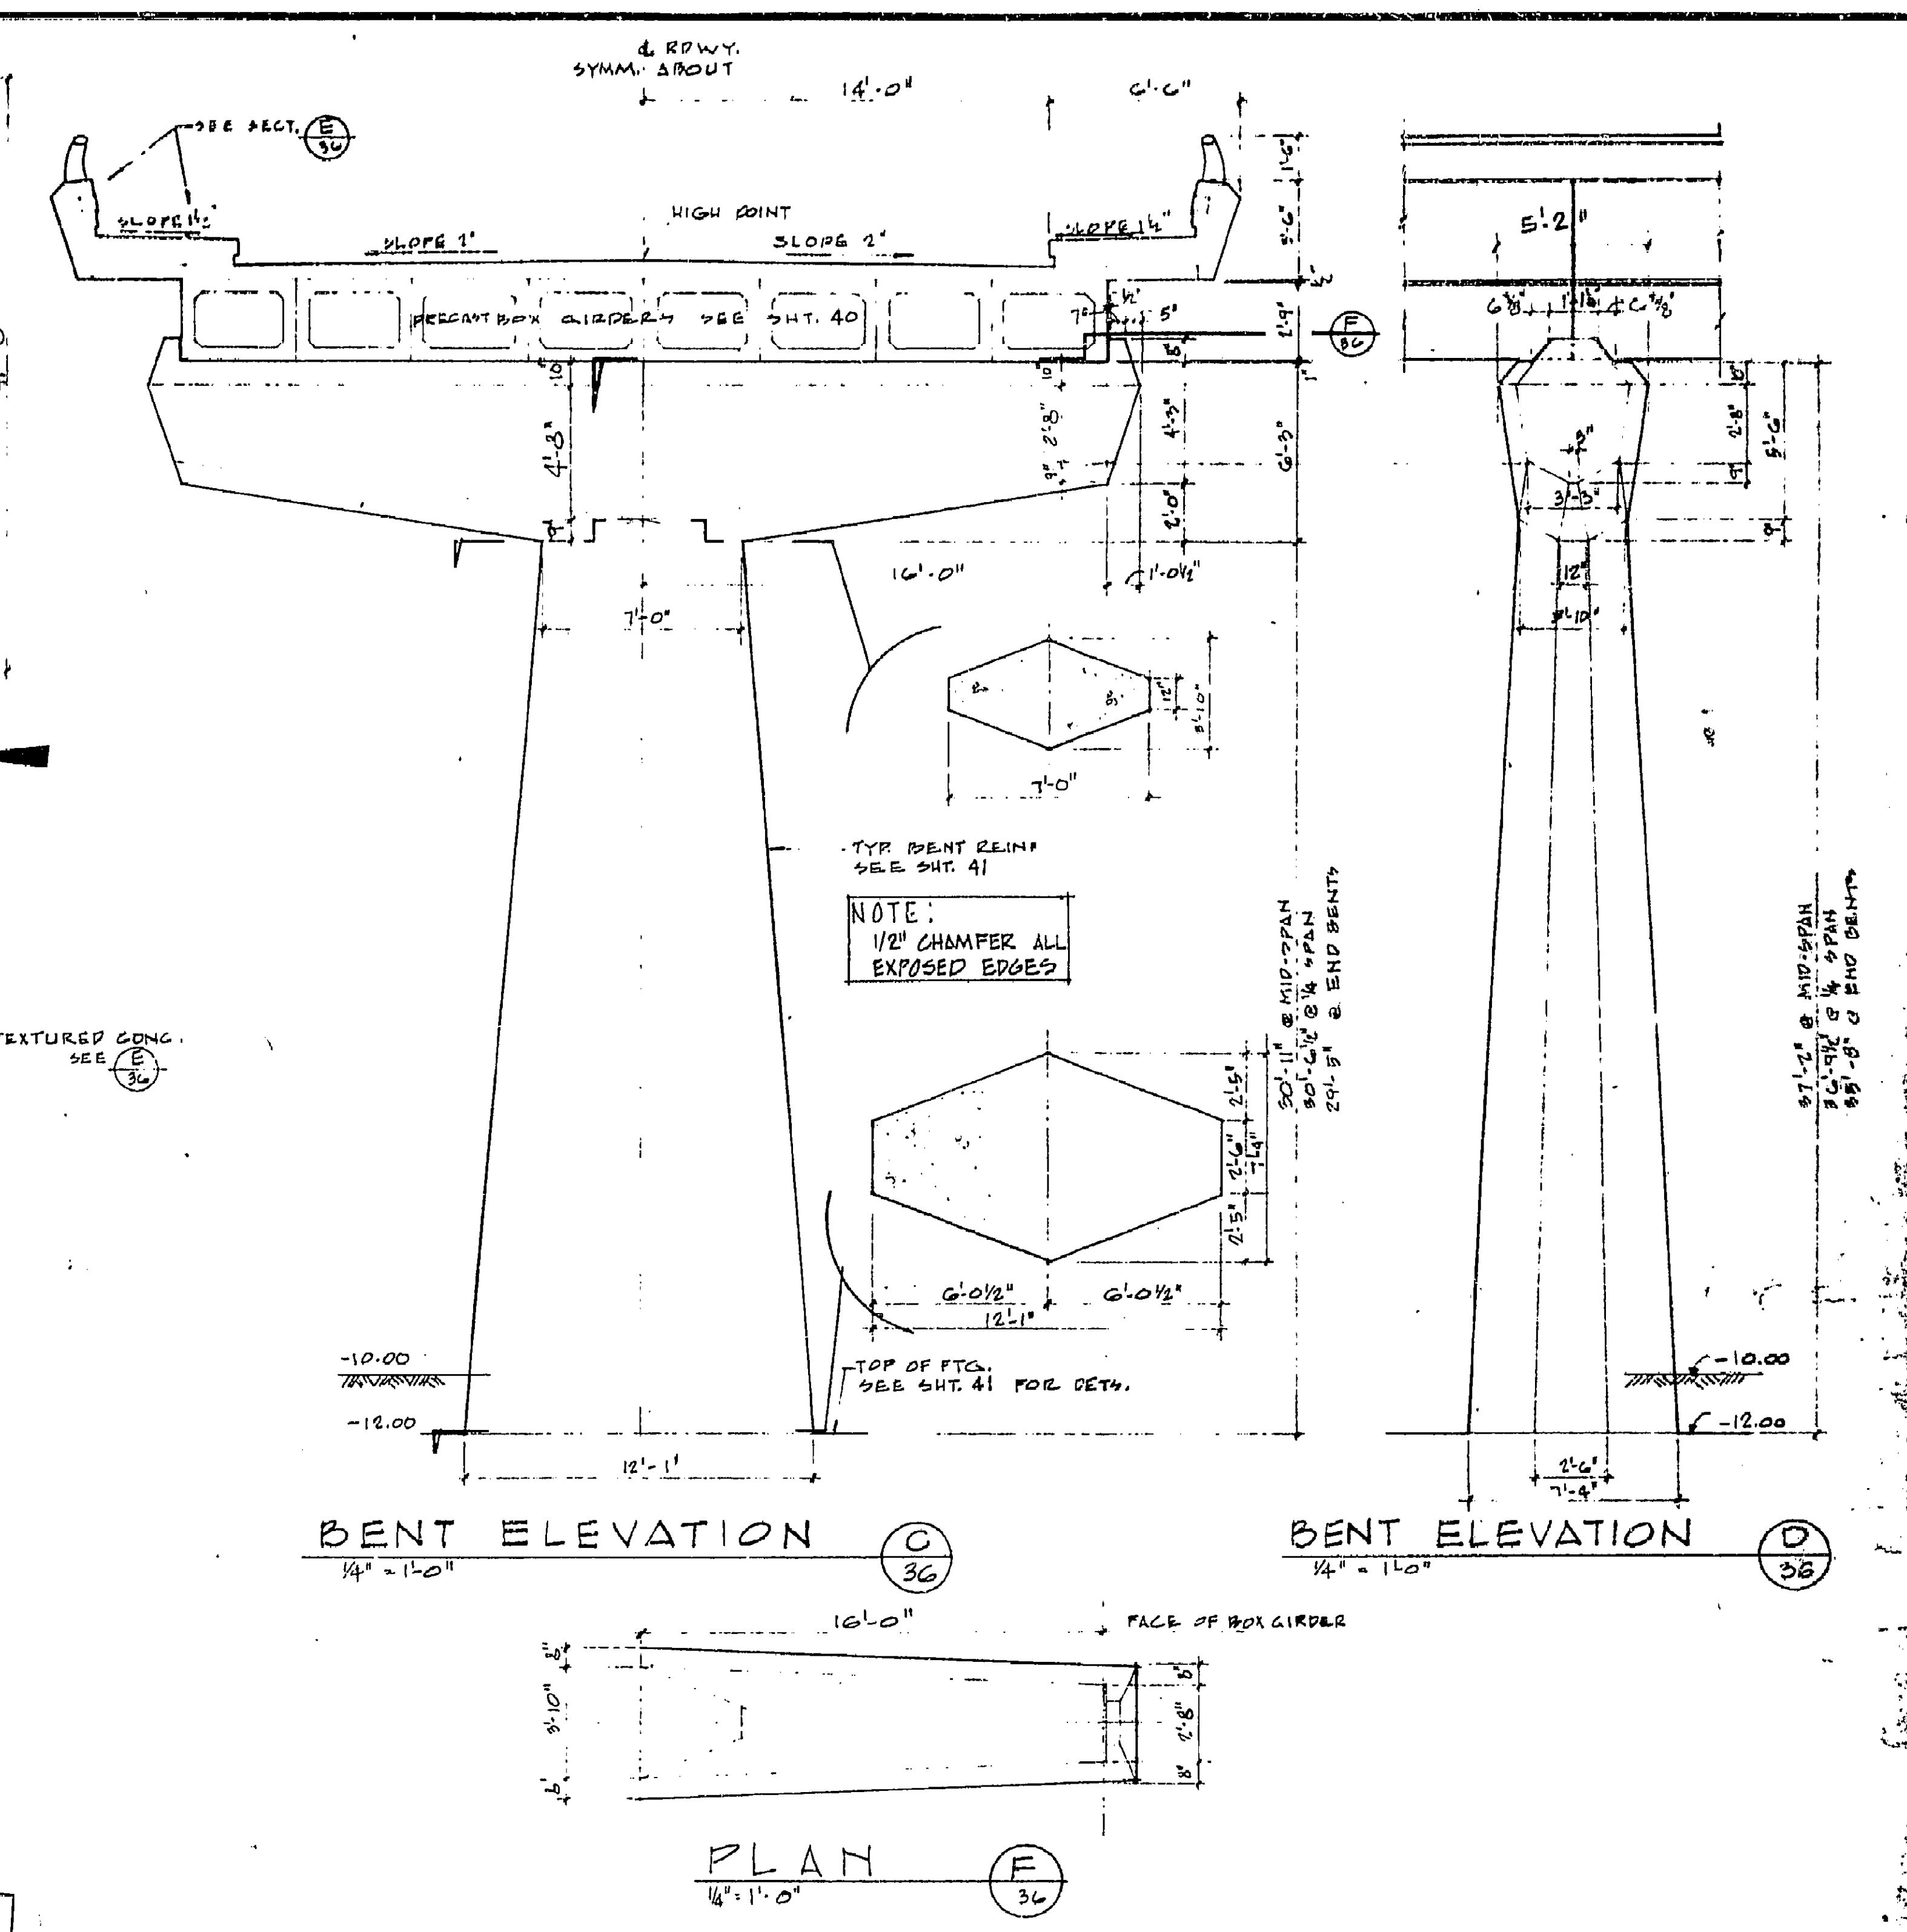

55C - 561

PLANS PREPARED BY K KOEZIG & KOEIG, INC. ENGINEERING ARCHITECTURE PLANNING LOS ANGELES CALIFORNIA 213/608-3102		ORANGE COUNTY HARBOR DISTRICT NEWPORT BEACH, CALIFORNIA 1201 BAYSIDE DRIVE 714/634-3300	
JOBS NO. 1-417 DATE 9-24-68		DANA POINT HARBOR DANA POINT, CALIFORNIA HEAVY CONSTRUCTION BRIDGE ARCHITECTURAL PLAN, ELEVATION AND MISCELLANEOUS DETAILS	
APPROVED <i>Robert L. Koedig</i>		DATE: OCTOBER 1968	SHEET 36 OF 50 D 10.5-1
		SCALE: AS SHOWN	