
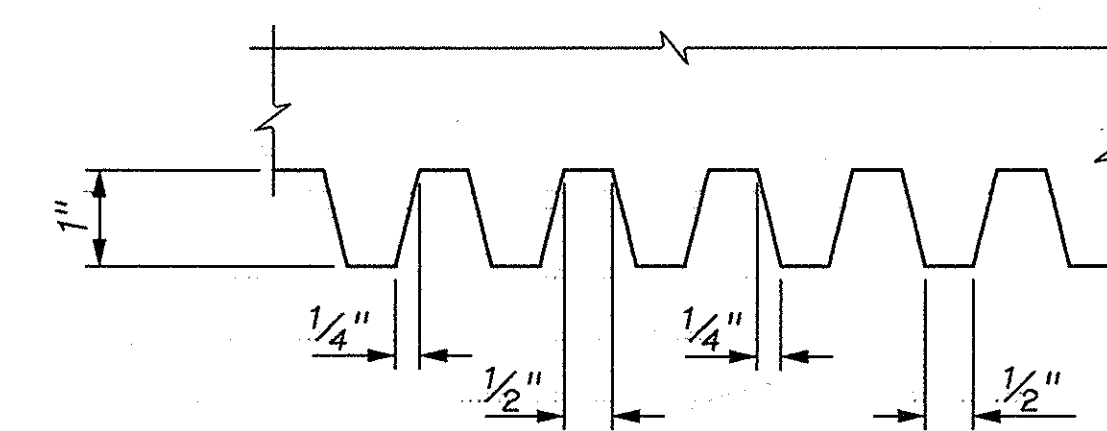


DIST	COUNTY	ROUTE	POST MILES TOTAL PROJECT	SHEET NO.	TOTAL SHEETS
12				3 R1	14


G.J. Nascimento
 REGISTERED CIVIL ENGINEER
 No. 44871
 Exp. 3/31/02
 CIVIL
 STATE OF CALIFORNIA

PLANS APPROVAL DATE
 LIM & NASCIMENTO ENGINEERING
 12-L Mauchly
 Irvine, California 92618

The State of California or its officers or agents shall not be responsible for the accuracy or completeness of electronic copies of this plan sheet.

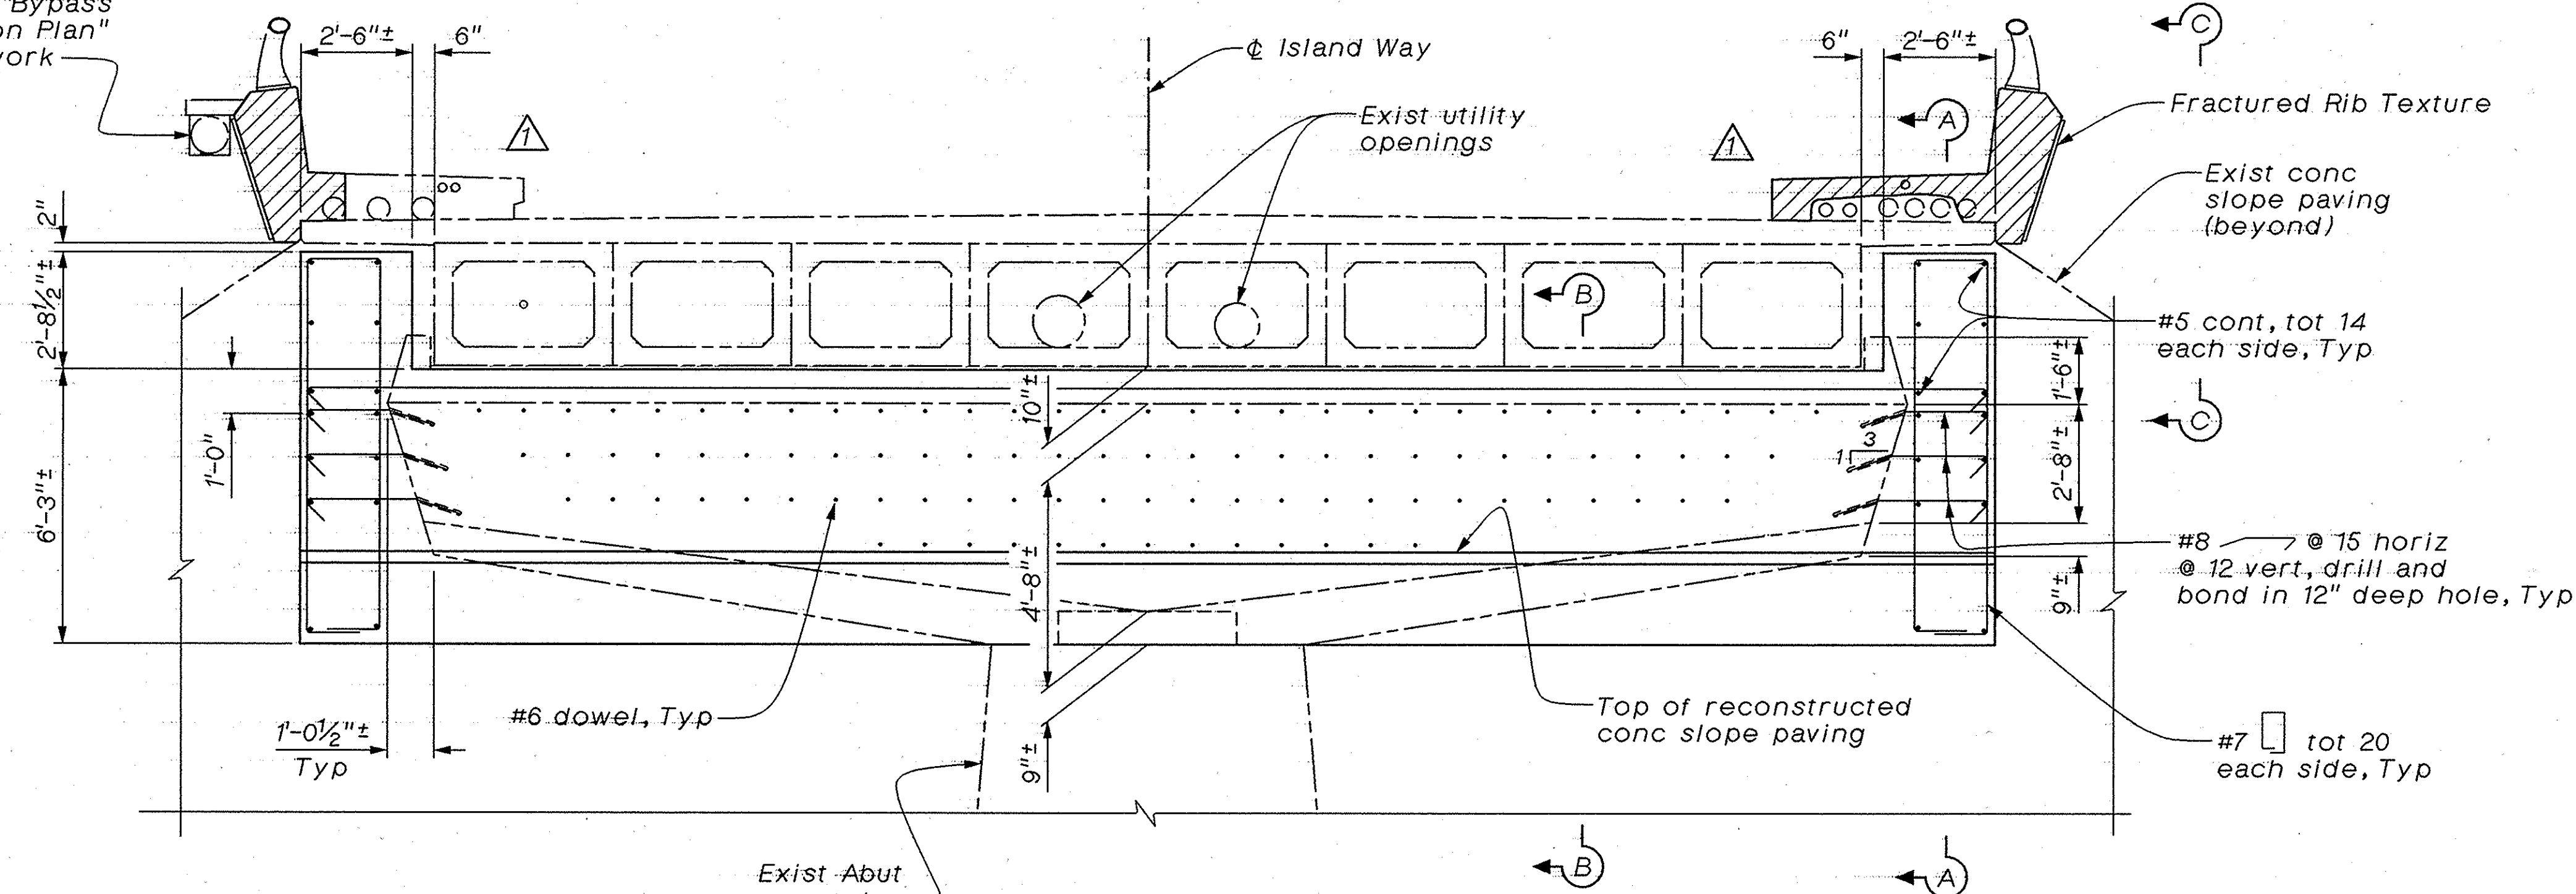

SECTION D-D
6" = 1'-0"

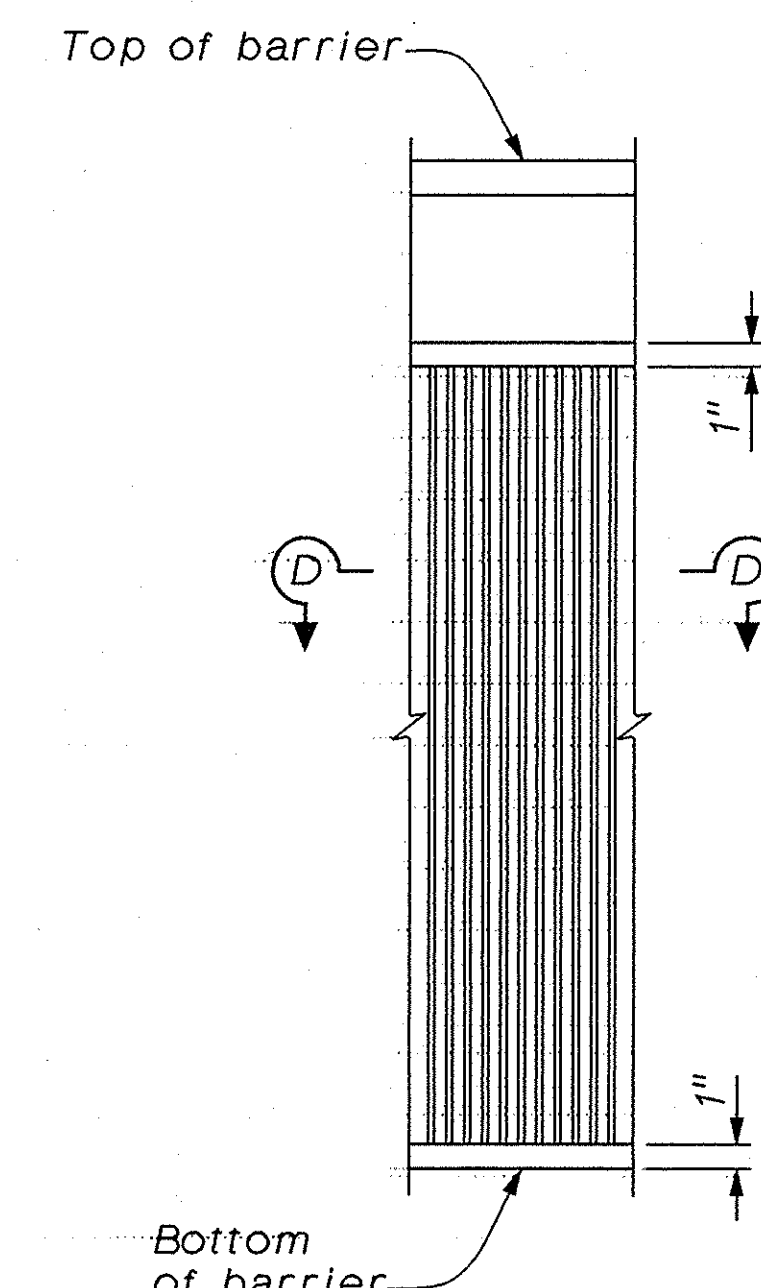


VIEW C-C
1 1/2" = 1'-0"

LEGEND

Limits of exist Sidewalk and Barrier removal and replacement

ELEVATION
3/8" = 1'-0"
(Looking North)

Note:
Utilities shown are to be protected in place unless otherwise indicated.
Not all utilities shown.

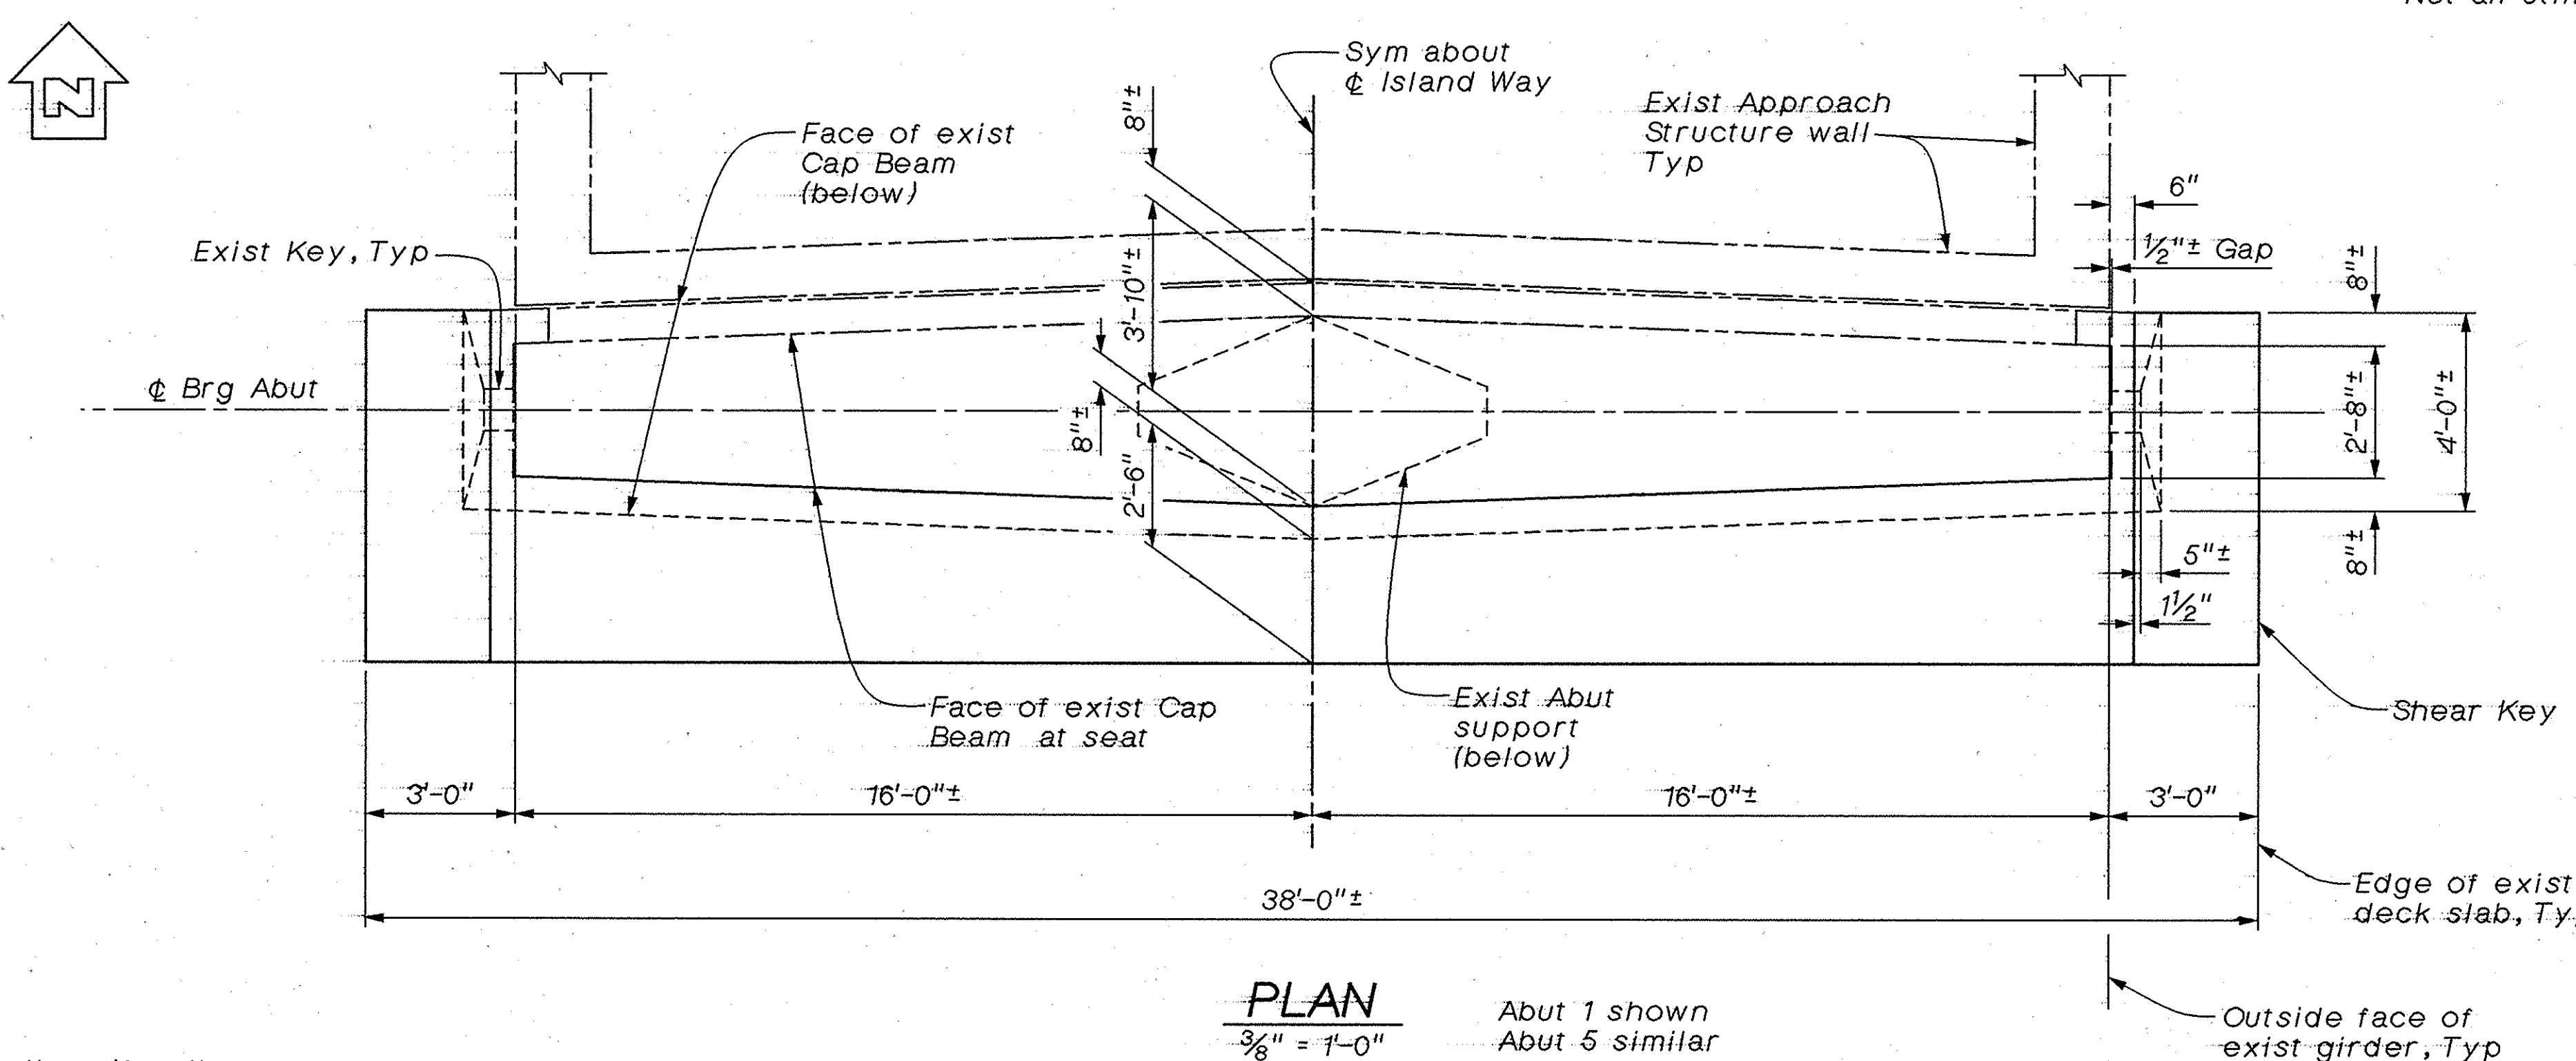

PLAN
3/8" = 1'-0"
Abut 1 shown
Abut 5 similar

Note: Superstructure not shown

AS BUILT

CORRECTIONS BY G. Zaun / WPN
CONTRACT NO. 59Y021
DATE 02-02 / 03-02

NO AS BUILT CHANGES

Note:
1. For "Section A-A" & "Section B-B" see "Abutment Retrofit Details No. 2" sheet.

REV	DATE	DESCRIPTION	BY	CHKD
1	11/17/00	Barrier Modification	RA	GJN

Note:
The Contractor shall verify all controlling field dimensions before ordering or fabricating any material.

SHAWN SUN DESIGN OVERSIGHT 11/20/00 SIGN OFF DATE		DESIGN BY G.J.N./H. LAM DETAILS BY H. LAM QUANTITIES BY H. LAM	CHECKED M. ZAHEDI/A. HOU CHECKED J. LU CHECKED A. TRUONG	PREPARED FOR THE COUNTY OF ORANGE	G.J. NASCIMENTO PROJECT ENGINEER	BRIDGE NO. 55C-0561 POST MILE	EARTHQUAKE RETROFIT DANA POINT HARBOR BRIDGE ABUTMENT RETROFIT DETAILS No. 1	
ORIGINAL SCALE IN INCHES FOR REDUCED PLANS 0 1 2 3						CU 12 152 EA L02406	DISREGARD PRINTS BEARING EARLIER REVISION DATES 11/17/00	
						SHEET 2 OF 9		