


|      |        |       |                             |              |                 |
|------|--------|-------|-----------------------------|--------------|-----------------|
| DIST | COUNTY | ROUTE | POST MILES<br>TOTAL PROJECT | SHEET<br>NO. | TOTAL<br>SHEETS |
| 12   |        |       |                             | 4            | 14              |

  
REGISTERED CIVIL ENGINEER

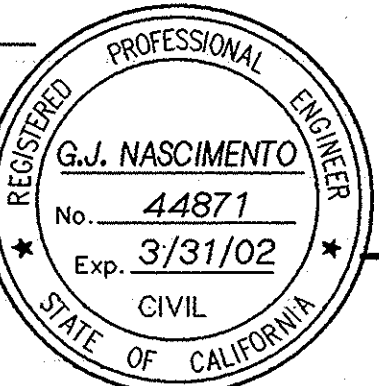

PLANS APPROVAL DATE \_\_\_\_\_

LIM & NASCIMENTO ENGINEERING  
12-L. Mauchly  
Irvine, California 92618


The State of California or its officers or agents shall not be responsible for the accuracy or completeness of electronic copies of this plan sheet.

## AS BUILT

CORRECTIONS BY G. Zaun / WPN

CONTRACT NO. 59Y021


DATE 02-02 / 03-02

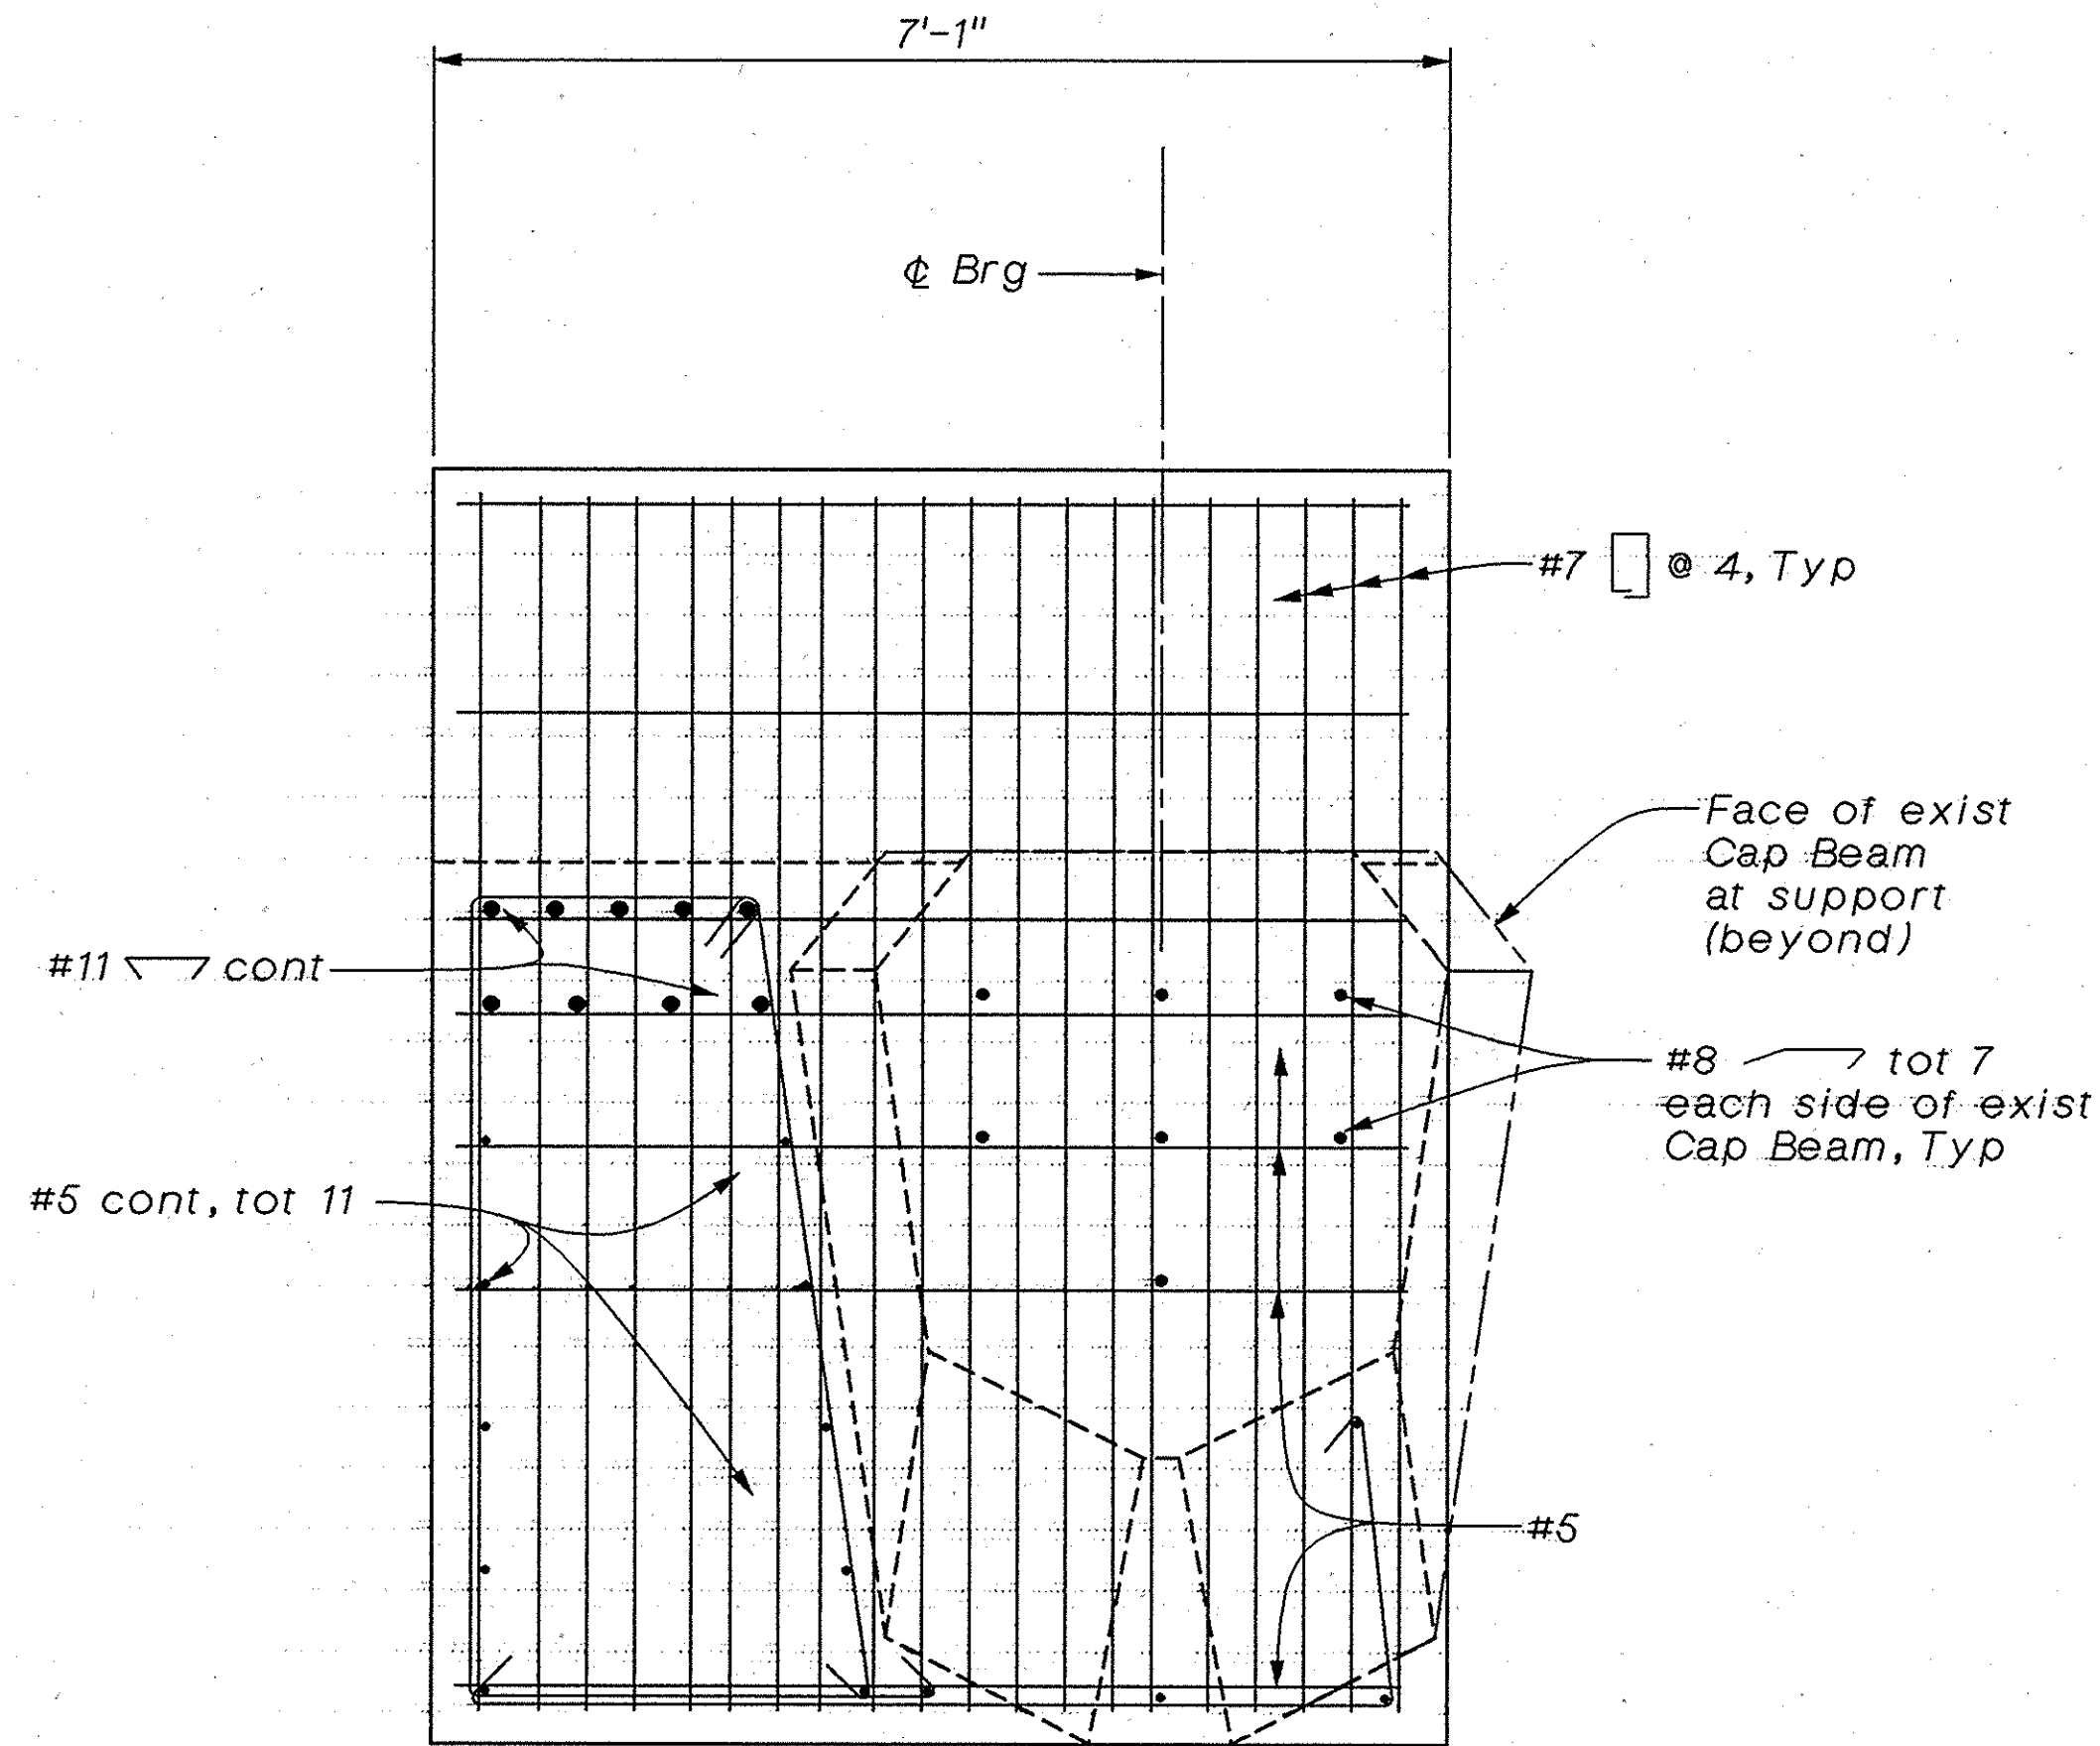

SECTION A-A

$\frac{3}{4}'' = 1'-0''$

Note: Exist Barrier and deck not shown.

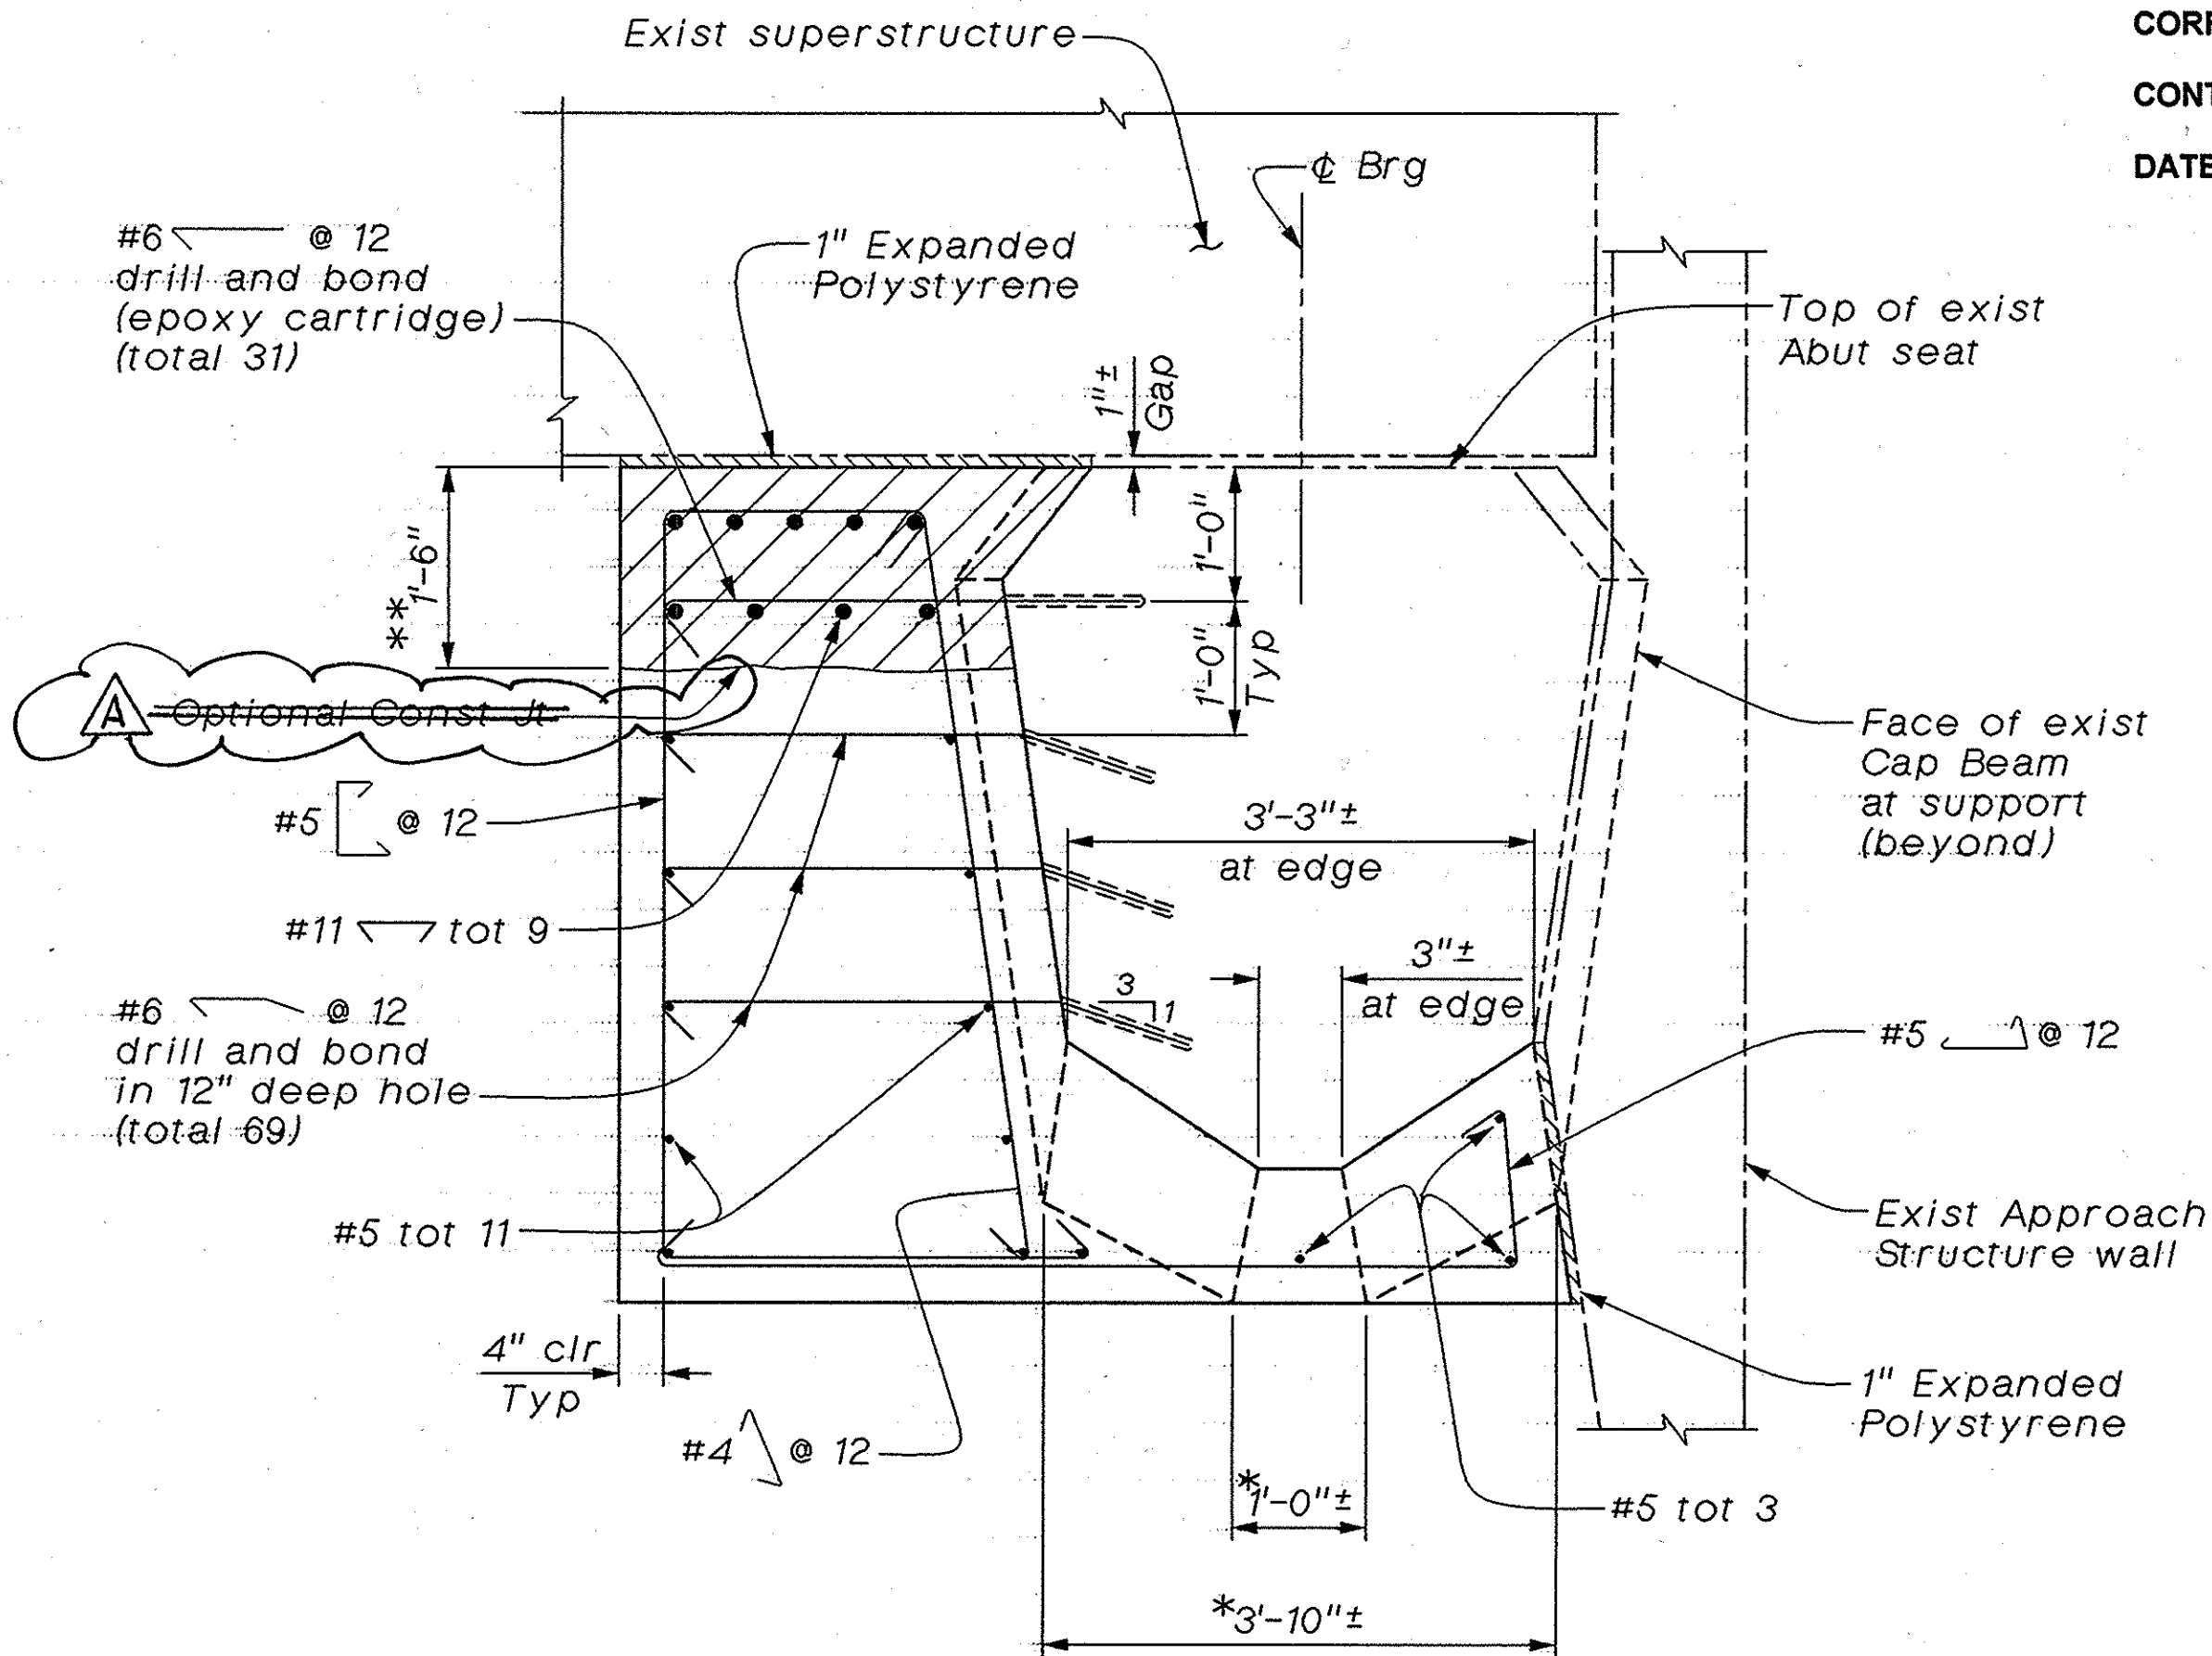

SECTION B-B

$\frac{3}{4}'' = 1'-0''$

\* At existing support (beyond)

\*\* Optional injectable concrete

Note:  
The Contractor shall verify all  
controlling field dimensions before  
ordering or fabricating any material.

|                                                            |  |                                                                      |                                                |                                         |                                     |                                                    |                                                                                    |                       |
|------------------------------------------------------------|--|----------------------------------------------------------------------|------------------------------------------------|-----------------------------------------|-------------------------------------|----------------------------------------------------|------------------------------------------------------------------------------------|-----------------------|
| SHAWN SUN<br>DESIGN OVERSIGHT<br>11/20/00<br>SIGN OFF DATE |  | DESIGN BY G.J.N./H. LAM<br>DETAILS BY H. LAM<br>QUANTITIES BY H. LAM | CHECKED M. ZAHEDI/A. HOU<br>J. LU<br>A. TRUONG | PREPARED FOR THE<br>COUNTY OF<br>ORANGE | G.J. NASCIMENTO<br>PROJECT ENGINEER | BRIDGE NO.<br>55C-0561<br>POST MILE                | EARTHQUAKE RETROFIT<br>DANA POINT HARBOR BRIDGE<br>ABUTMENT RETROFIT DETAILS No. 2 |                       |
| ORIGINAL SCALE IN INCHES<br>FOR REDUCED PLANS              |  |                                                                      |                                                |                                         | CU 12 152<br>EA L02106              | DISREGARD PRINTS BEARING<br>EARLIER REVISION DATES | REVISION DATES (PRELIMINARY STAGE ONLY)<br>11/17/00<br>3/02 AS BUILT               | SHEET<br>3<br>OF<br>9 |