

DIST	COUNTY	ROUTE	POST MILES TOTAL PROJECT	SHEET NO.	TOTAL SHEETS
12				6 S1	14

REGISTERED CIVIL ENGINEER
 G.J. NASCIMENTO
 No. 44871
 Exp. 3/31/02
 CIVIL
 STATE OF CALIFORNIA

PLANS APPROVAL DATE
 LIM & NASCIMENTO ENGINEERING
 12-L Mauchly
 Irvine, California 92618


The State of California or its officers or agents shall not be responsible for the accuracy or completeness of electronic copies of this plan sheet.

AS BUILT

CORRECTIONS BY G. Zaun / WPN

CONTRACT NO. 59Y021


DATE 02-02 / 03-02

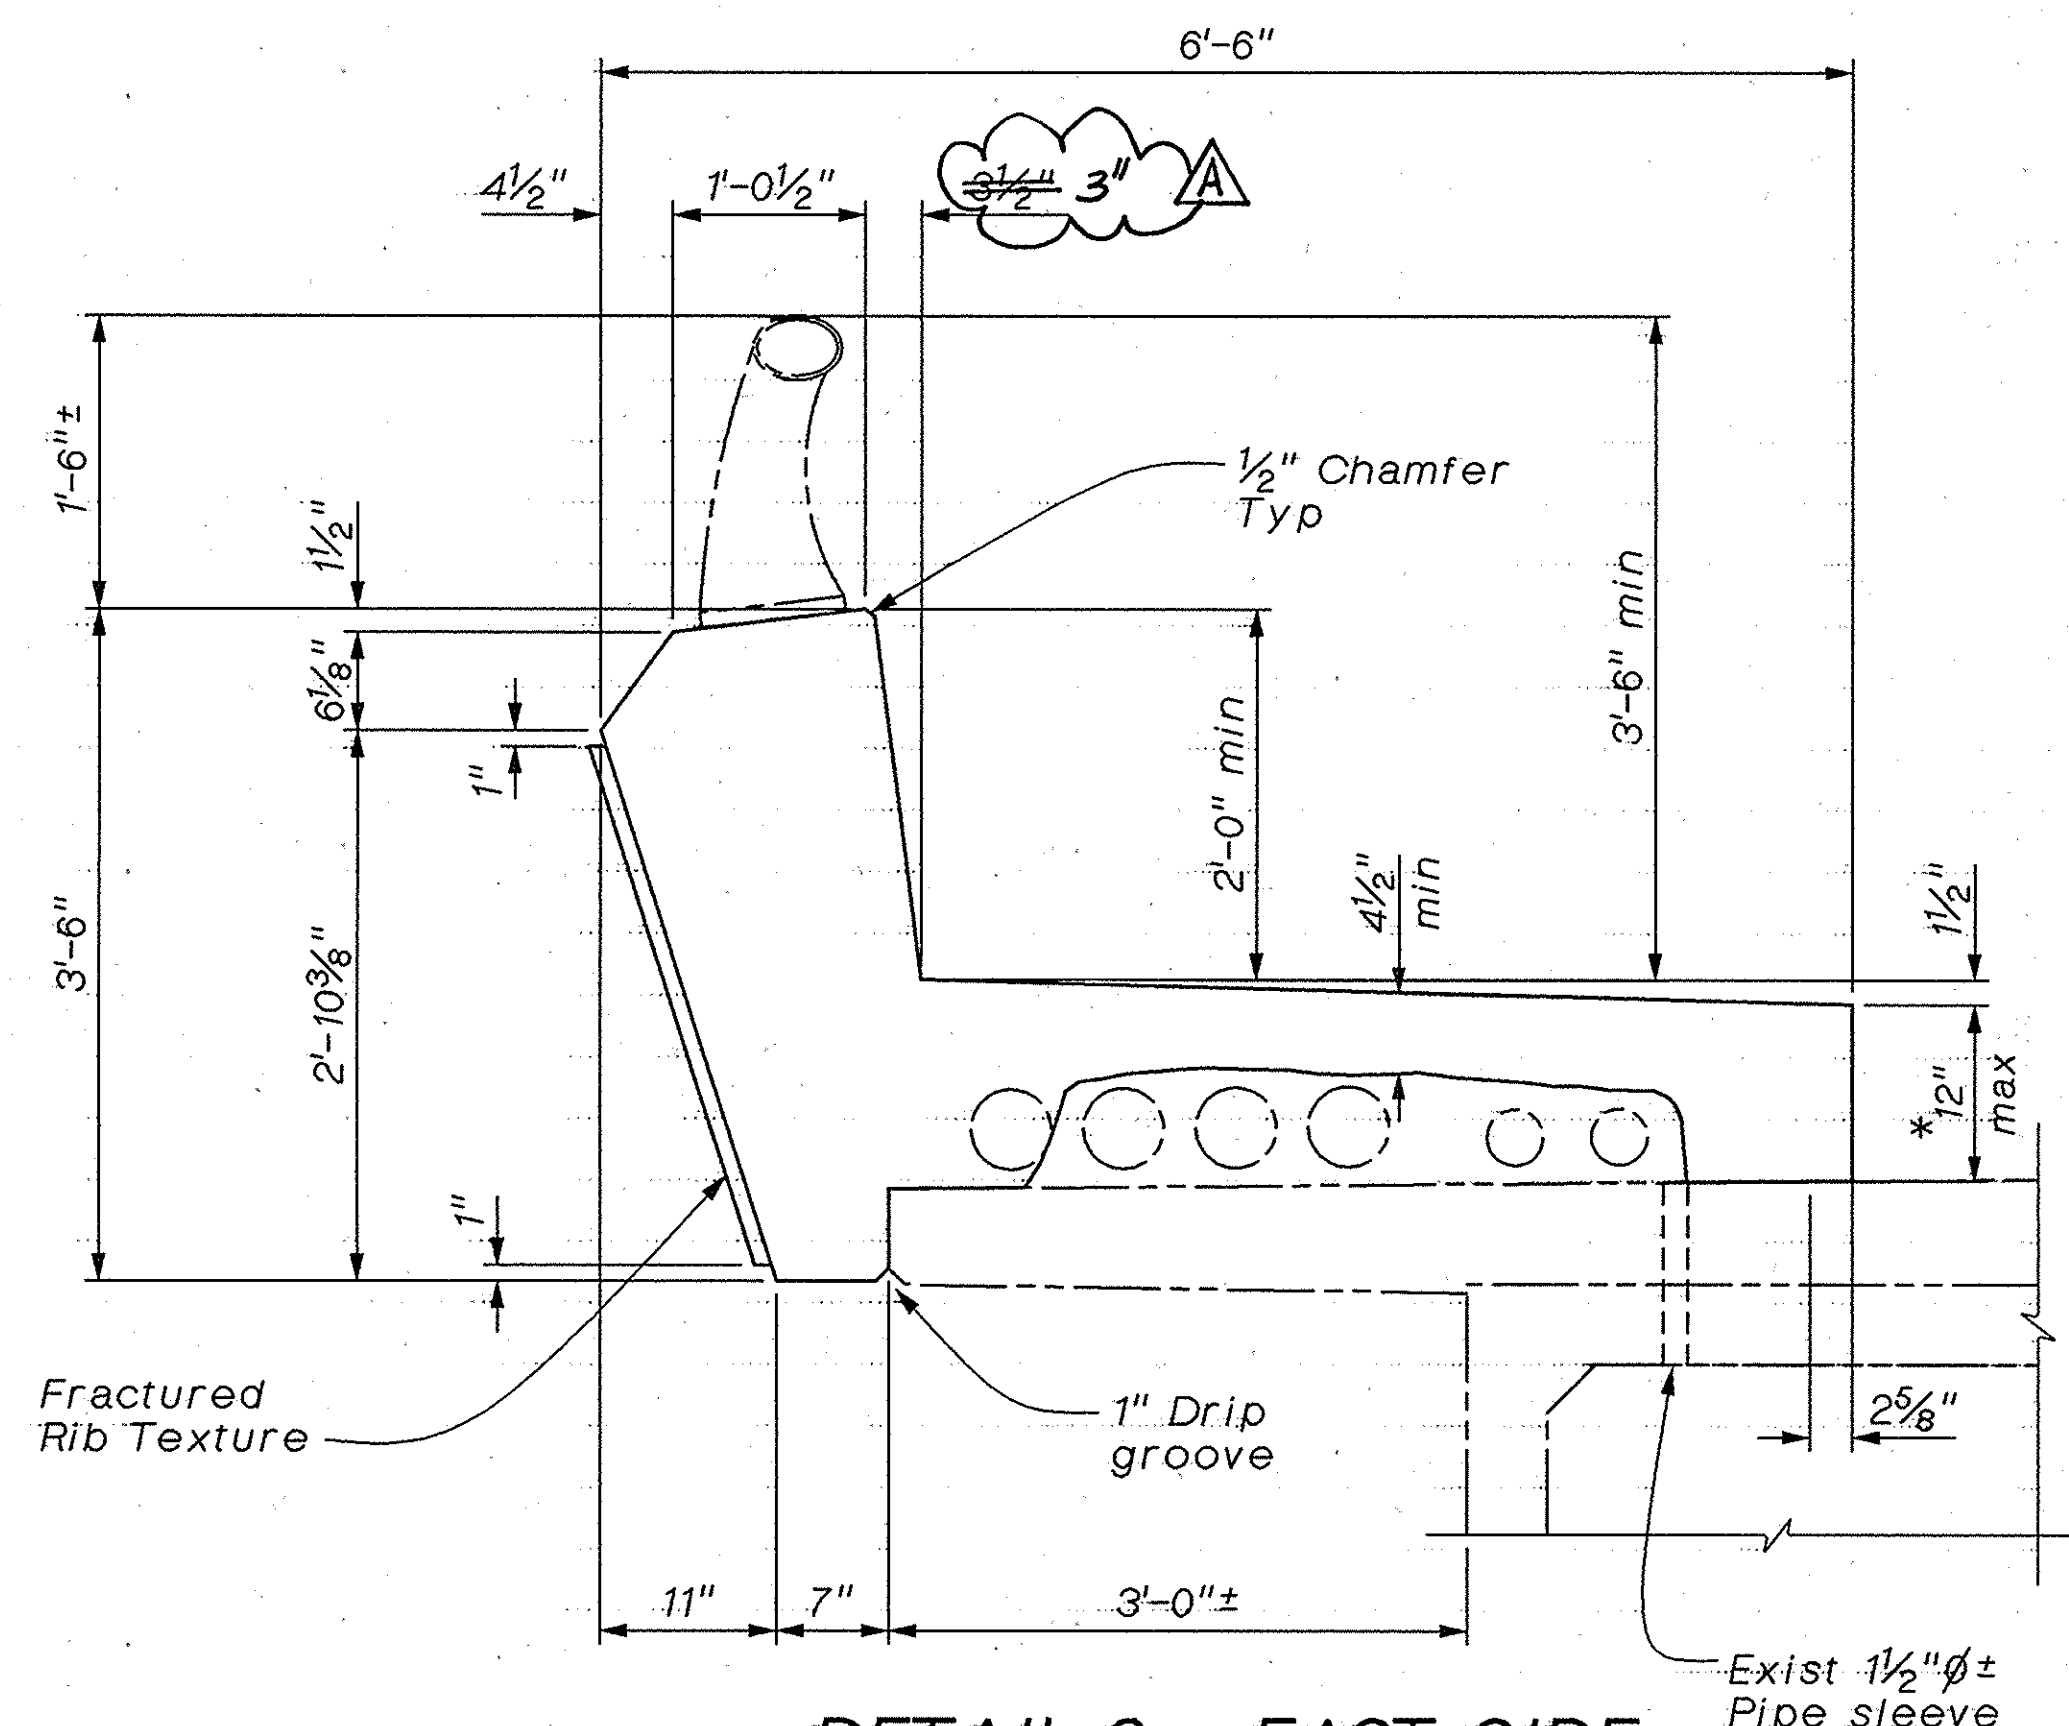

DETAIL 2 - EAST SIDE

1" = 1'-0"


* Adjust sidewalk before and after beginning of bridge as directed by the Engineer.

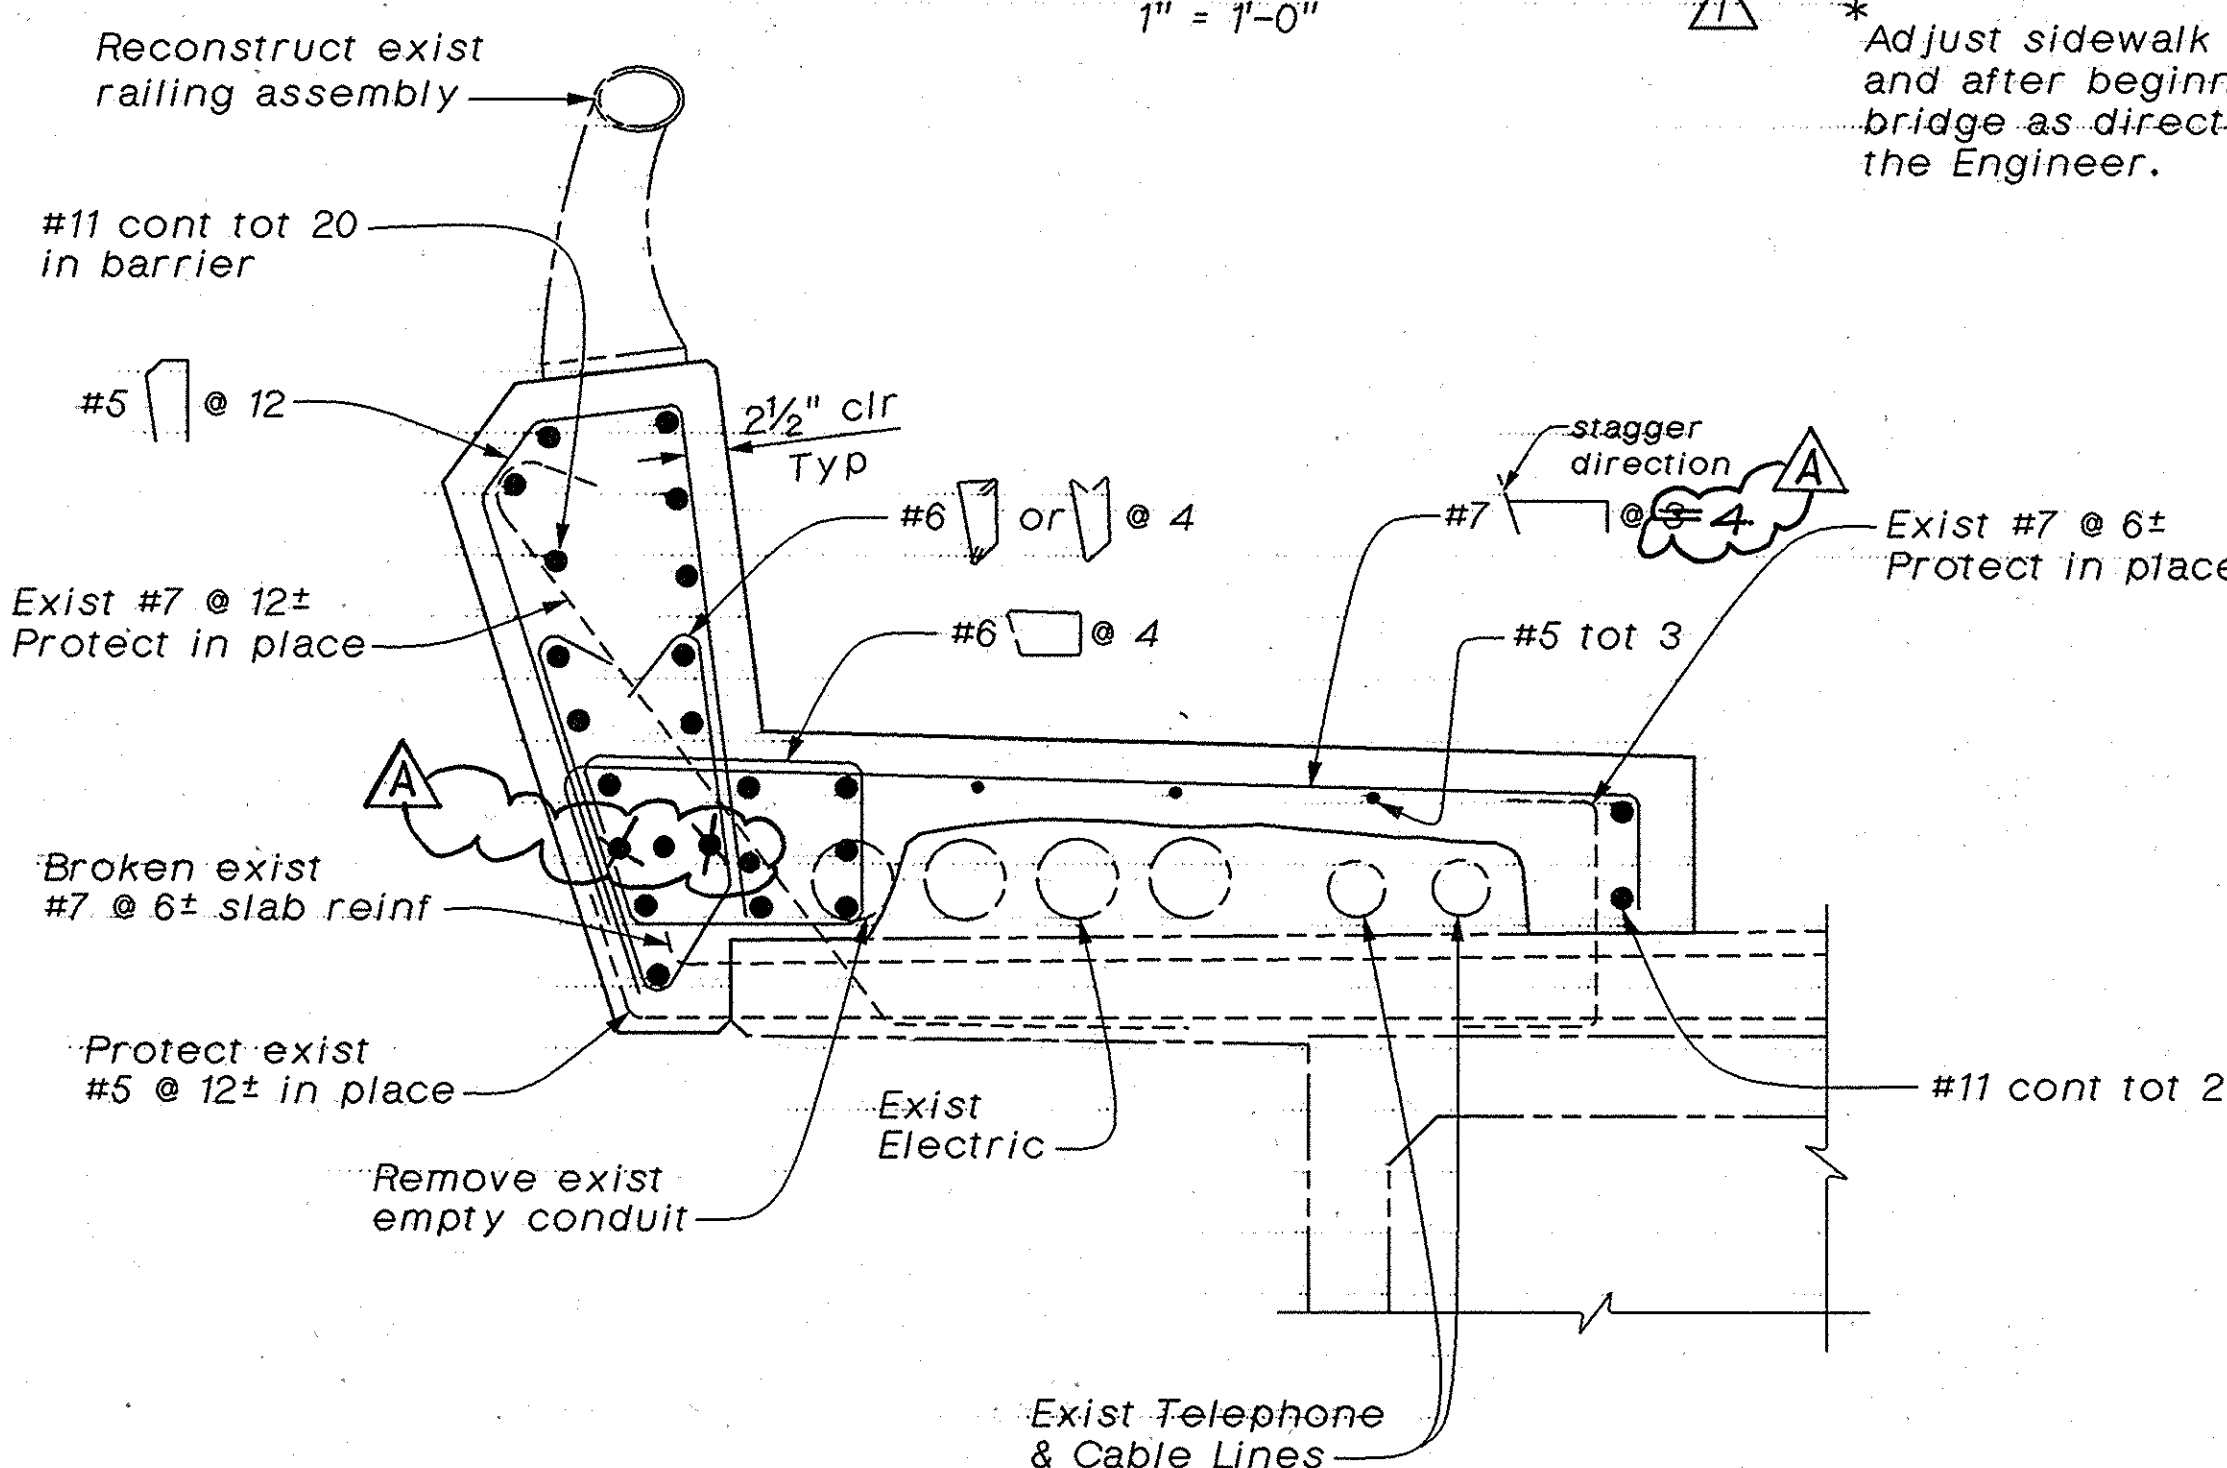

BARRIER SECTION - EAST SIDE


1" = 1'-0"

Looking South

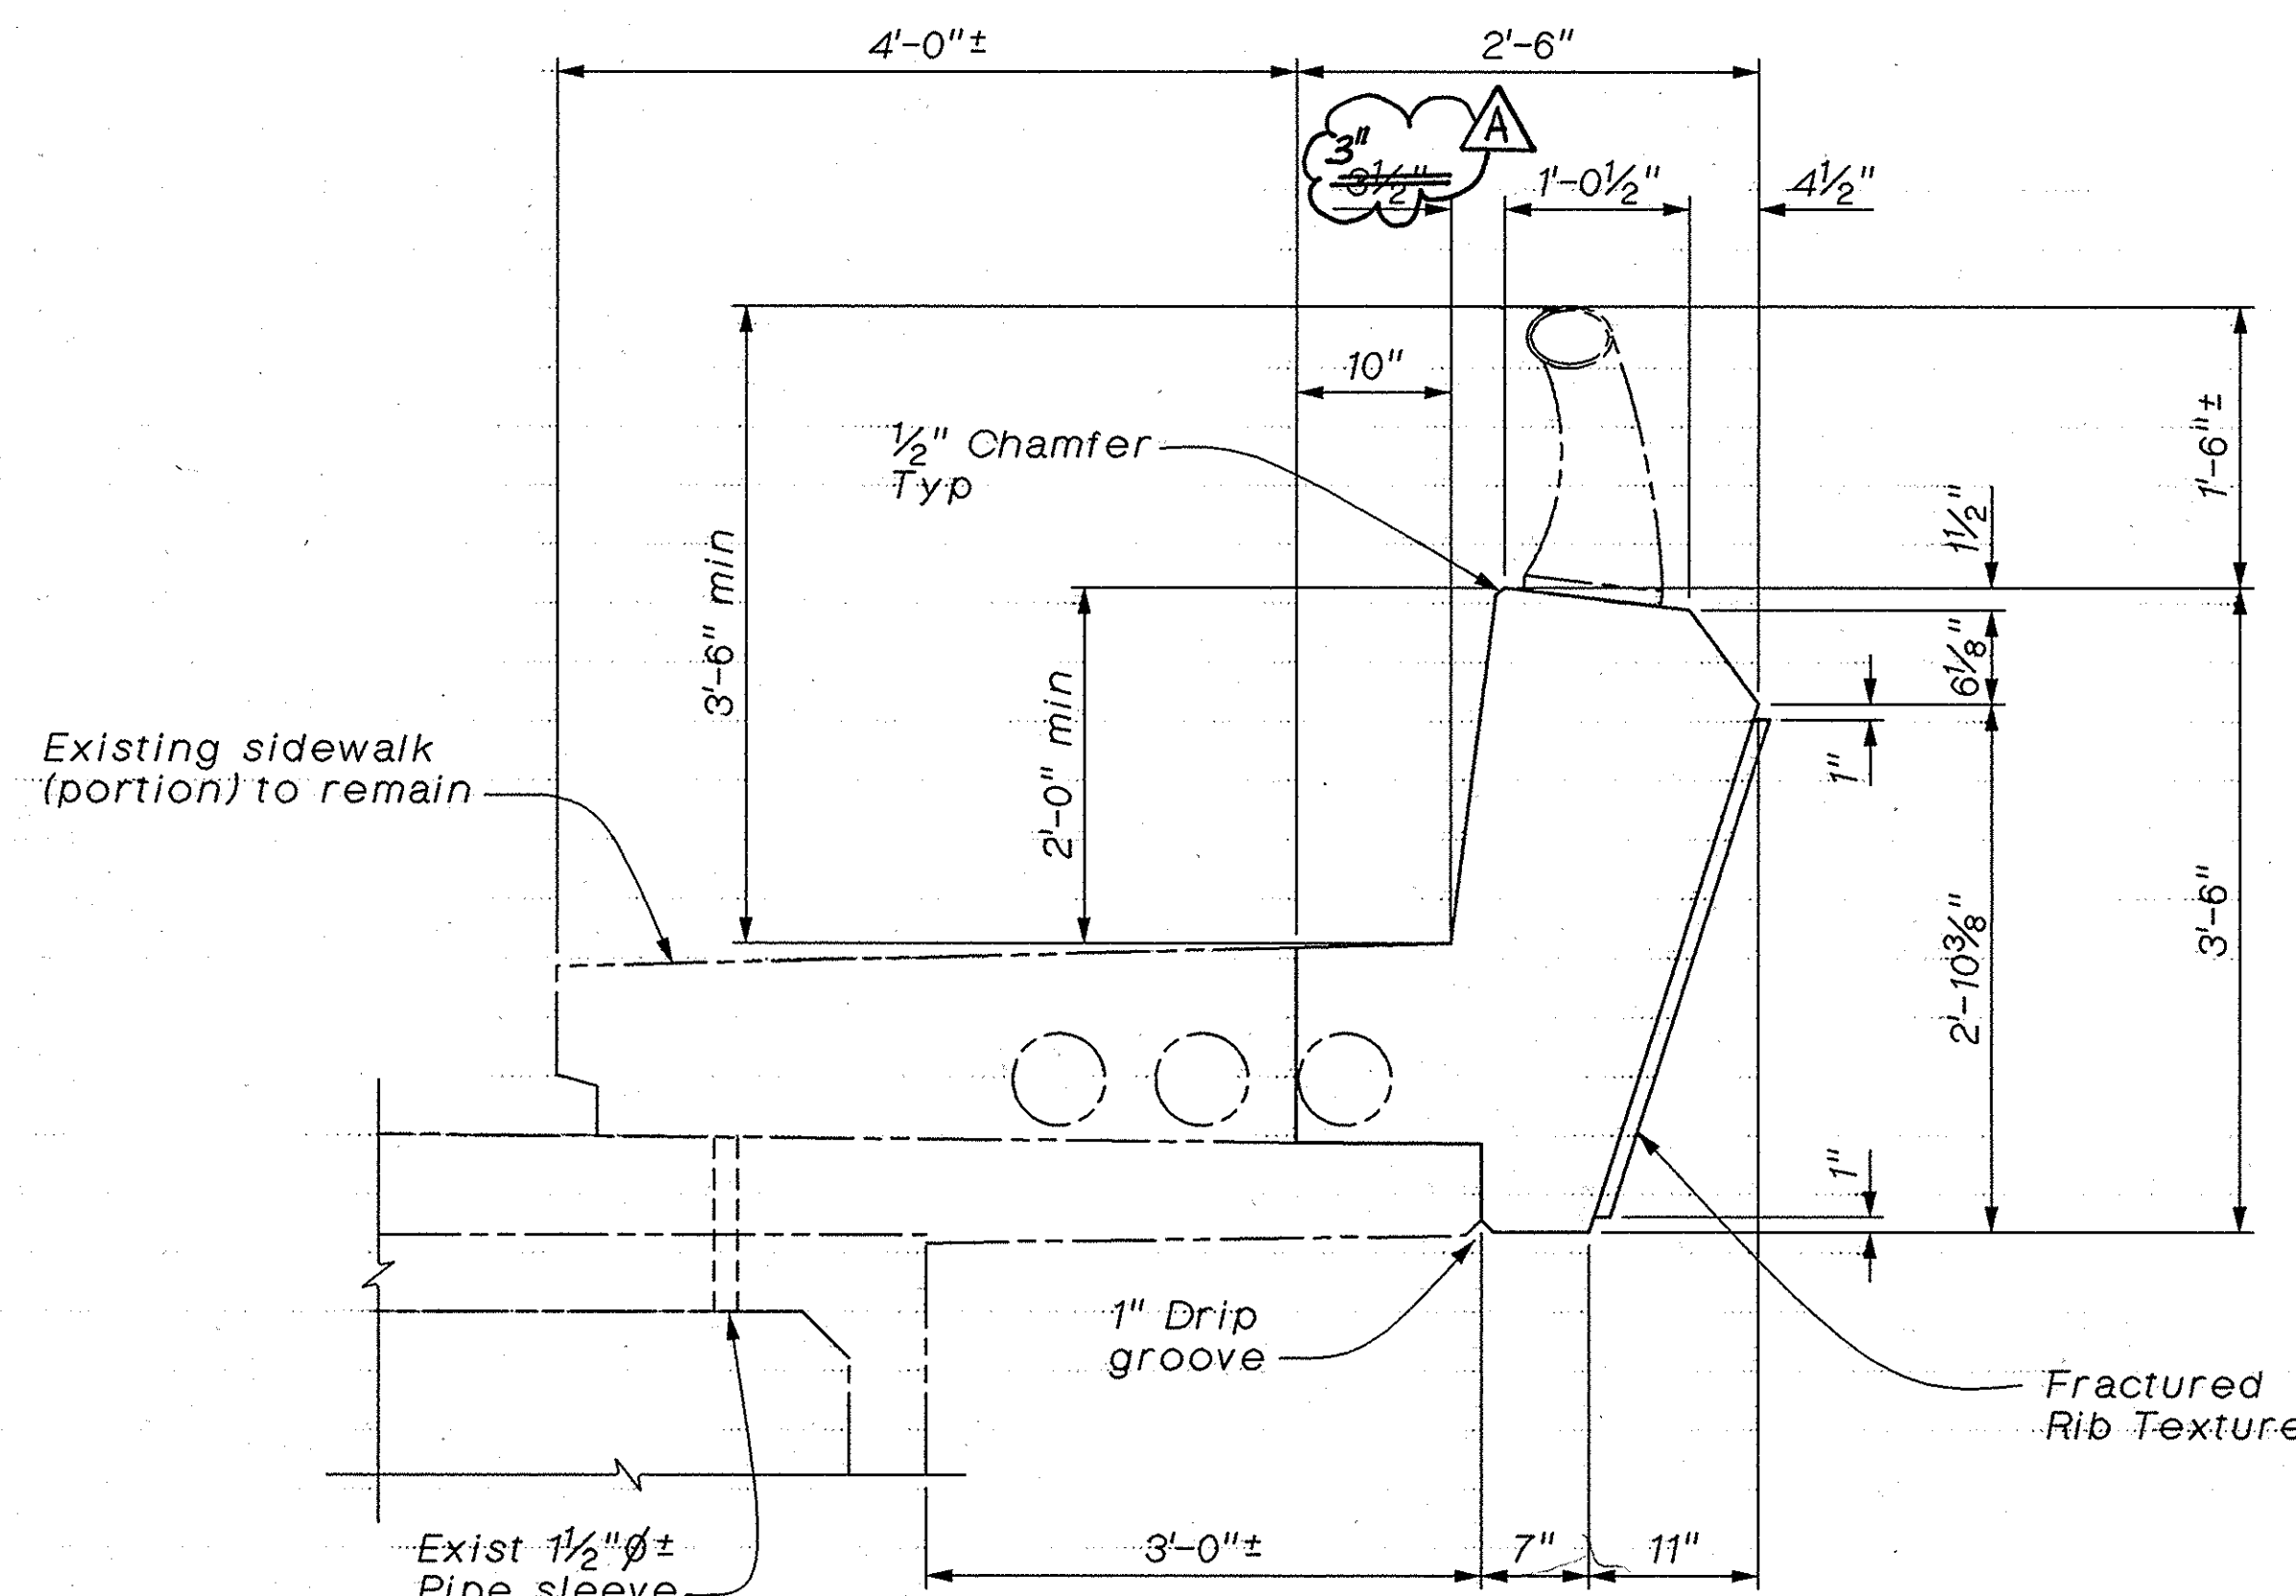

DETAIL 2 - WEST SIDE

1" = 1'-0"

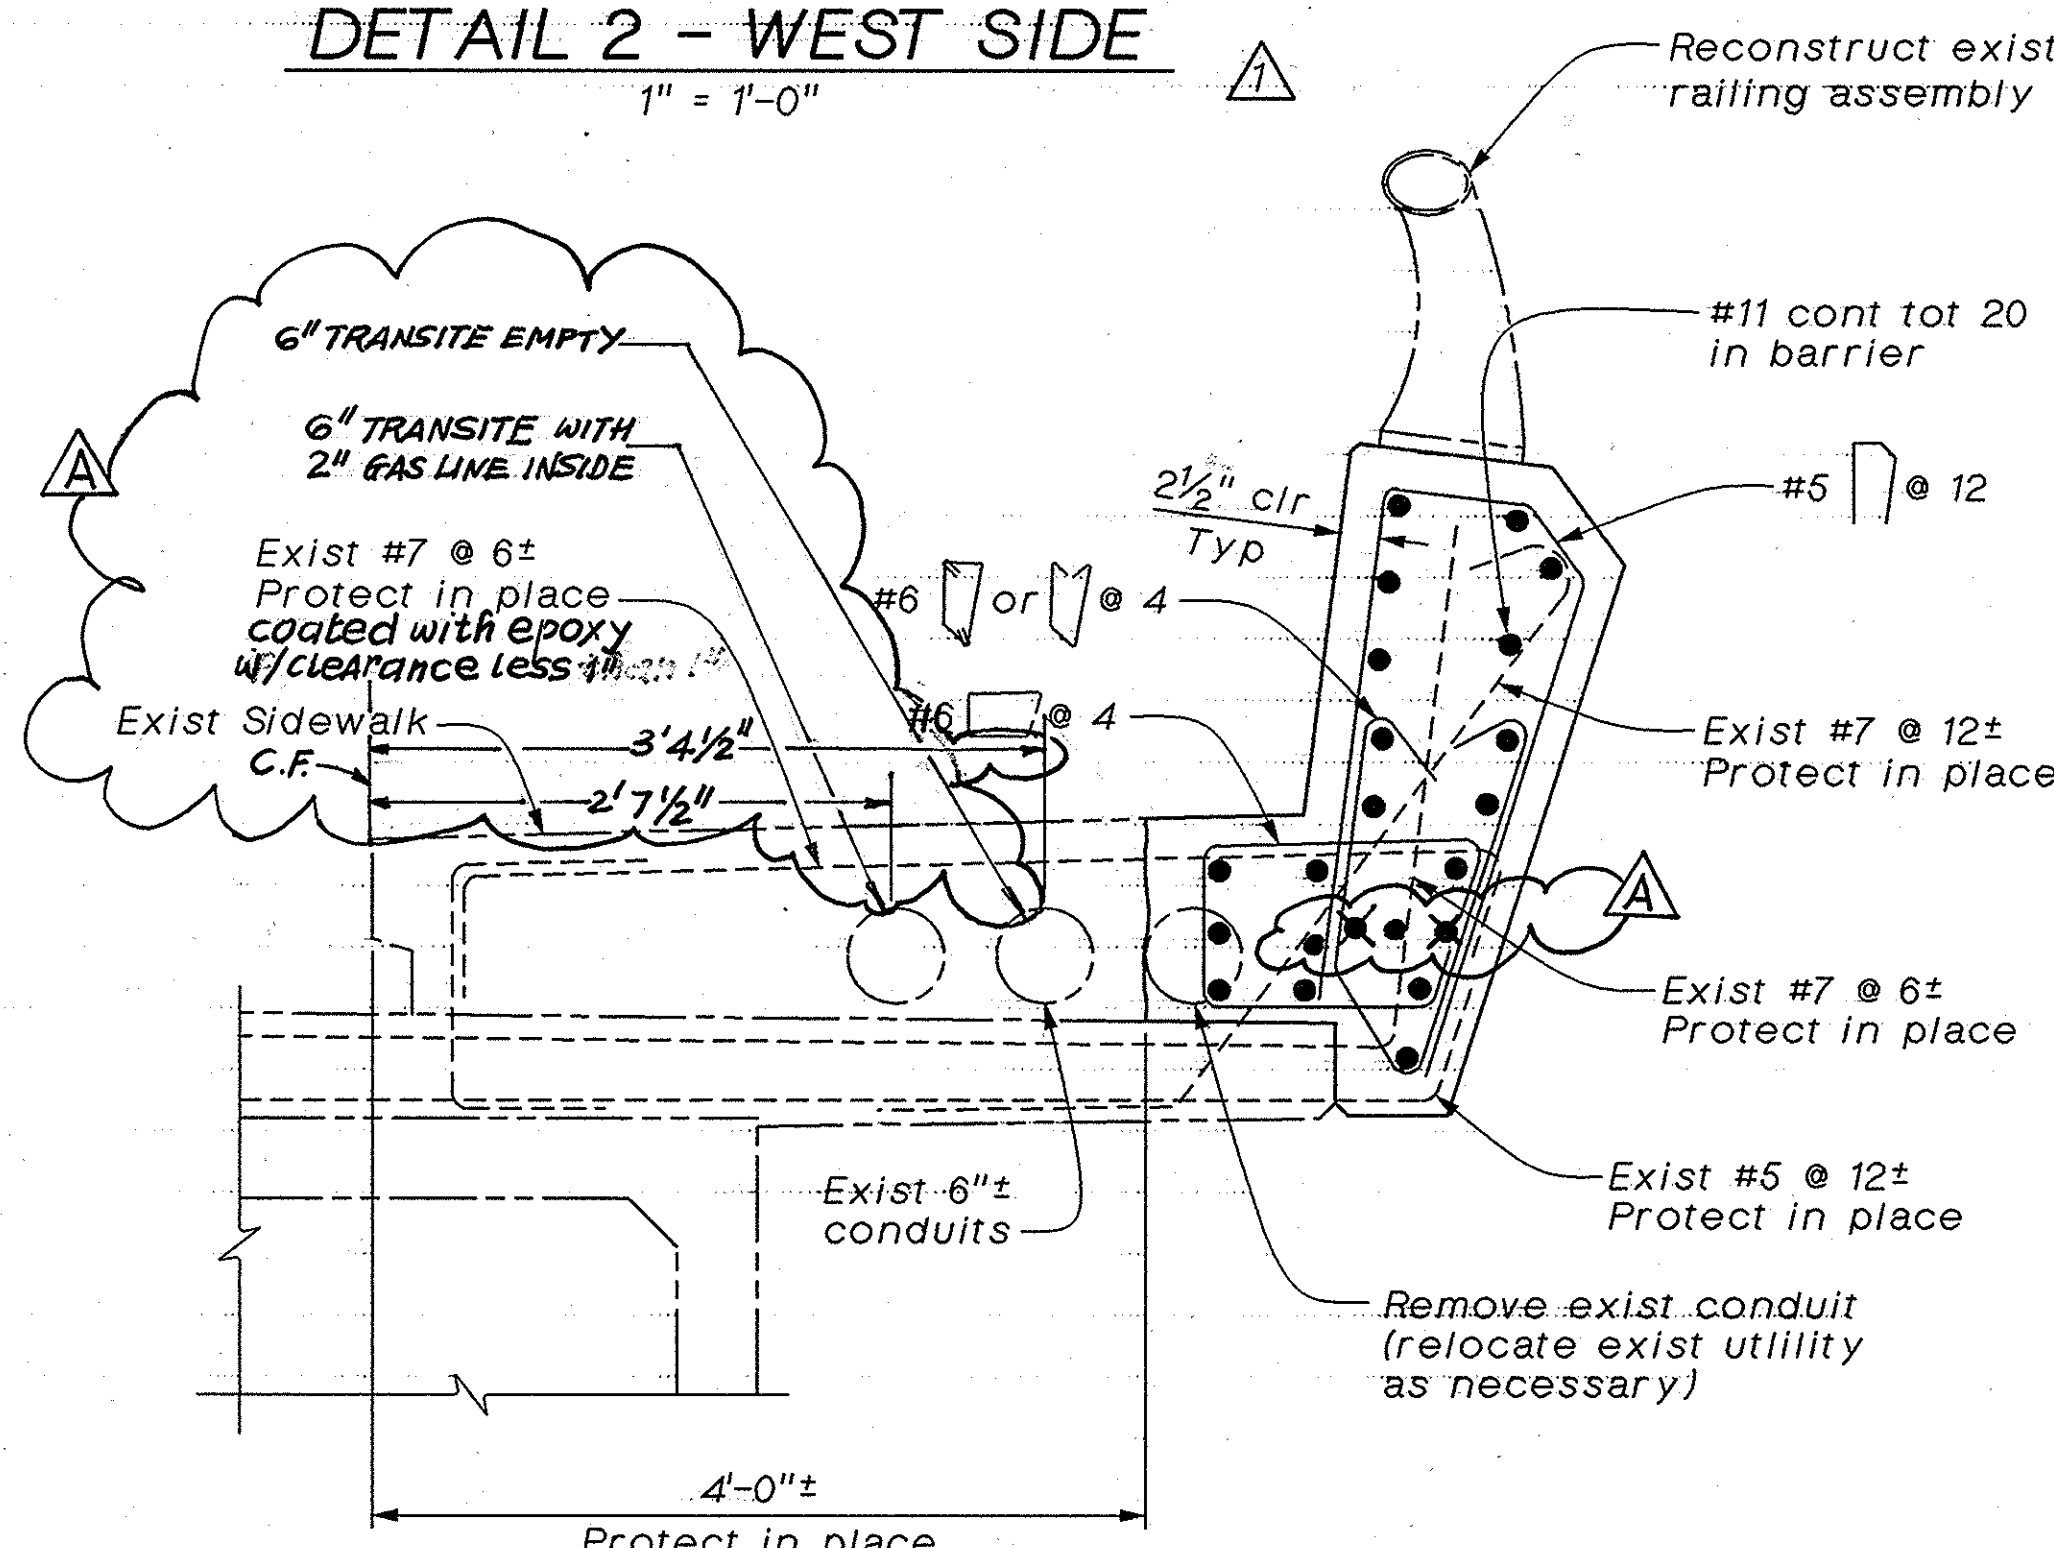

BARRIER SECTION - WEST SIDE

1" = 1'-0"

Looking South

3/02	AS BUILT		
11/17/00	Barrier Modification	RA	GJN
REV	DATE	DESCRIPTION	BY

SHAWN SUN DESIGN OVERSIGHT 11/20/00 SIGN OFF DATE	DESIGN BY G.J.N./H. LAM DETAILS BY R. ANDRASEK QUANTITIES BY H. LAM	CHECKED M. ZAHEDI/A. HOU CHECKED J. LU CHECKED A. TRUONG	PREPARED FOR THE COUNTY OF ORANGE	G.J. NASCIMENTO PROJECT ENGINEER	BRIDGE NO. 55C-0561 POST MILE	EARTHQUAKE RETROFIT DANA POINT HARBOR BRIDGE REVISED BARRIER DETAILS
ORIGINAL SCALE IN INCHES FOR REDUCED PLANS				CU 12 152 EA L02106	DISREGARD PRINTS BEARING EARLIER REVISION DATES	REVISION DATES (PRELIMINARY STAGE ONLY) 11/17/00