



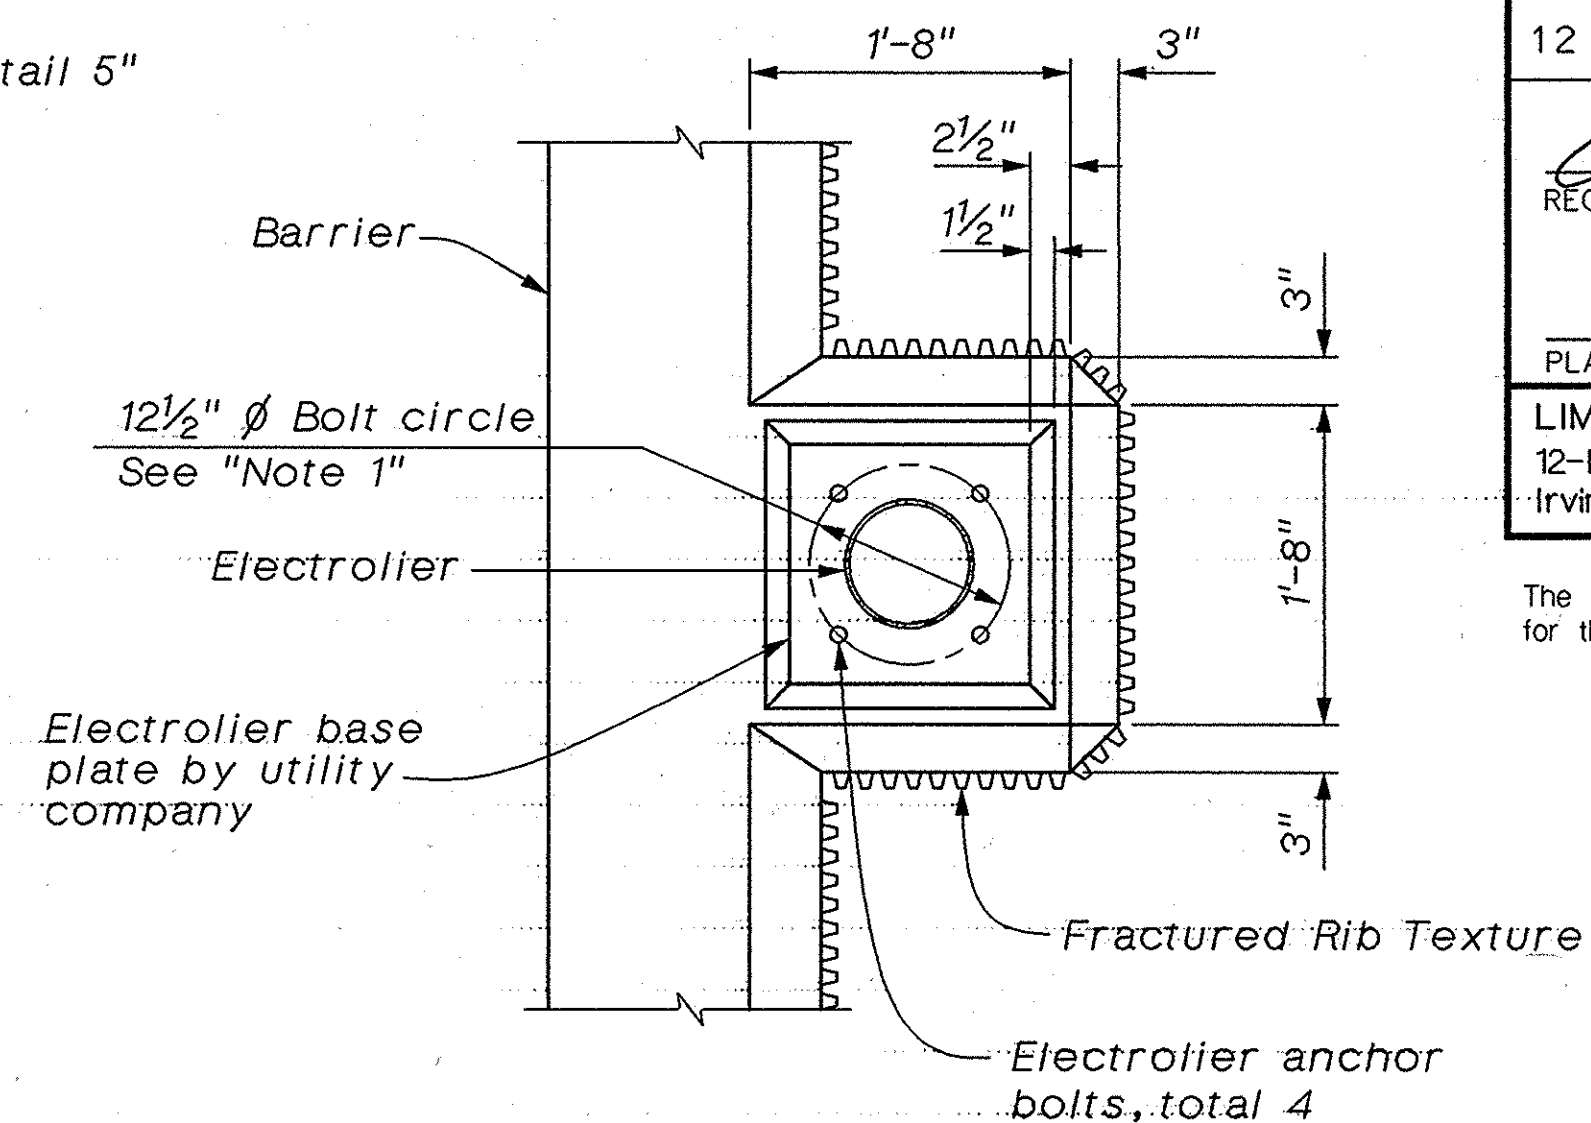


ELEVATION - PIER 3
 $\frac{3}{8}'' = 1'-0''$
 (Looking North)

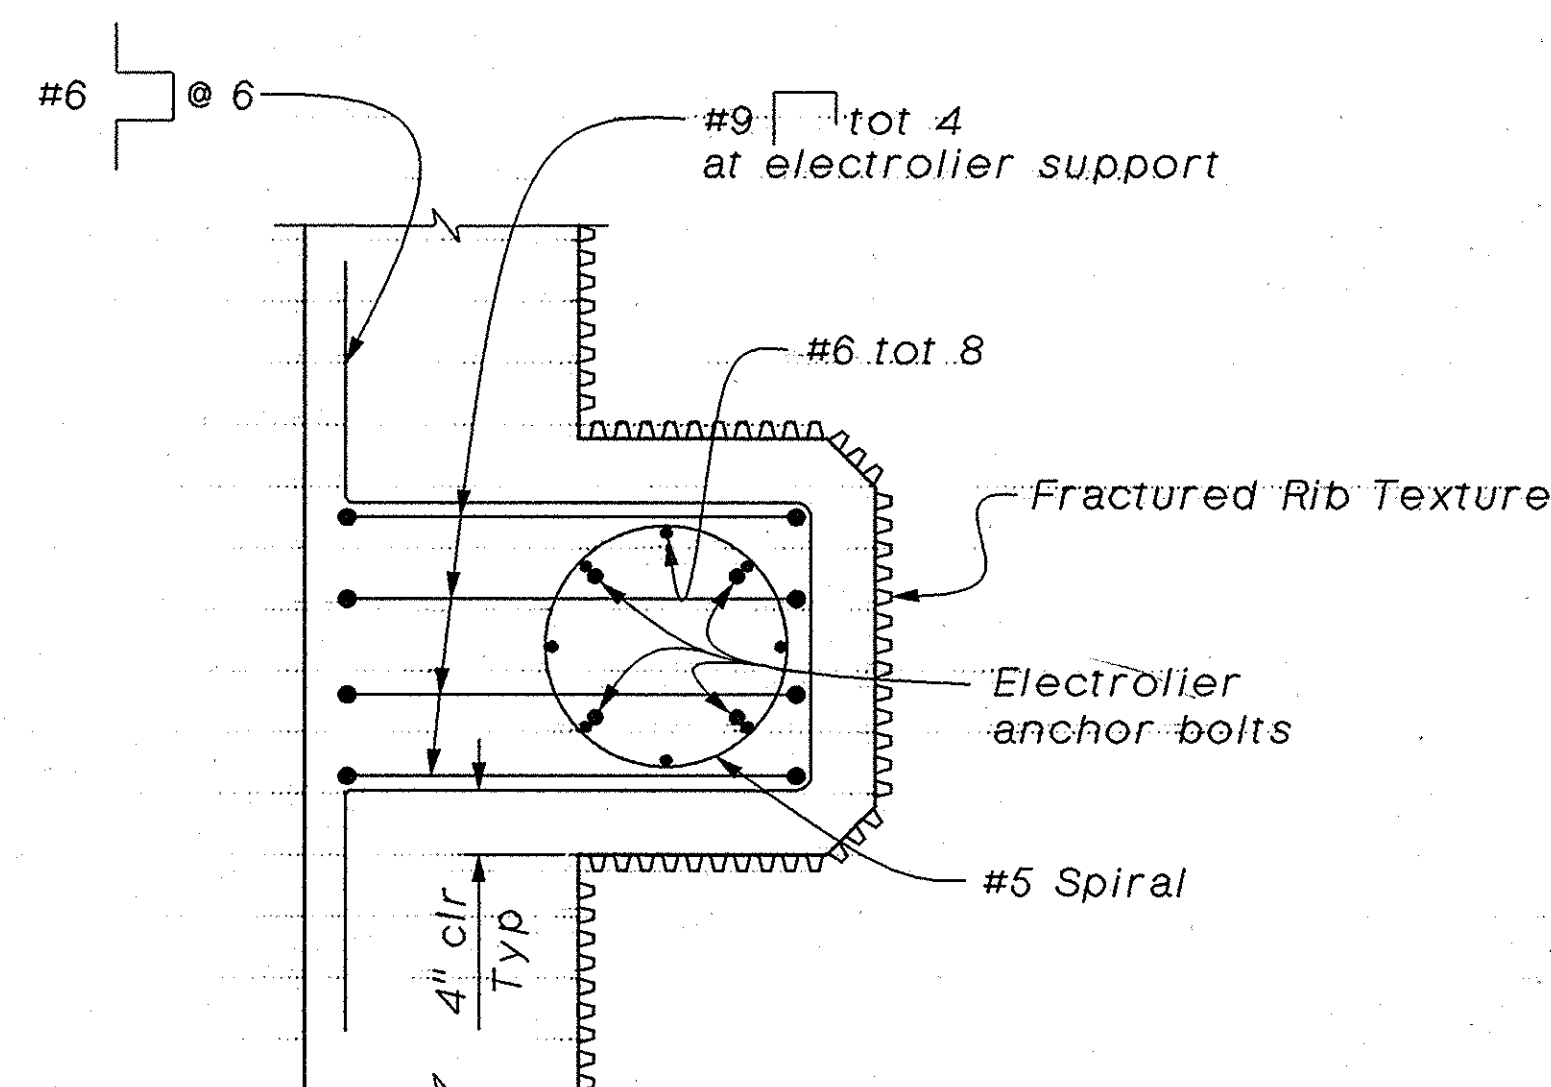

SECTION J-J
1" = 1'-0"

Note:
Barrier reinforcement not shown

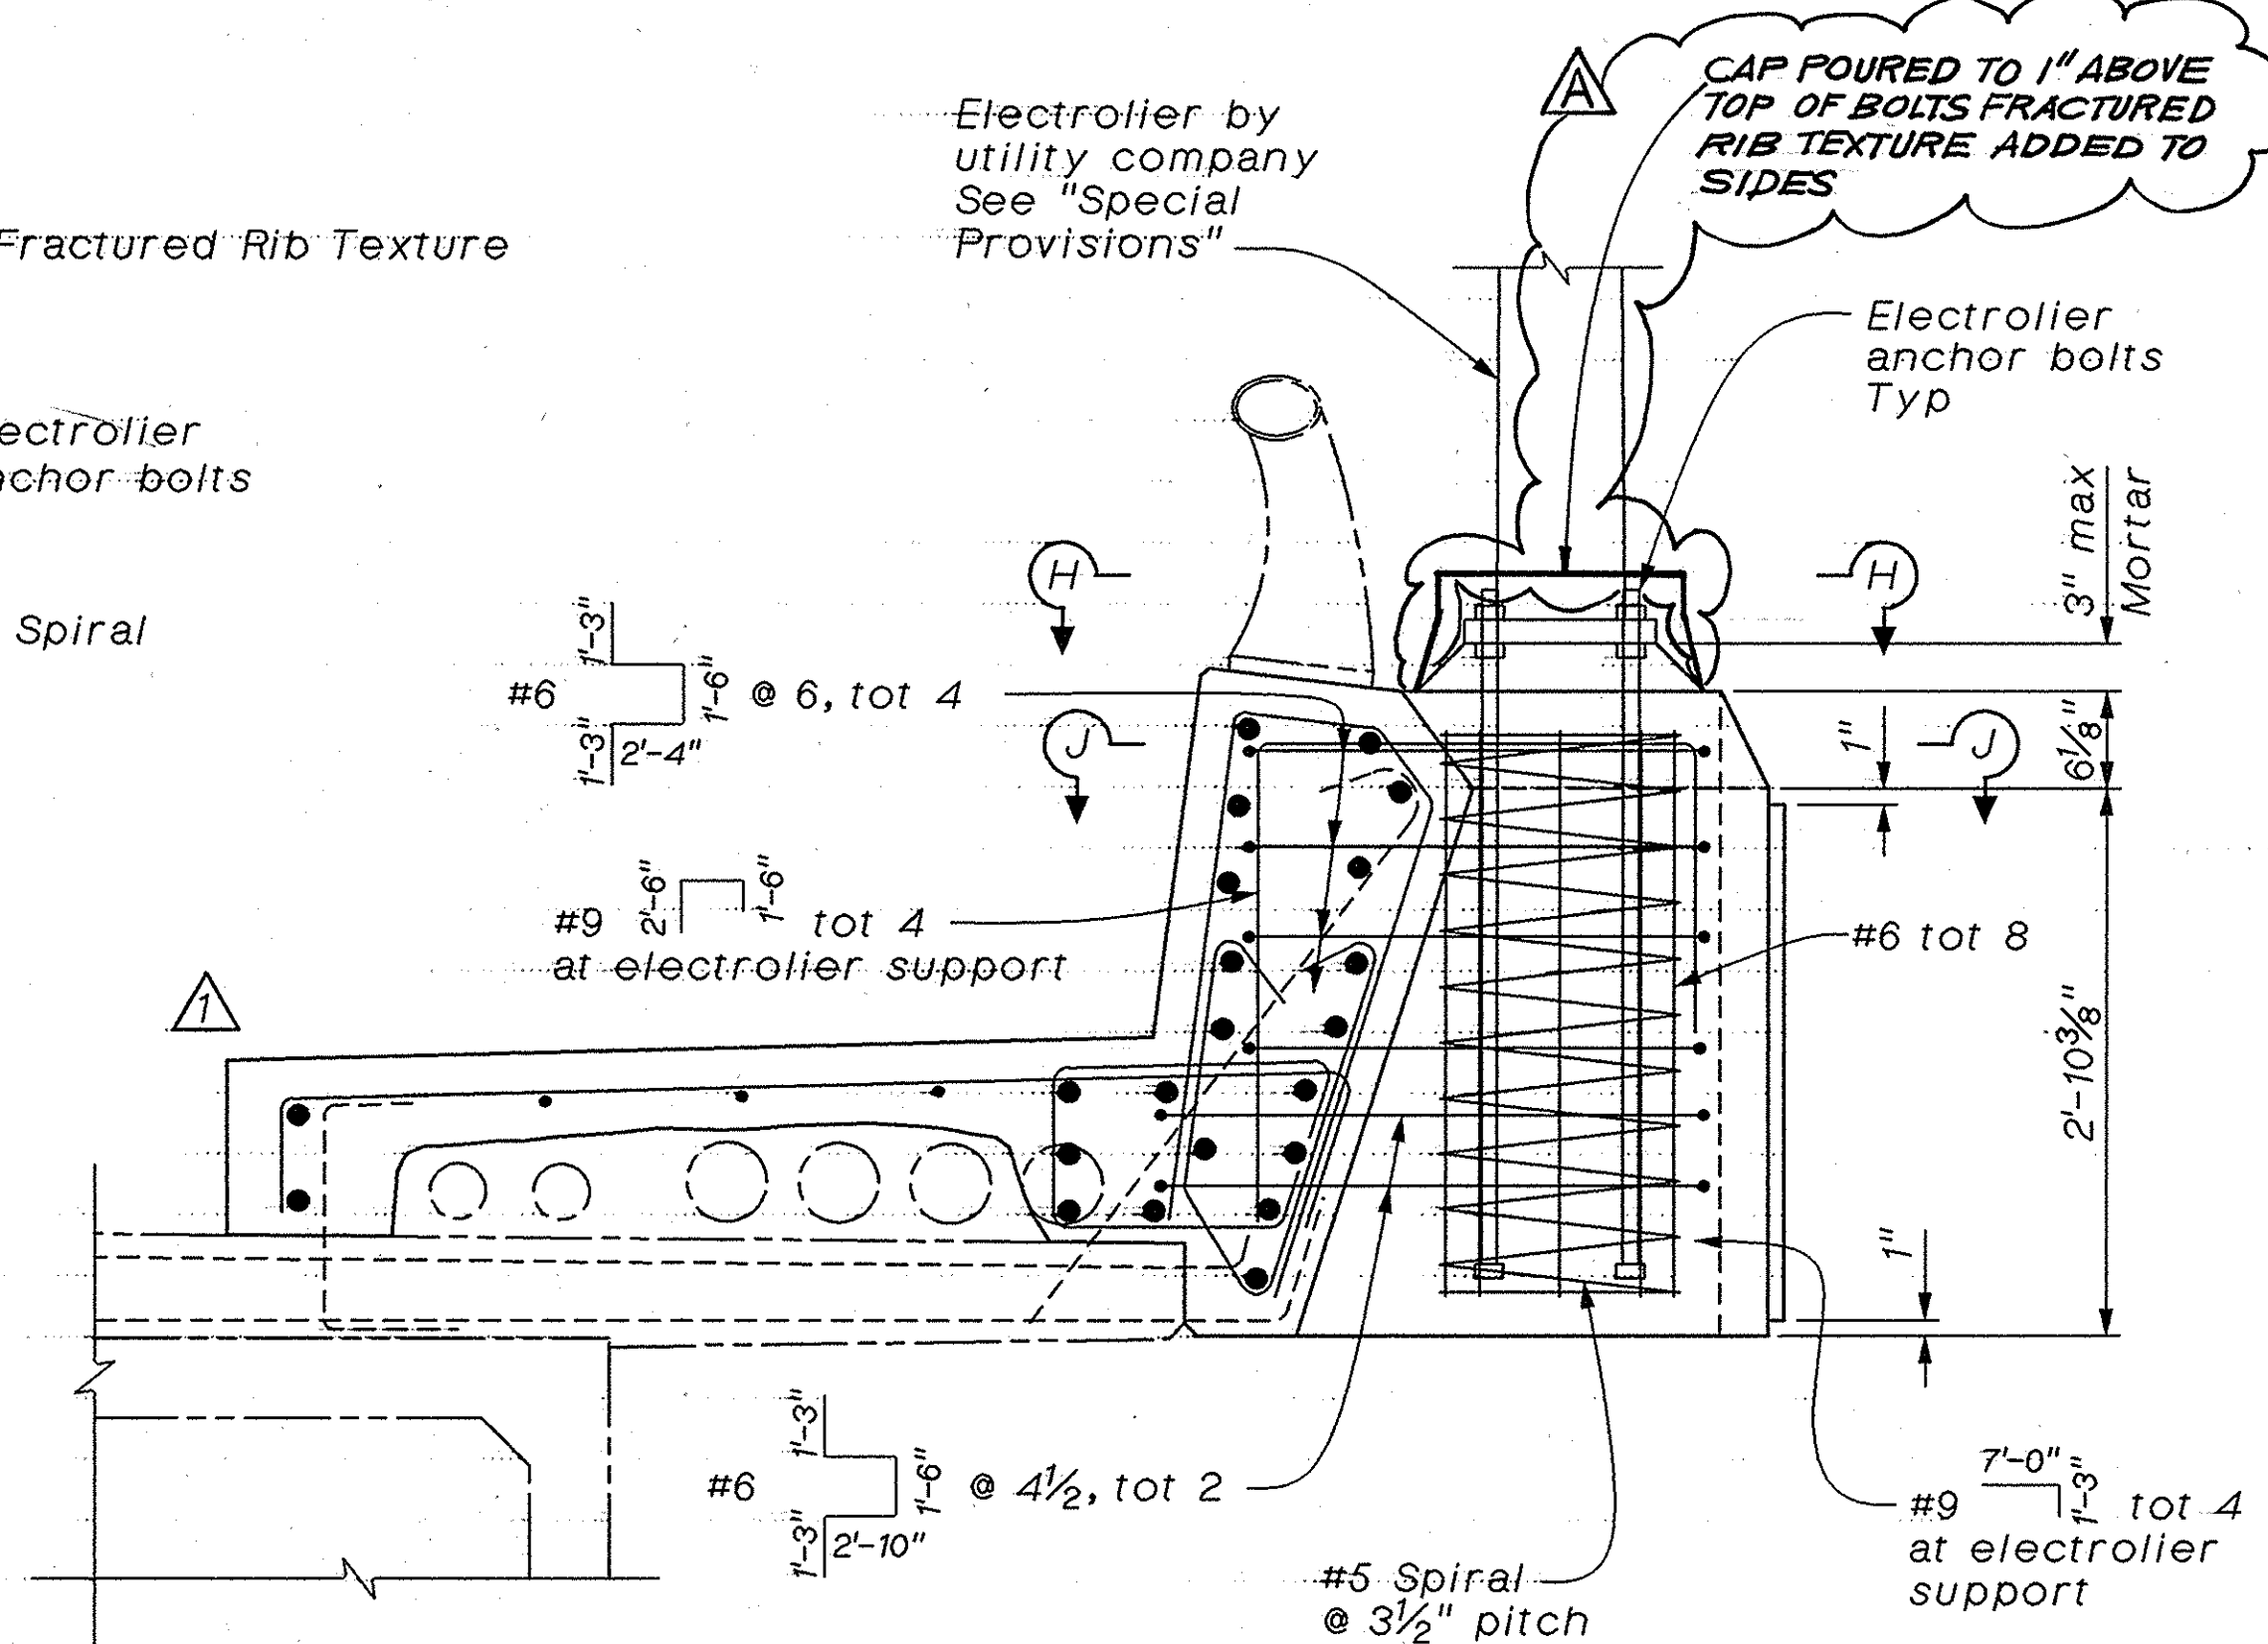

DETAIL 5
1" = 1'-0"

Note:
For information not shown,
see "Detail 3" on "Barrier
Retrofit Details No. 1" sheet

Note:
The Contractor shall verify all
controlling field dimensions before
ordering or fabricating any material.

Note:
For dimensions, see "Detail 2" on
"Barrier Retrofit Details No. 1" sheet

	3/02	AS BUILT		
	11/17/00	Barrier Modification	RA	GJM
REV	DATE	DESCRIPTION	BY	CHK

SHAWN SUN <i>Shawn Sun</i> DESIGN OVERSIGHT SIGN OFF DATE <i>11/20/00</i>	DESIGN BY <i>G.J.N./H. LAM</i>	CHECKED <i>M. ZAHEDI/A. HOU</i>	PREPARED FOR THE COUNTY OF ORANGE	G.J. NASCIMENTO PROJECT ENGINEER	BRIDGE NO. <i>55C-0561</i>	DANA POINT HARBOR BRIDGE					
	DETAILS BY <i>H. LAM</i>	CHECKED <i>J. LU</i>			POST MILE	BARRIER RETROFIT DETAILS No. 2					
	QUANTITIES BY <i>H. LAM</i>	CHECKED <i>A. TRUONG</i>									
			ORIGINAL SCALE IN INCHES FOR REDUCED PLANS	CU 12 152 EA L02106	DISREGARD PRINTS BEARING EARLIER REVISION DATES →	REVISION DATES (PRELIMINARY STAGE ONLY)				SHEET 6	OF 9
						11/17/00					