

DIST	COUNTY	ROUTE	POST MILES TOTAL PROJECT	SHEET NO.	TOTAL SHEETS
12				8 R1	14

G. J. Nascimento
REGISTERED CIVIL ENGINEER

PLANS APPROVAL DATE _____


LIM & NASCIMENTO ENGINEERING
12-L Mauchly
Irvine, California 92618

The State of California or its officers or agents shall not be responsible for the accuracy or completeness of electronic copies of this plan sheet.

Note:
All existing utilities are to be protected in place unless otherwise indicated. Not all utilities shown.


AS BUILT

CORRECTIONS BY	G. Zaun / WPN
CONTRACT NO.	59Y021
DATE	02-02 / 03-02

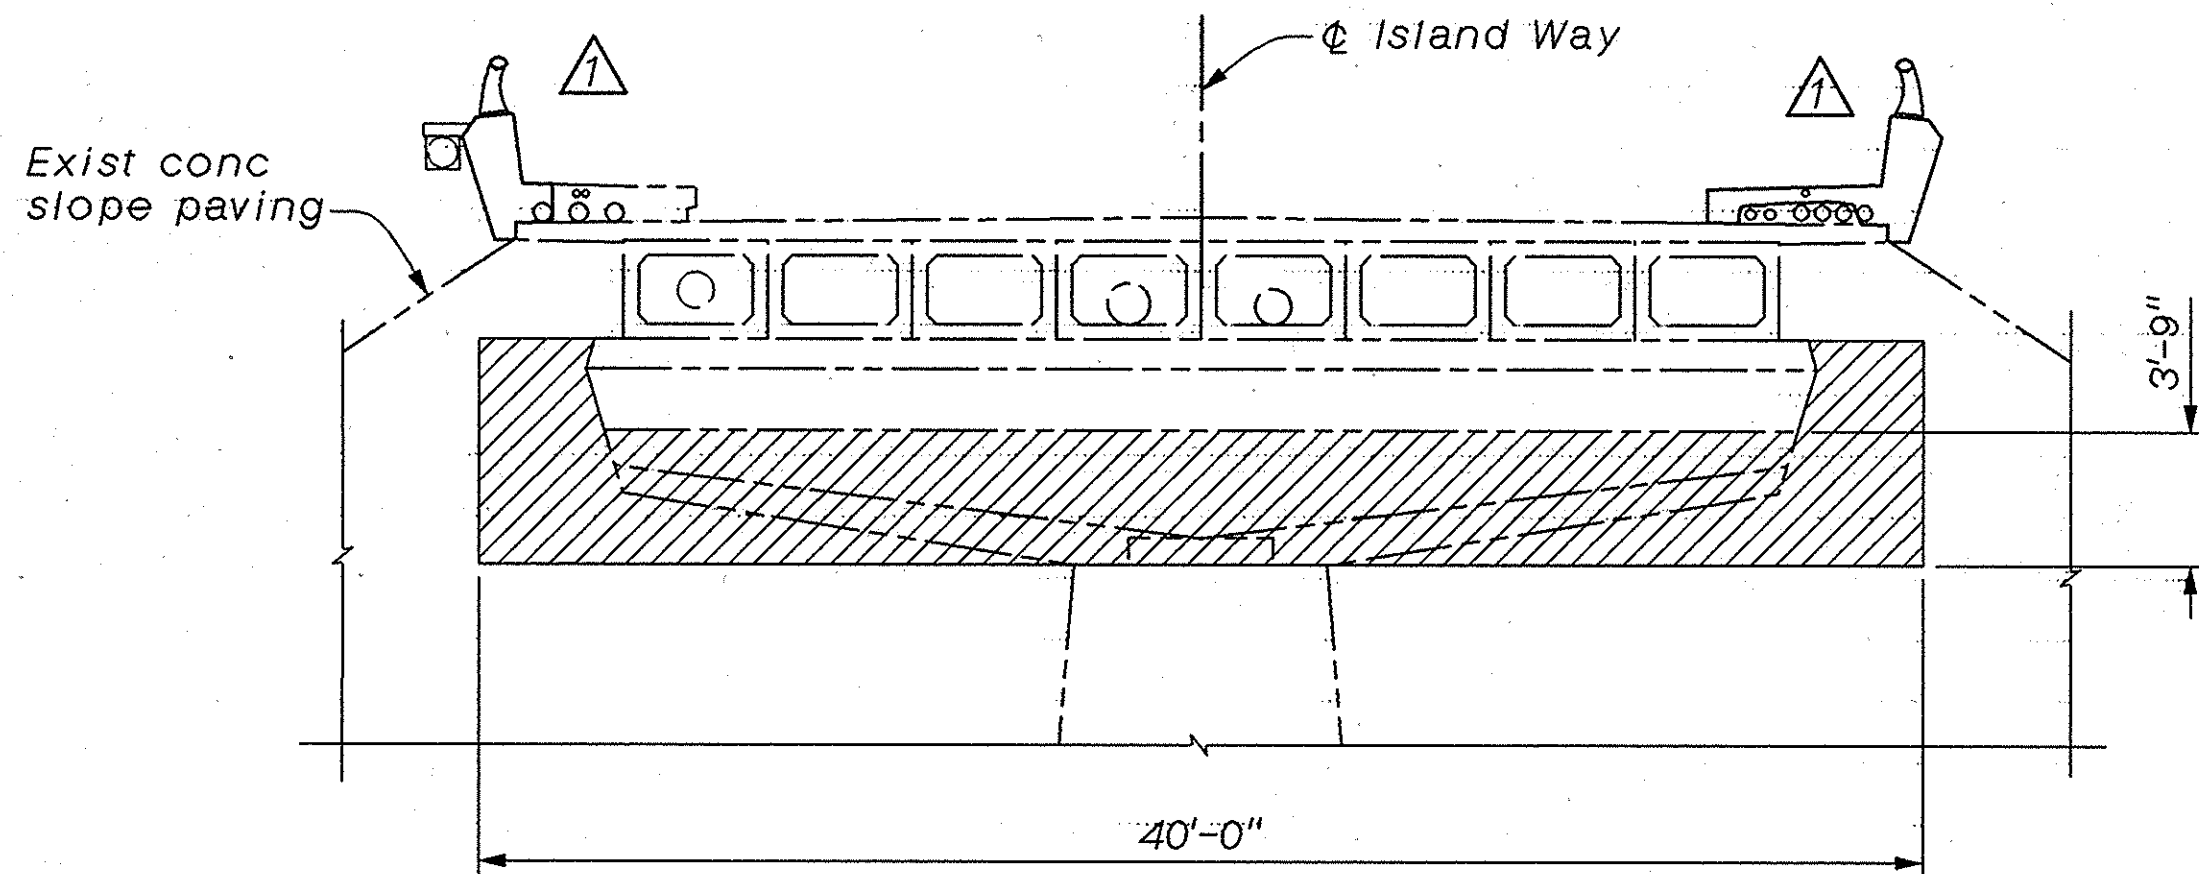


ELEVATION VIEW

Looking North

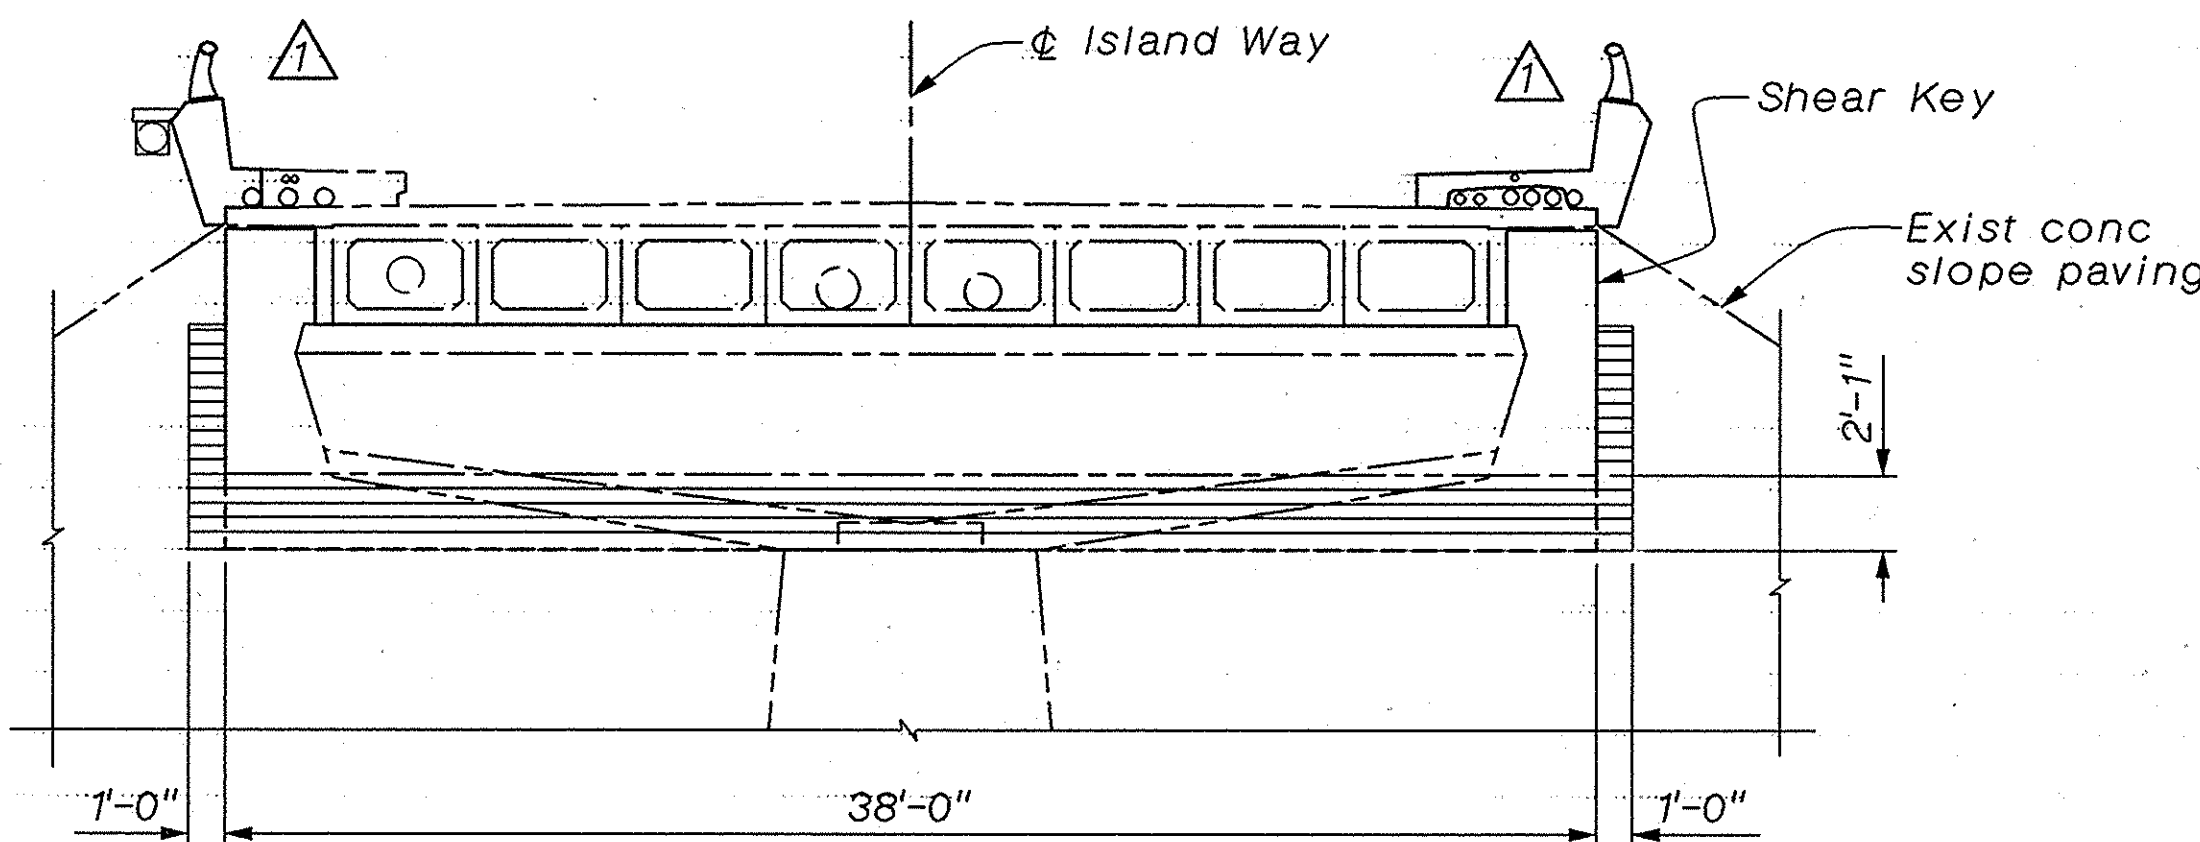


ELEVATION VIEW

Looking North

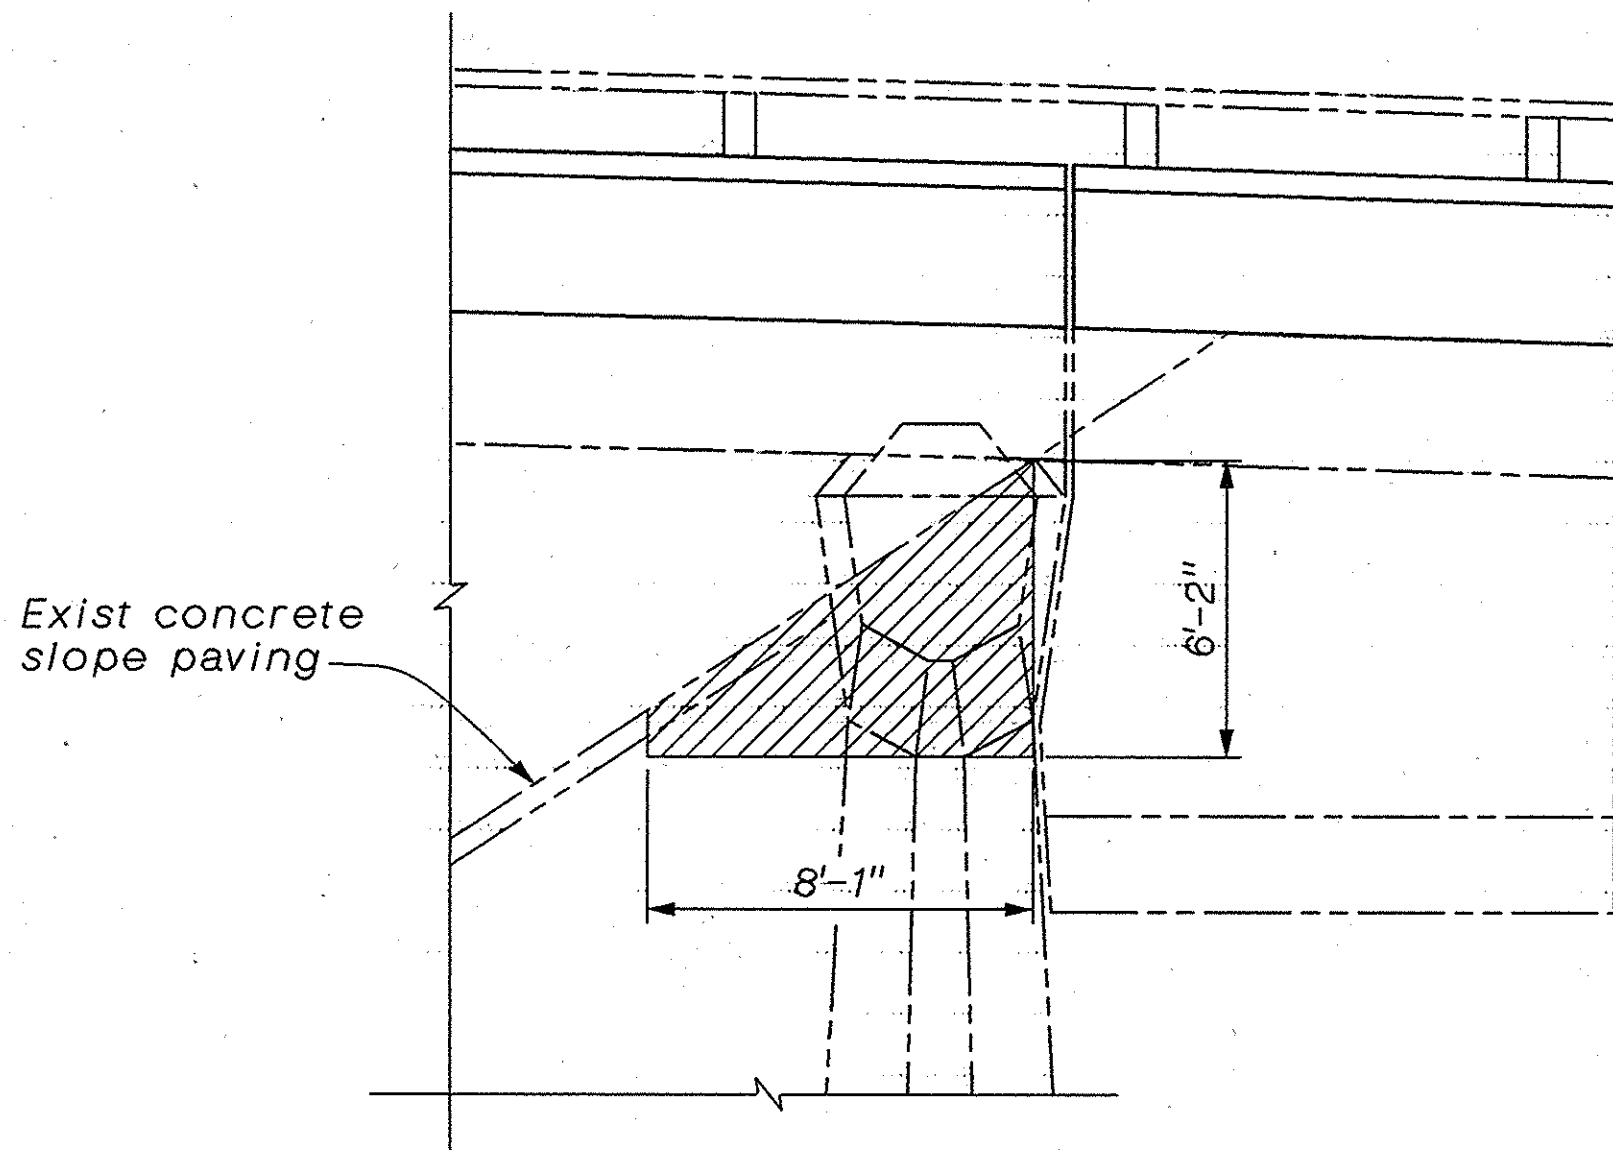


SIDE VIEW

EXCAVATION

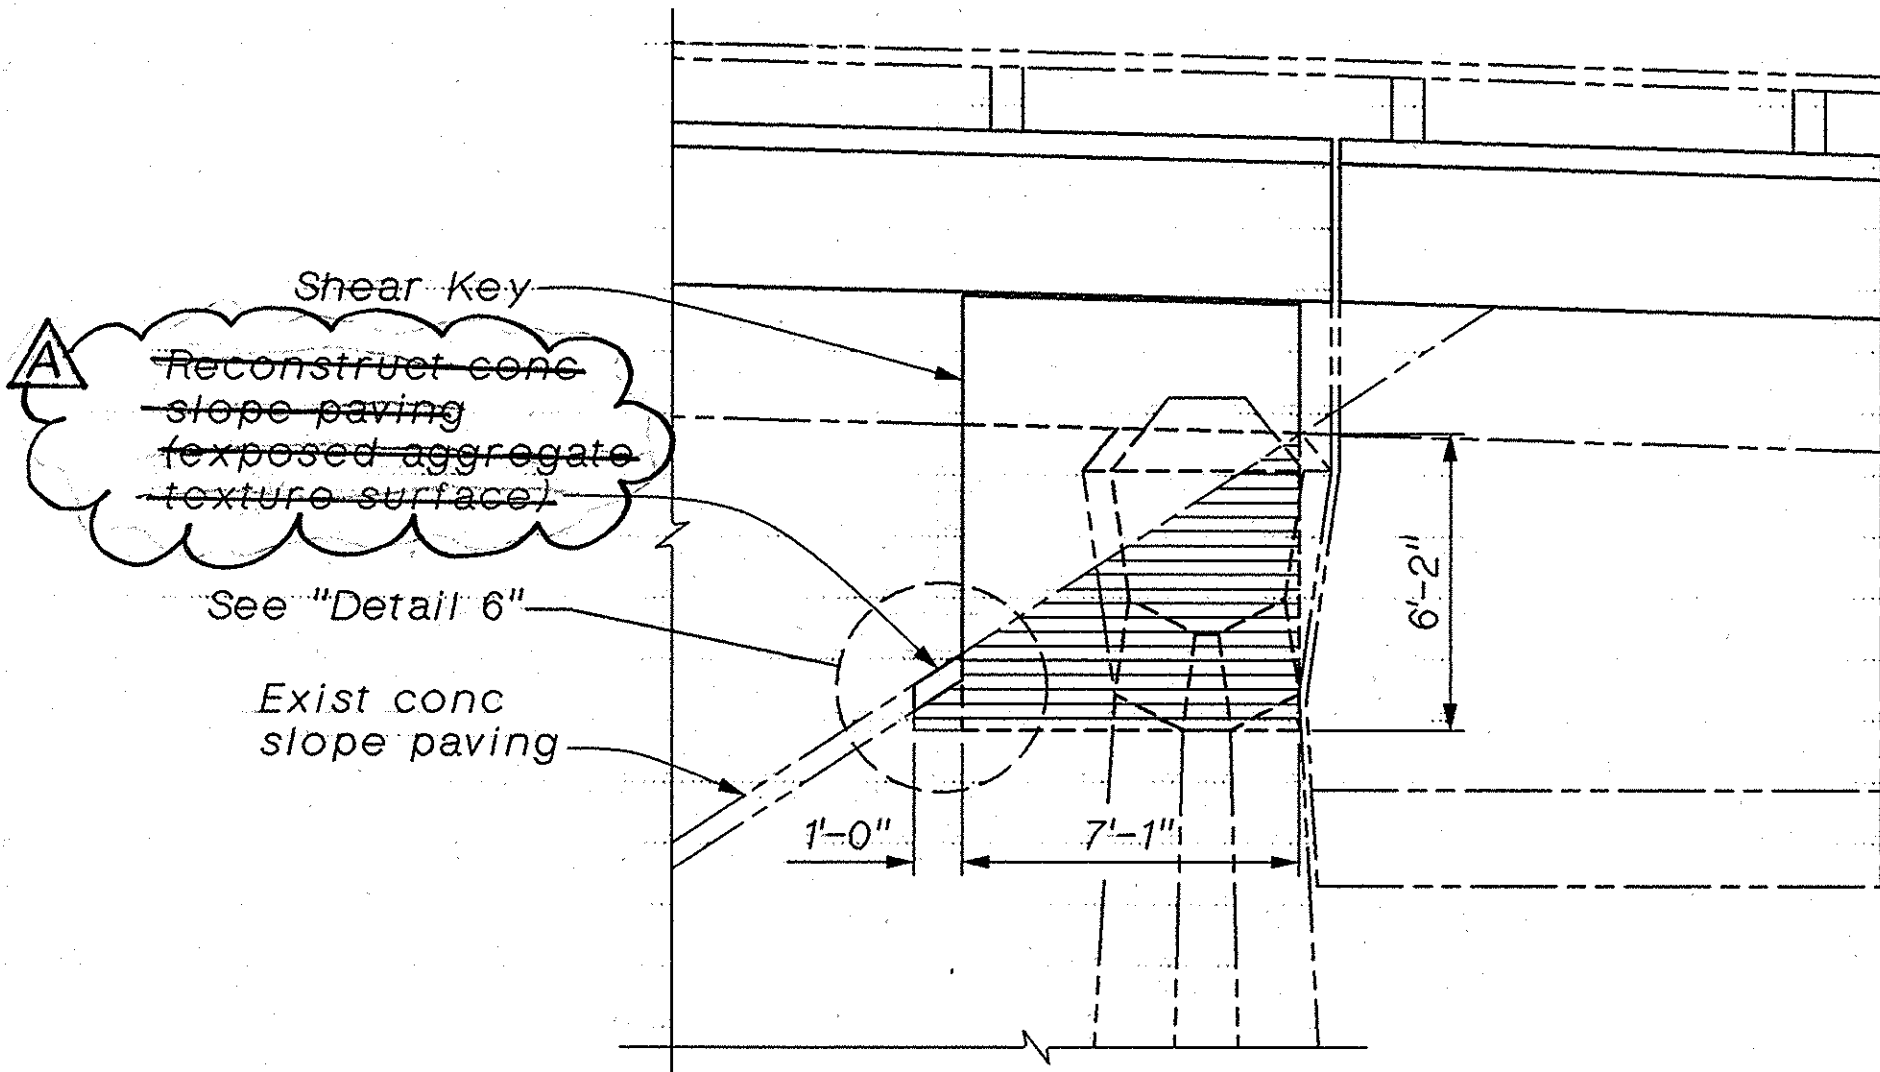

SIDE VIEW

BACKFILL

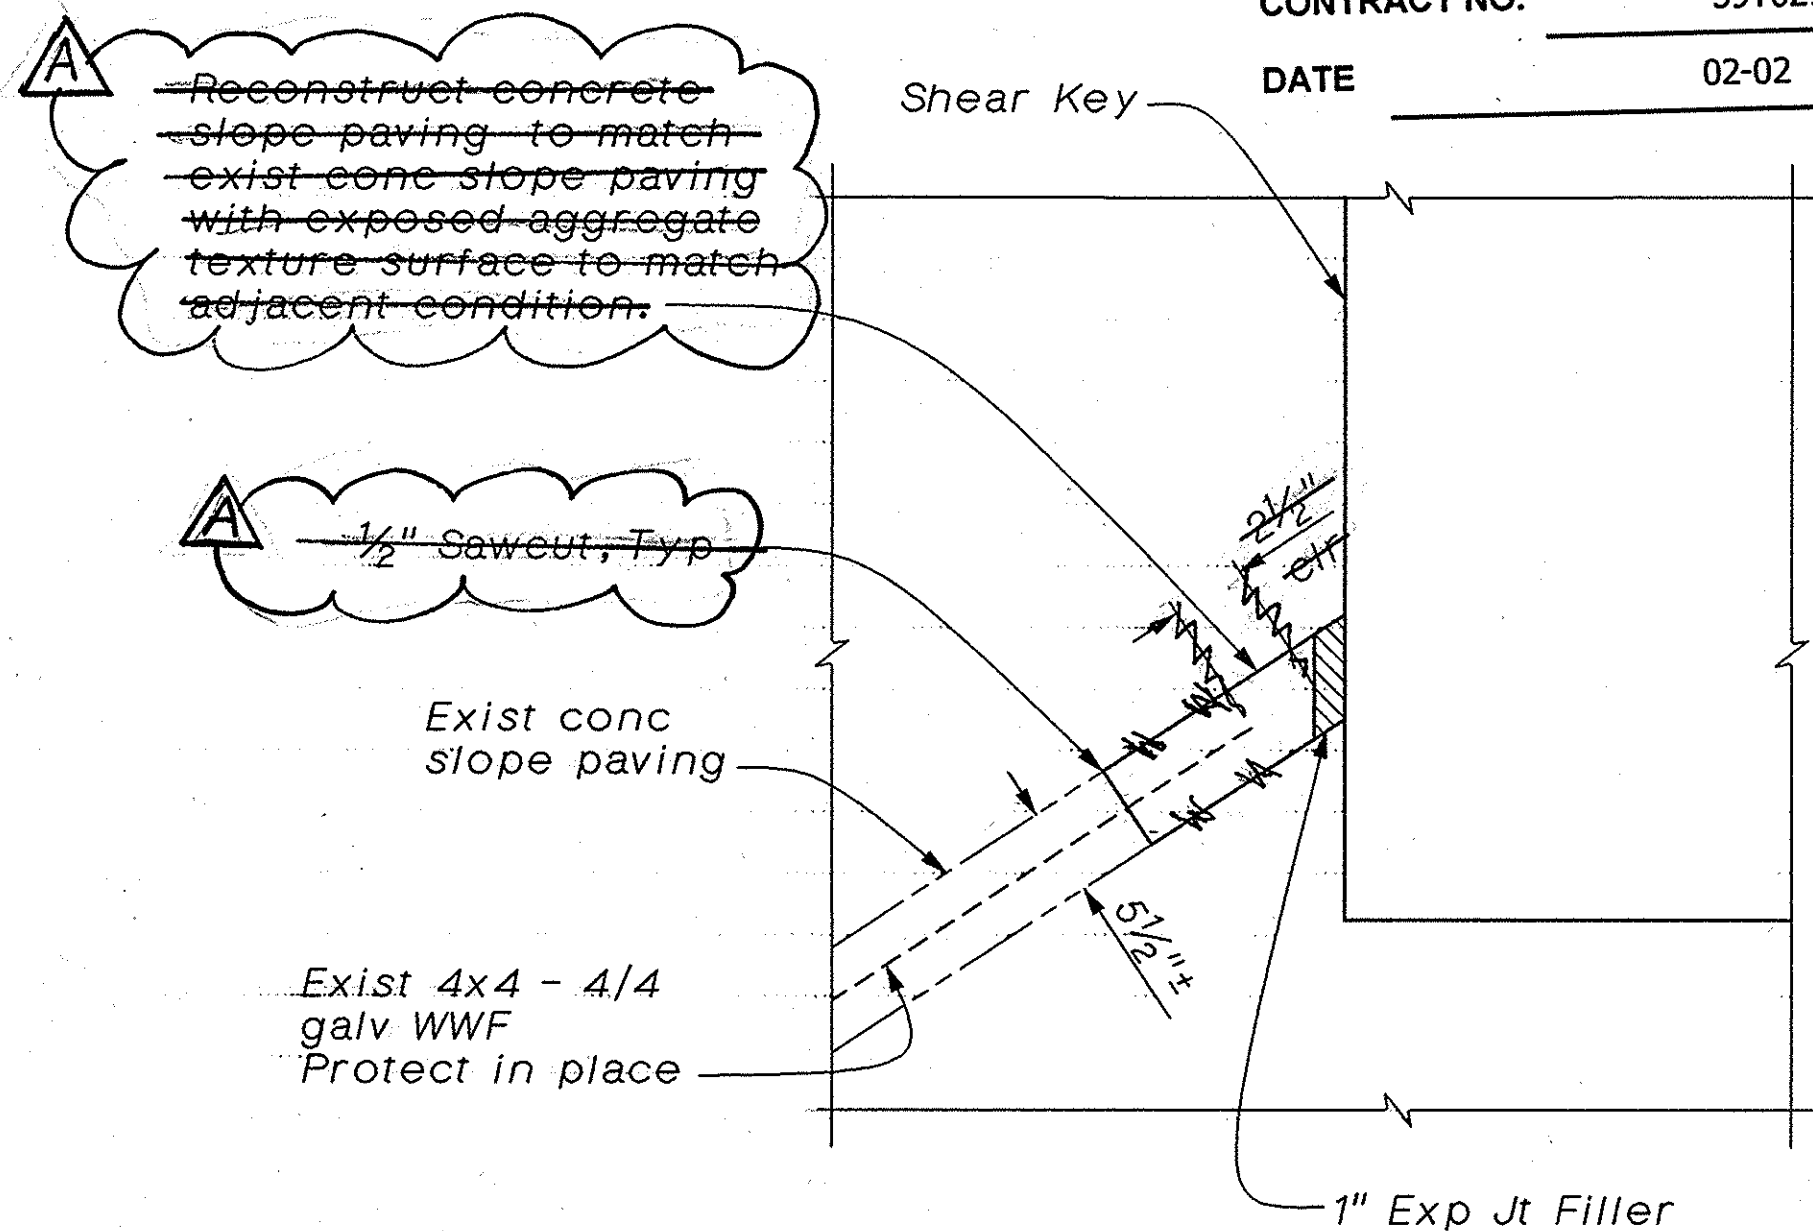

DETAIL 6

1" = 1'-0"

LEGEND

	Structure Excavation
	Structure Backfill

REV	DATE	DESCRIPTION	BY	CHK'D
3/02	AS BUILT			
11/17/00	Barrier Modification		RA	GJN

Note:
The Contractor shall verify all controlling field dimensions before ordering or fabricating any material.

DESIGN	BY	G.J.N./H. LAM	CHECKED	M. ZAHEDI/A. HOU
DETAILS	BY	H. LAM	CHECKED	J. LU
QUANTITIES	BY	H. LAM	CHECKED	A. TRUONG

PREPARED FOR THE
COUNTY OF
ORANGE

G.J. NASCIMENTO
PROJECT ENGINEER

BRIDGE NO.
55C-0561
POST MILE

EARTHQUAKE RETROFIT
DANA POINT HARBOR BRIDGE
LIMITS OF PAYMENT FOR
EXCAVATION AND BACKFILL

ORIGINAL SCALE IN INCHES
FOR REDUCED PLANS

0 1 2 3

CU 12 152
EA L02106

DISREGARD PRINTS BEARING
EARLIER REVISION DATES

REVISION DATES (PRELIMINARY STAGE ONLY)

SHEET 7 OF 9