


TO ACCOMPANY PLANS DATED

| DIST | COUNTY | ROUTE | POST MILES TOTAL PROJECT | SHEET NO. | TOTAL SHEETS |
|------|--------|-------|-----------------------------|--------------|-----------------|
| 12 | | | | 9 | 14 |

L. Cheang
REGISTERED CIVIL ENGINEER

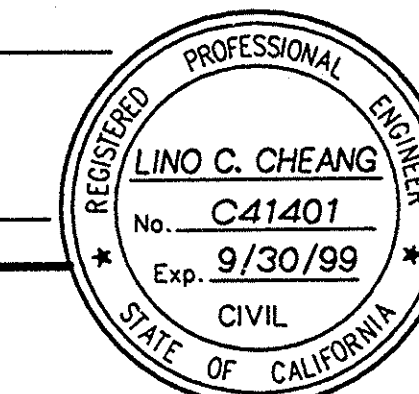

PLANS APPROVAL DATE

EARTH MECHANICS, INC.
17660 Newhope Street, Suite E
Fountain Valley, California 92708


AS BUILT

CORRECTIONS BY G. Zaun / WPN

CONTRACT NO. 59Y021

DATE 02-02 / 03-02

NO AS BUILT CHANGES

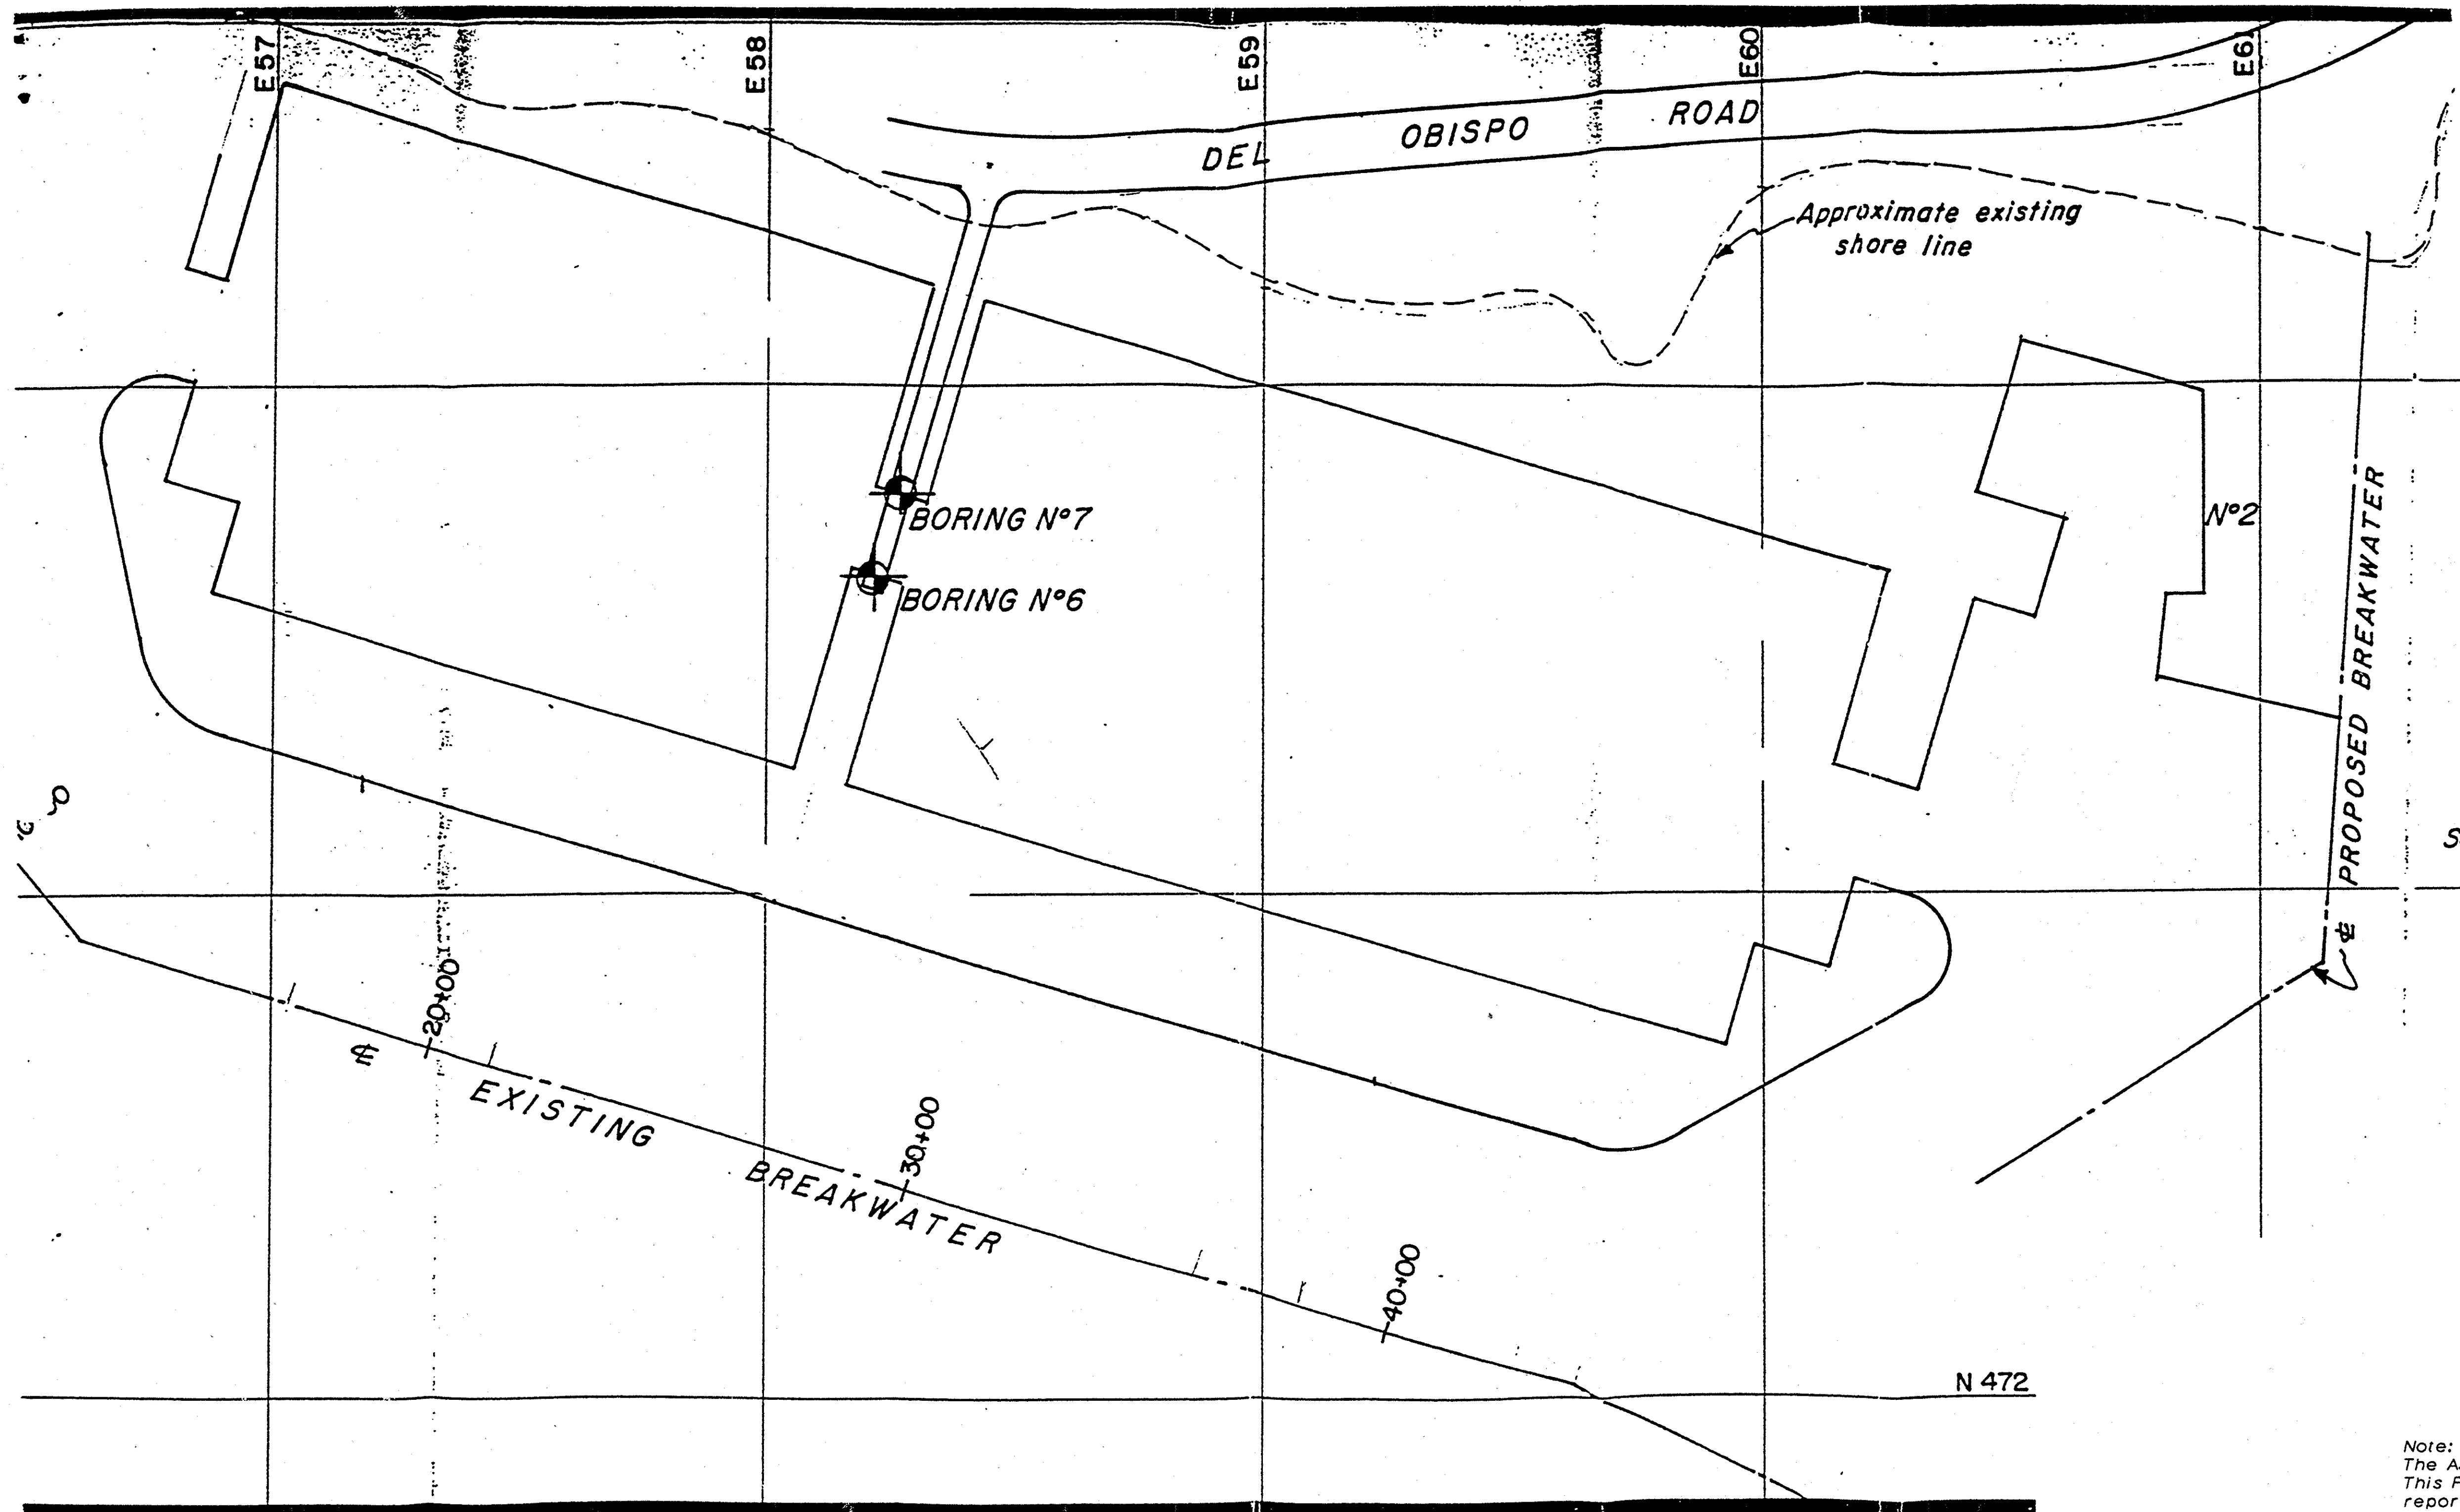

Note:
The As-Built Log of Test Borings is not available.
This Plan shows Log of Test Borings from the geotechnical
report entitled "Preliminary Soils and Geologic Investigation,
Dana Point Harbor" dated June 25, 1968 by Moore & Taber.

EARTHQUAKE RETROFIT

DANA POINT HARBOR BRIDGE

ADJACENT GEOTECHNICAL INFORMATION No.1

SHAWN SUN *Shawn Sun*
DESIGN OVERSIGHT
SIGN OFF DATE 12/29/97

| | | |
|------------|------------------|--------------------------|
| DESIGN | BY G.J.N./H. LAM | CHECKED M. ZAHEDI/A. HOU |
| DETAILS | BY R. ANDRASEK | CHECKED J. LU |
| QUANTITIES | BY H. LAM | CHECKED A. TRUONG |

PREPARED FOR THE
COUNTY OF
ORANGE

G.J. NASCIMENTO
PROJECT ENGINEER

BRIDGE NO.
55C-0561
POST MILE

CU 12 152
EA L02106

DISREGARD PRINTS BEARING
EARLIER REVISION DATES

REVISION DATES (PRELIMINARY STAGE ONLY)

SHEET 8 OF 9