


TO ACCOMPANY PLANS DATED

DIST	COUNTY	ROUTE	POST MILES TOTAL PROJECT	SHEET NO.	TOTAL SHEETS
12				10	14

L. C. Cheang
REGISTERED CIVIL ENGINEER

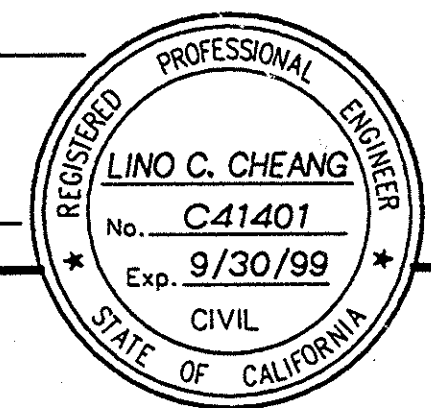

PLANS APPROVAL DATE

EARTH MECHANICS, INC.
17660 Newhope Street, Suite E
Fountain Valley, California 92708

AS BUILT

CORRECTIONS BY G. Zaun / WPN

CONTRACT NO. 59Y021

DATE 02-02 / 03-02

NO AS BUILT CHANGES

TEST BORING LOG

