

AS BUILT


CORRECTIONS BY G. Zaun / WPN
 CONTRACT NO. 59Y021
 DATE 02-02 / 03-02

NO AS BUILT CHANGES


DIST	COUNTY	ROUTE	POST MILES TOTAL PROJECT	SHEET NO.	TOTAL SHEETS
12				11	14

C. Russell Hulse
 REGISTERED CIVIL ENGINEER
 18 Nov 98
 PLANS APPROVAL DATE
 No. 17139
 Exp. 6/30/01
 CIVIL
 STATE OF CALIFORNIA

BOYLE ENGINEERING
 1501 Quail Street
 Newport Beach, California 92658

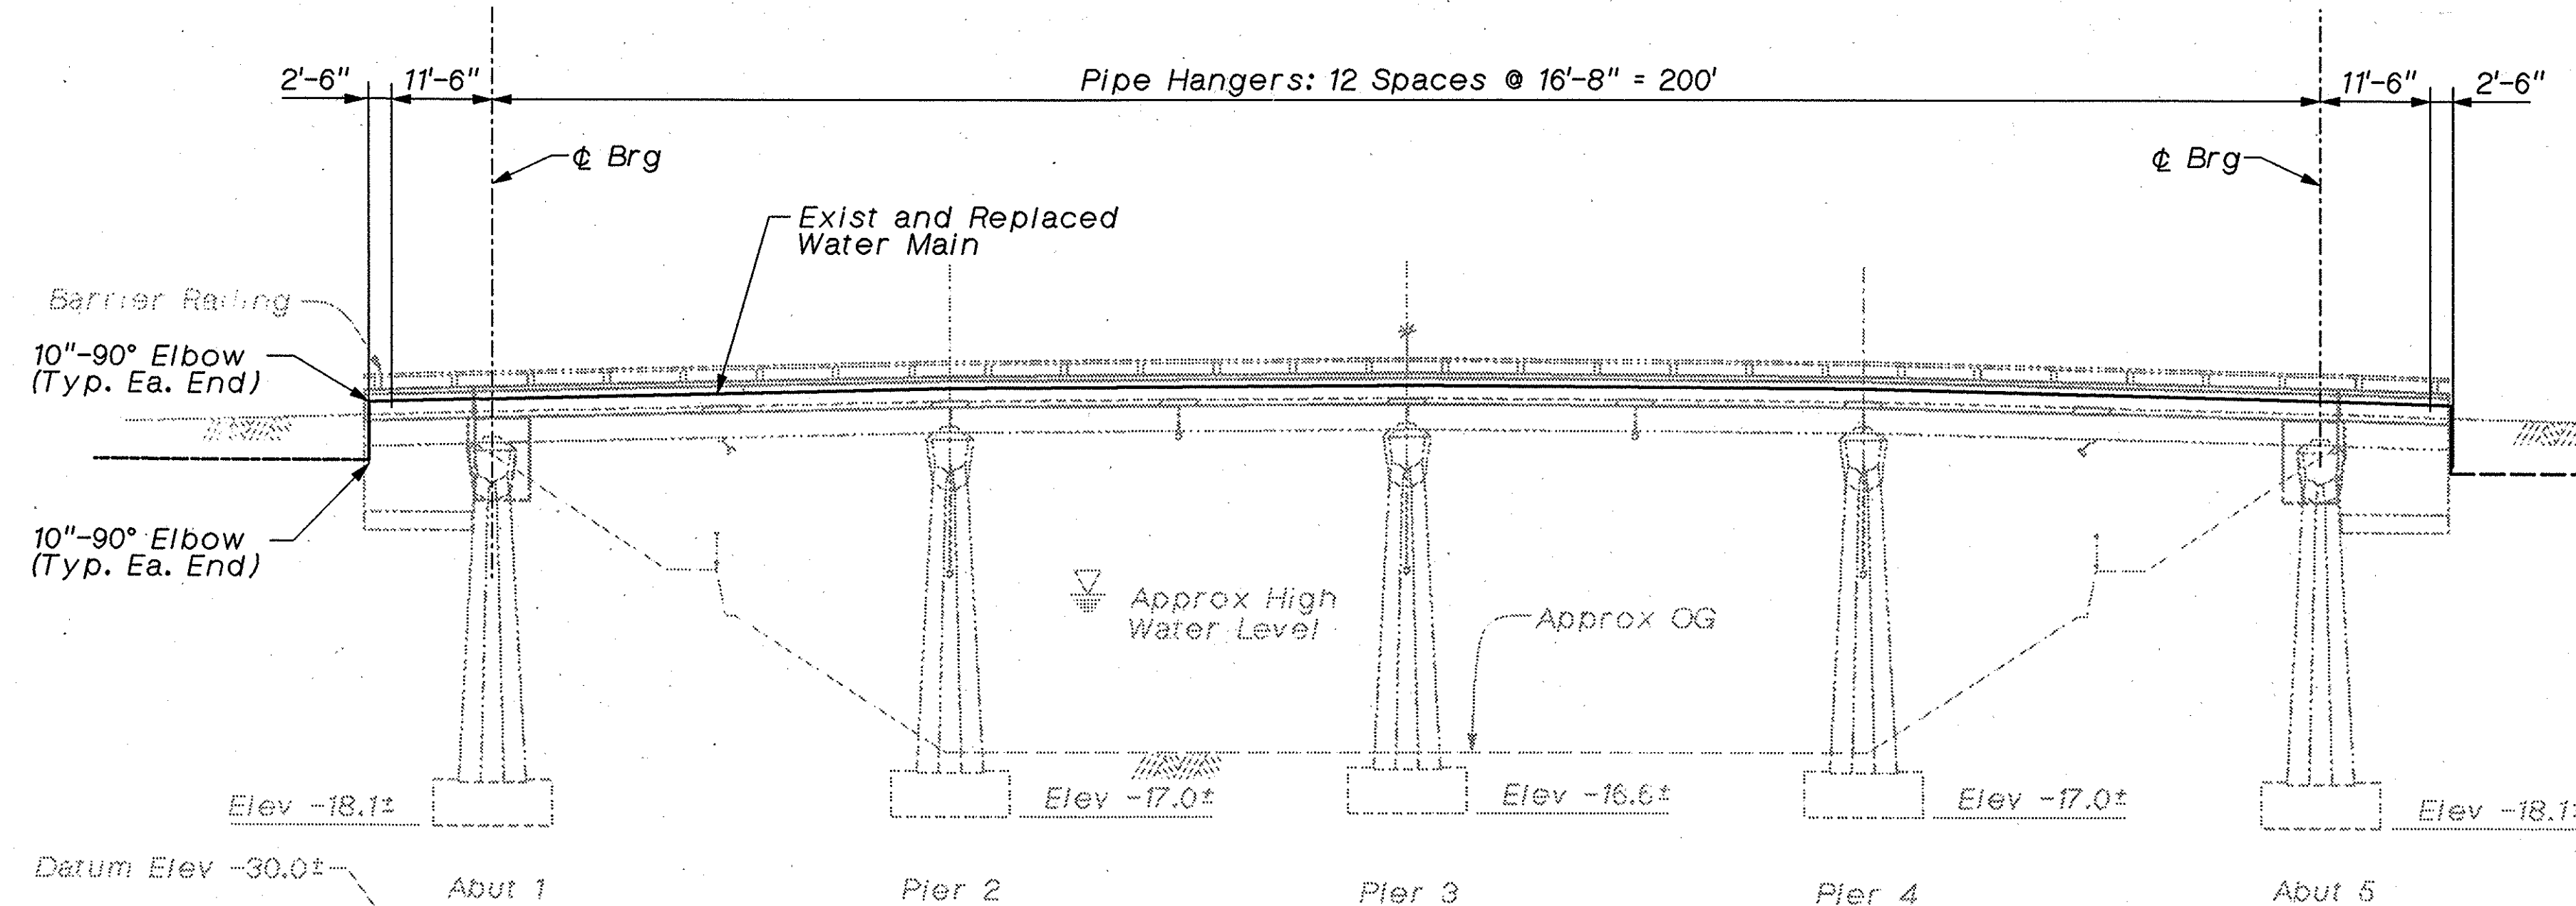


ELEVATION
 1" = 15'

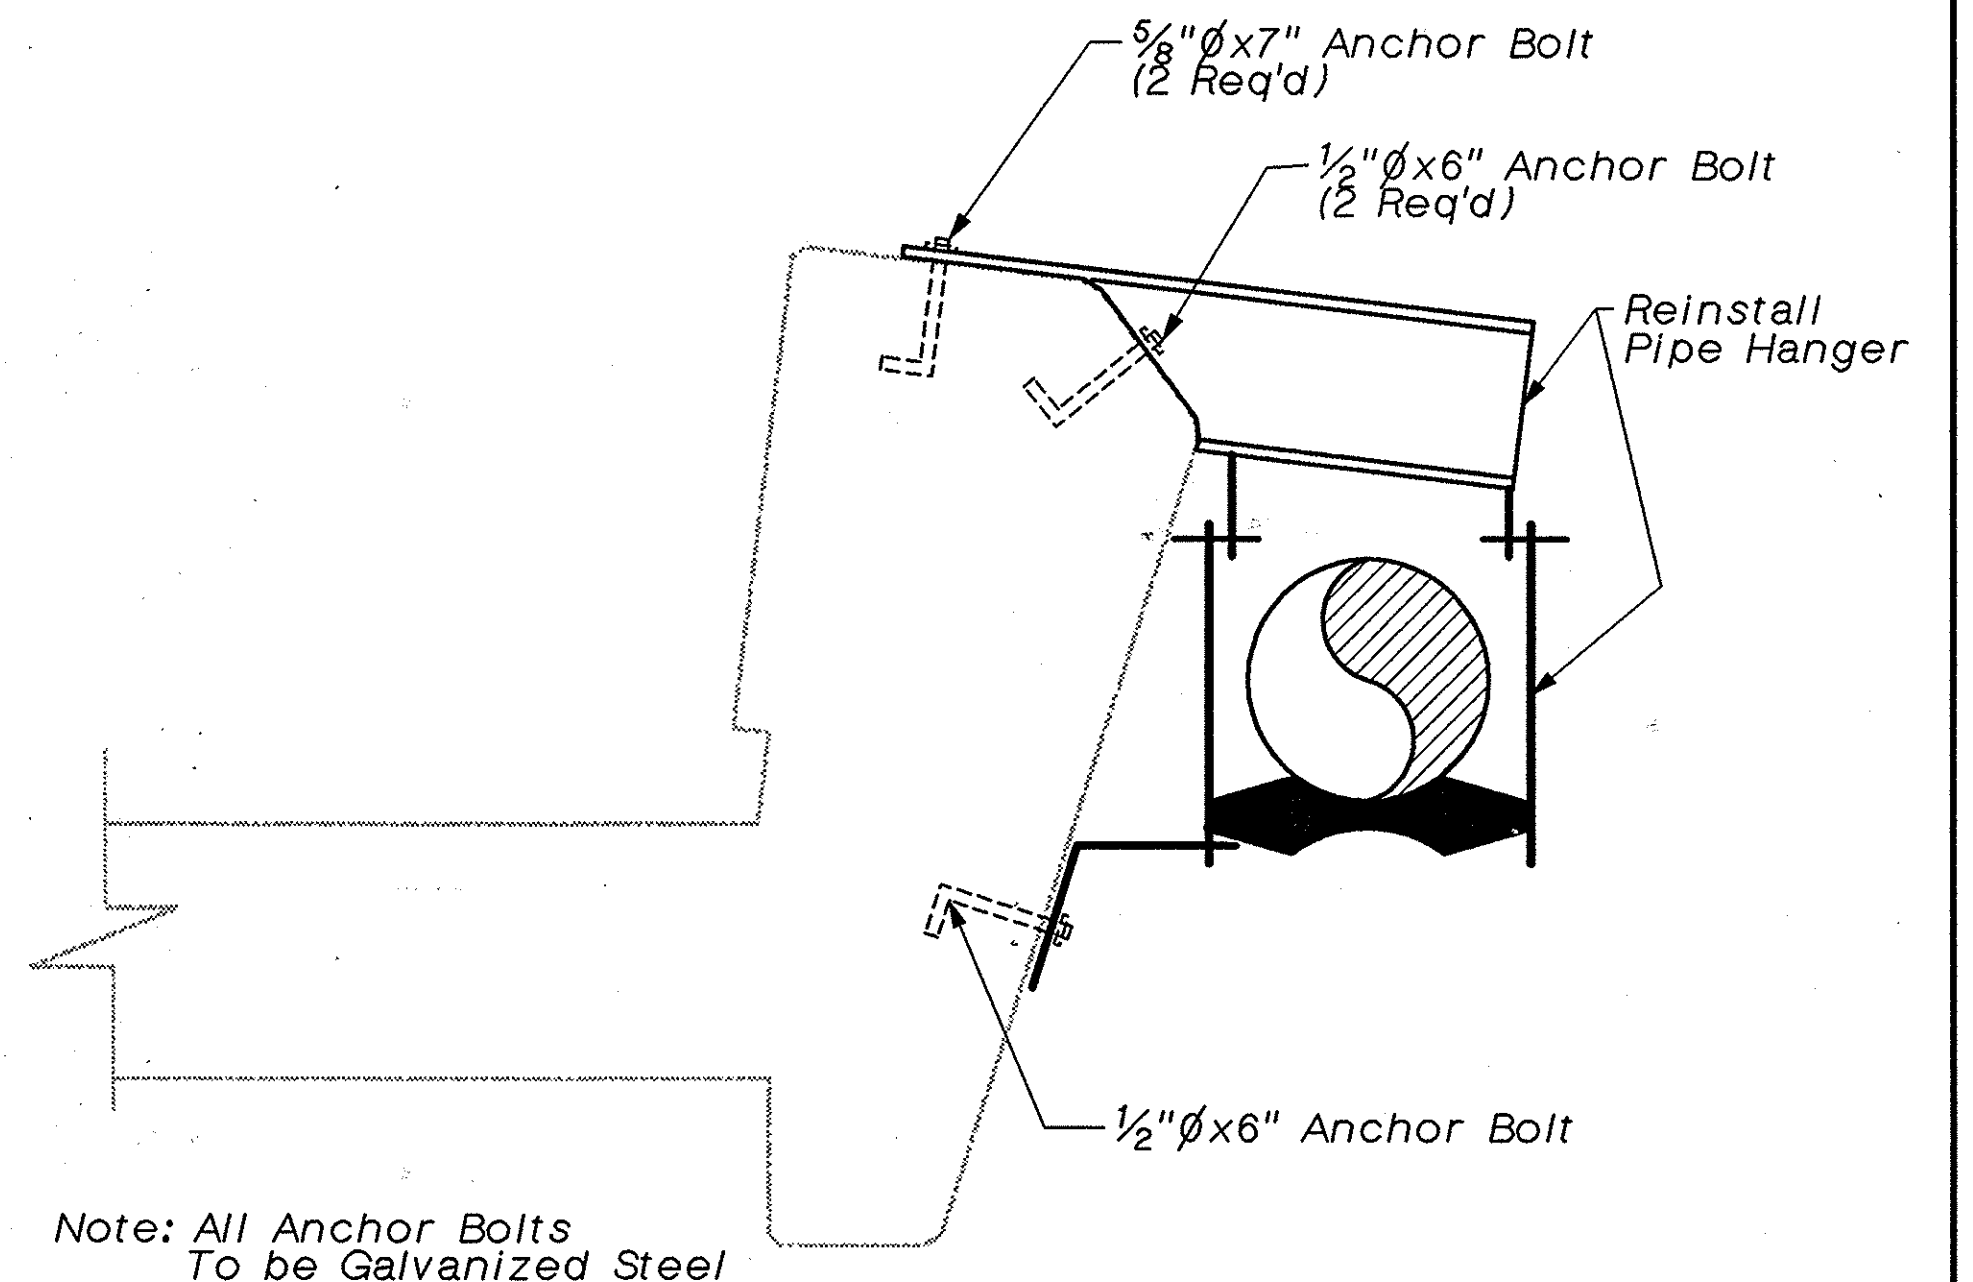


DETAIL 2
 SCALE: 1-1/2" = 1'-0"

Note: All Anchor Bolts To be Galvanized Steel

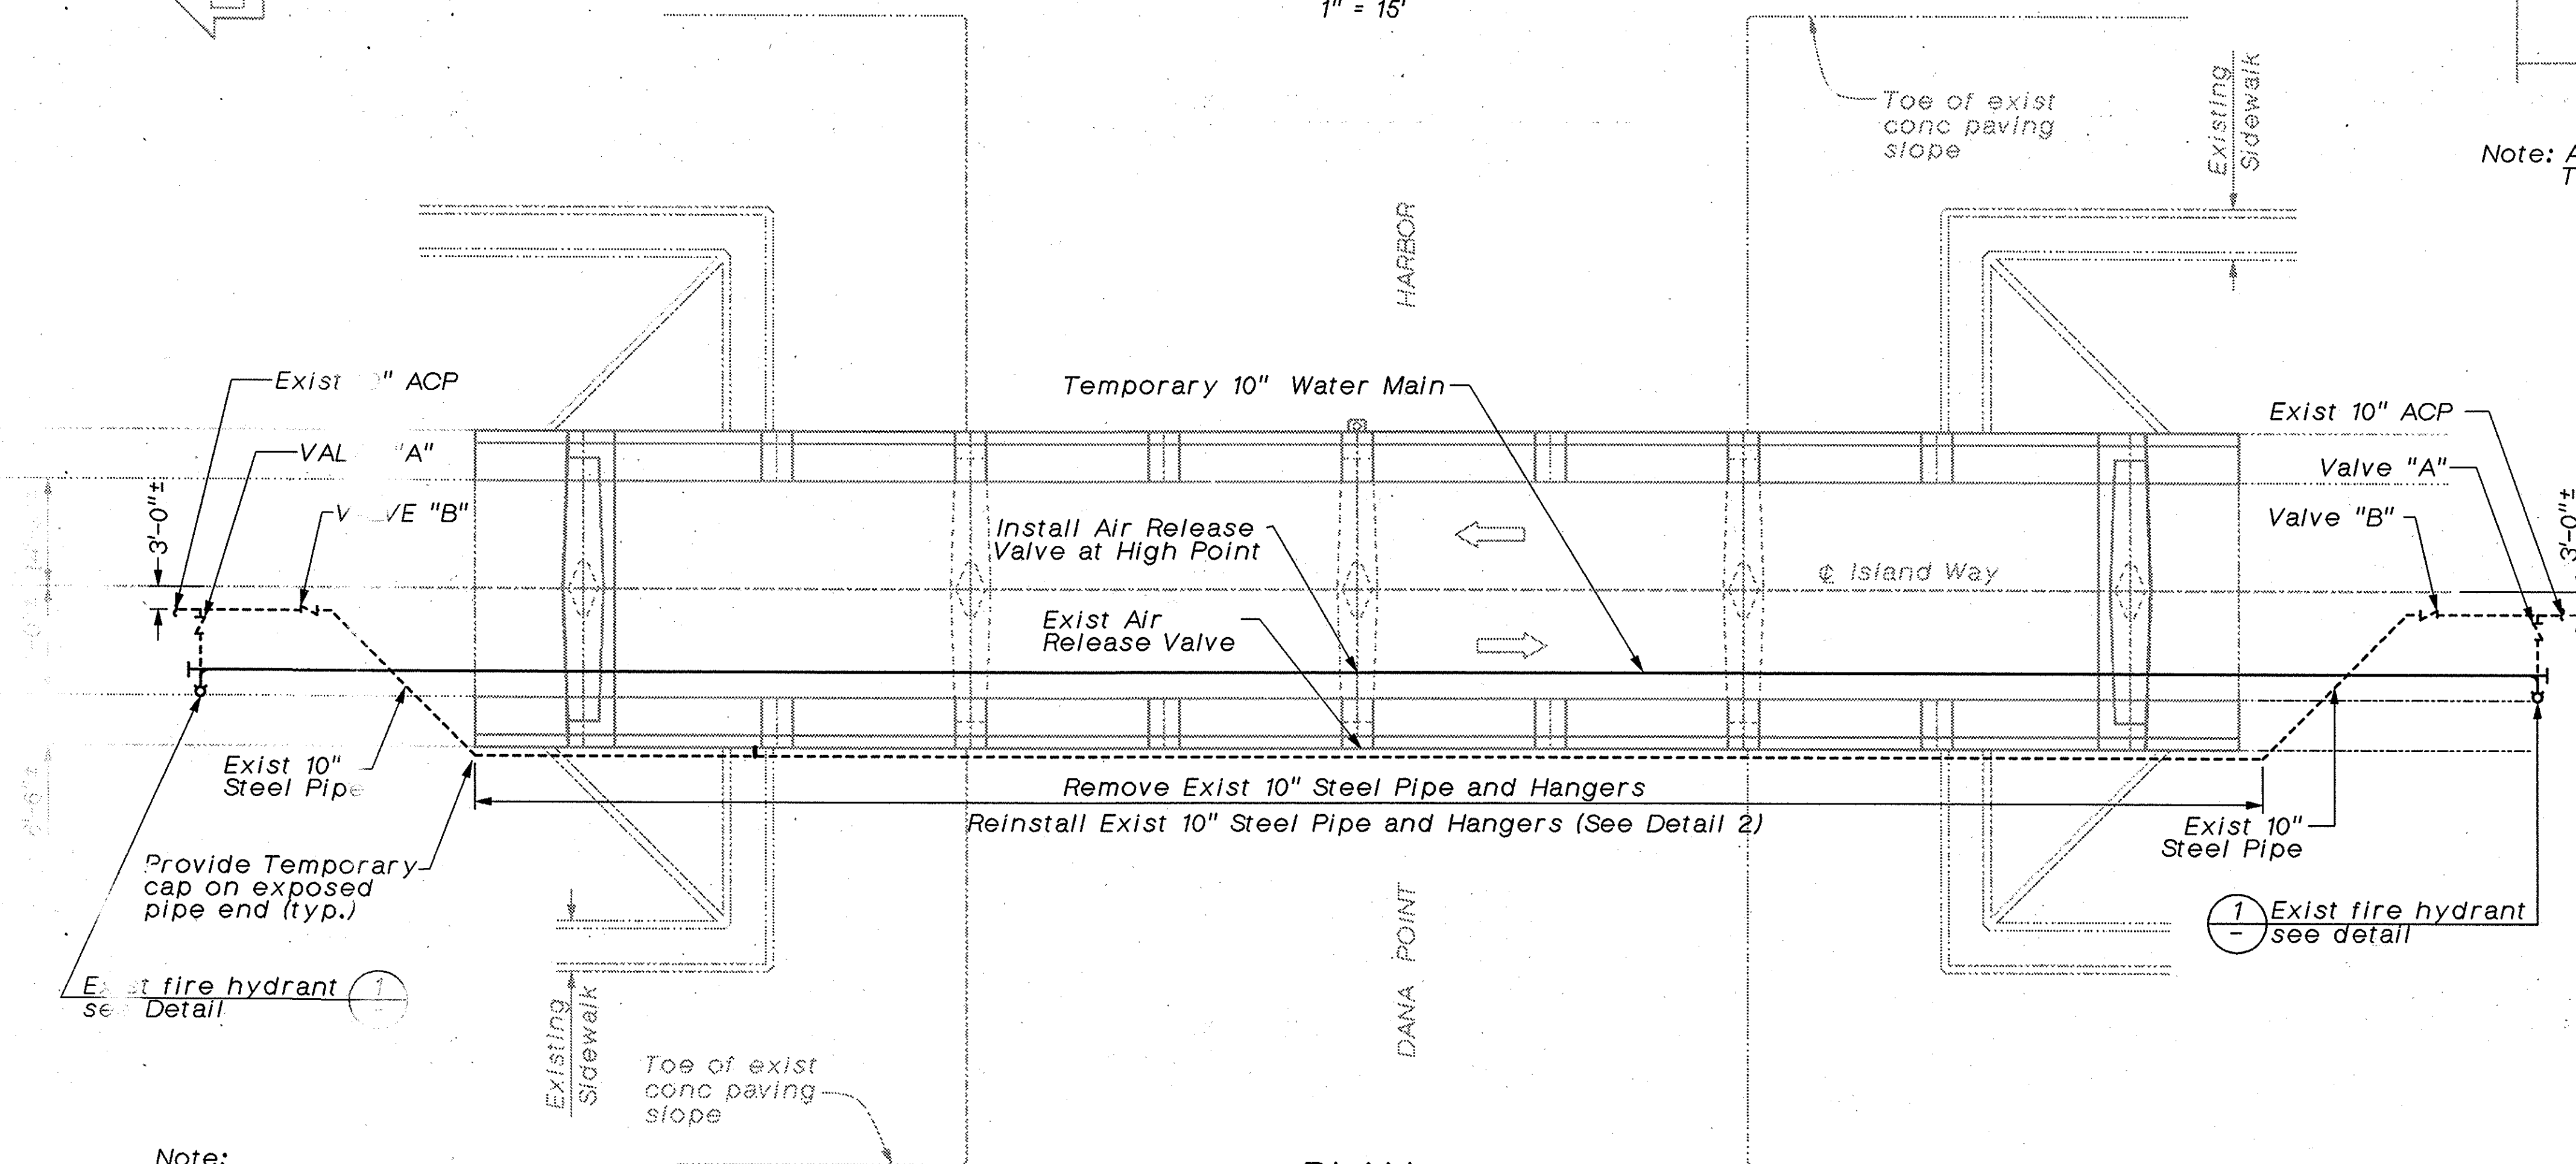

PLAN
 1" = 15'

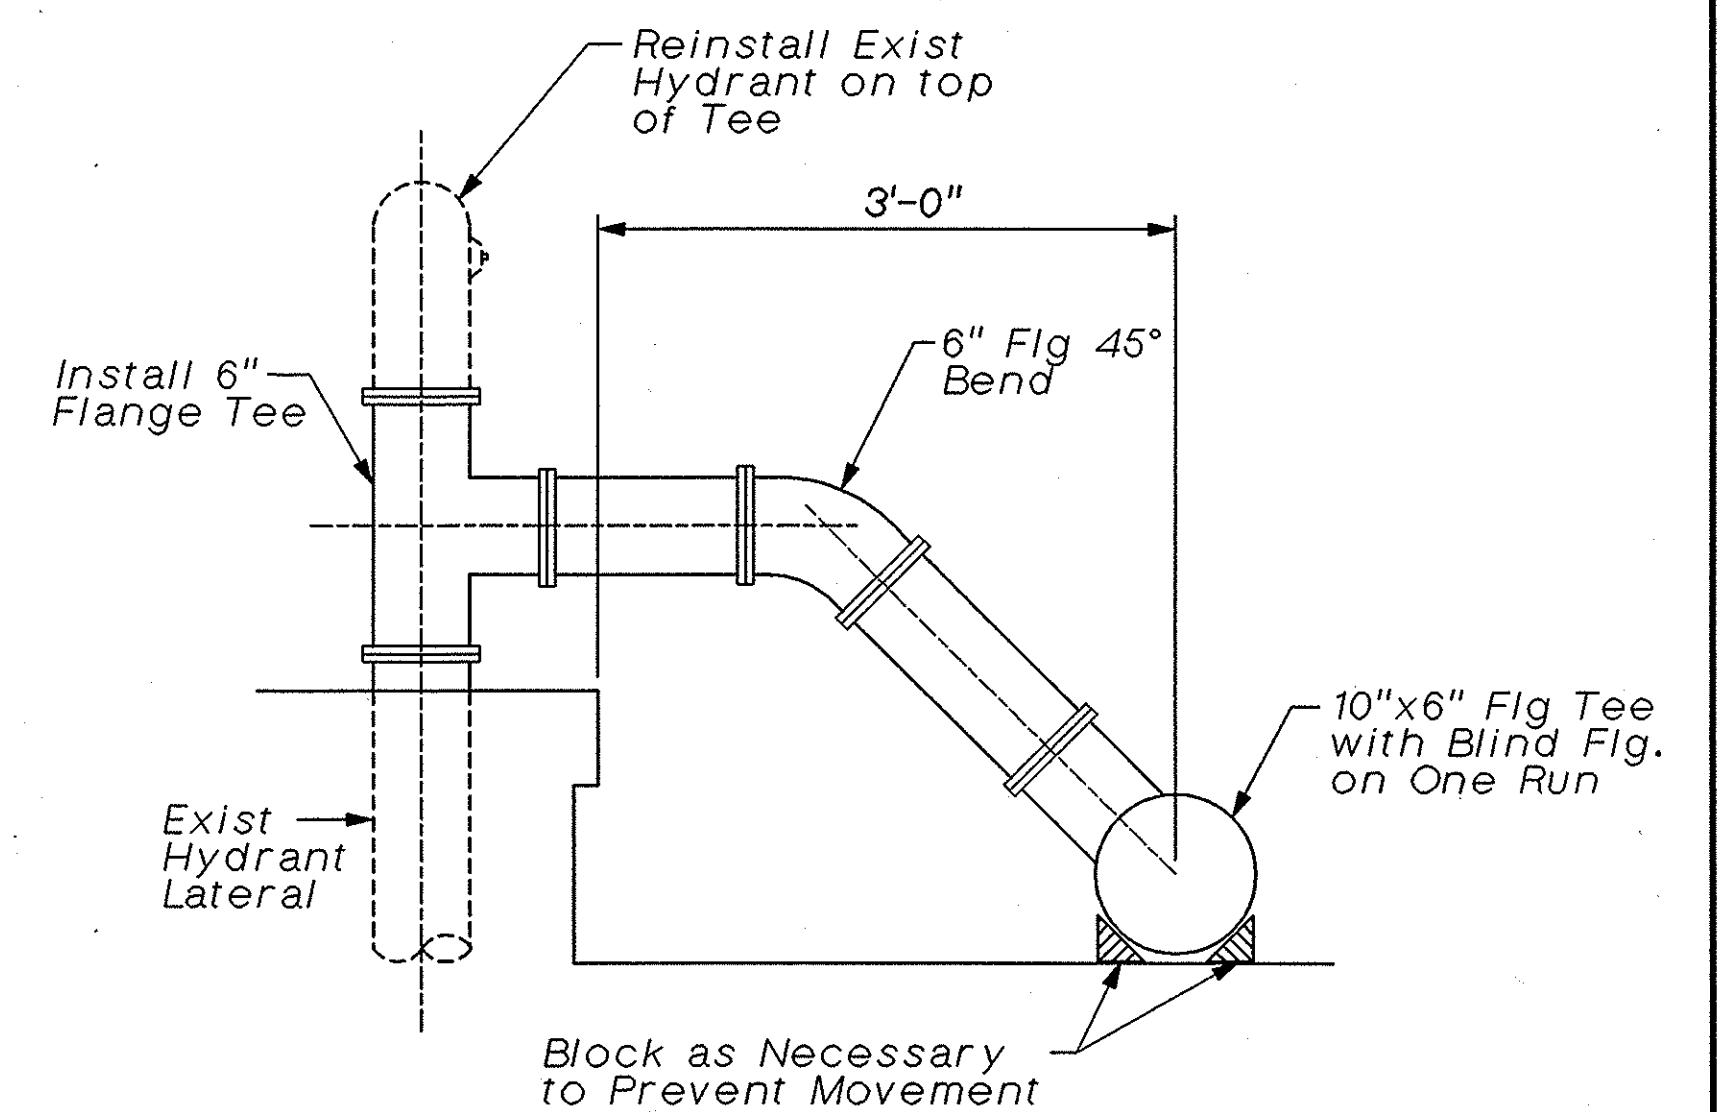

DETAIL 1
 SCALE: 1" = 1'-0"

Note: The Contract controlling ordering or

all verify all imensions before ating any material.

DESIGN	BY C. R. HULSE	CHECKED	CAPISTRANO BEACH WATER DISTRICT
DETAIL	BY	CHECKED	APPROVAL: <i>Donna E. Mack</i> DATE 11/20/98
SIGN	BY	CHECKED	

PREPARED FOR THE
 COUNTY OF
 ORANGE

C. RUSSELL HULSE
 PROJECT ENGINEER
 BOYLE ENGINEERING CORPORATION

BRIDGE NO.
 55C-0561
 POST MILE

EARTHQUAKE RETROFIT

DANA POINT HARBOR BRIDGE

WATER MAIN BYPASS AND REINSTALLATION

ORIGINAL SCALE IN INCHES
 FOR REDUCED PLANS

0 1 2 3

CU 12 152
 EA L02106
 CONTRACT NO. 59Y021

DISREGARD PRINTS BEARING
 EARLIER REVISION DATES

REVISION DATES (PRELIMINARY STAGE ONLY)

SHEET 11 OF 14