




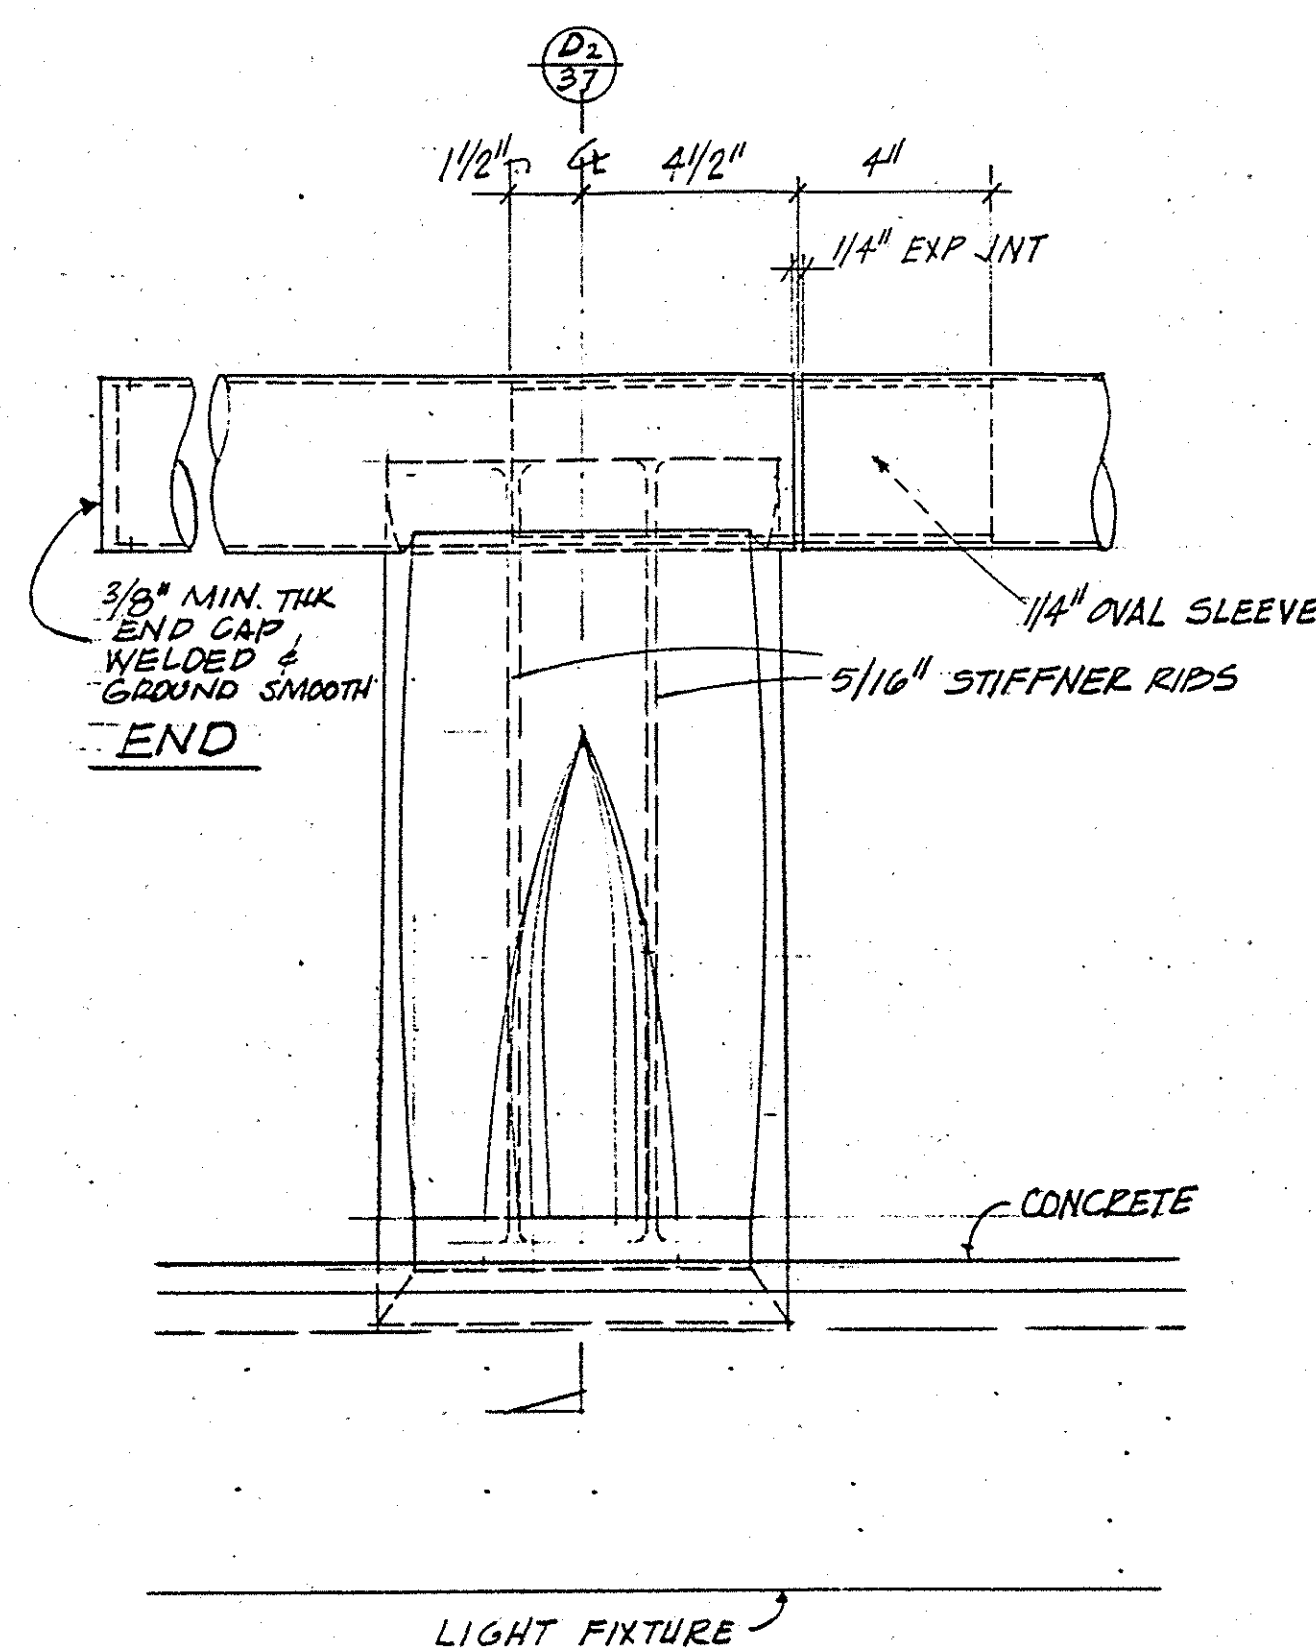

FRONT ELEVATION

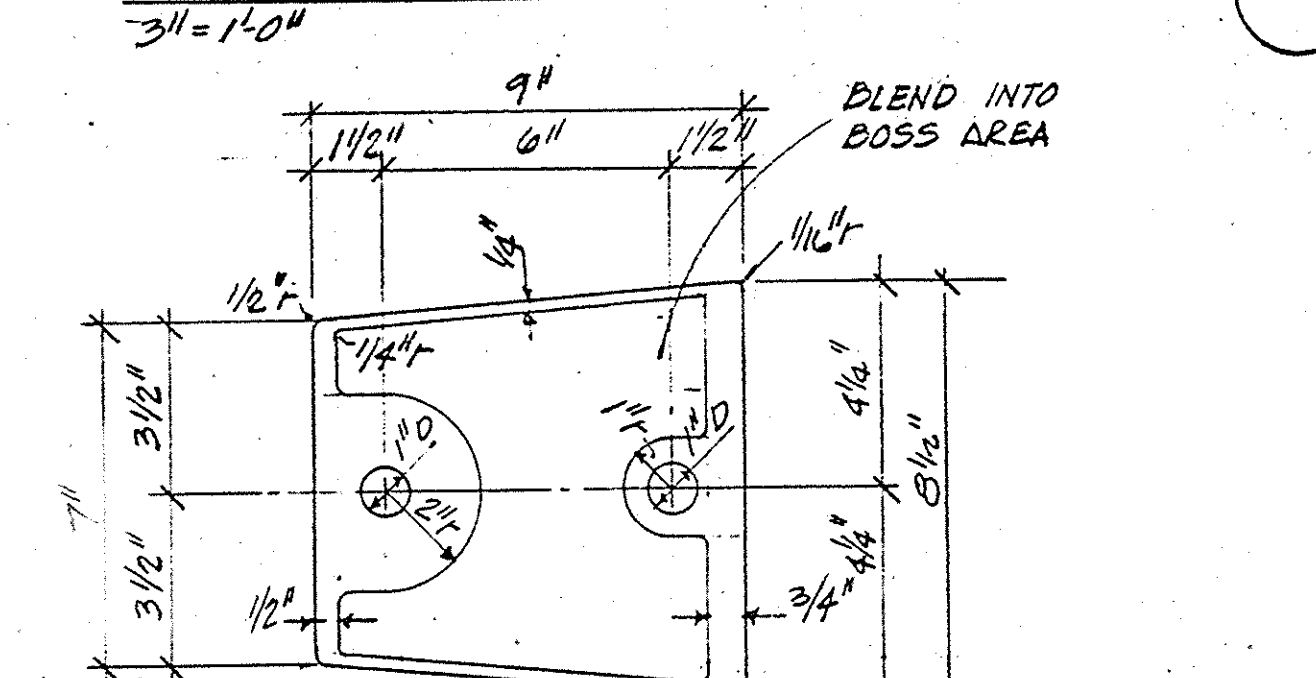


SECTION

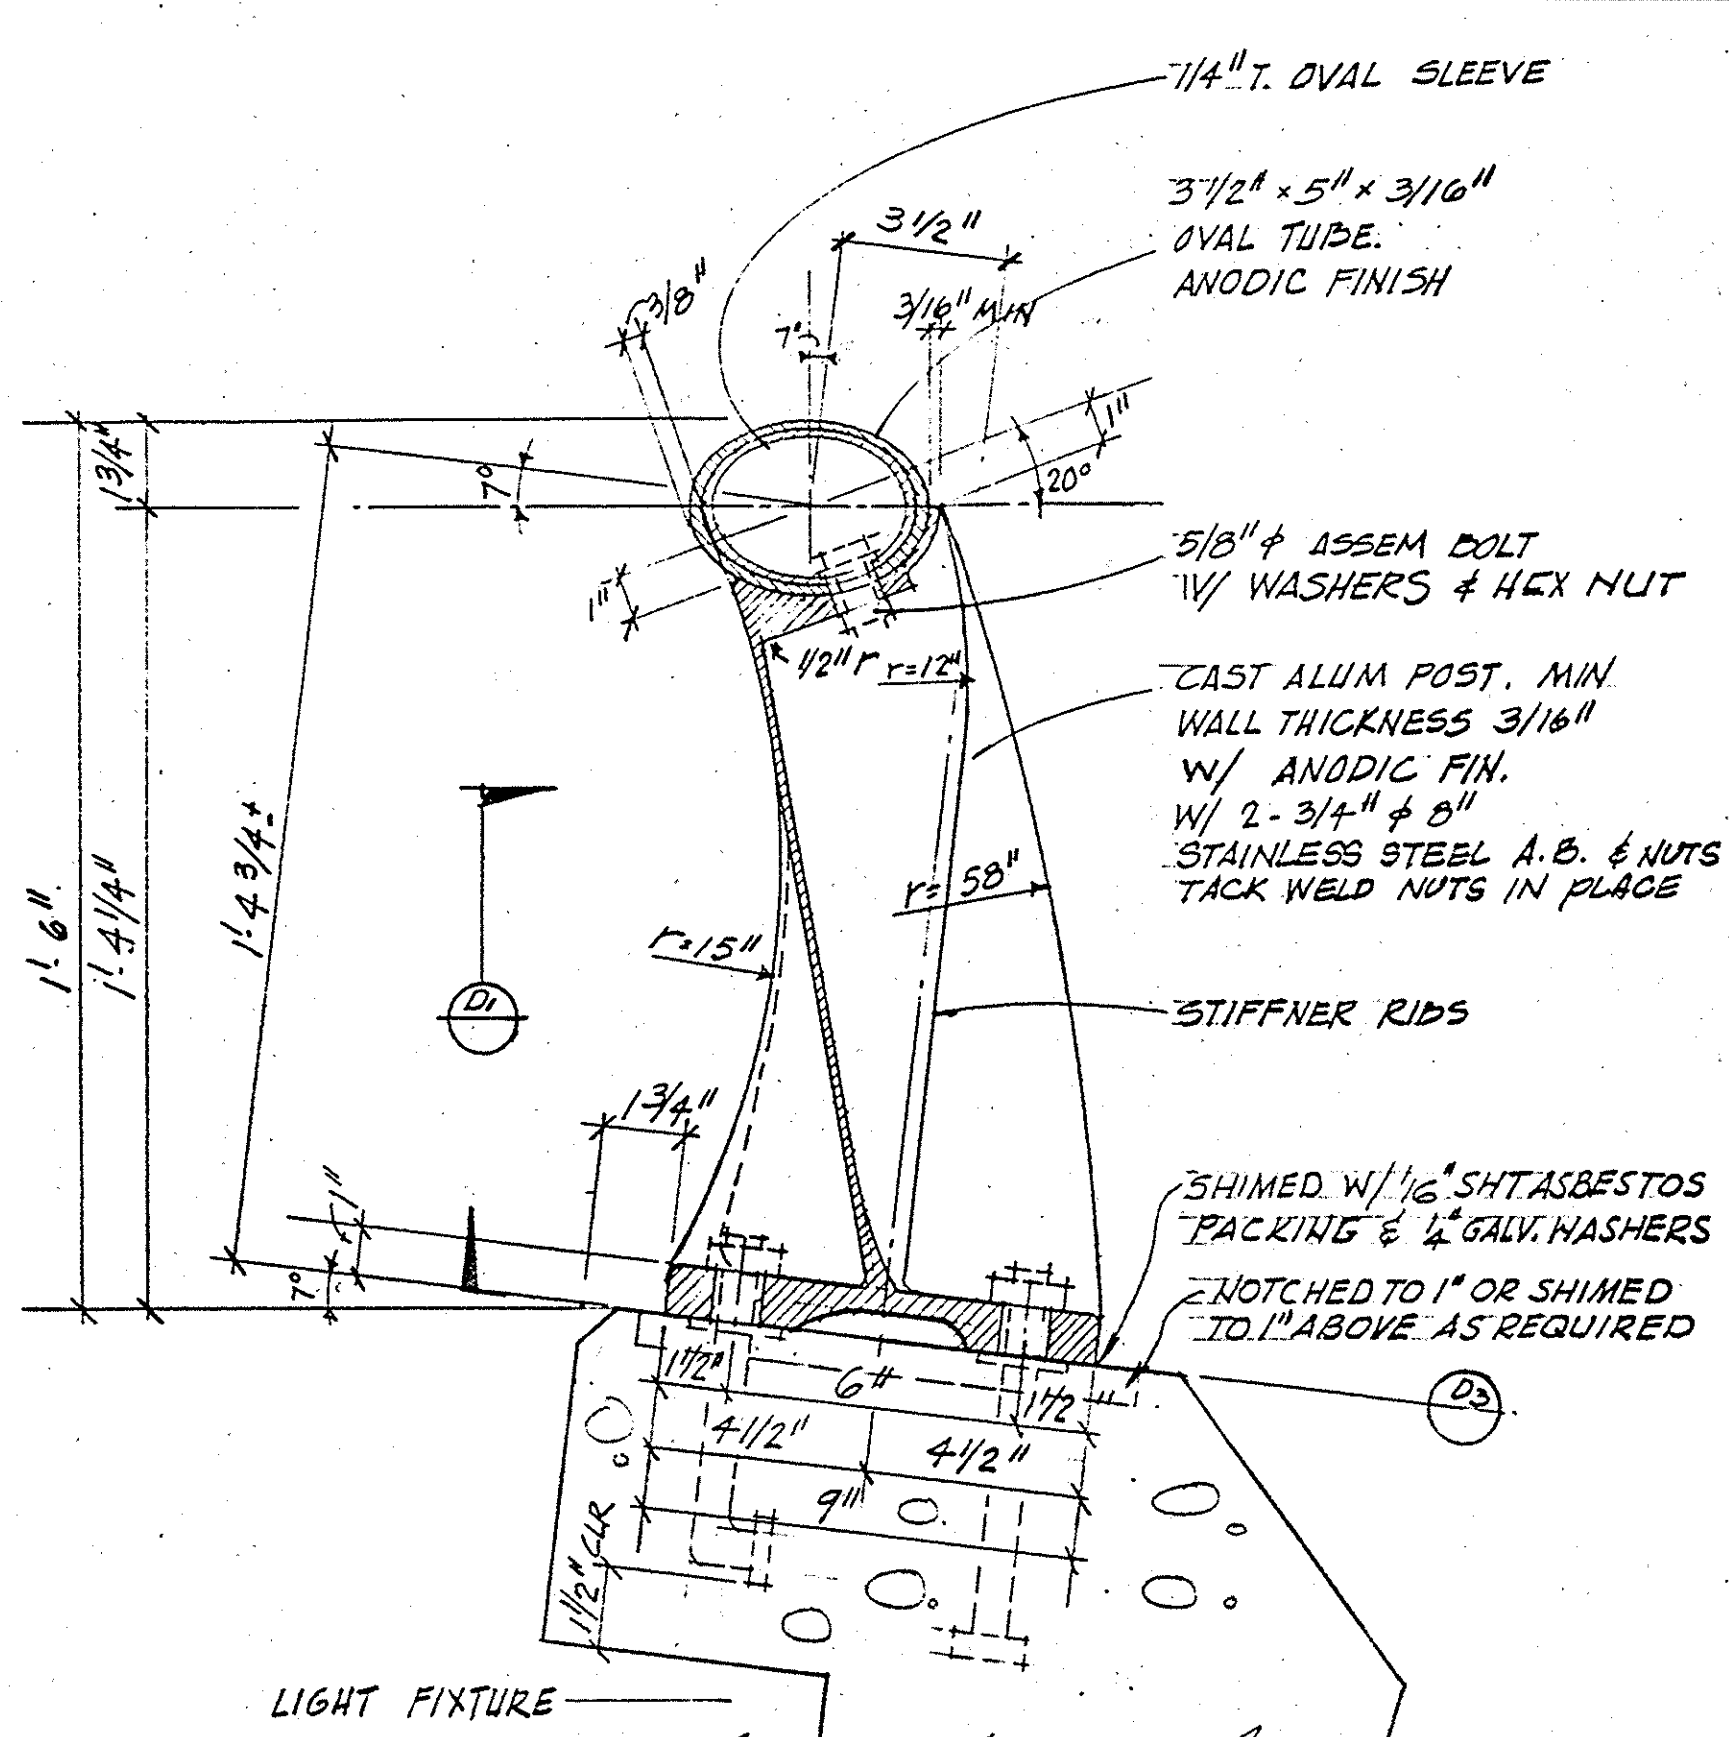


SECTION

NOTE: RAILING & POST SIM. TO (MIN. THICKNESS, RADIUS ETC) STATE OF CALIFORNIA, DEPT OF PUBLIC WORKS, DIVISION OF HIGHWAYS, SINGLE RAIL POST. REFER TO BRIDGE PLANNING AND DESIGN MANUAL, VOL II STANDARD PLANS, AUG. 1965. PAGE 11-2 BARRIER RAILING DETAILS. DIMENSIONS SHOWN HEREIN GOVERN.



R A I L I N G
D E T A I L S

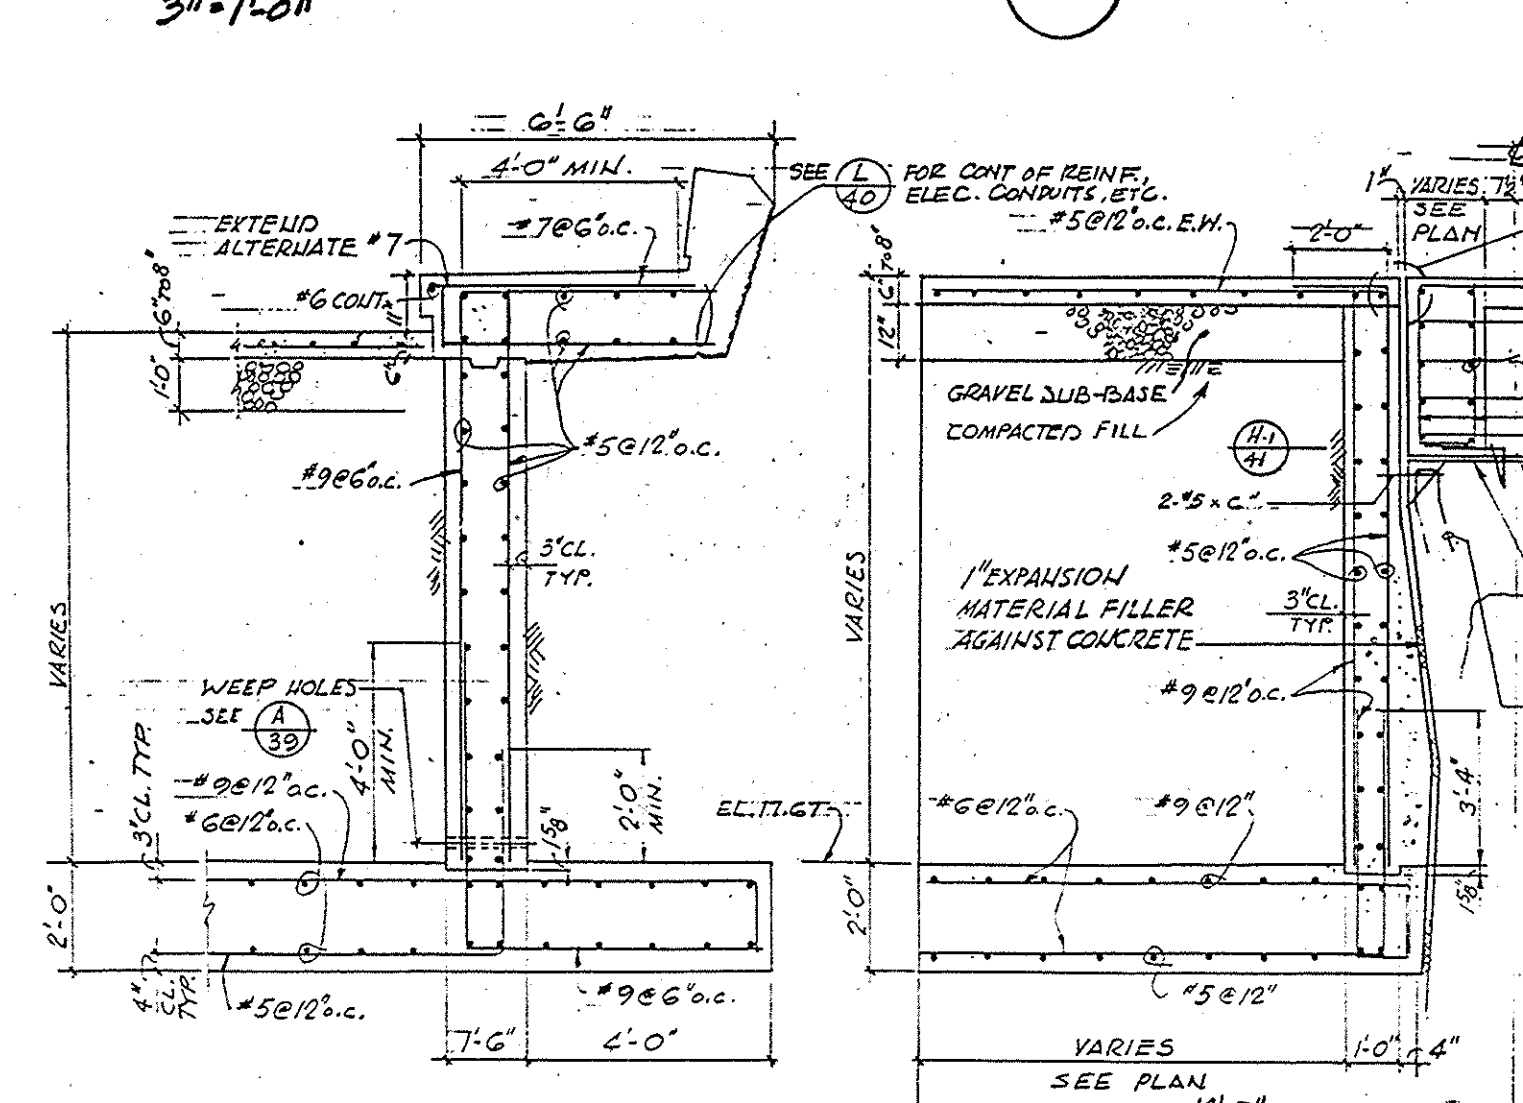

SECTION

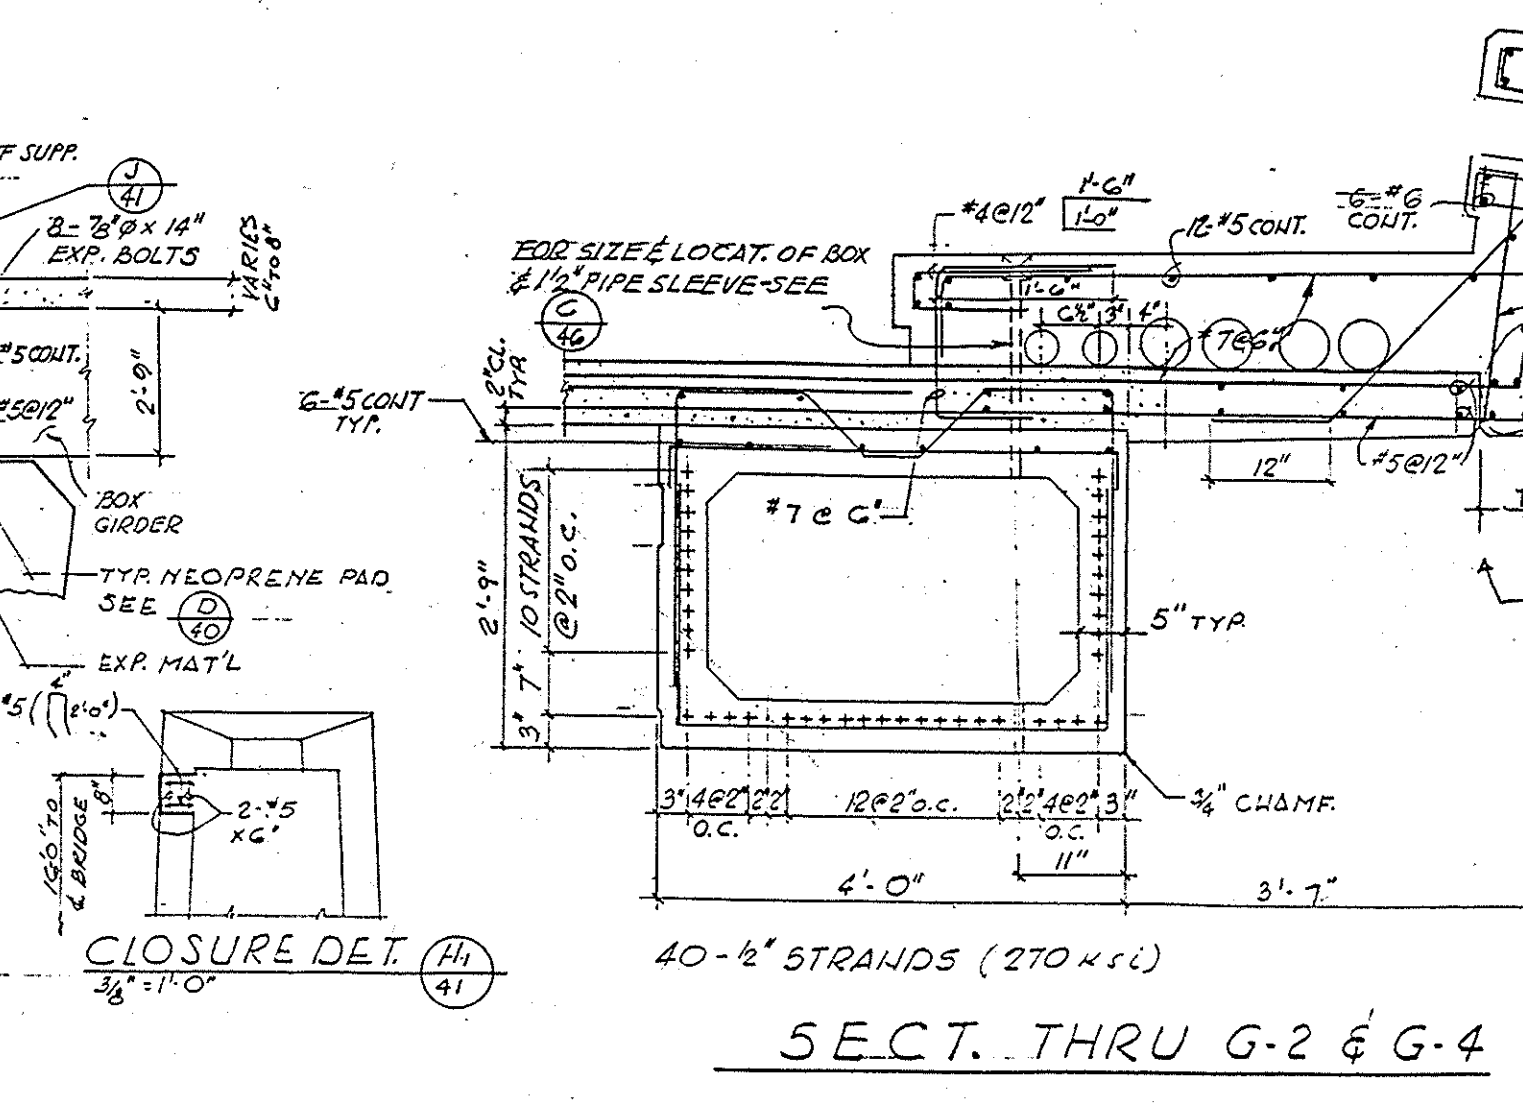

EXISTING BARRIER RAIL, SIDEWALK AND APPROACH DETAILS
Not to Scale

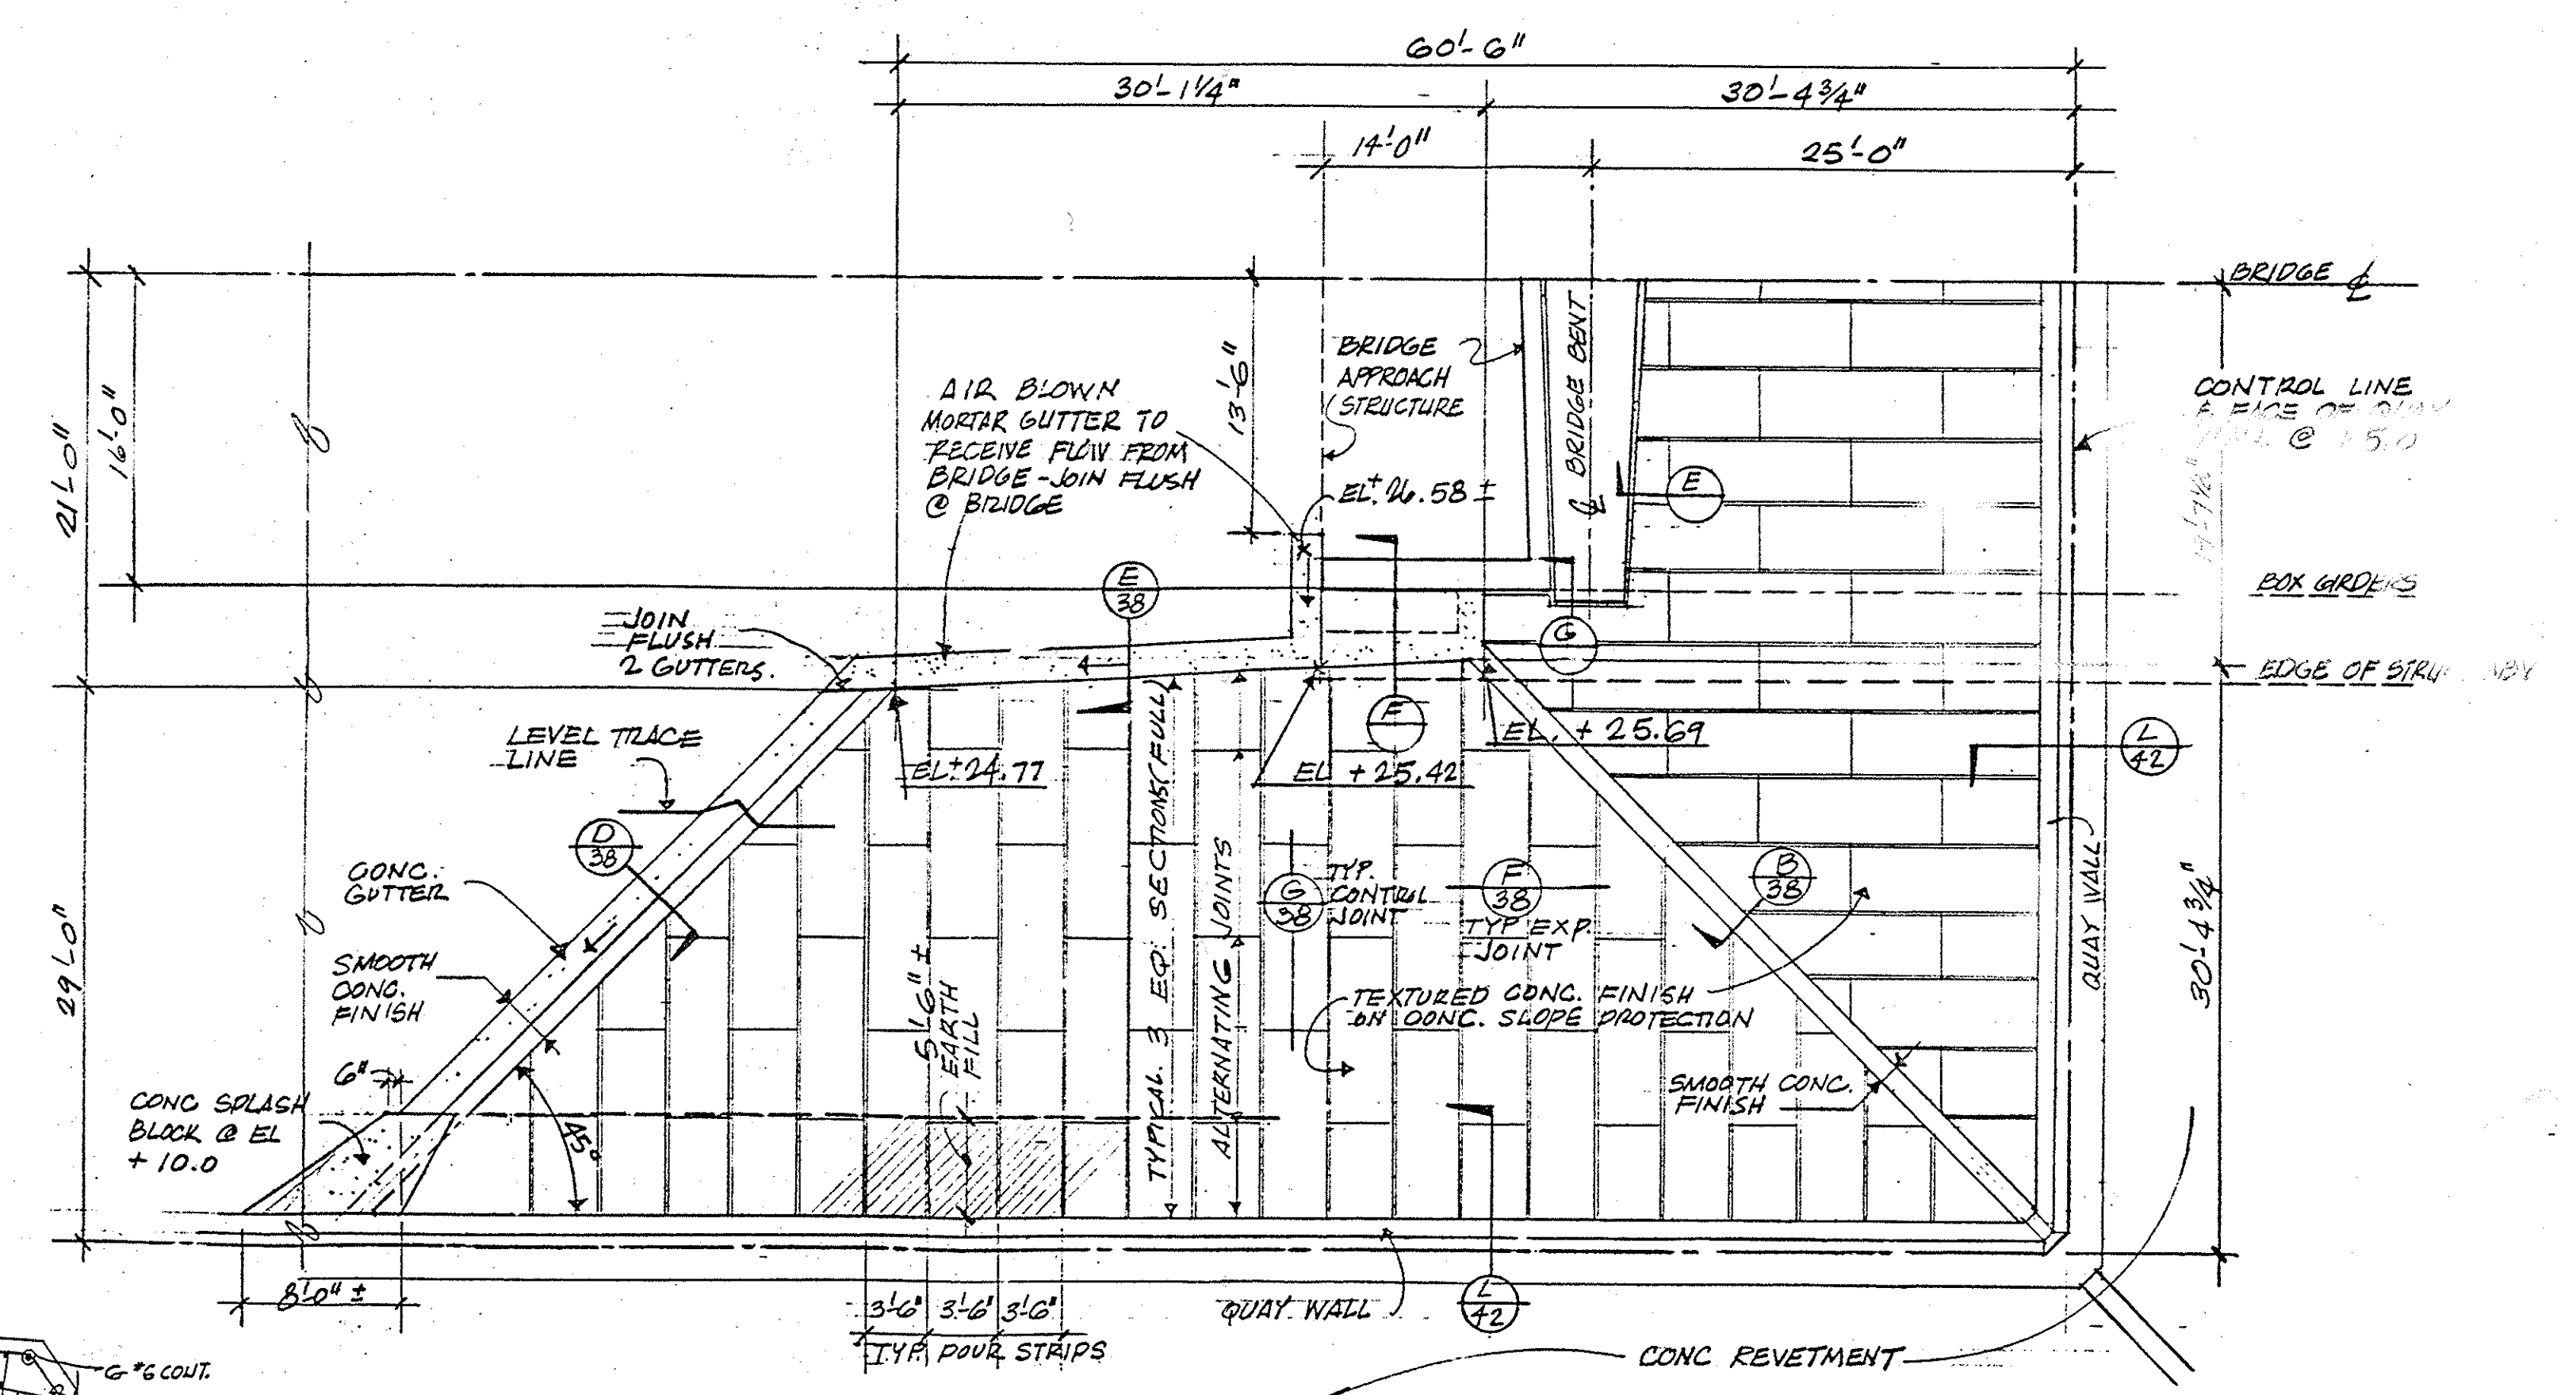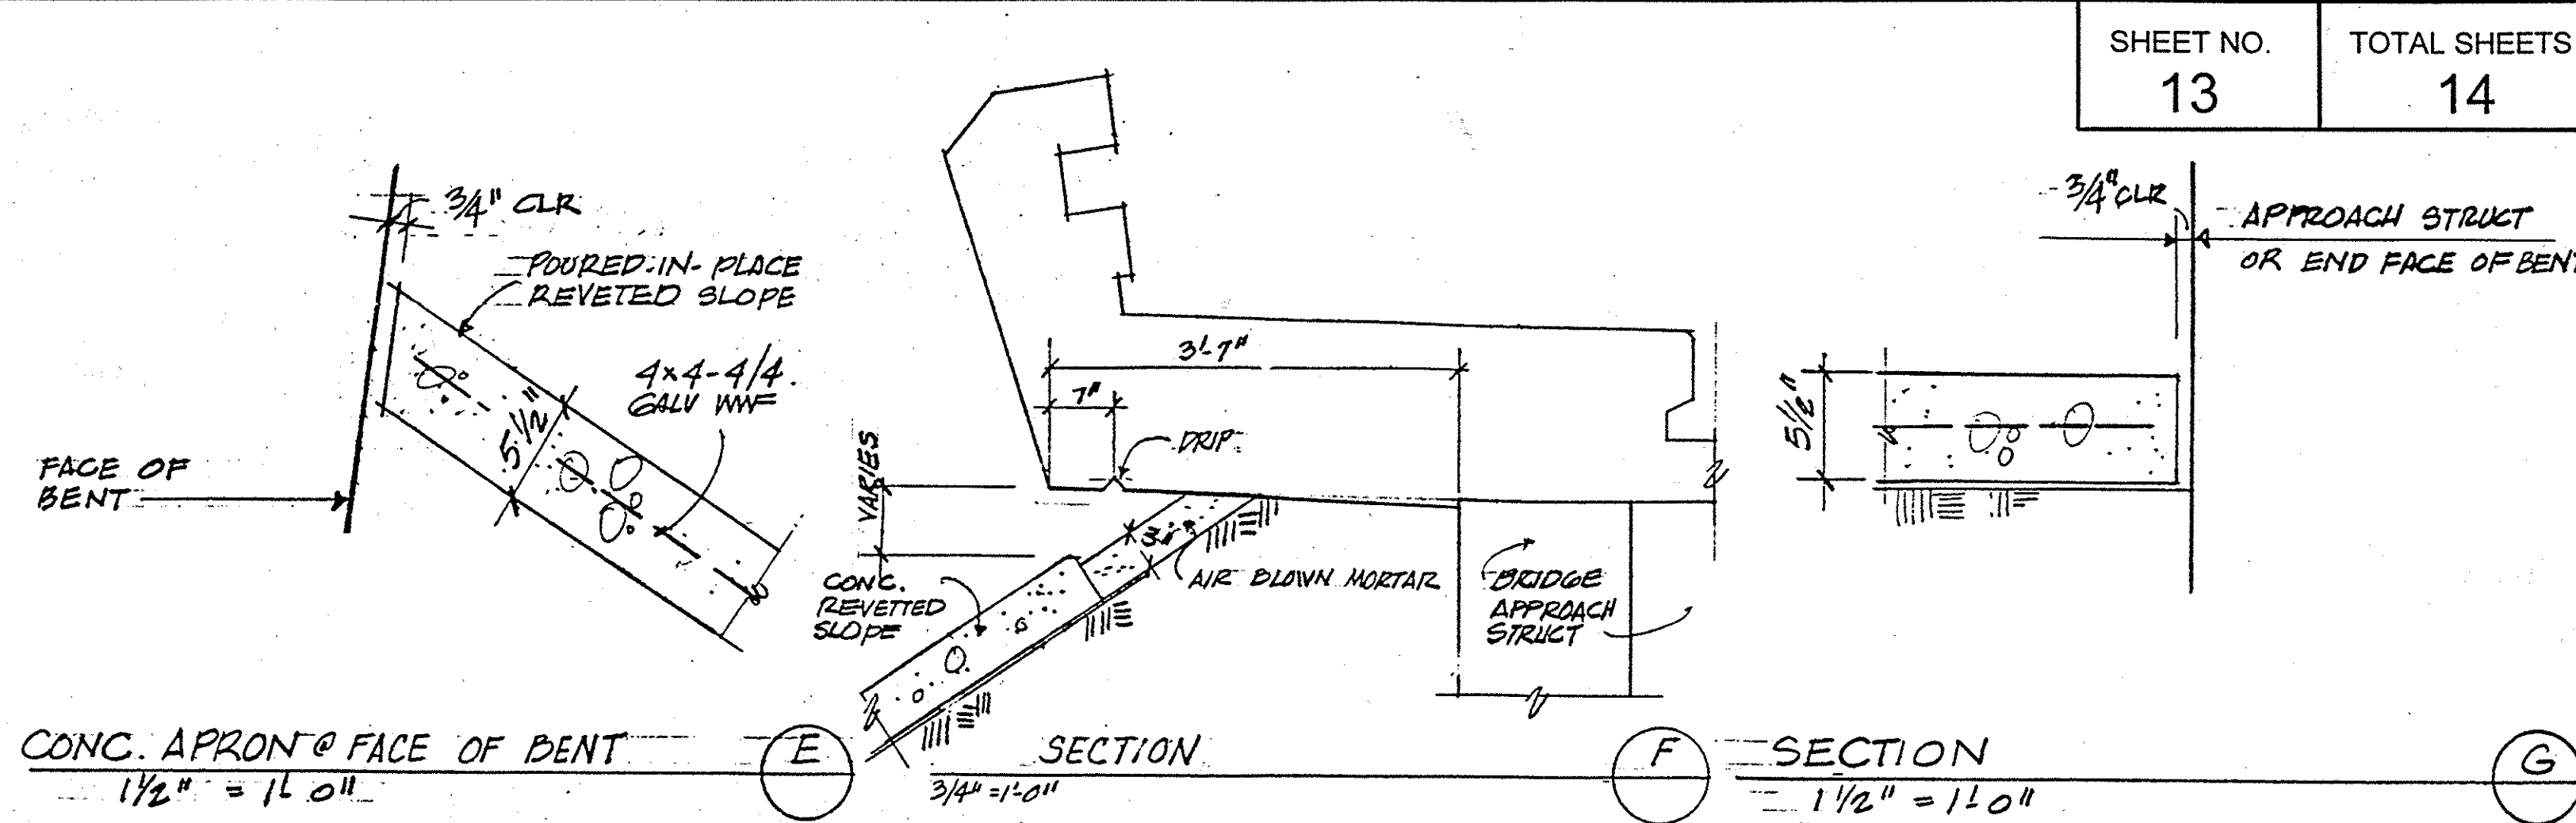

PARTIAL PLAN OF REVETTED SLOPE @ BRIDGE SUPPORT

NOTE TO CONTRACTORS:
This sheet represents information and details taken from various sheets of the original full size RECORD DRAWINGS for the construction plans for the Dana Point Harbor Heavy Construction Bridge D 10.5-1, dated October, 1968. The details hereon are to be used and referenced by the CONTRACTOR for the removal and replacement of the existing barrier rail and hand railing, sidewalk and slope paving. See also the Special Provisions for more information on these work items.

XX REFERS TO DETAIL AND SHEET #
WITHIN ORIGINAL PLANS

AS BUILT

CORRECTIONS BY G. Zaun / WPN
CONTRACT NO. 100-000000-0000
DATE 03-02

NO AS BUILT CHANGES

ORANGE COUNTY PUBLIC FACILITIES AND RESOURCES DEPARTMENT	
EARTHQUAKE RETROFIT	
DANA POINT HARBOR BRIDGE	
MISCELLANEOUS EXISTING BARRIER RAILING, SIDEWALK AND APPROACH DETAILS	
DESIGNED	CHECKED
SCALE	DRAWING NO.
DATE	