


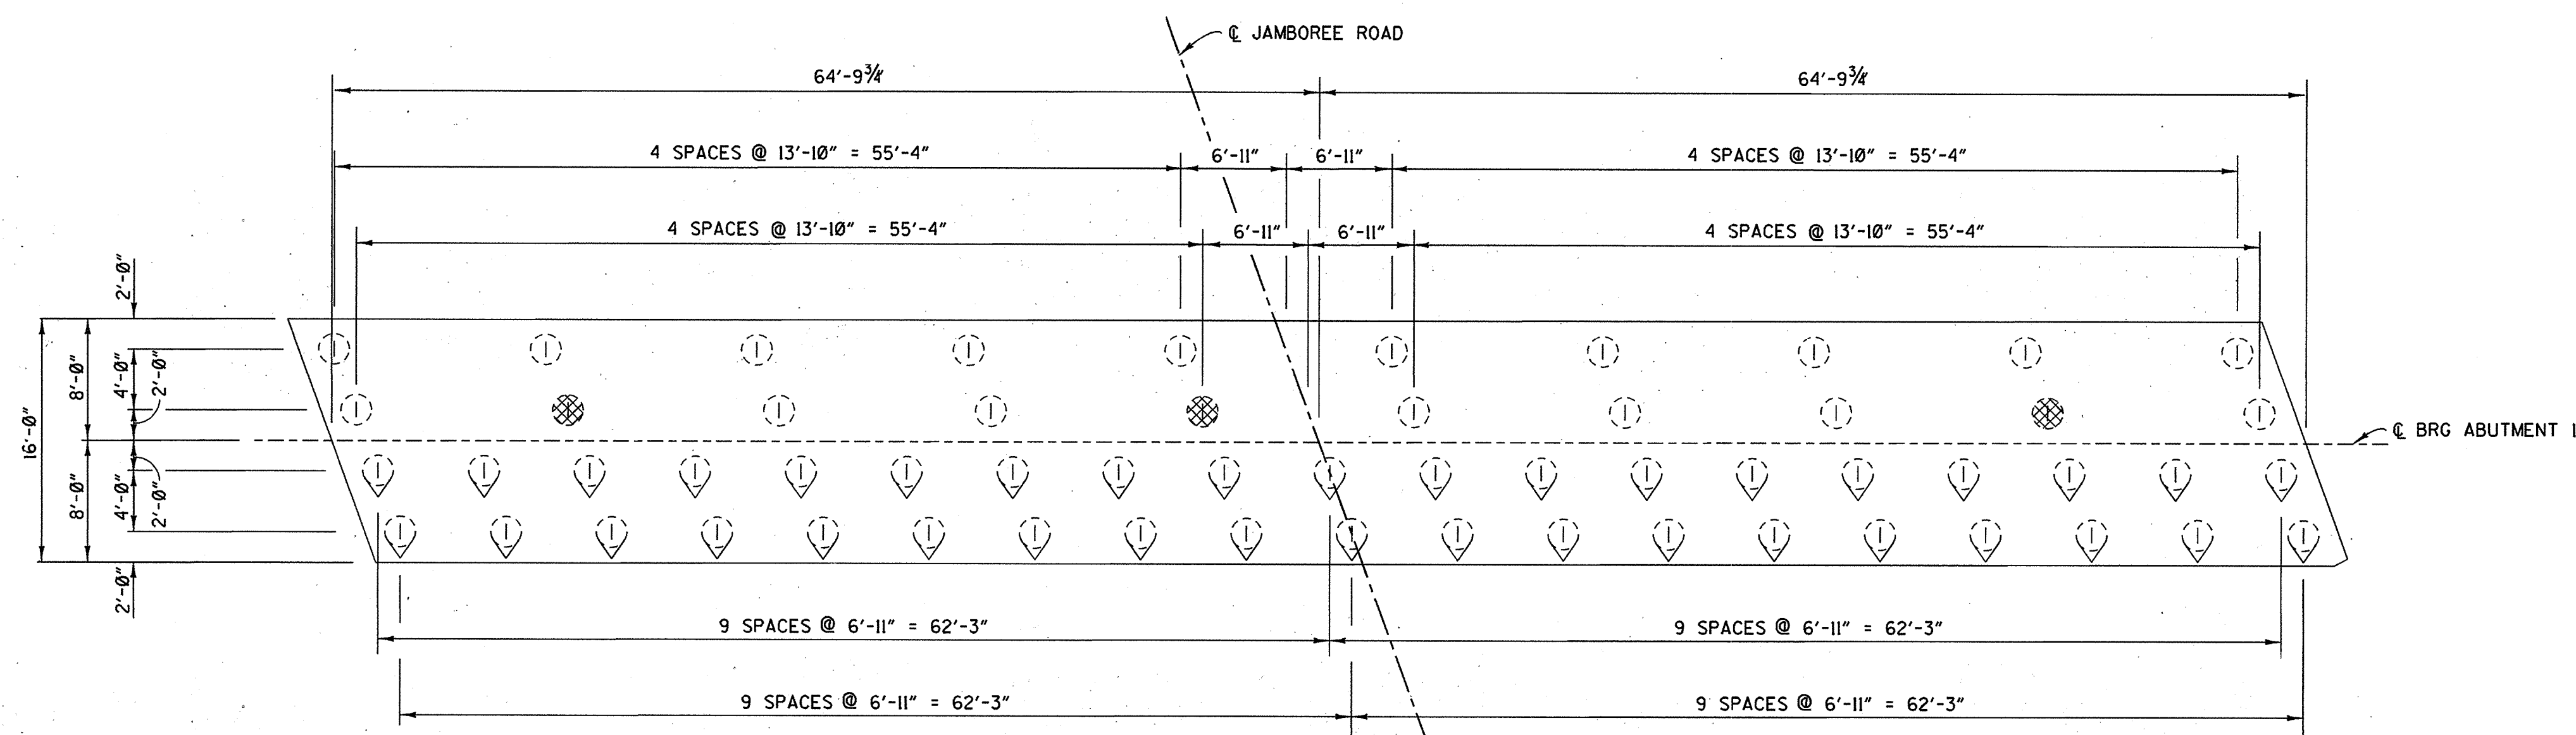


ABUTMENT 1 PILE LAYOUT

1/8" = 1'-0"

LEGEND

- VERTICAL PILE
- △ 1:3 BATTERED PILE
- ⊗ INDICATOR PILE

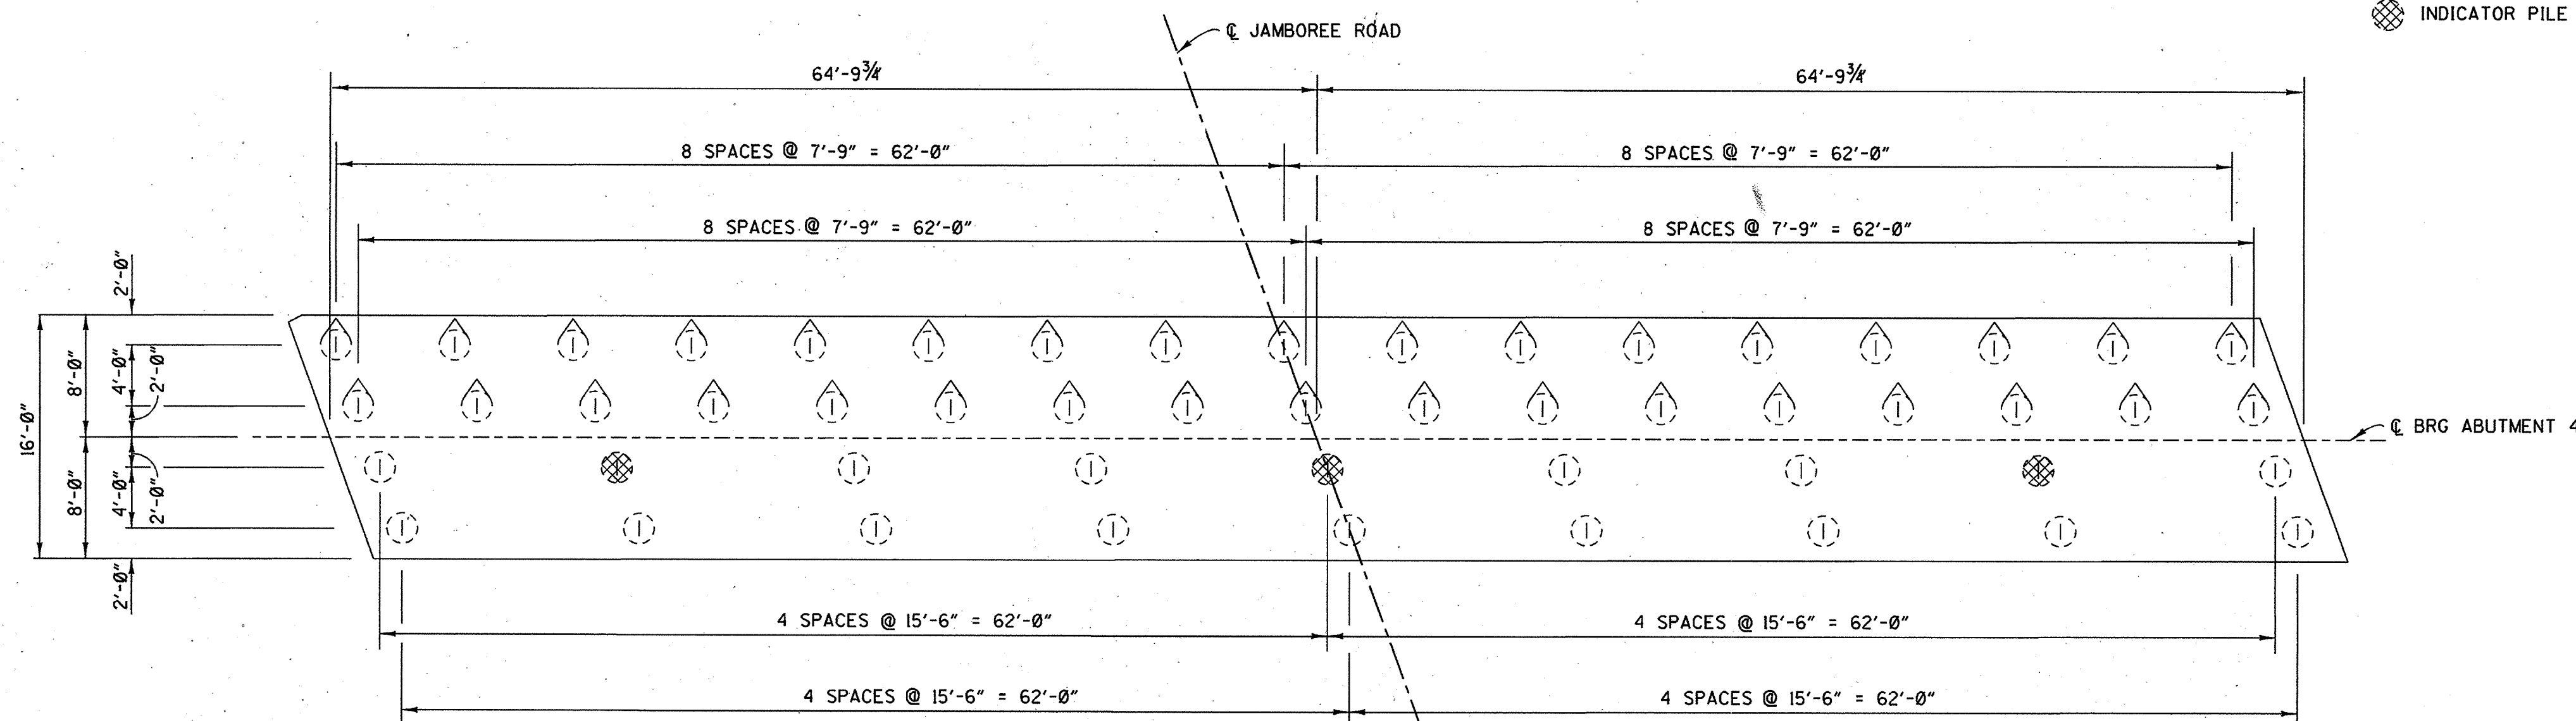

ABUTMENT 4 PILE LAYOUT

1/8" = 1'-0"

URS GREINER, INC.
1241 EAST DYER ROAD, SUITE 250
SANTA ANA, CALIFORNIA 92705-5605

ORANGE COUNTY ENVIRONMENTAL MANAGEMENT AGENCY		
JAMBOREE ROAD GRADE SEPARATION AT EDINGER AVENUE		
PILE LAYOUT		
DESIGNED J.W.	CHECKED C.L.R.	SHEET 102
DRAWN A. GOMEZ	DATE 6-97	DRAWING NO. 130
SCALE AS SHOWN	DATE 5-97	

DR. 1 (16157)