




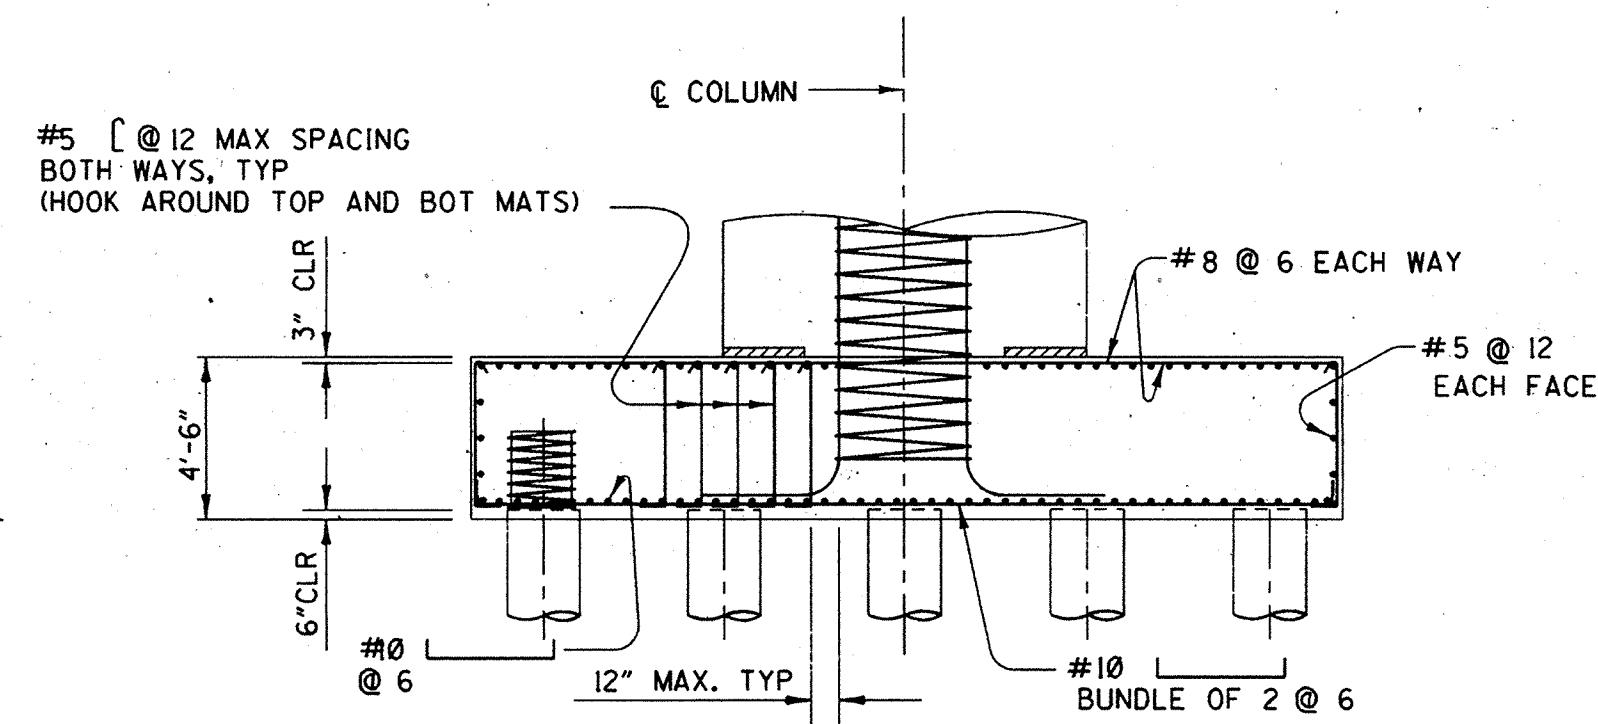


ELEVATION

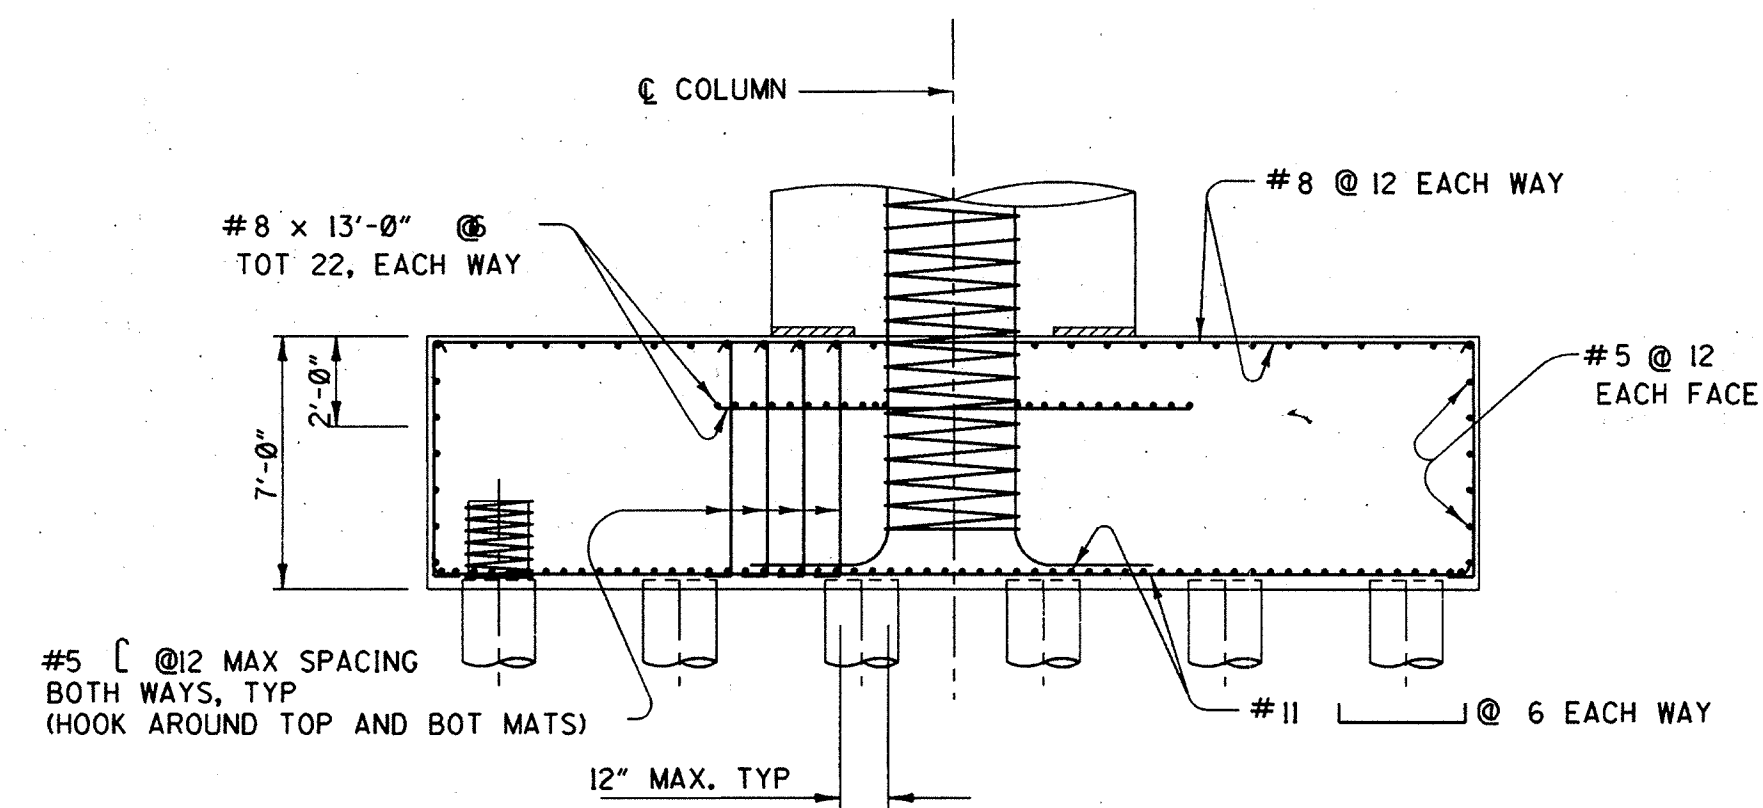


ELEVATION

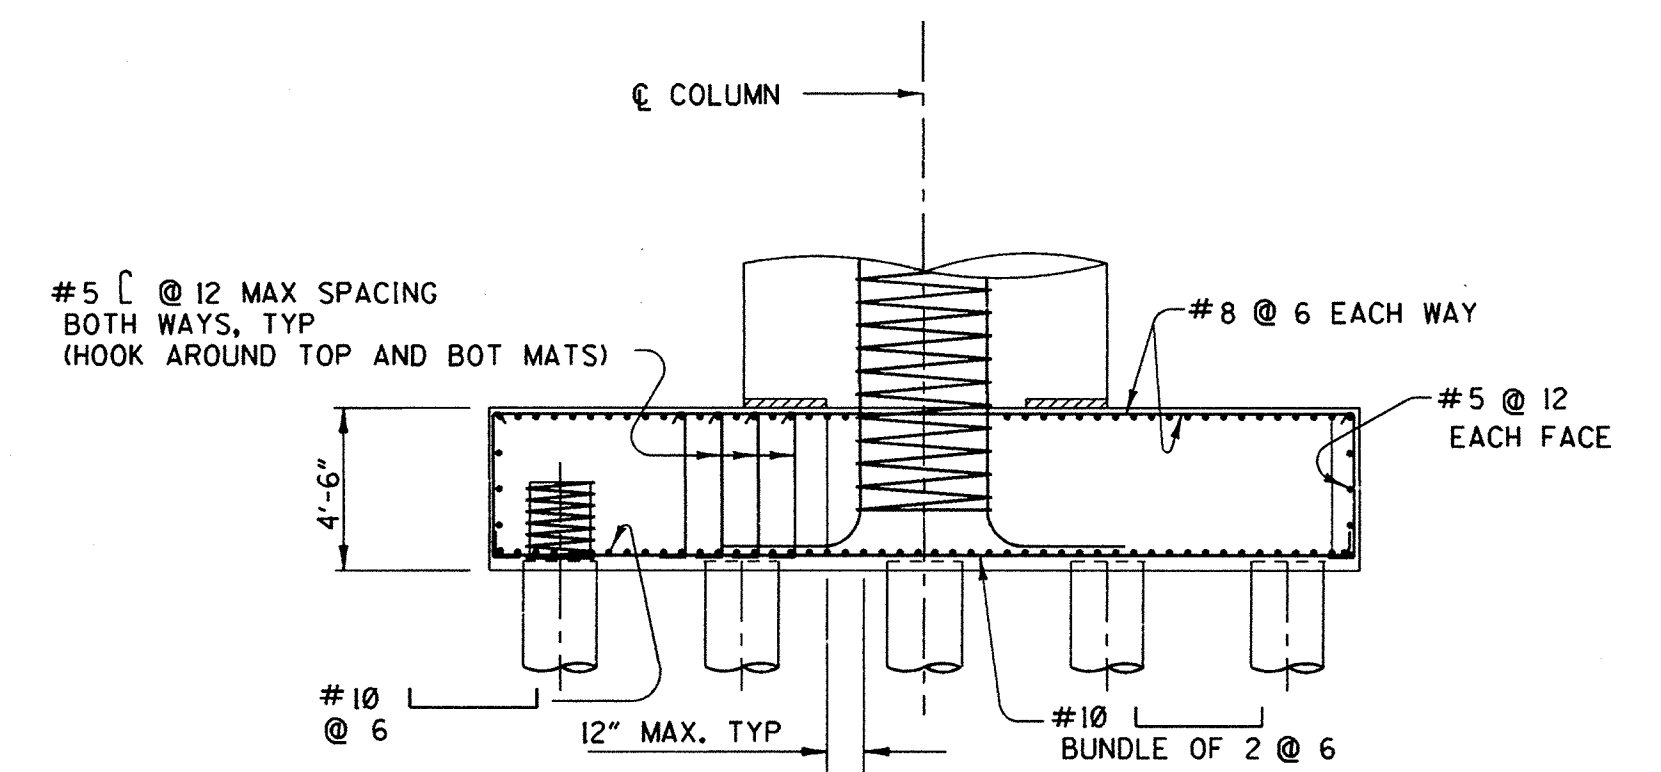

ELEVATION

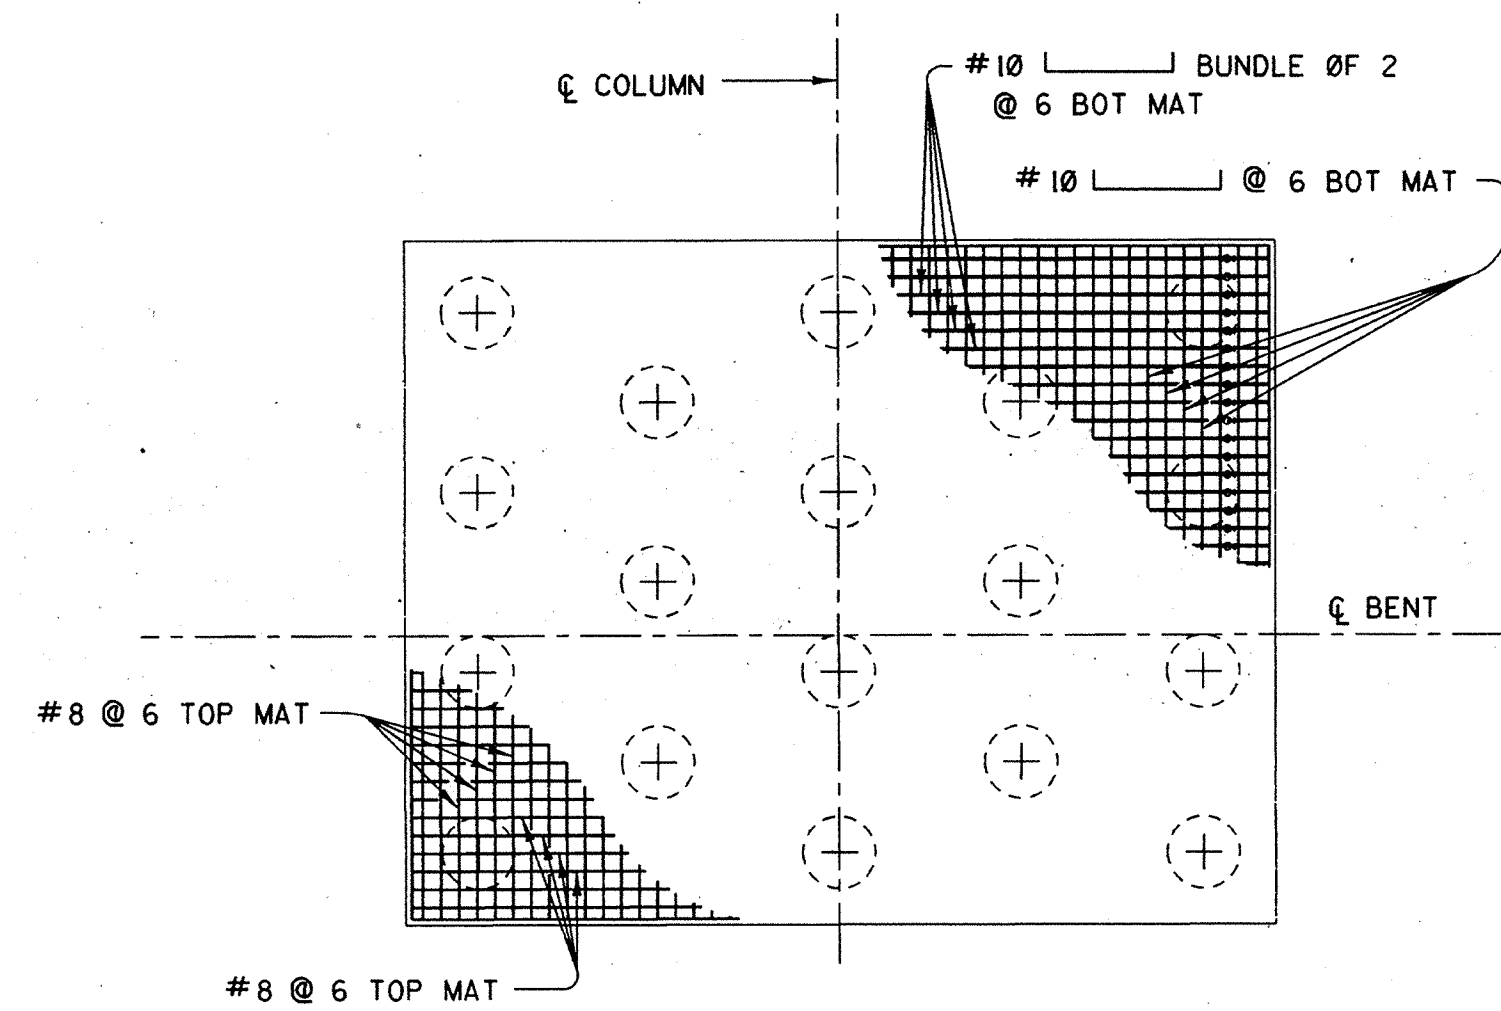


PLAN
FOOTING 2L

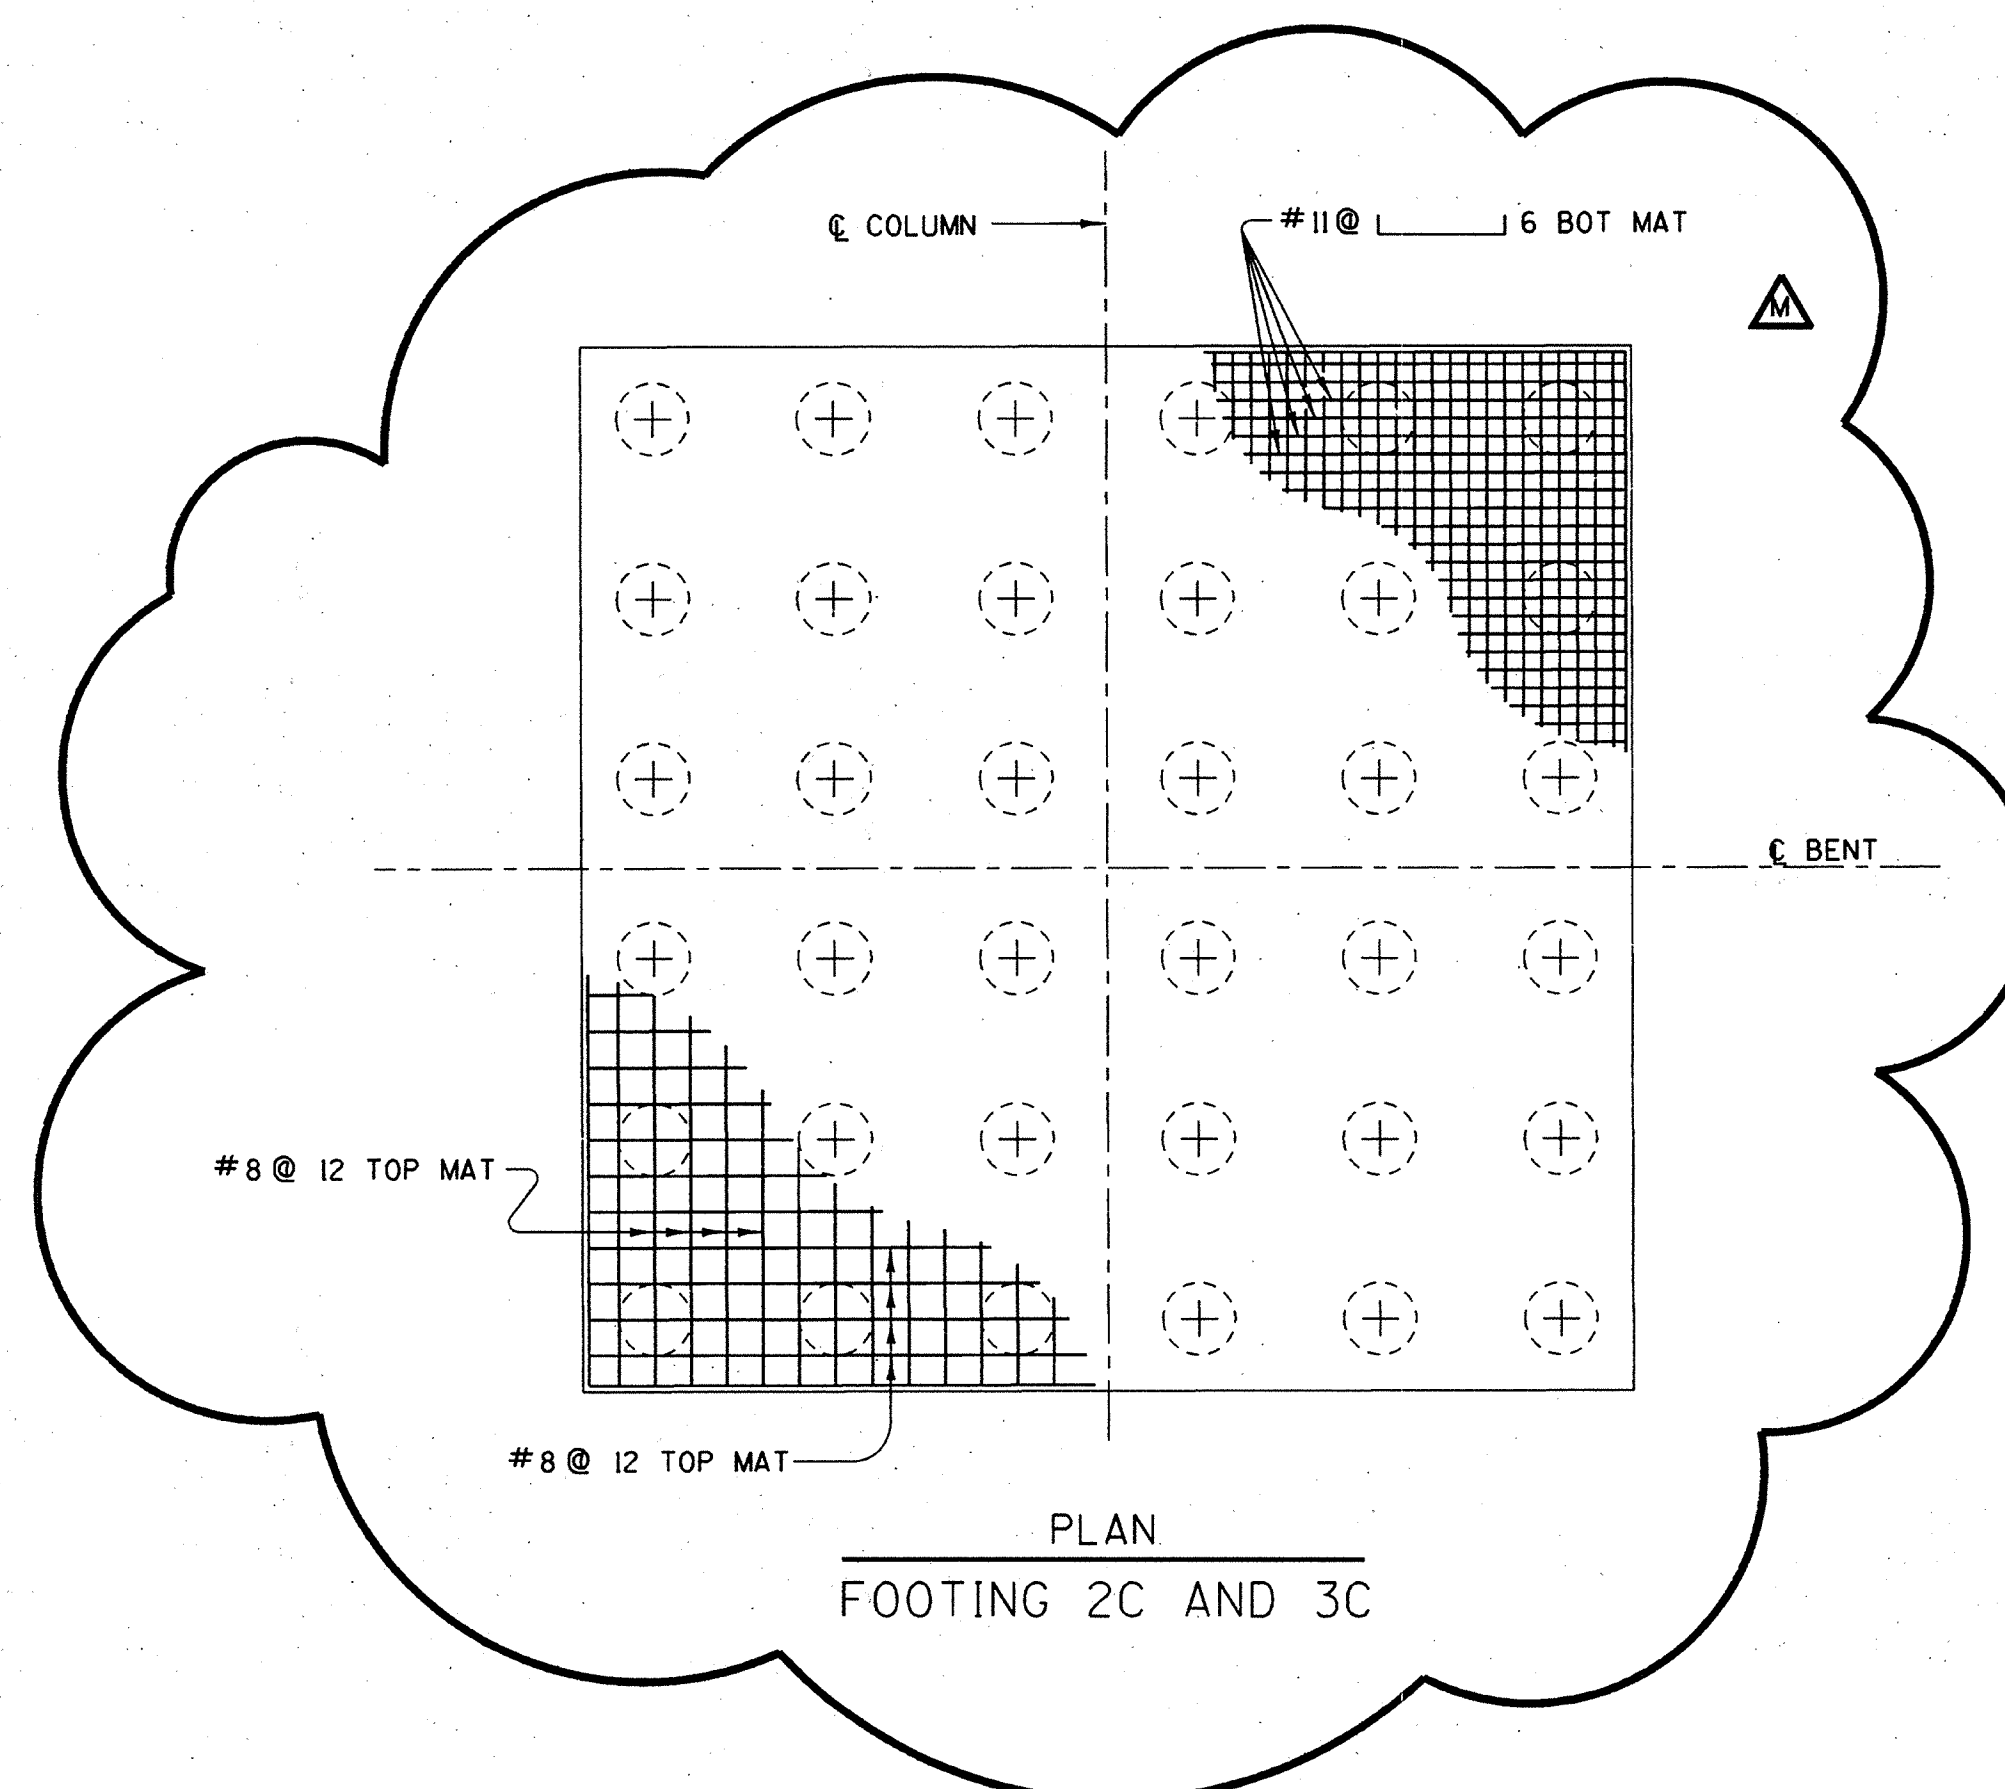

PLAN
FOOTING 2C AND 3C

BENT FOOTINGS

$\frac{3}{16}'' = 1'-0''$

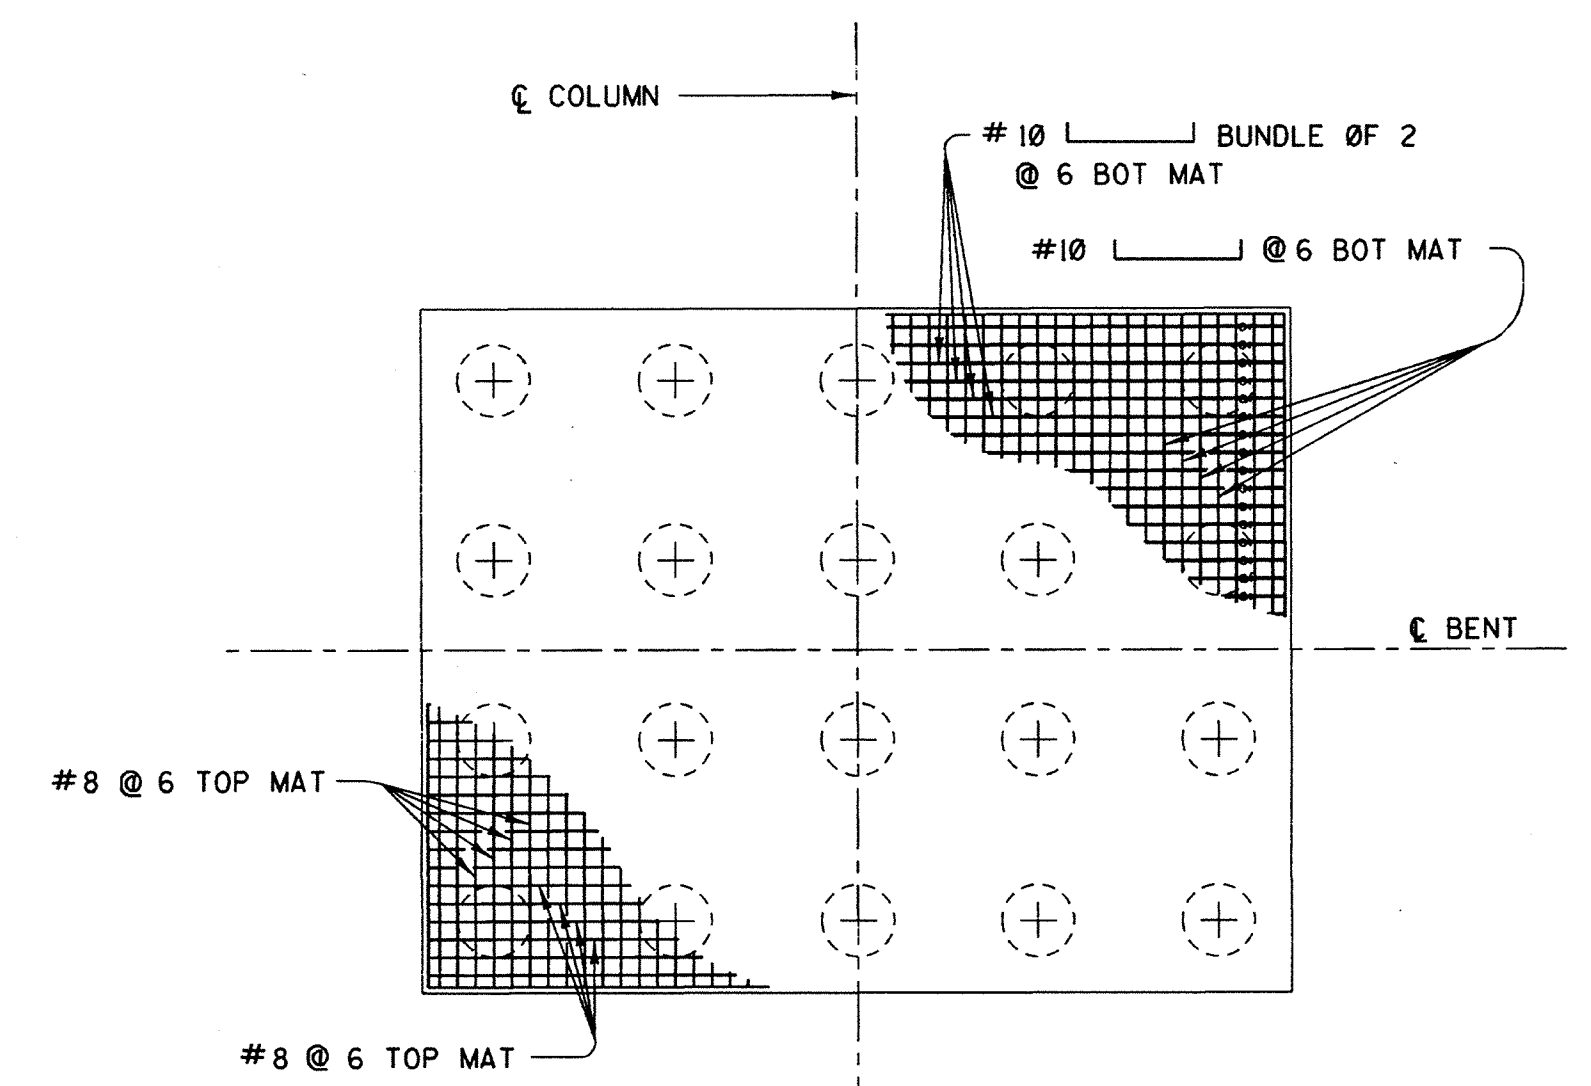

PLAN
FOOTING 2R, 3L, AND 3R

URS GREINER, INC.
1241 EAST DYER ROAD, SUITE 250
SANTA ANA, CALIFORNIA 92705-5605

		8-5-98 Revision per Bulletins #2 and #3		ORANGE COUNTY ENVIRONMENTAL MANAGEMENT AGENCY	
MARK DATE DESCRIPTION		REVISIONS		JAMBOREE ROAD GRADE SEPARATION AT EDINGER AVENUE	
PREPARED UNDER RESPONSIBLE CHARGE OF:		DESIGNED: J.W.		BENTS 2 & 3 FOOTING REINFORCEMENT DETAILS	
SCALE AS SHOWN		DATE 5-97		DRAWING NO. 104	
CHECKED: G.L.R.		DATE 6-97		SHEET 104 OF 130	

DR. 1 (16157)