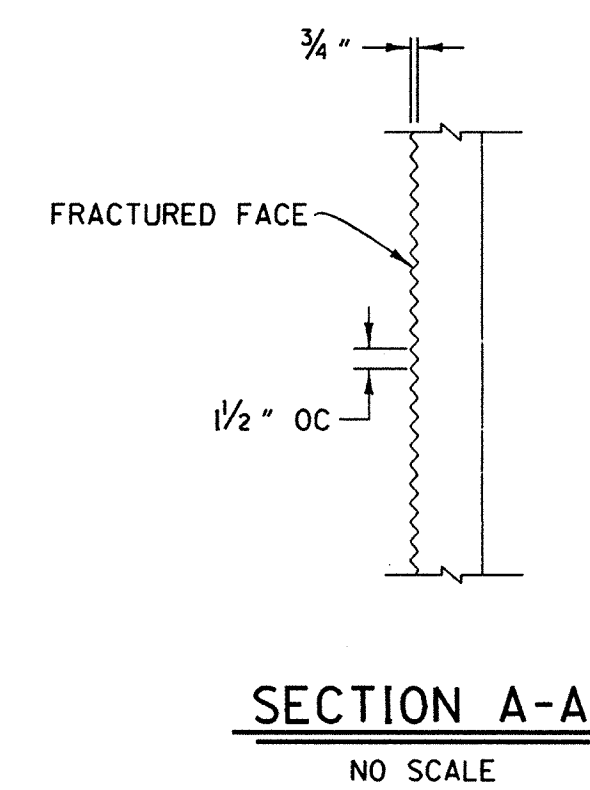
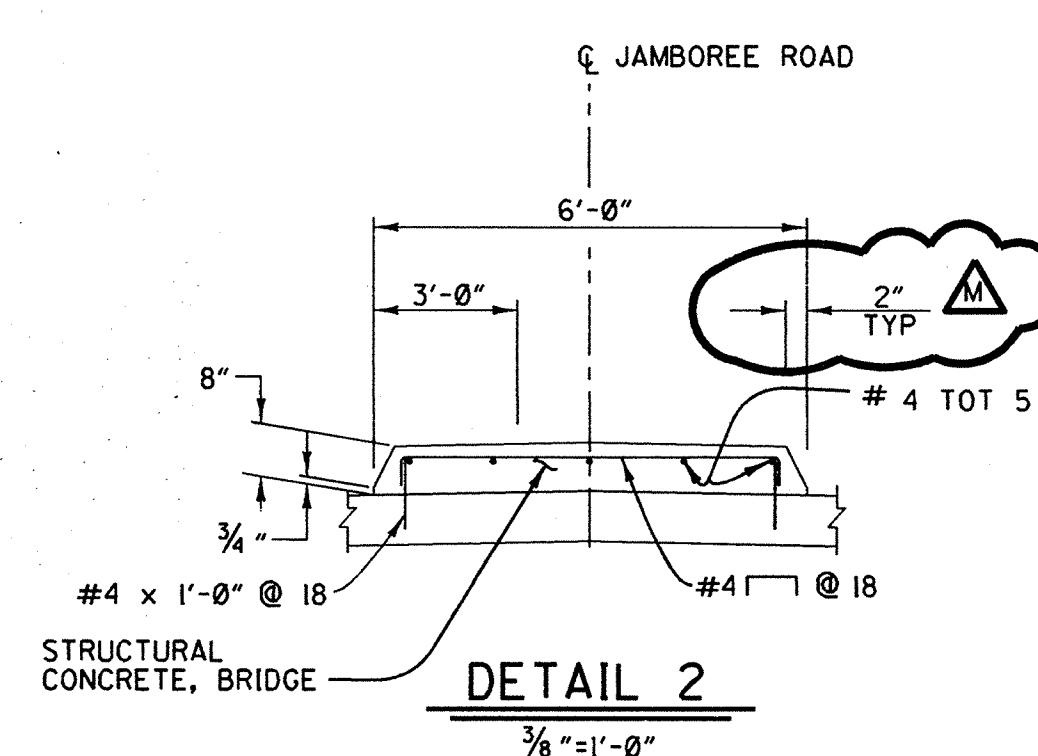
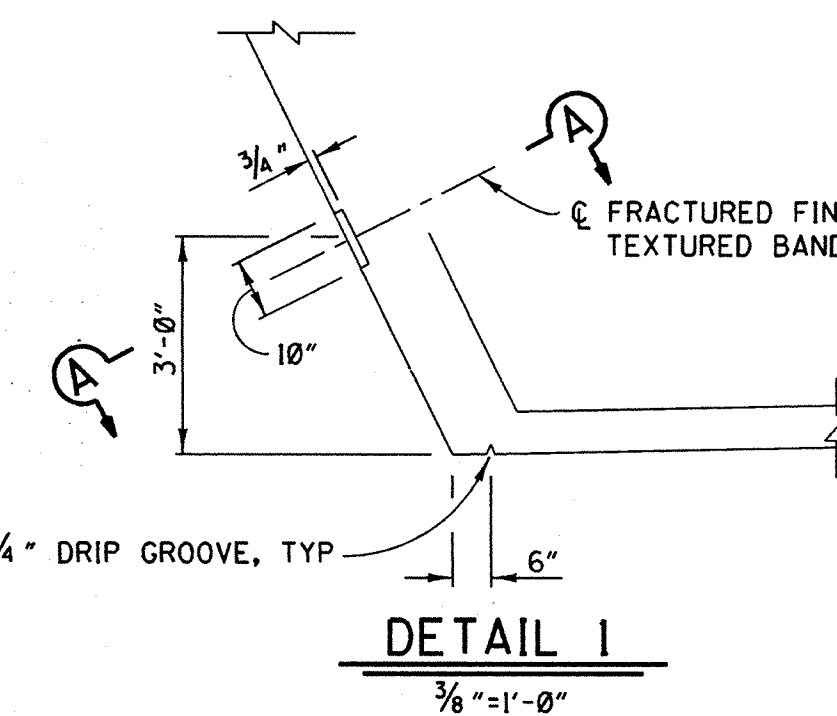
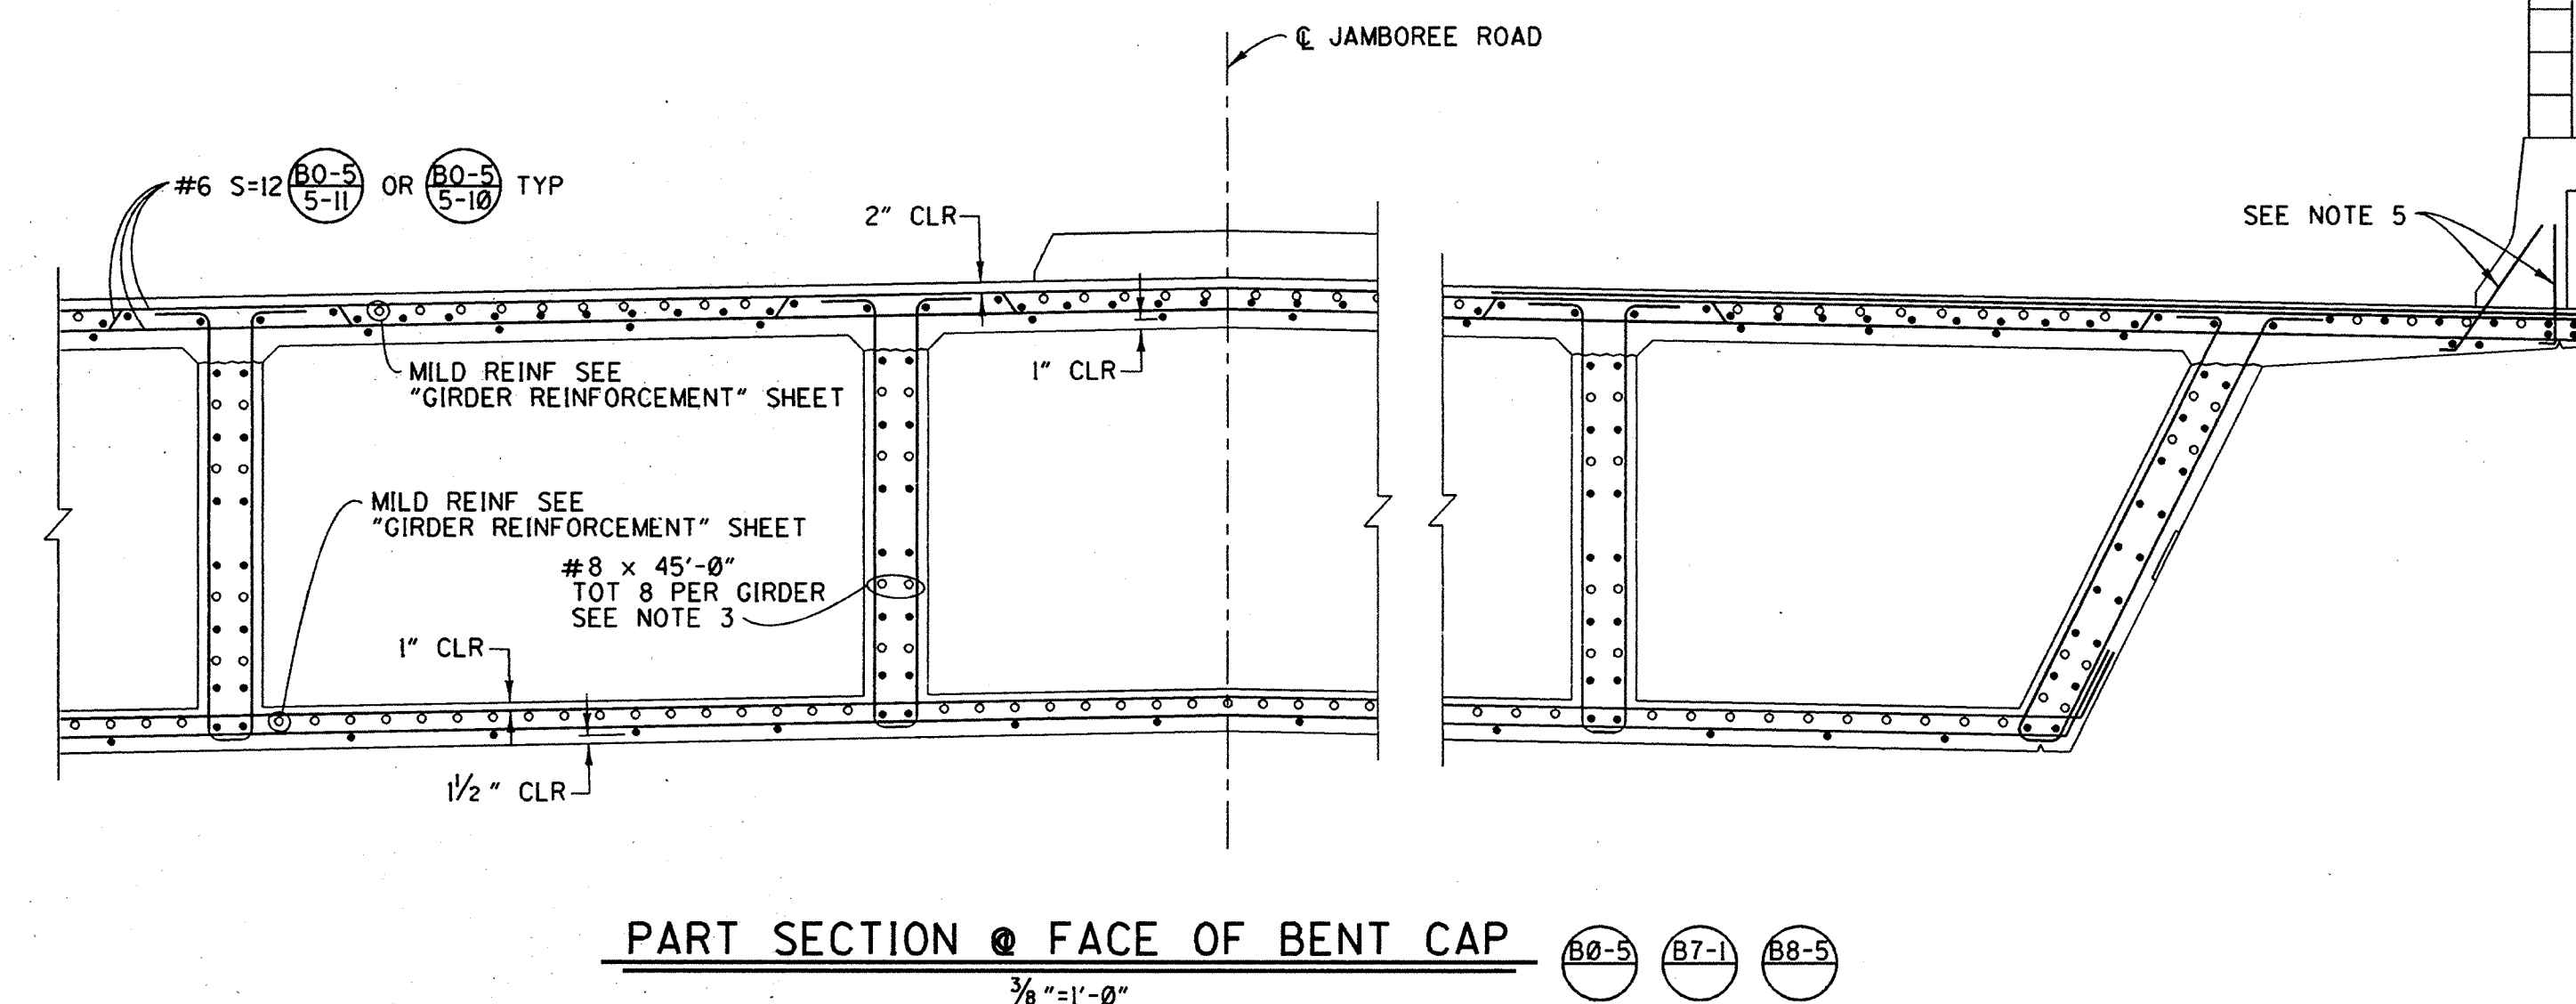
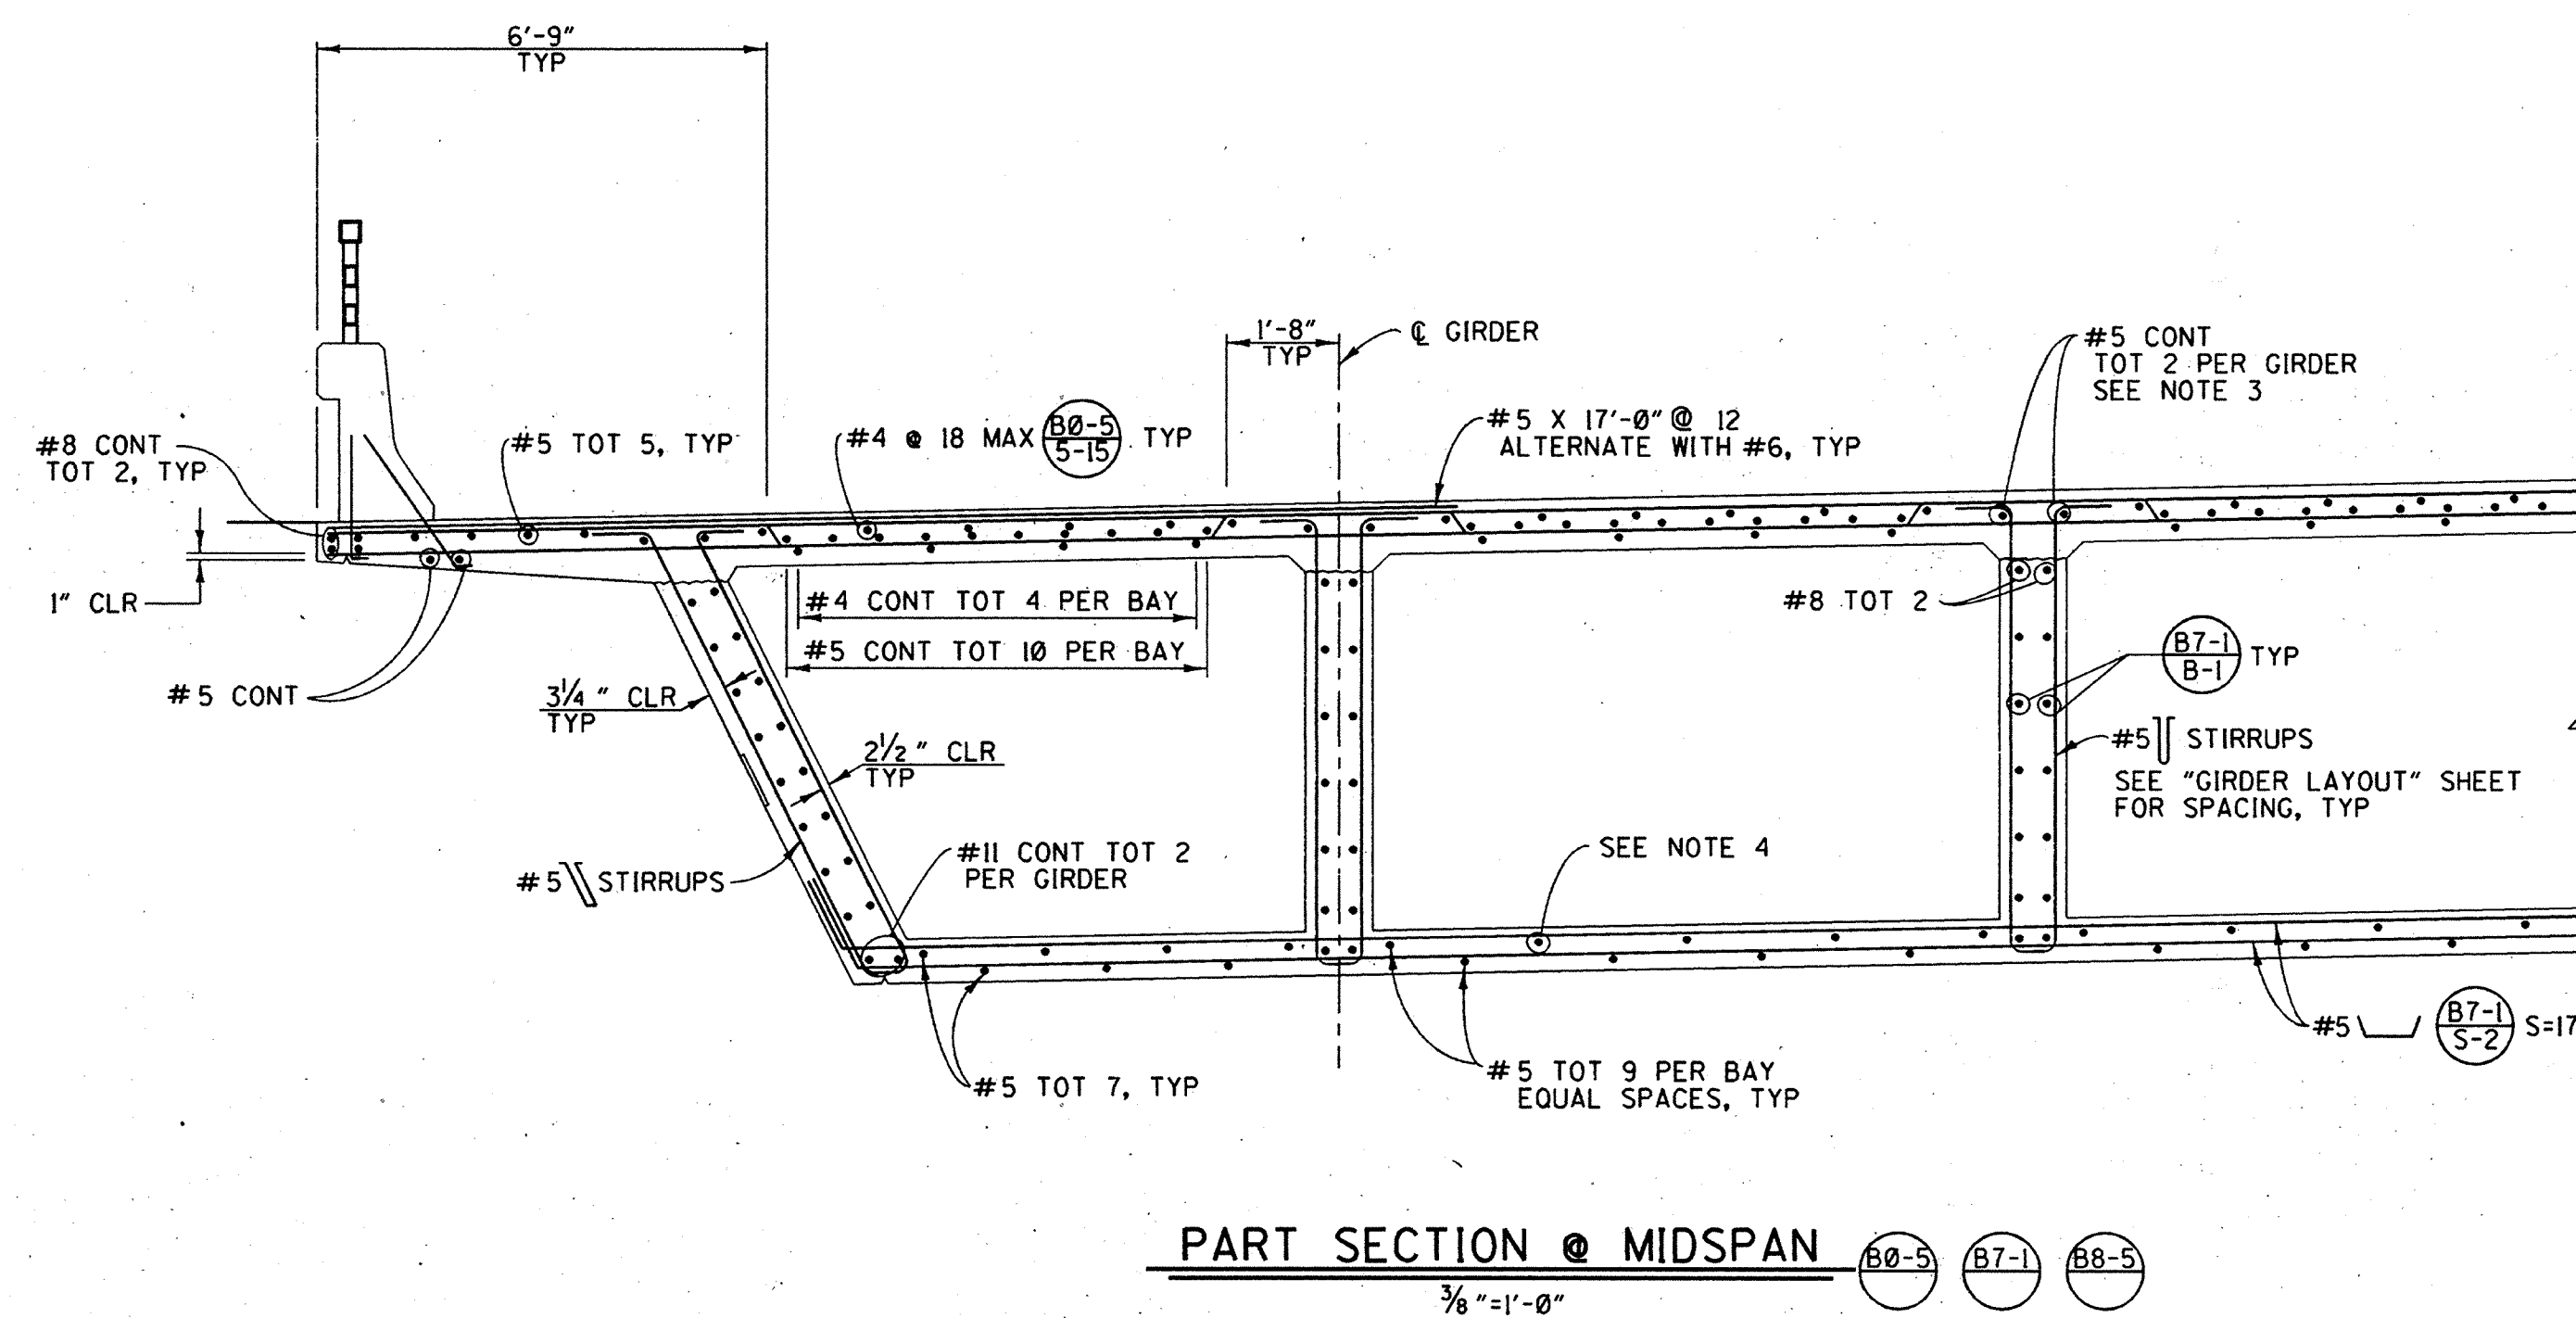
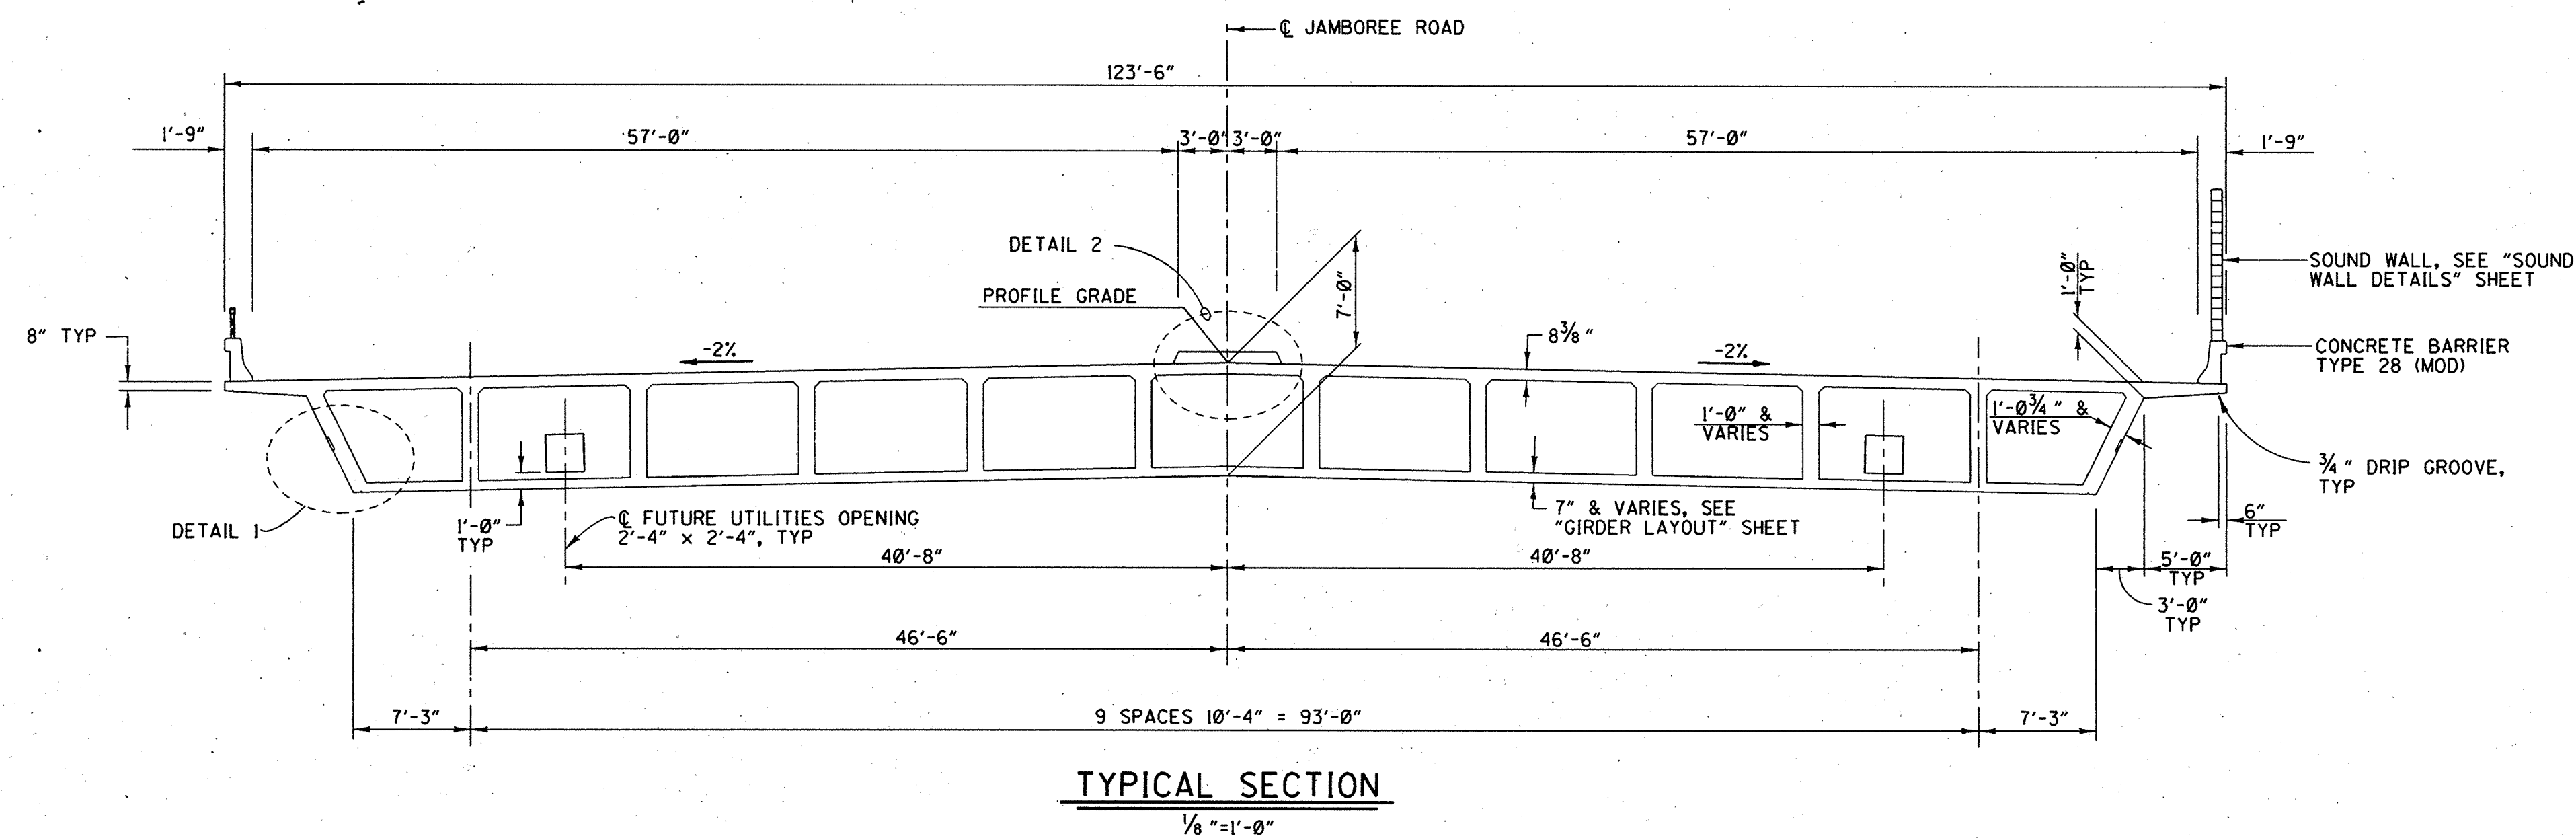


- STRUCTURAL CONCRETE, BRIDGE (5000 PSI AT 28 DAYS)
- STRUCTURAL CONCRETE, BRIDGE (5000 PSI AT 28 DAYS)
- STRUCTURAL CONCRETE, BRIDGE (4000 PSI AT 28 DAYS)
- STRUCTURAL CONCRETE, BRIDGE FOOTING (4000 PSI AT 28 DAYS)
- STRUCTURAL CONCRETE, BRIDGE FOOTING (3250 PSI AT 28 DAYS)
- STRUCTURAL CONCRETE, APPROACH SLAB (TYPE N)

URS GREINER, INC.
 1241 EAST DYER ROAD, SUITE 250
 SANTA ANA, CALIFORNIA 92705-5605

NOTES:

- FOR TYPICAL GIRDER FLARES SEE "GIRDER LAYOUT" SHEET.
- PLACE TRANSVERSE DECK REINFORCING BARS PARALLEL TO CL BRG.
- PLACE #8 X 45'-0" BARS SYMMETRICAL TO CL OF BENTS 2 & 3.
- REIN IN THIS LAYER CAN BE SPliced TO THE #9 REIN.
- FOR BARRIER REINFORCEMENT SEE "CONCRETE BARRIER TYPE 28 (MOD)" AND "SOUND WALL DETAILS" SHEET.

ORANGE COUNTY ENVIRONMENTAL MANAGEMENT AGENCY	
JAMBOREE ROAD GRADE SEPARATION AT EDINGER AVENUE	
TYPICAL SECTION	
DESIGNED J.W.	SHEET 108 OF 130
DRAWN A. GOMEZ	CHECKED G.L.R.
SCALE AS SHOWN	DATE 6-97
DRAWING NO.	

Dr. 1 (16157)