


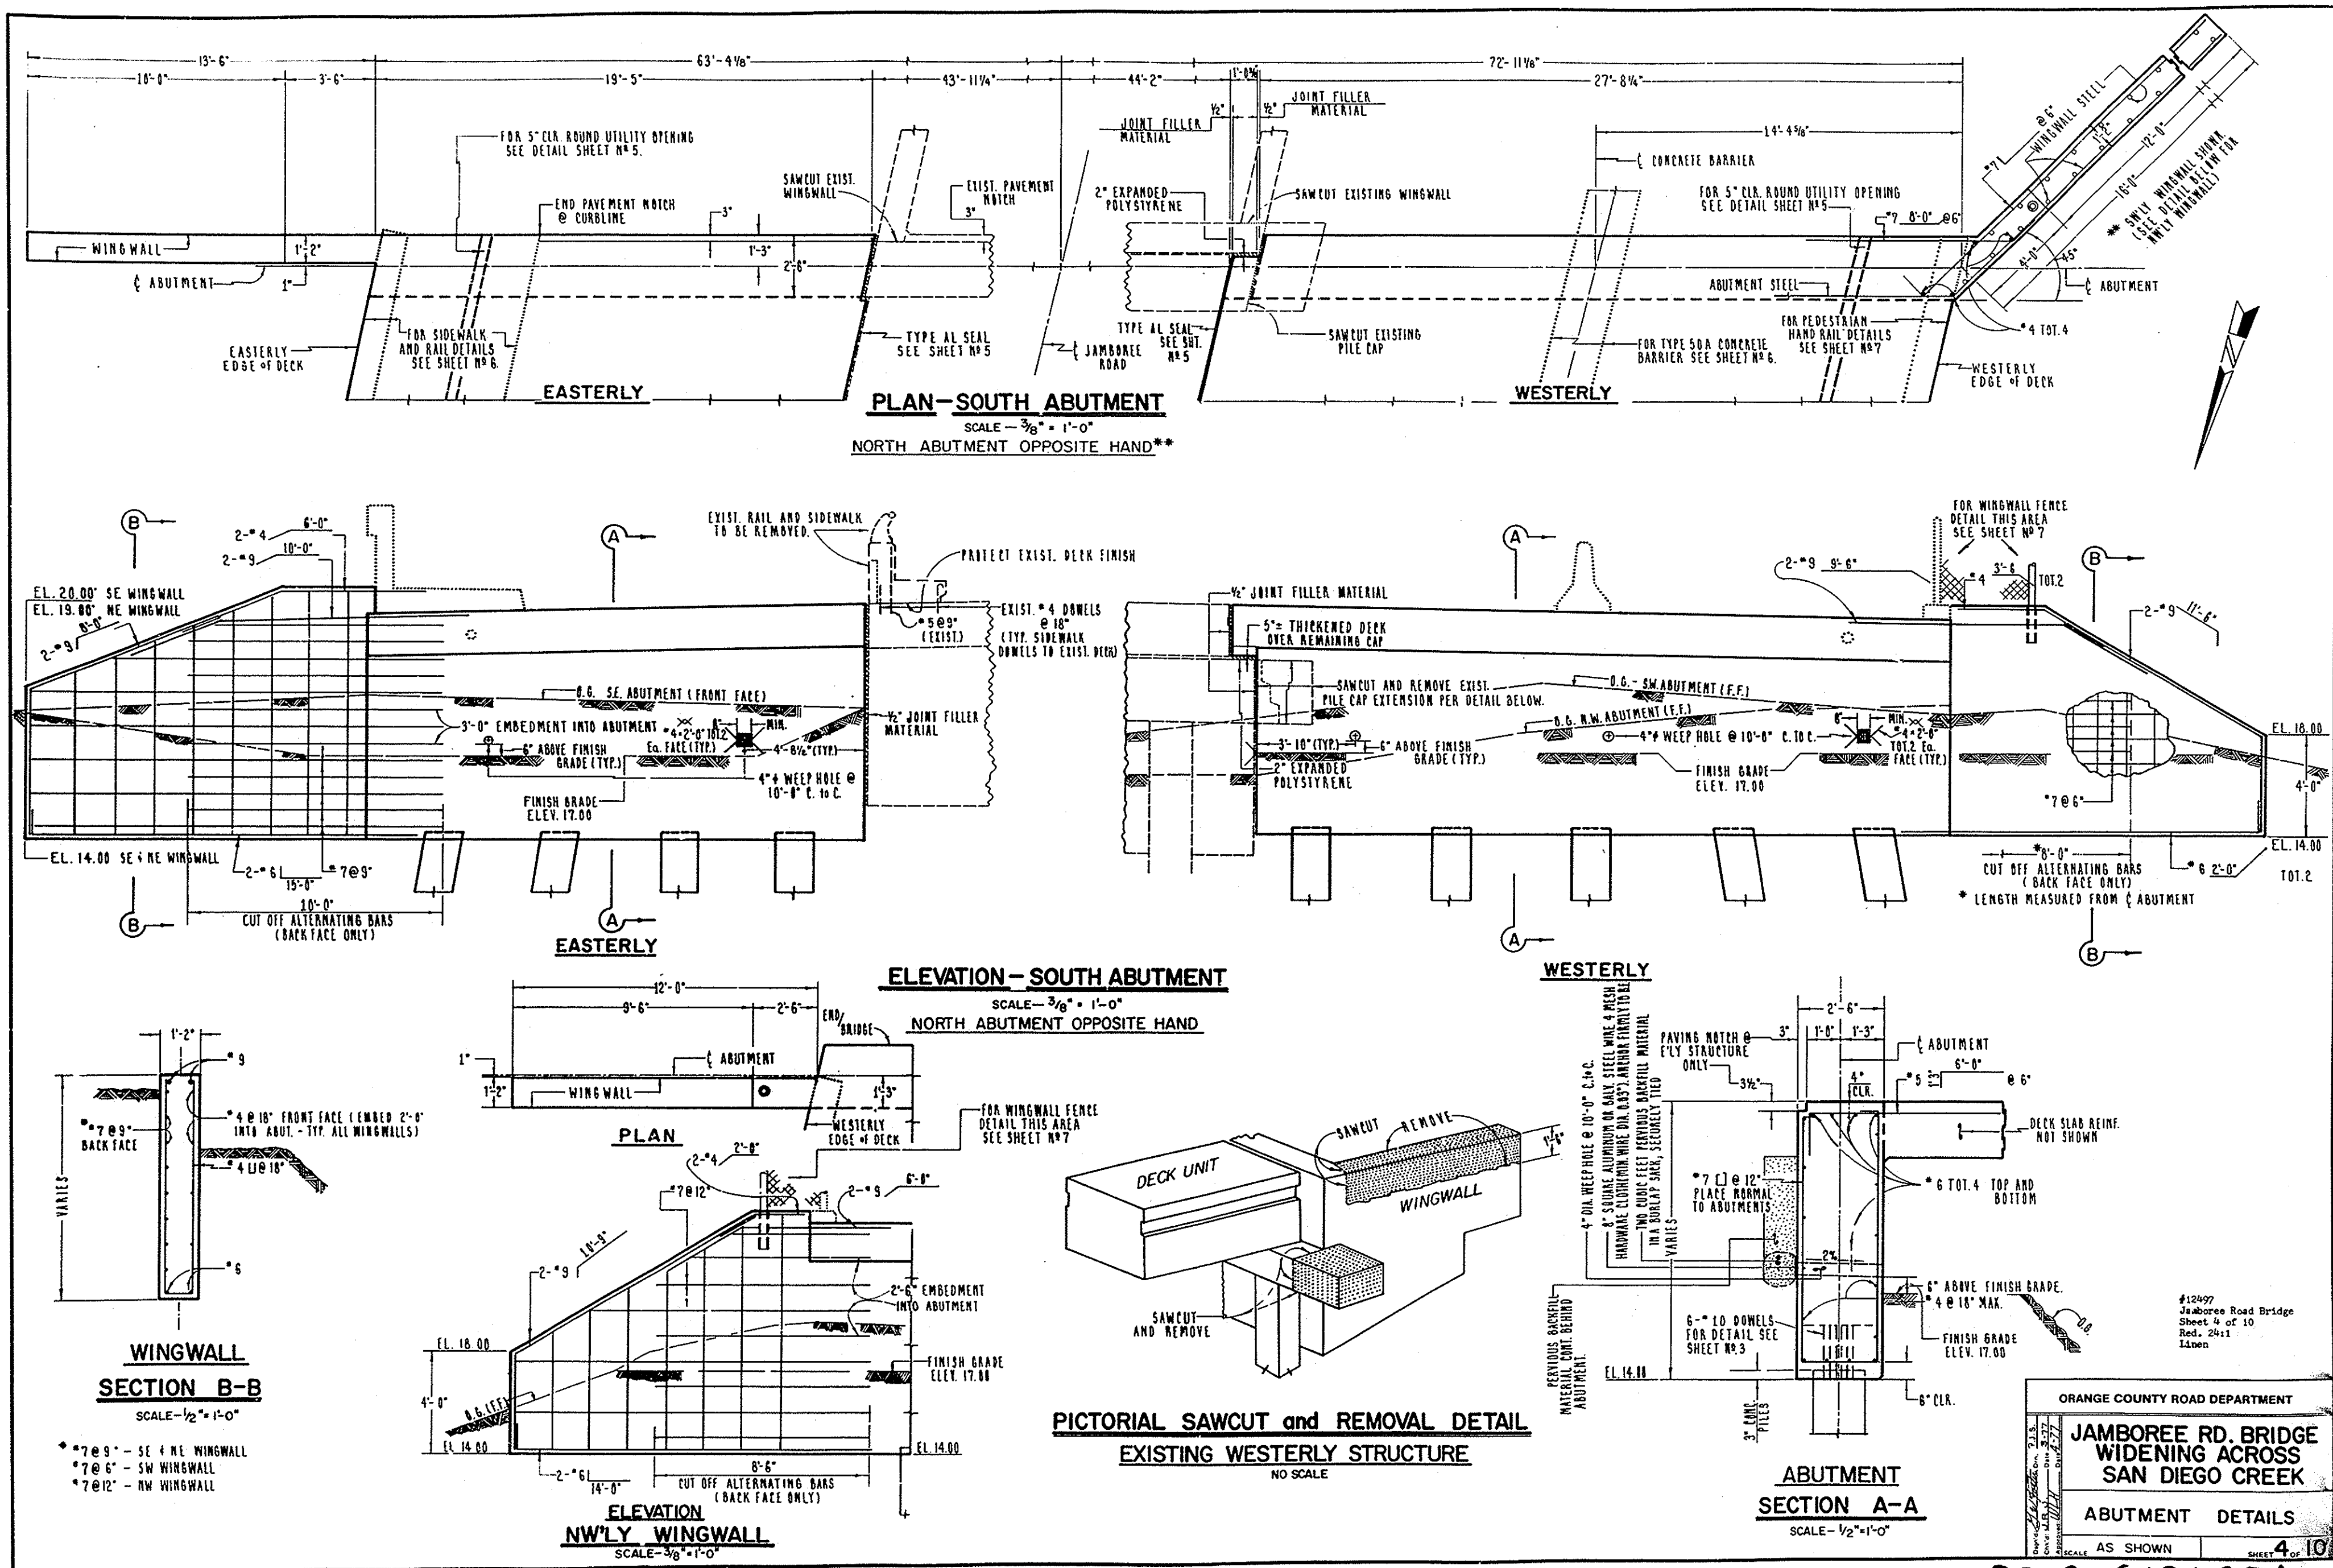

F05-104-2 DR 9 (12497)