
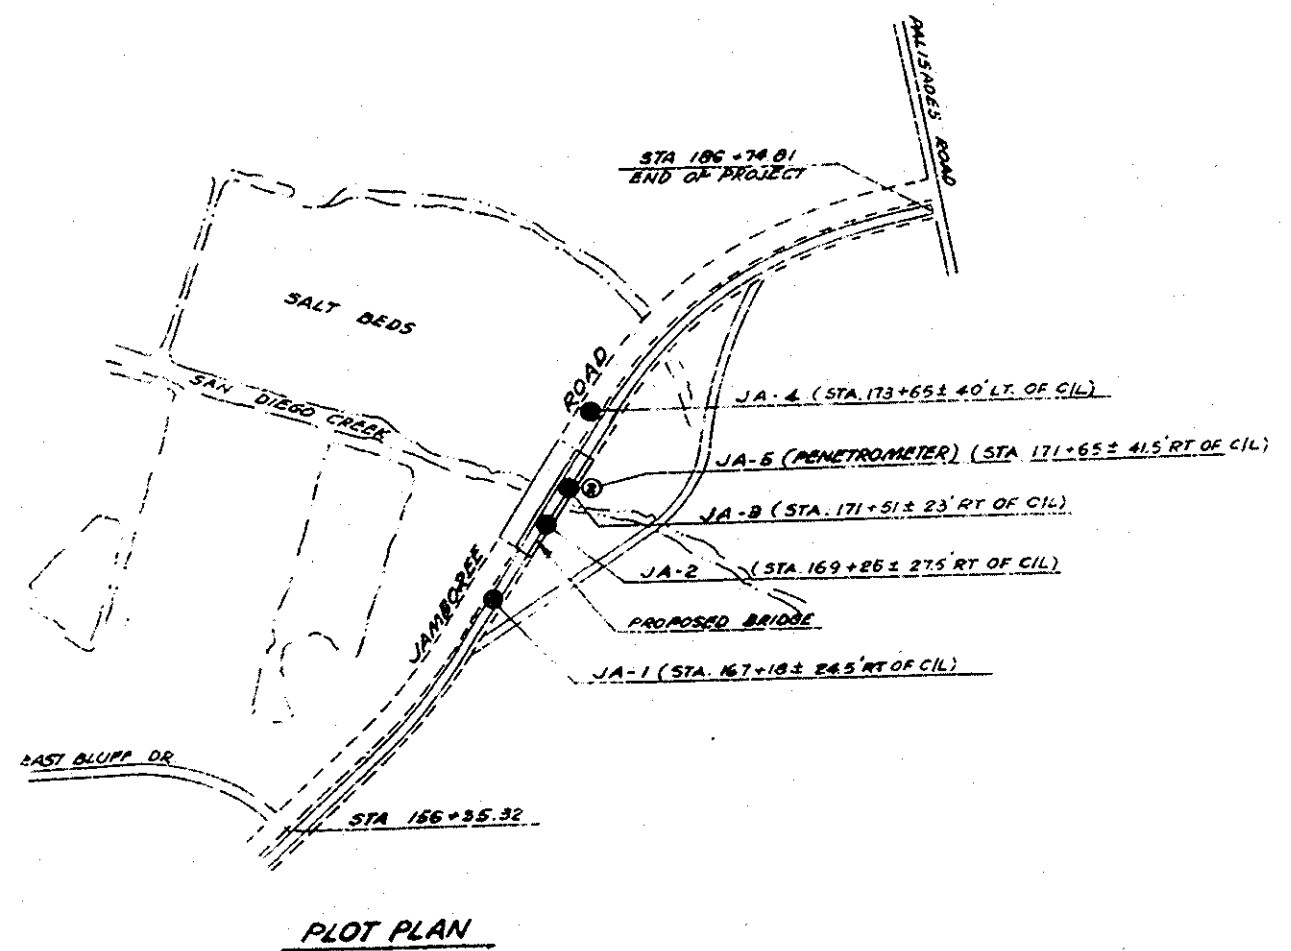
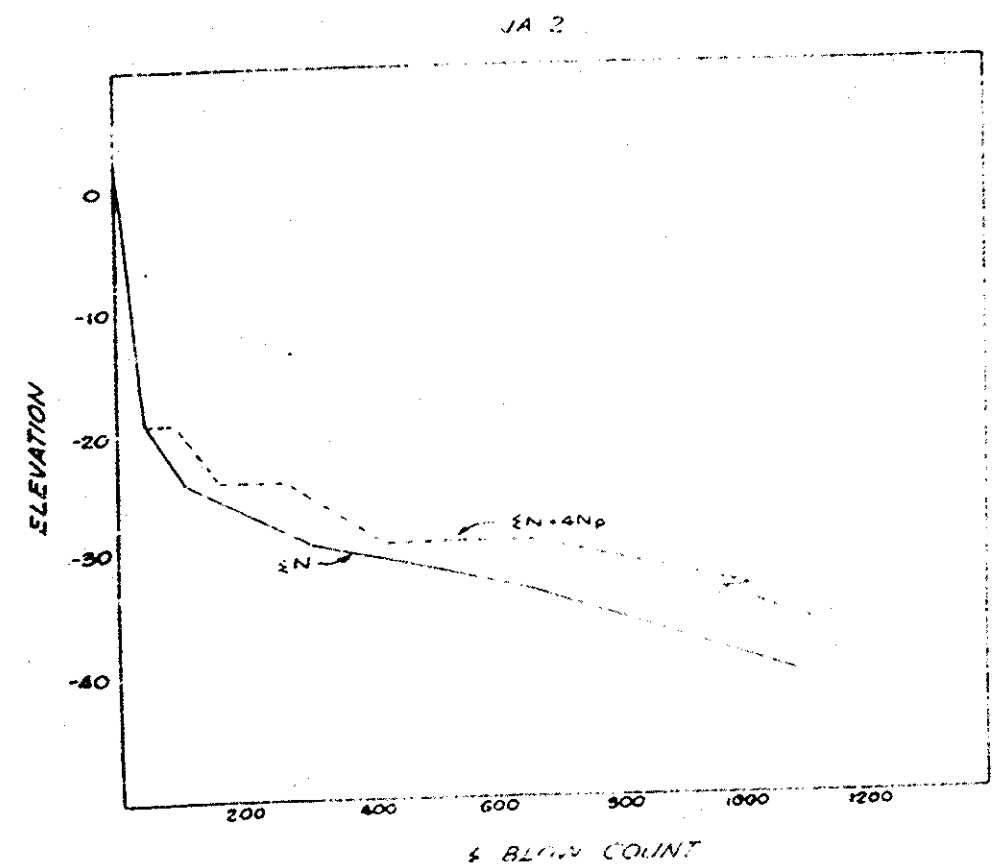


JA-4

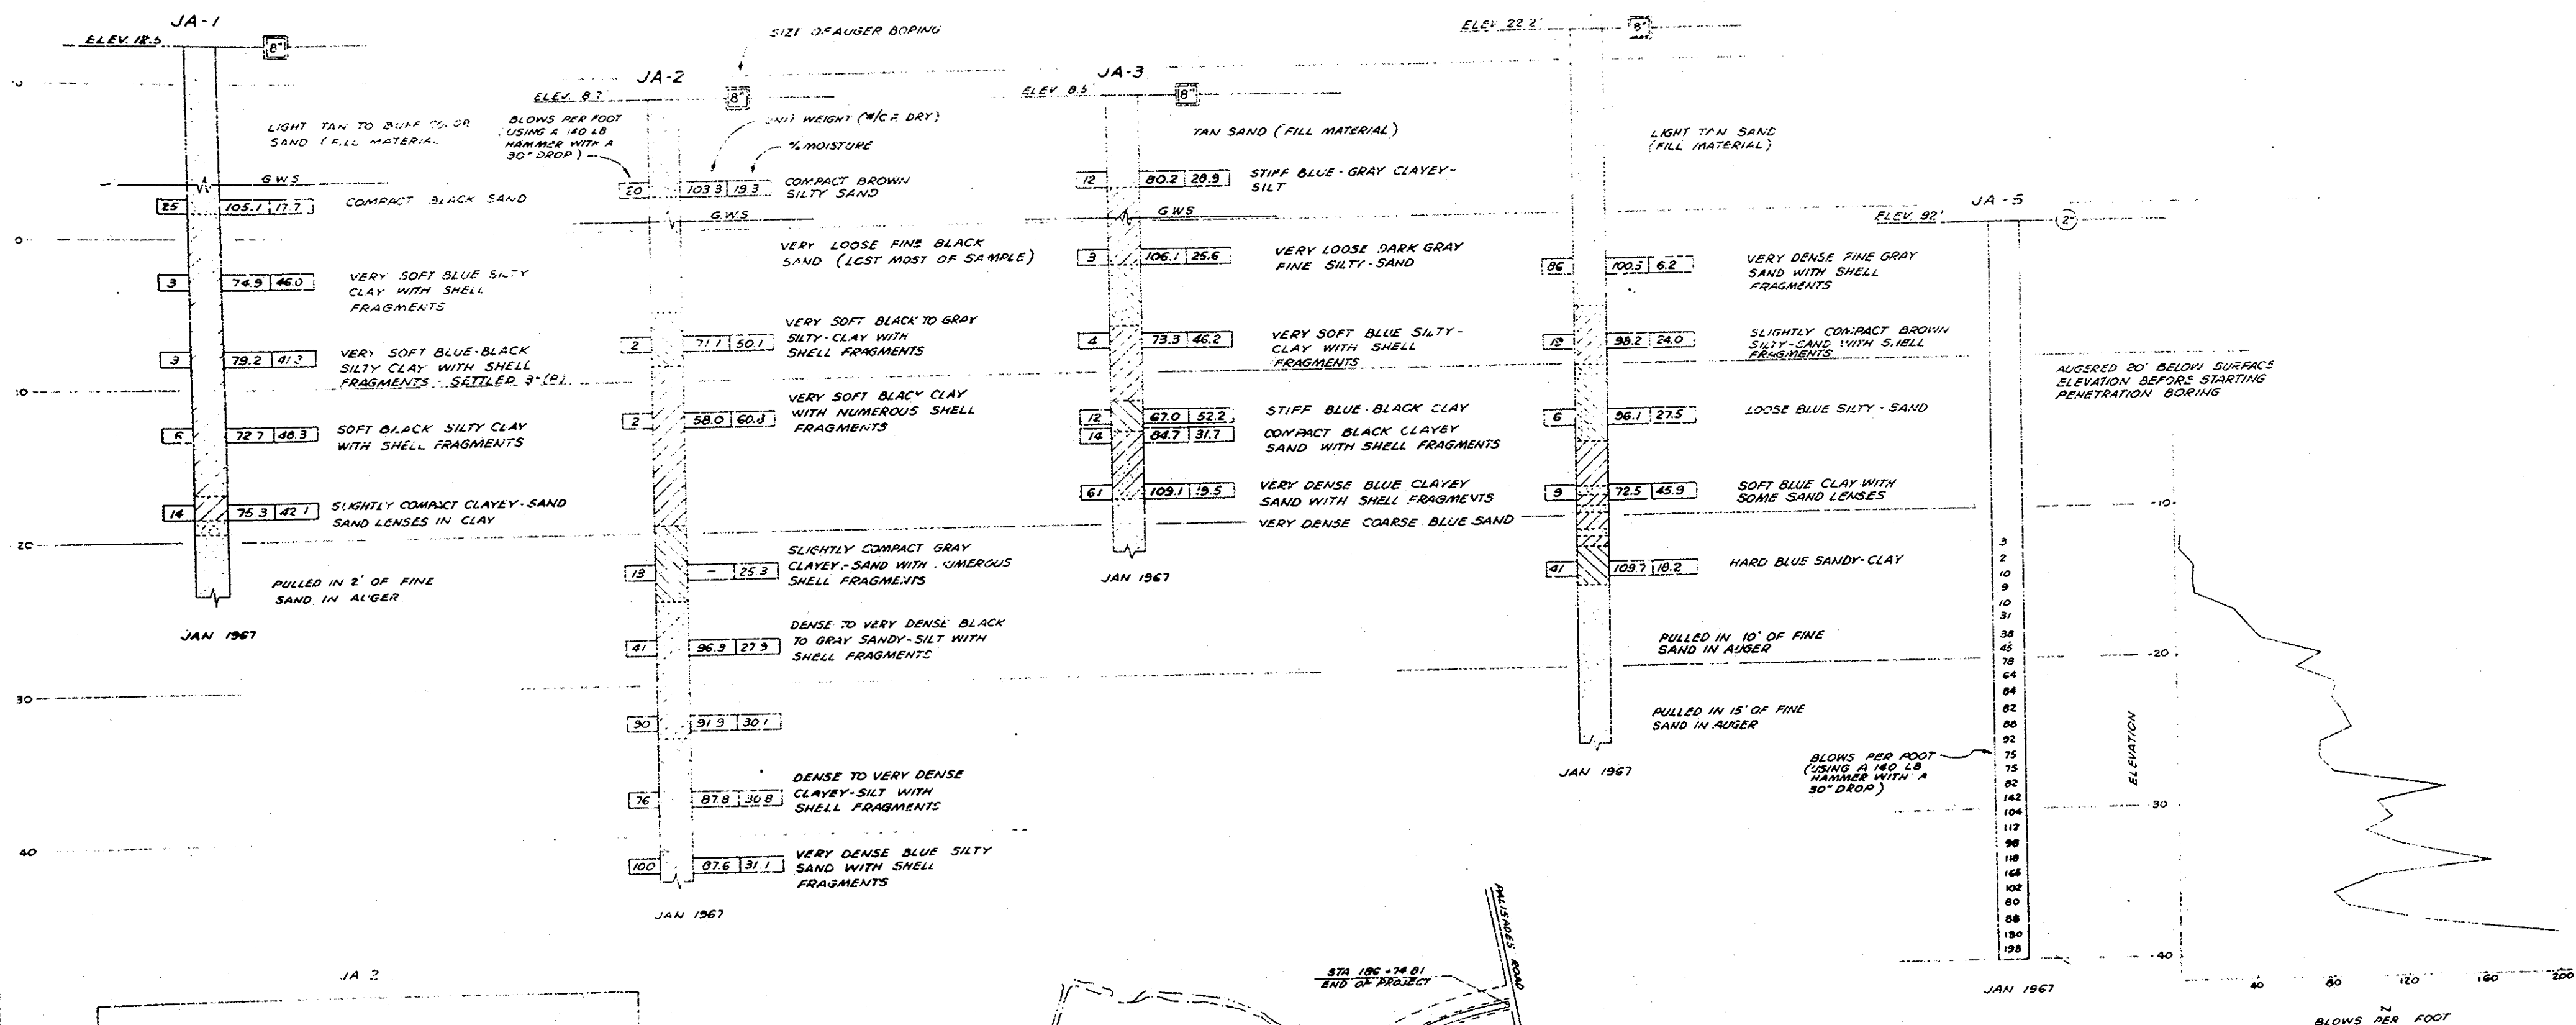

NOTE: DATA ON THIS SHEET IS TAKEN FROM "MATERIALS REPORT FOR THE PROPOSED* CONSTRUCTION OF JAMBOREE ROAD FROM FORD ROAD TO PALISADES ROAD IN THE CITY OF NEWPORT BEACH - A.N.P.R. #34C" DATED MARCH 21, 1967 BY COUNTY OF ORANGE, OFFICE OF COUNTY SURVEYOR AND ROAD COMMISSIONER, MATERIALS LABORATORY. * THIS SHEET WAS TAKEN FROM THE "AS BUILT" PLANS FOR THE EXISTING UPSTREAM STRUCTURE.

JAMBOREE RD. BRIDGE
WIDENING ACROSS
SAN DIEGO CREEK
LOG OF TEST BORINGS
AS SHOWN

F05-104-2 DR 9 (12497)