


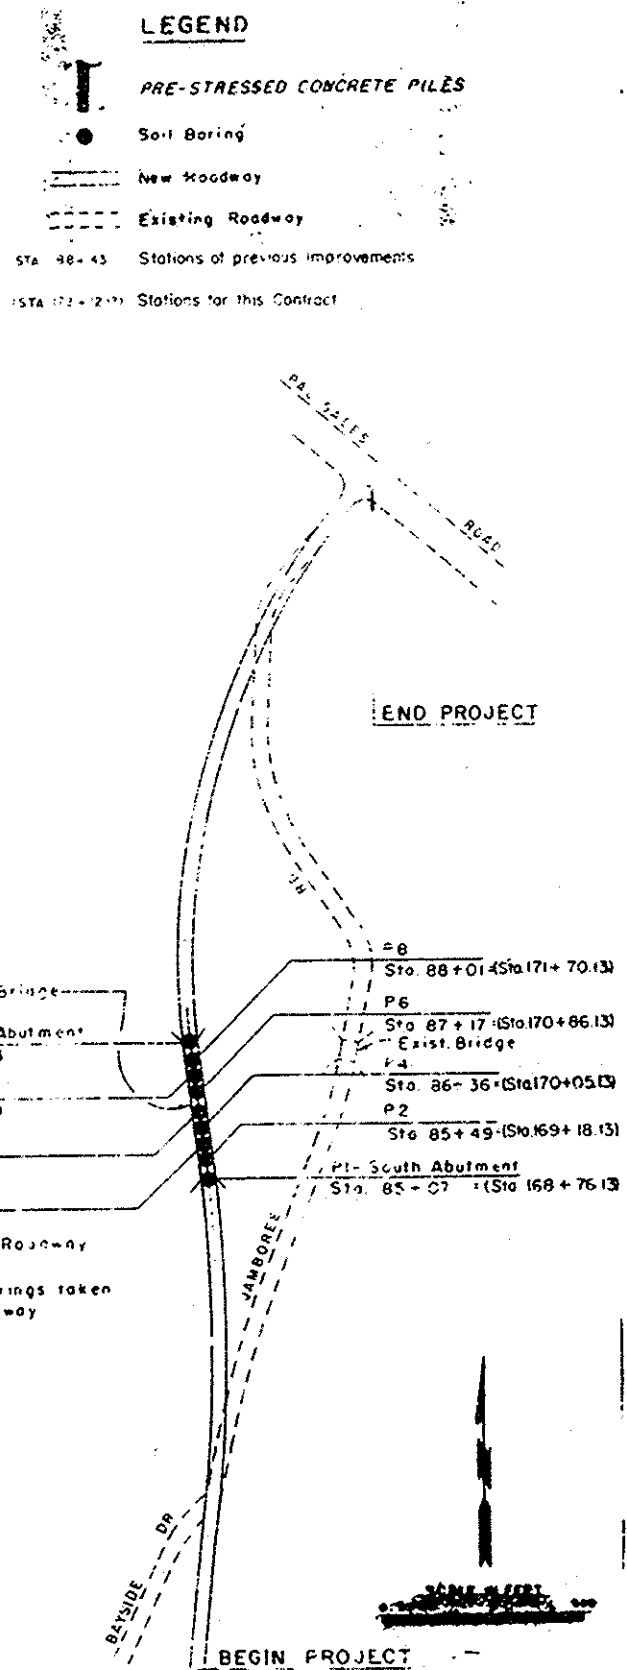

#12497
Jamboree Road Bridge
Sheet 9 of 10
Red. 24:1
Linen

AS SHOWN

9 10]

F05-104-2

DR 9 (12497)