




SCALE IN FEET

NOTES

BORING LEGEND

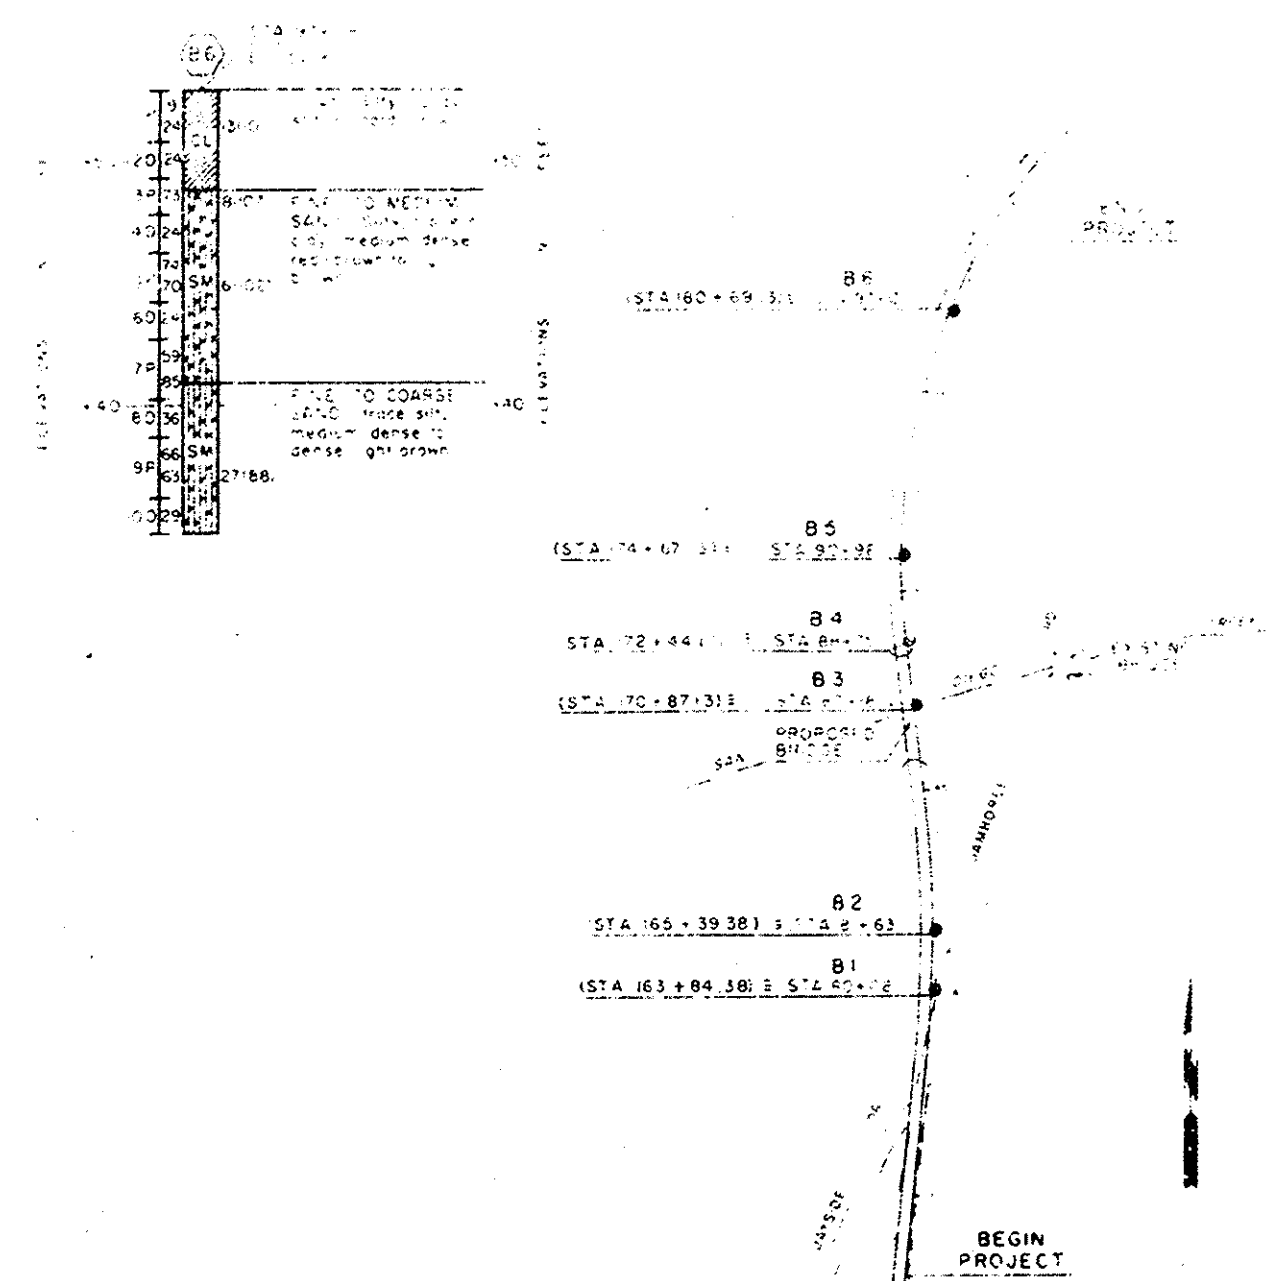

LOG OF TEST BORINGS

AS SHOWN 10 10

#12497
Jamboree Road Bridge
Sheet 10 of 10
Red. 24:1
Linen

F05-104-Z

AS SHOWN
DR 9 (12497)