

ORANGE COUNTY ROAD DEPT.

STATE OF CALIFORNIA

PLANS FOR CONSTRUCTION ON

JERONIMO ROAD


LOS ALISOS BLVD. to CHERRY AVENUE

TOTAL LENGTH 0.28 MILE

LOS ALISOS BOULEVARD

JERONIMO ROAD to SECOND STREET

TOTAL LENGTH 0.17 MILE

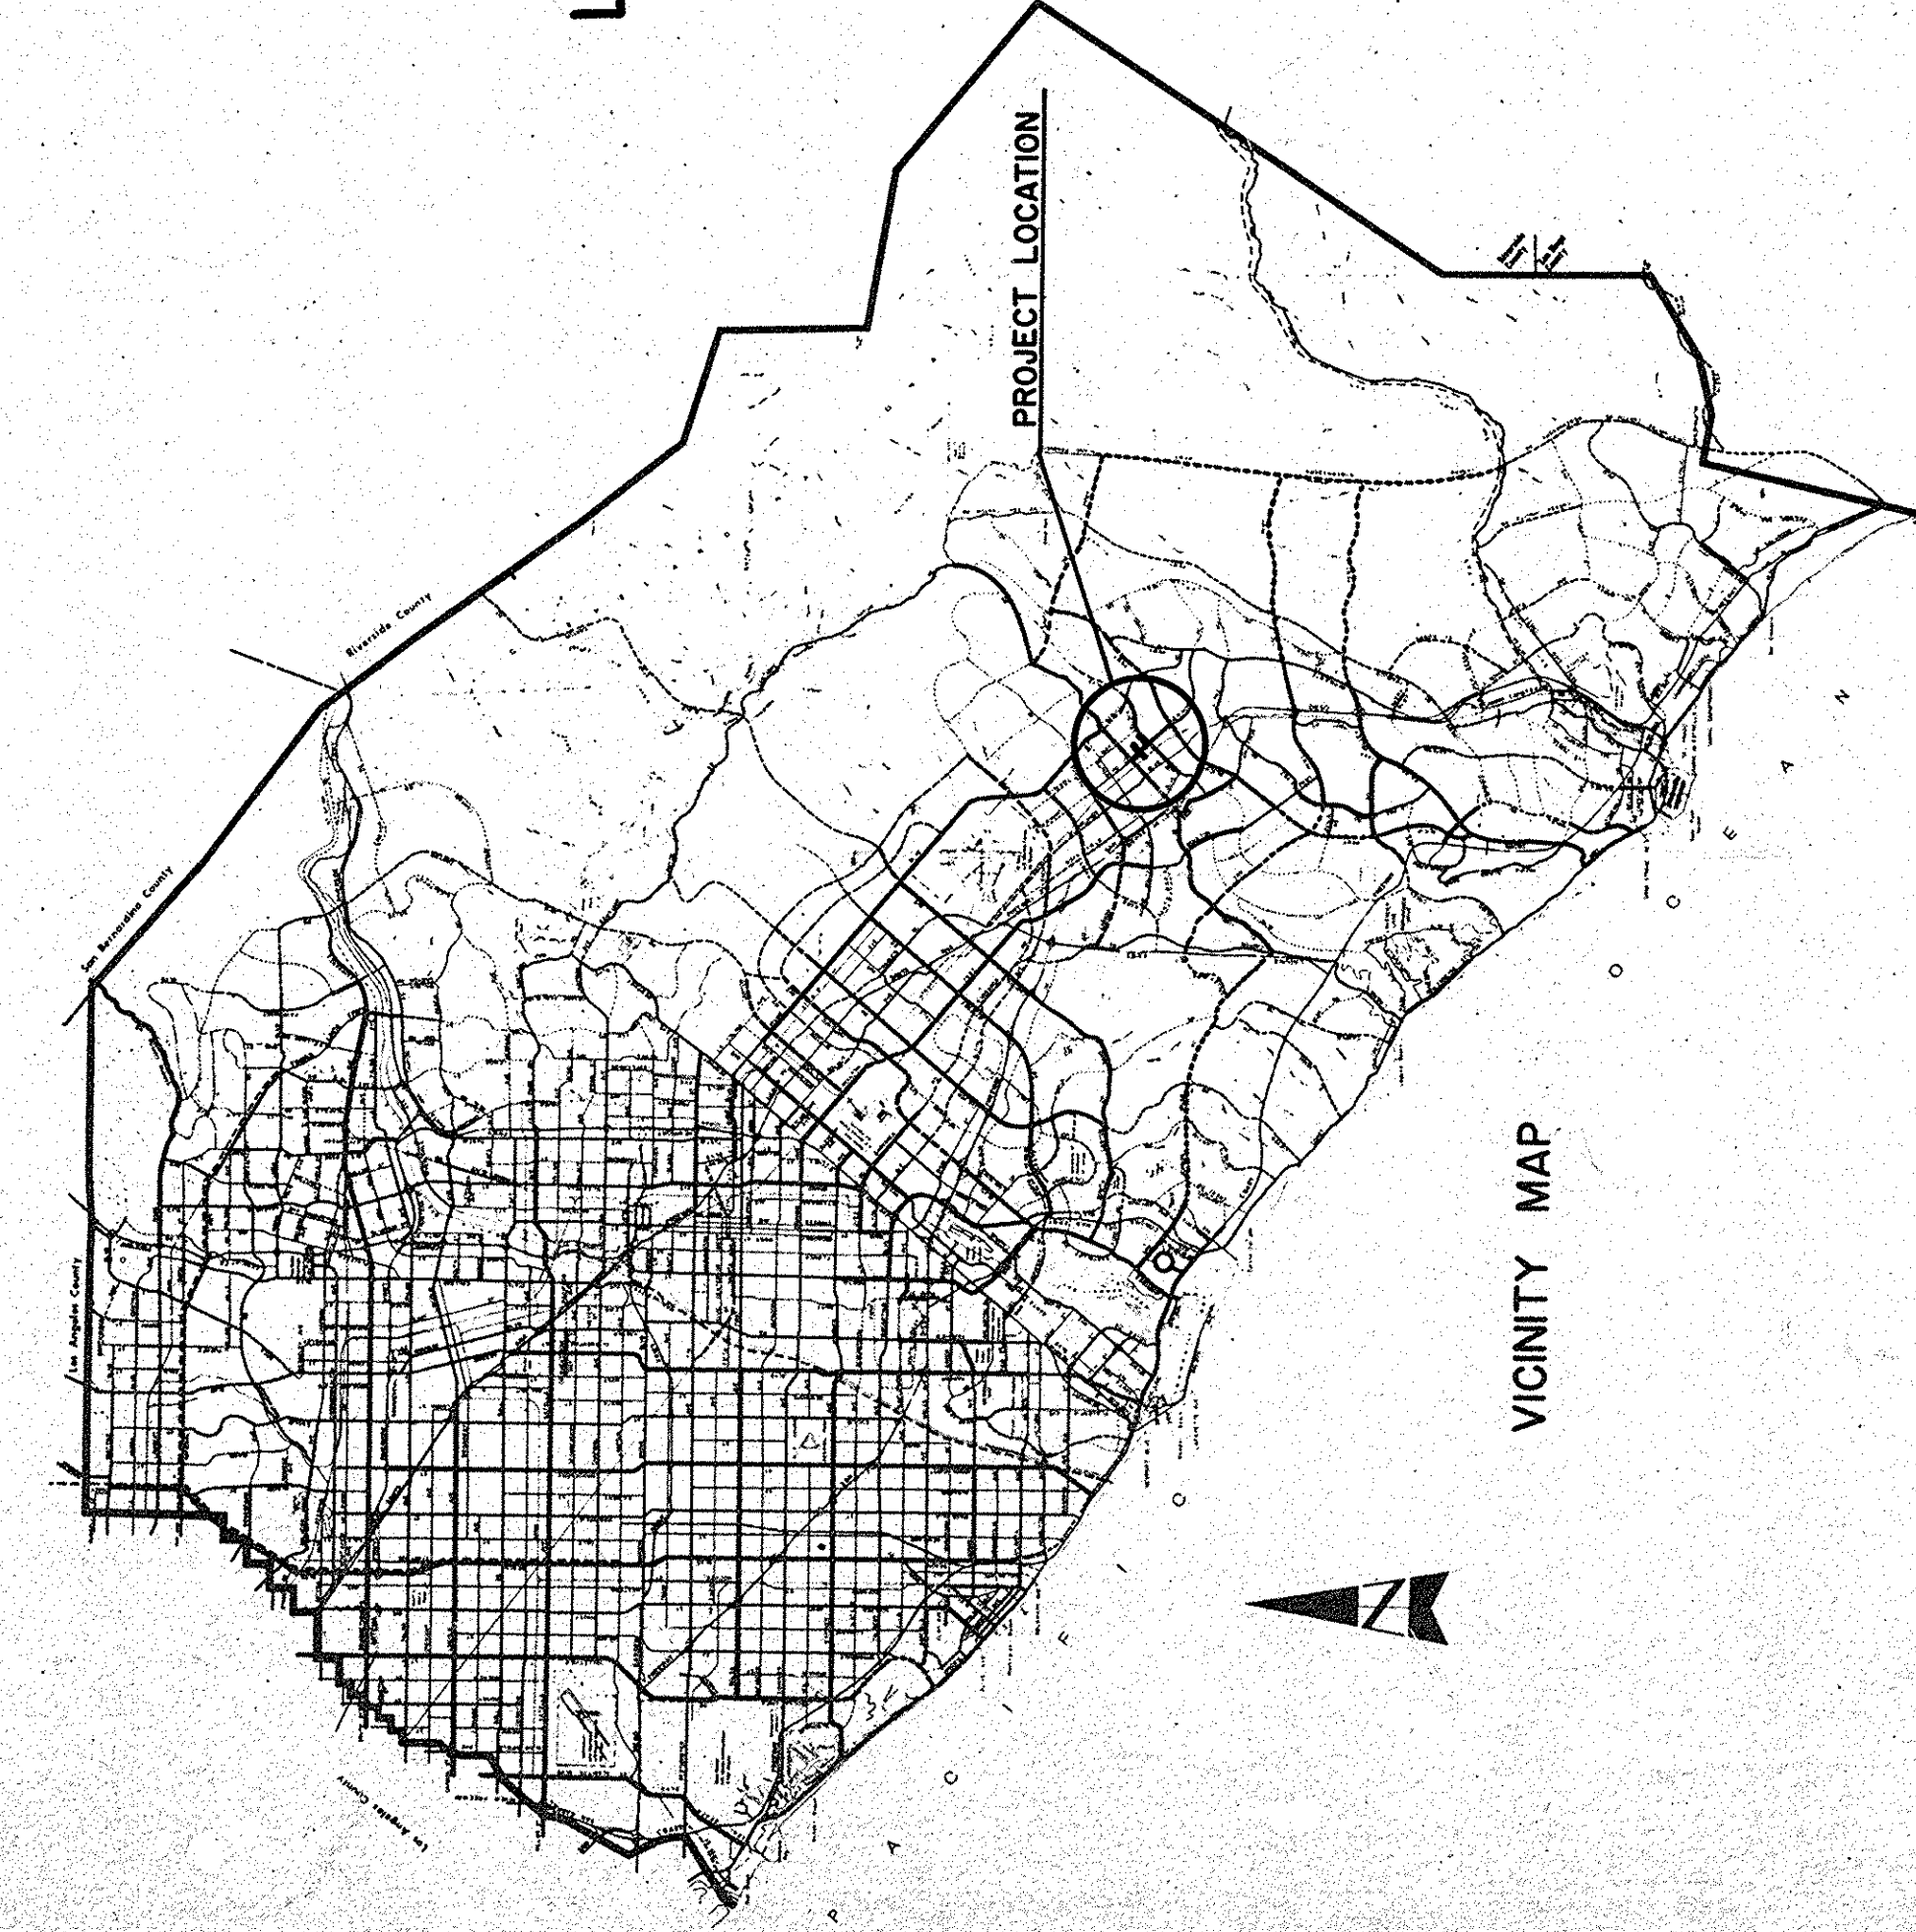

VICINITY MAP

INDEX OF SHEETS

SHEET NO. DESCRIPTION

STREETS AND CHANNEL

- | | |
|------|---------------------------------------|
| 1 | TITLE SHEET |
| 2 | TYPICAL SECTIONS AND DETAILS |
| 3-4 | PLAN AND PROFILE JERONIMO ROAD |
| 5 | PLAN AND PROFILE LOS ALISOS BLVD. |
| 6-8 | INTERSECTIONS & MISCELLANEOUS DETAILS |
| 9-10 | PLAN AND PROFILE ALISO CREEK CHANNEL |
| 11 | EXISTING ALISO CREEK |

CROSS SECTIONS

- | | |
|-------|----------------------|
| 12-14 | JERONIMO ROAD |
| 15-18 | LOS ALISOS BOULEVARD |
| 19 | CHERRY AVENUE |
| 20-22 | ALISO CREEK CHANNEL |
| 23 | EXISTING ALISO CREEK |

BRIDGE

- | | |
|----|--|
| 24 | GENERAL PLAN |
| 25 | FOUNDATION PLAN |
| 26 | ABUTMENT AND WINGWALL DETAILS |
| 27 | GIRDER LAYOUT |
| 28 | TYPICAL SECTION |
| 29 | BOX GIRDER AND UTILITY OPENING DETAILS |
| 30 | PRESTRESSED GIRDER DETAILS |
| 31 | RUSTIC BARRIER RAILING DETAIL |
| 32 | PILING DETAILS |
| 33 | BORING LOG |

AS BUILT

AS BUILT
P.H. RICKER R.E. 7-1-74

APPROVED:
AS TO PORTIONS
WITHIN THE
O.C.E.C.D. RW

AL Osborne 17 Sept 73
DATE

CONVENTIONAL		SIGNS	
COUNTY LINE	---	FRUIT TREES	○
CITY LIMITS	----	EUCALYPTUS TREE	○
BASE OR SURVEY LINE	---	PALM TREE	○
CONSTRUCTION	---	POWER POLE	○
RAILROAD TRACKS	---	TELEPHONE POLE	○
CULVERTS	---	STANDARD	○
DROP INLET	---	MANHOLE	○
WIRE FENCE	---	WATER METER	○
CHAIN LINK FENCE	---	WATER METER	○
MASONRY WALL	---	WATER METER	○
CONCRETE WALL	---	WATER METER	○
LEVEE	---	WATER METER	○
RECEIVING DRAINAGE	---	WATER METER	○
TOE SLOPE	---	WATER METER	○

#11212
JERONIMO RD.
SHEET 1 of 33
RED. 22.511
SEP 73

APPROVED:

ROAD COMMISSIONER R.C.E. 6978

DR. 10 (1212)