

444-SB USC & GS BM 444-SB IN THE
EL TORO GRAMMAR SCHOOL YARD IN
THE APPROXIMATE CENTER OF
TRIANGLE FORMED BY PEPPER
TREES 115' S.W. OF PROLONGATION
OF OLIVE ST. (REF. USC & GS LINE 9)
1958 ELEV. 444.979
1964 ELEV. 444.979



CLIFFORD C. HOOD R.C.E. 12489 DATE 3-2-77
BASIS OF BEARING = S.M. 65.20

NOTE:
1. STRIPING TO BE DONE BY COUNTY FORCES

MAYBELL WHISLER

ROY A. BENTSON

SIGNS AND MARKERS		
TYPE	LOCATION	NO.
W96G7	34 + 75 RT.	1
F(1) CULVERT	36 + 90 LT & RT	2

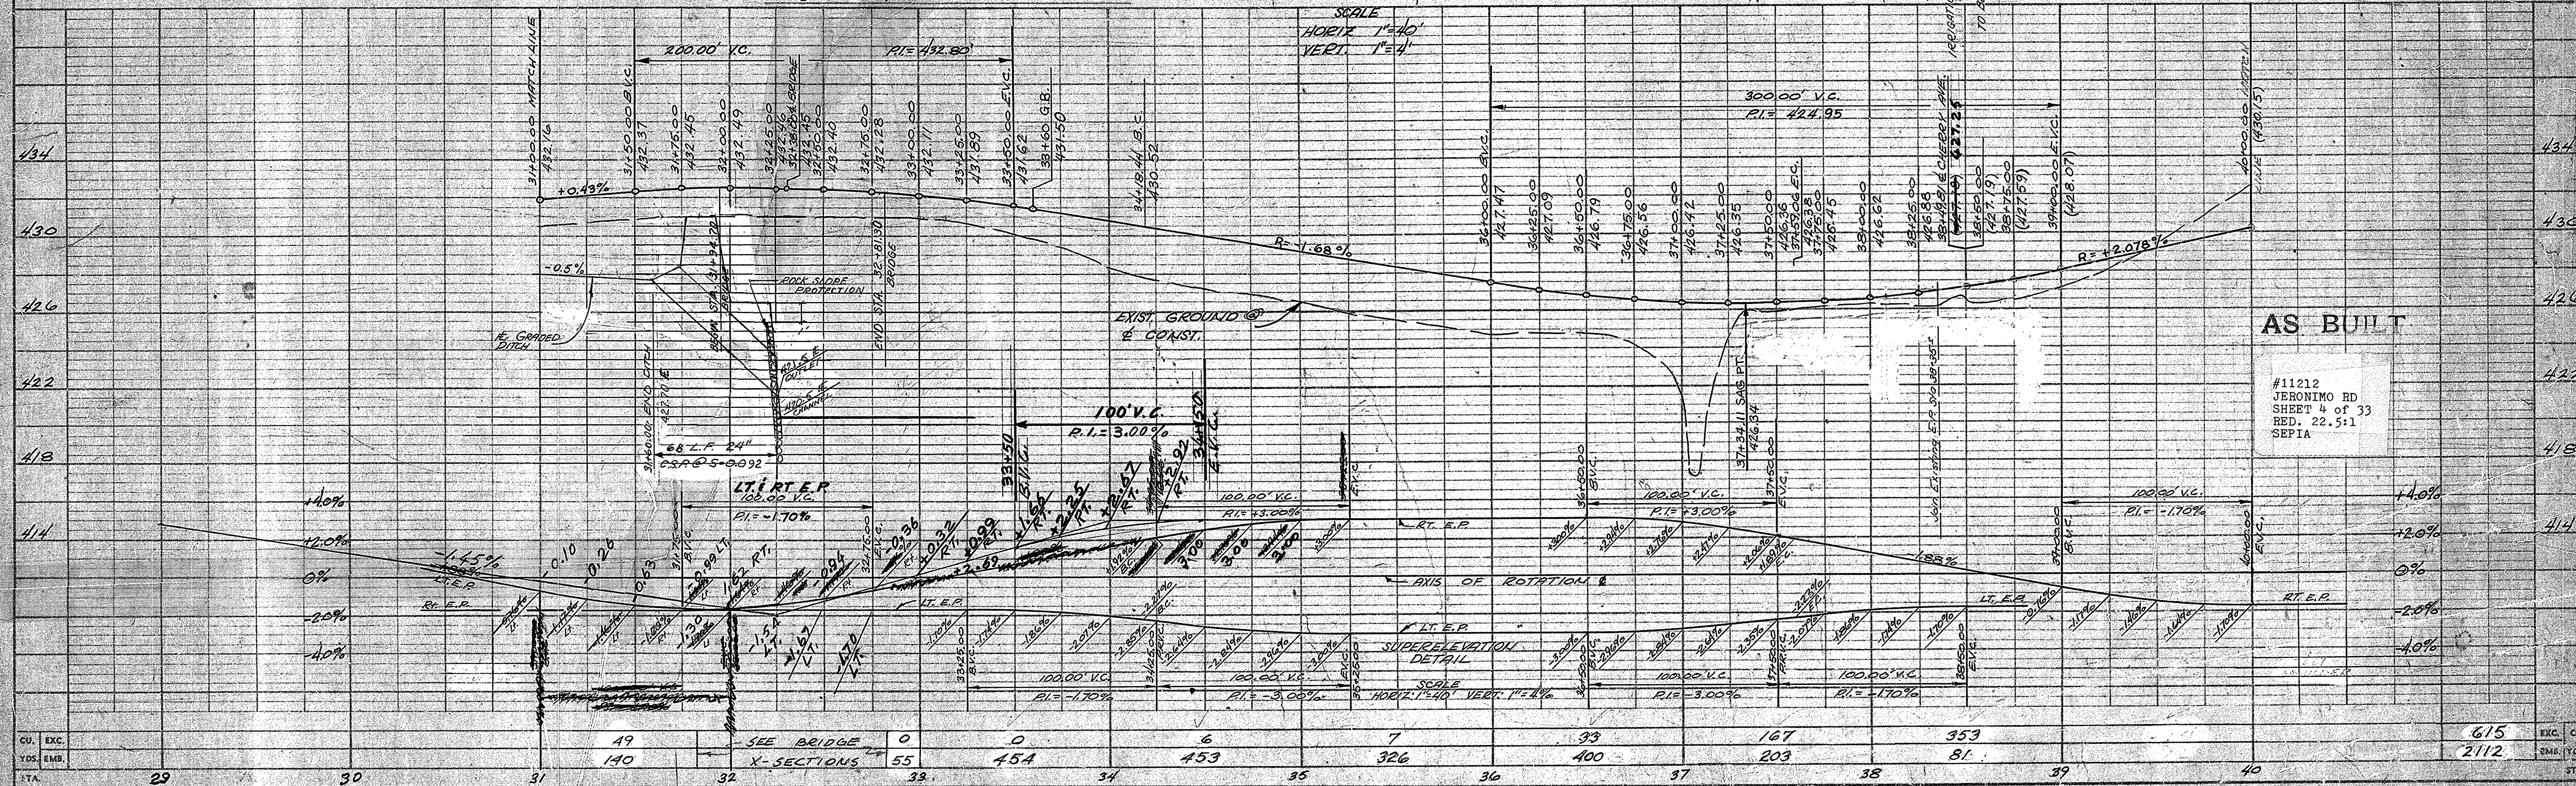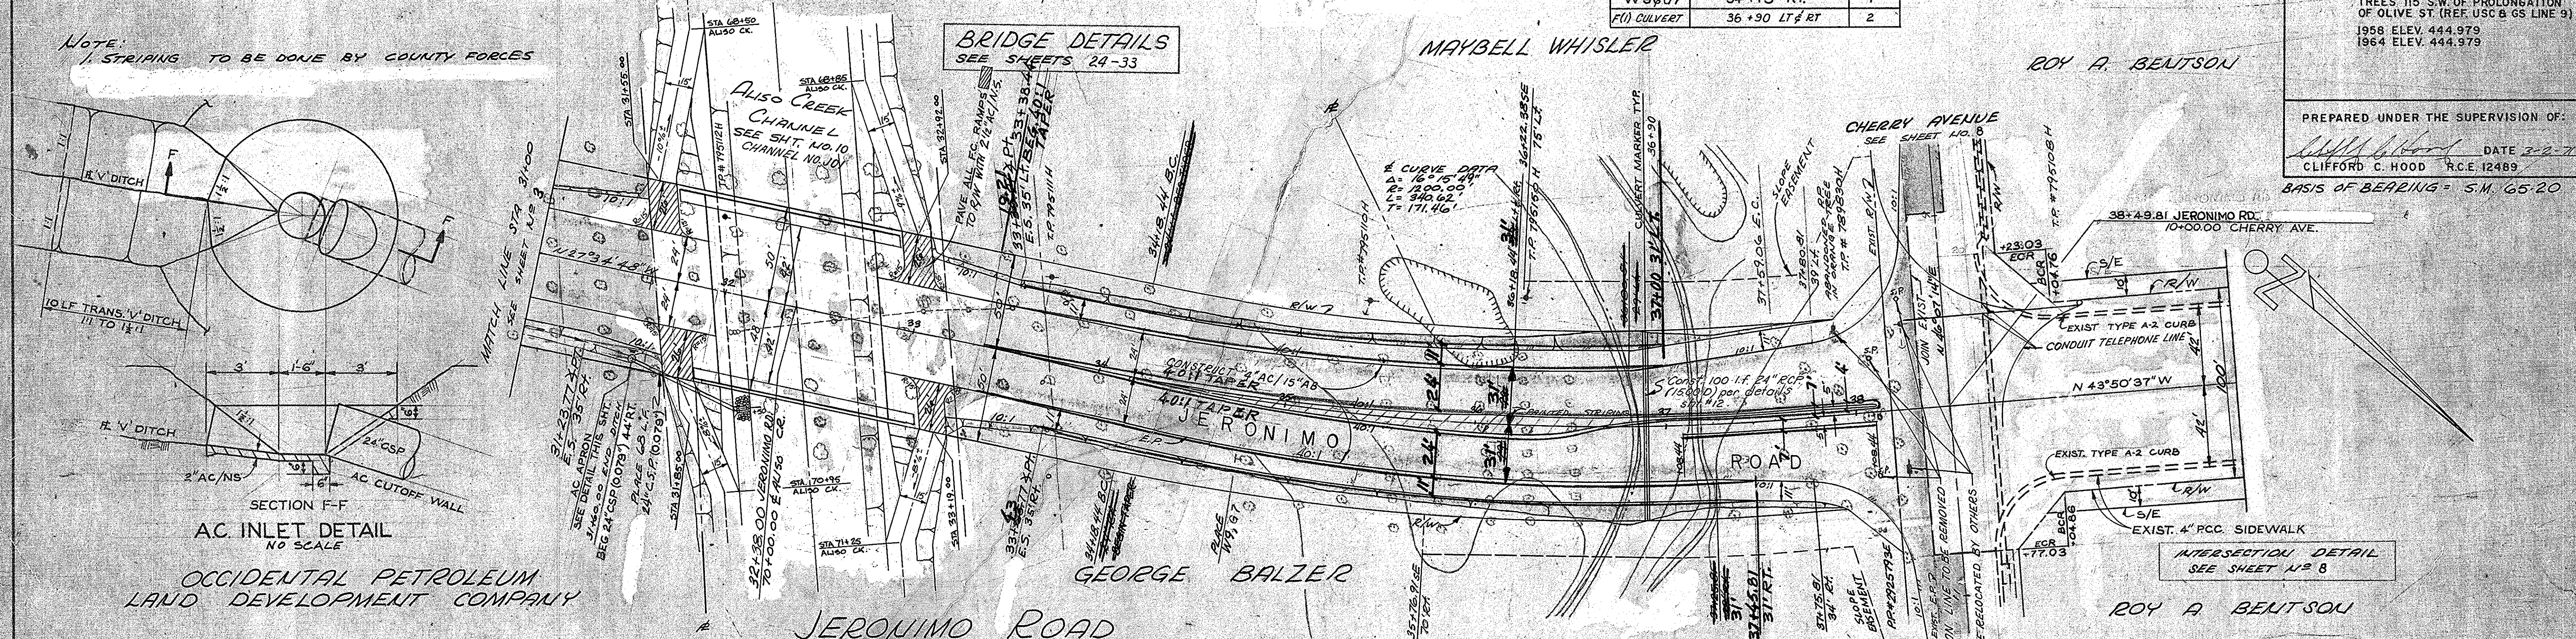

AS BUILT

#11212
JERONIMO RD
SHEET 4 of 33
RED. 22.5:1
SEPIA

DE 10 (11212)