


STRIPING TO BE DONE BY
COUNTY FORCES.

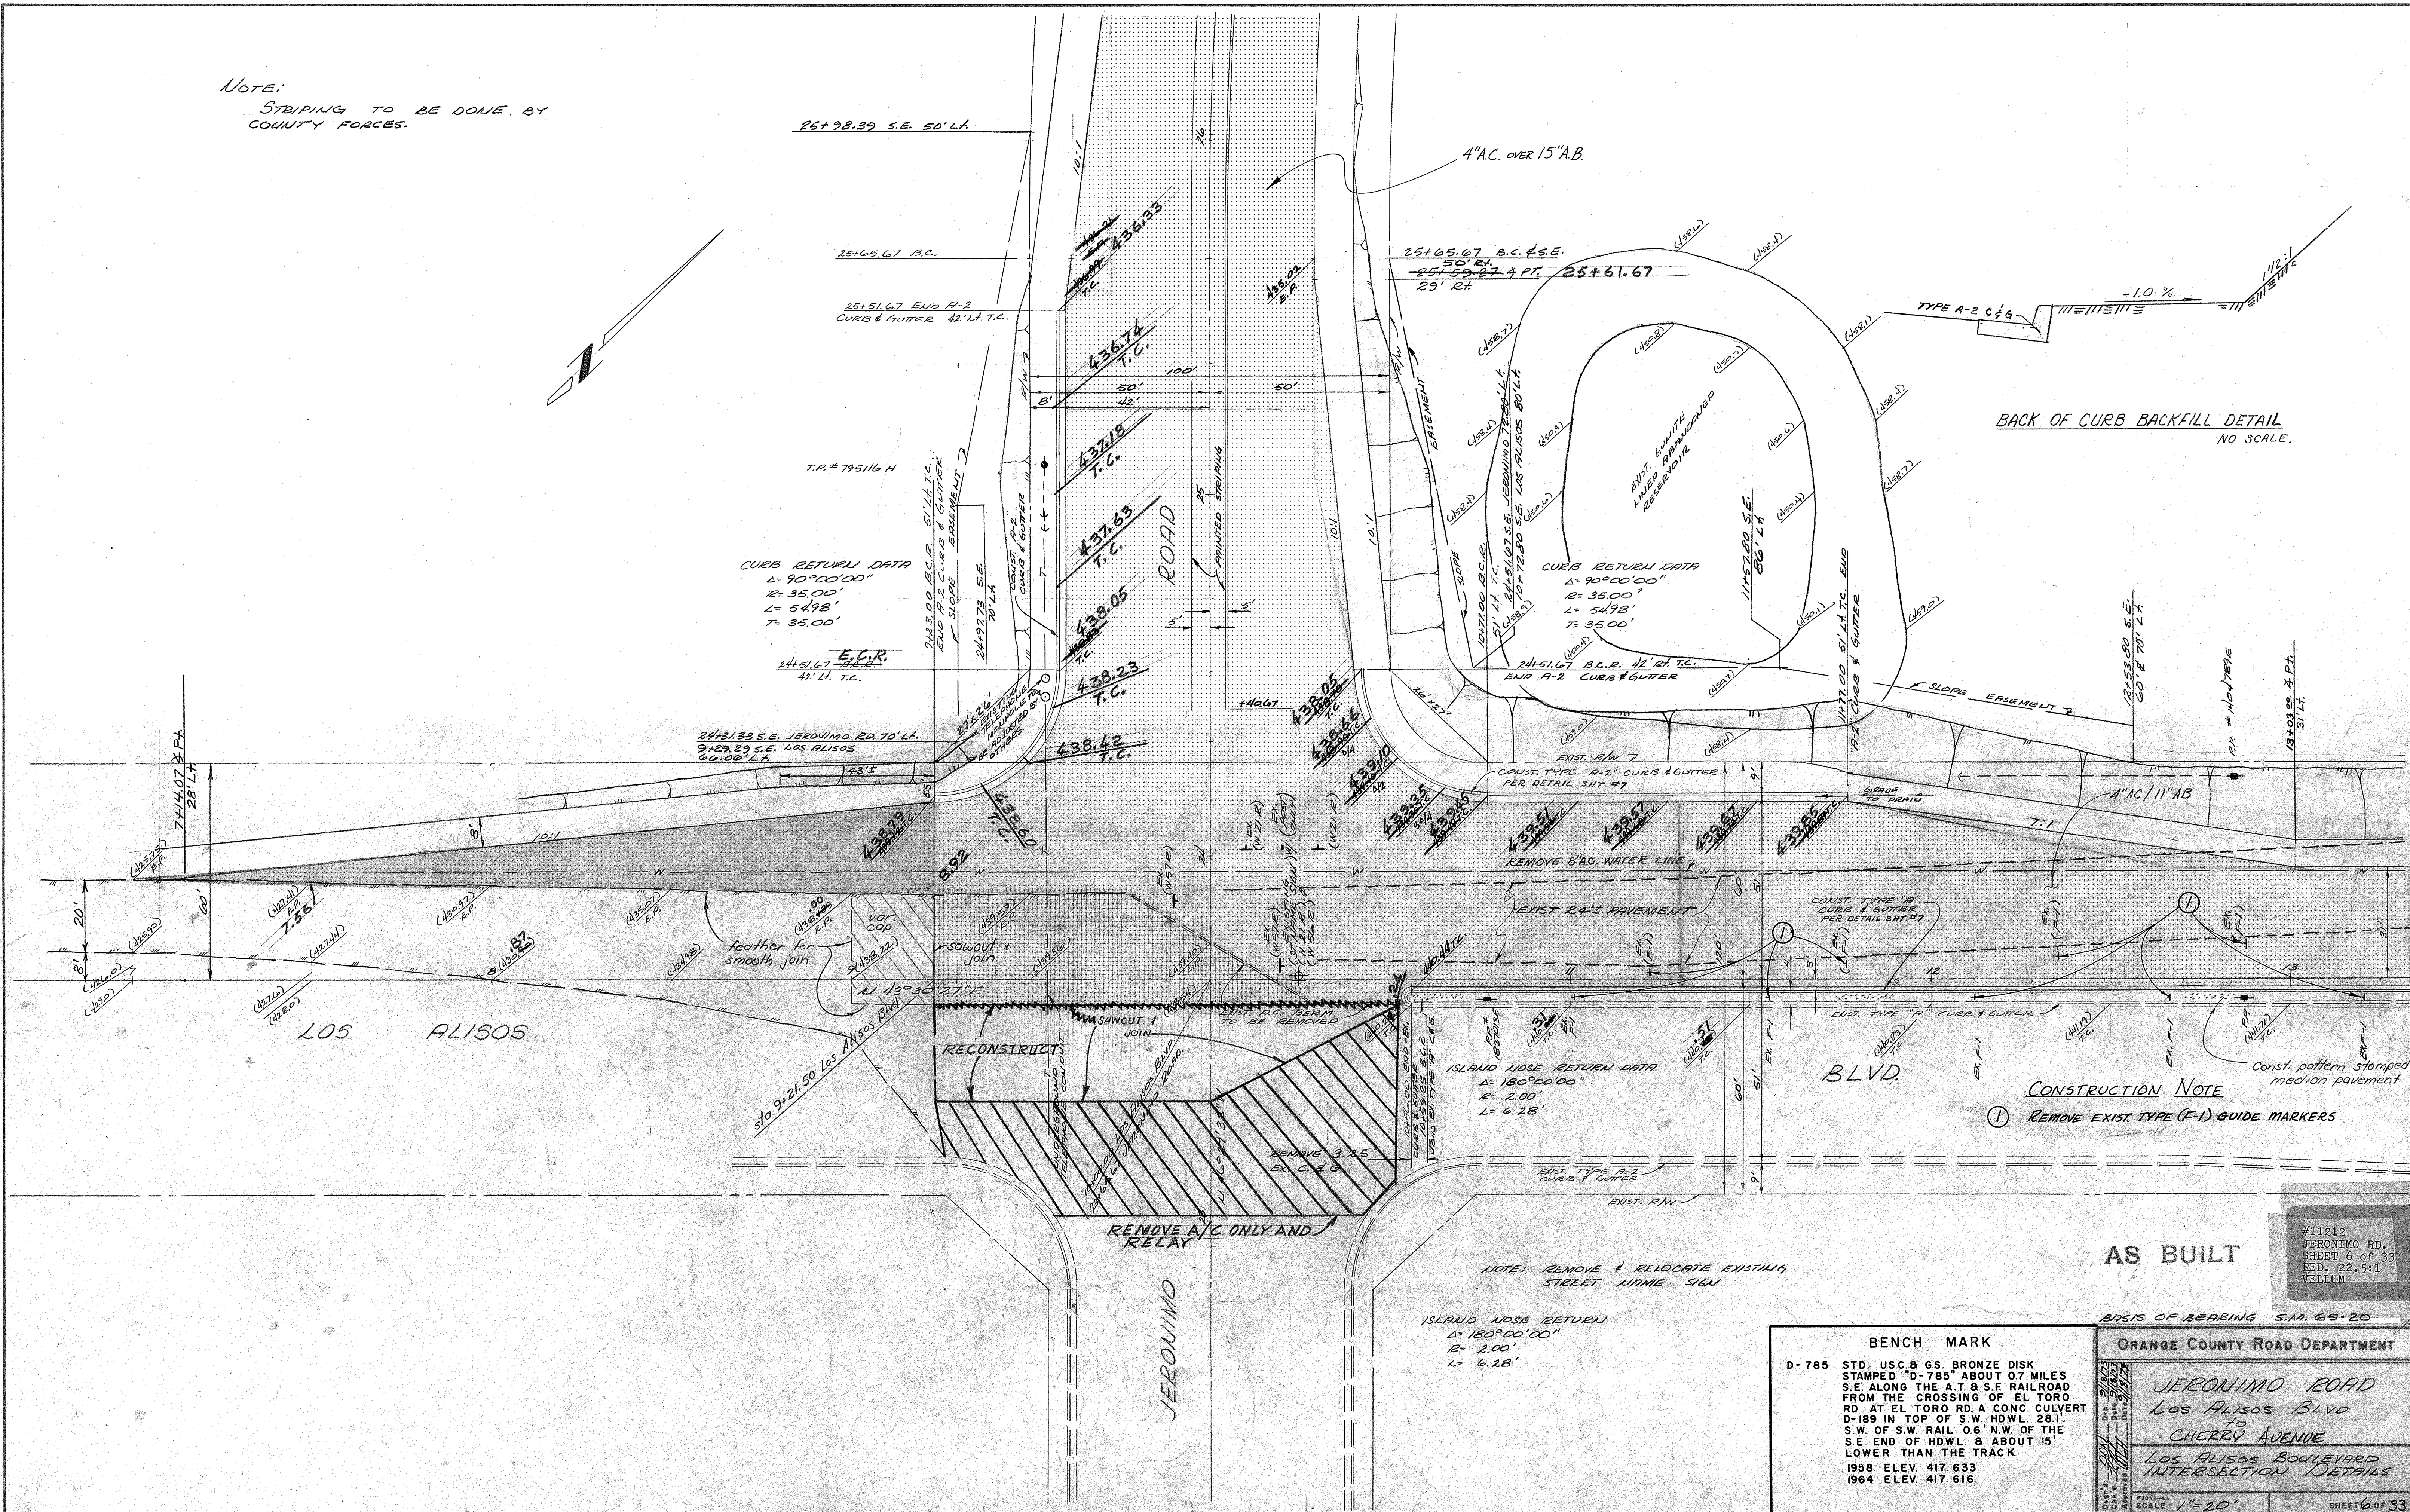

AS BUILT

BASIS OF BEARING S.M. 65-20

ORANGE COUNTY ROAD DEPARTMENT

JERONIMO ROAD
LOS ALISOS BLVD

70
CHERRY AVENUE
LOS ALISOS BOULEVARD
INTERSECTION DETAILS

F3011-84
 SCALE 1"=20'

SHEET 6 OF 3

#11212
JERONIMO RD.
SHEET 6 of 33
RED. 22.5:1
VELLUM

BENCH MARK

D-785 STD. USC & GS. BRONZE DISK
STAMPED "D-785 ABOUT 0.7 MILES
S.E. ALONG THE A.T. & S.F. RAILROAD
FROM THE CROSSING OF EL TORO
RD. AT EL TORO RD. A CONC. CULVERT
D-189 IN TOP OF S.W. HDWL. 28.1'
S.W. OF S.W. RAIL 0.6' N.W. OF THE
S.E. END OF HDWL & ABOUT 15'
LOWER THAN THE TRACK
1958 ELEV. 417.633
1964 ELEV. 417.616

DR.10 (4212)