



DATE	3/12/73
INITIAL	
DESIGNED	
CHECKED	
APPROVED	

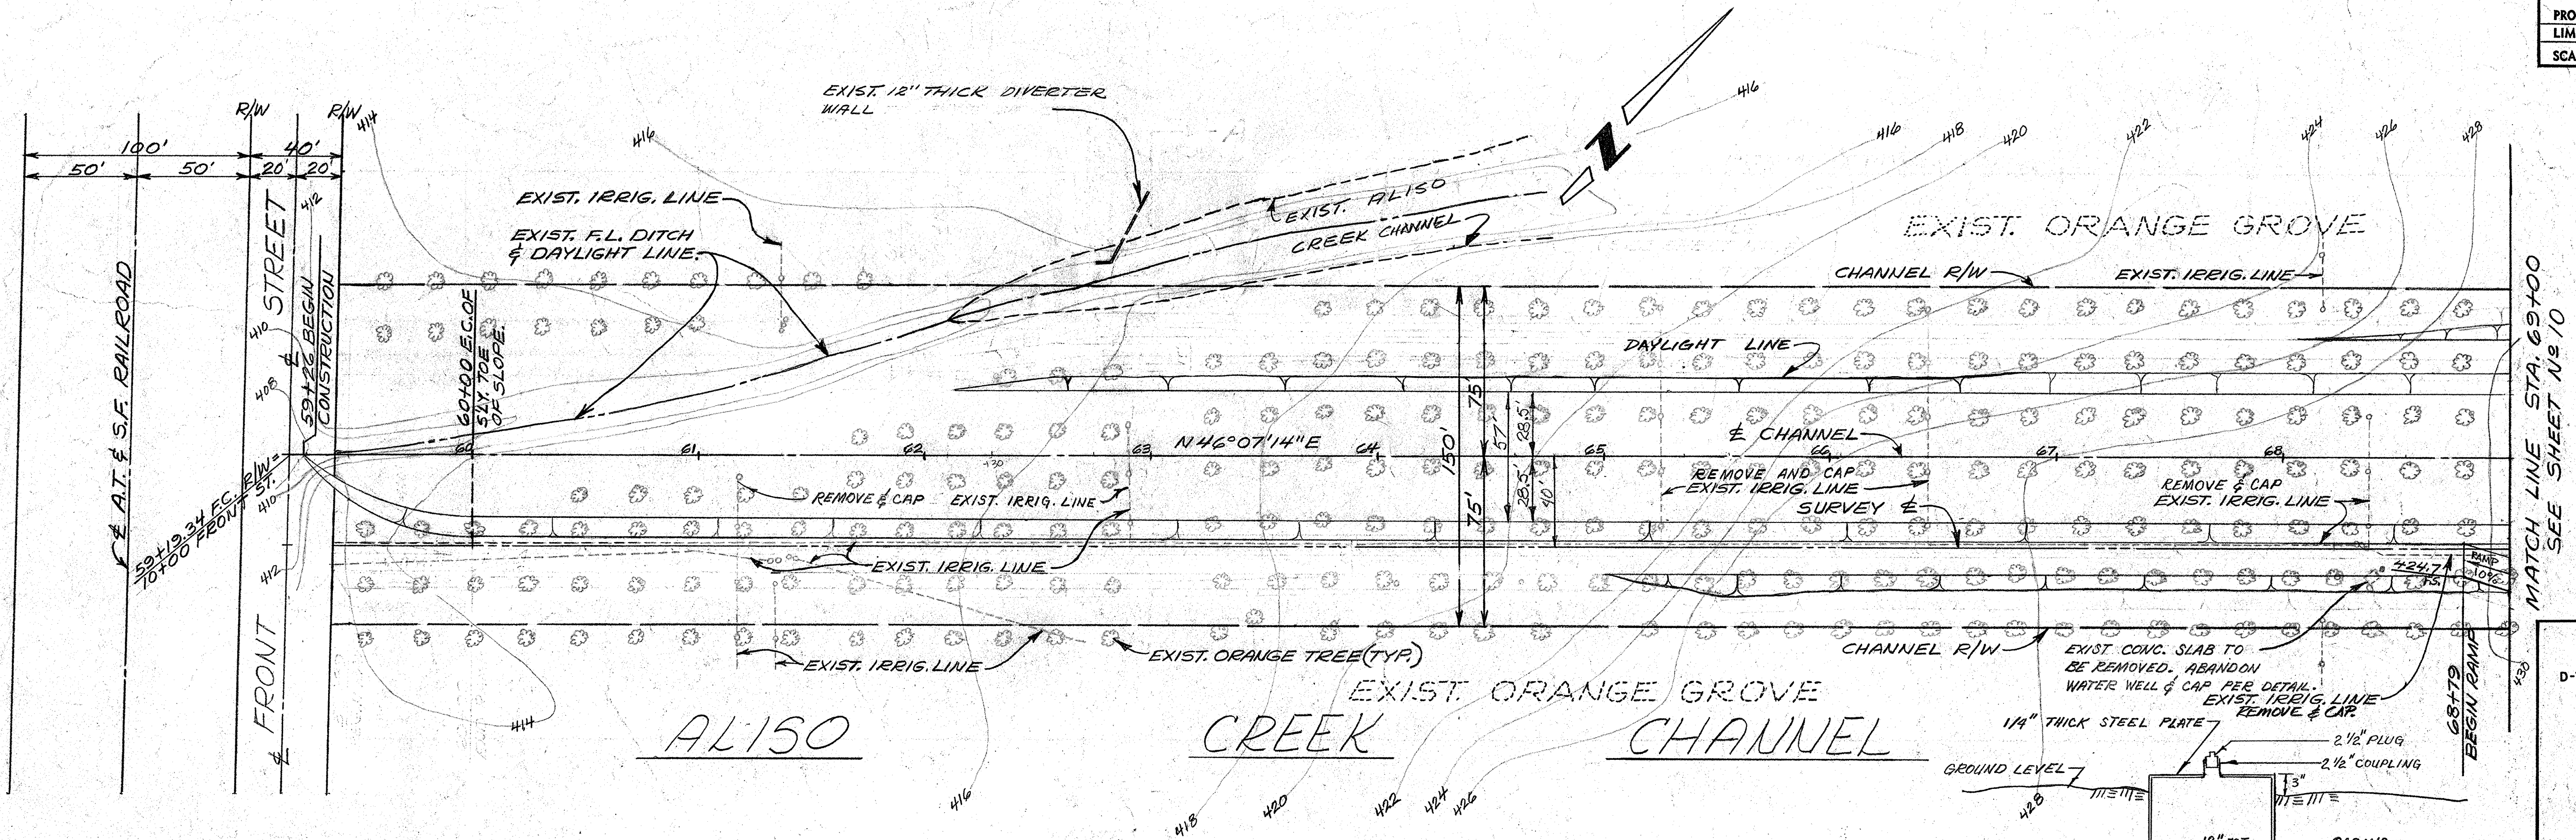


PLAN
SCALE: 1"=40'

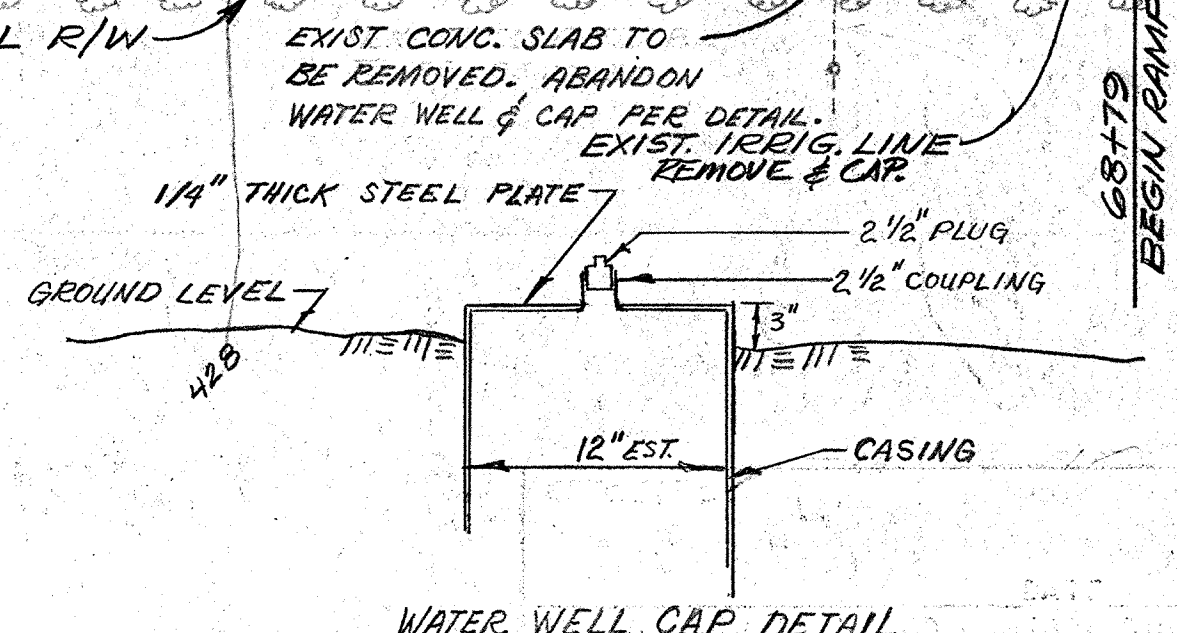

BENCH MARK
D-785 STD. USC & GS BRONZE DISK
STAMPED "D-785" ABOUT 0.7 MILES
S.E. ALONG THE AT. & S.F. RAILROAD
FROM THE CROSSING OF EL TORO RD.
AT EL TORO, AT A CONC. CULVERT
D-189, IN THE TOP OF THE S.W. HDWL.,
28.1' S.W. OF THE S.W. RAIL, 0.6' N.W.
OF THE S.E. END OF HDWL. & ABOUT
15' LOWER THAN THE TRACK.
1958 ELEV. 417.633
1964 ELEV. 417.616

PREPARED UNDER THE SUPERVISION OF:
Clifford C. Hood DATE 3-2-71
CLIFFORD C. HOOD R.C.E. 12489

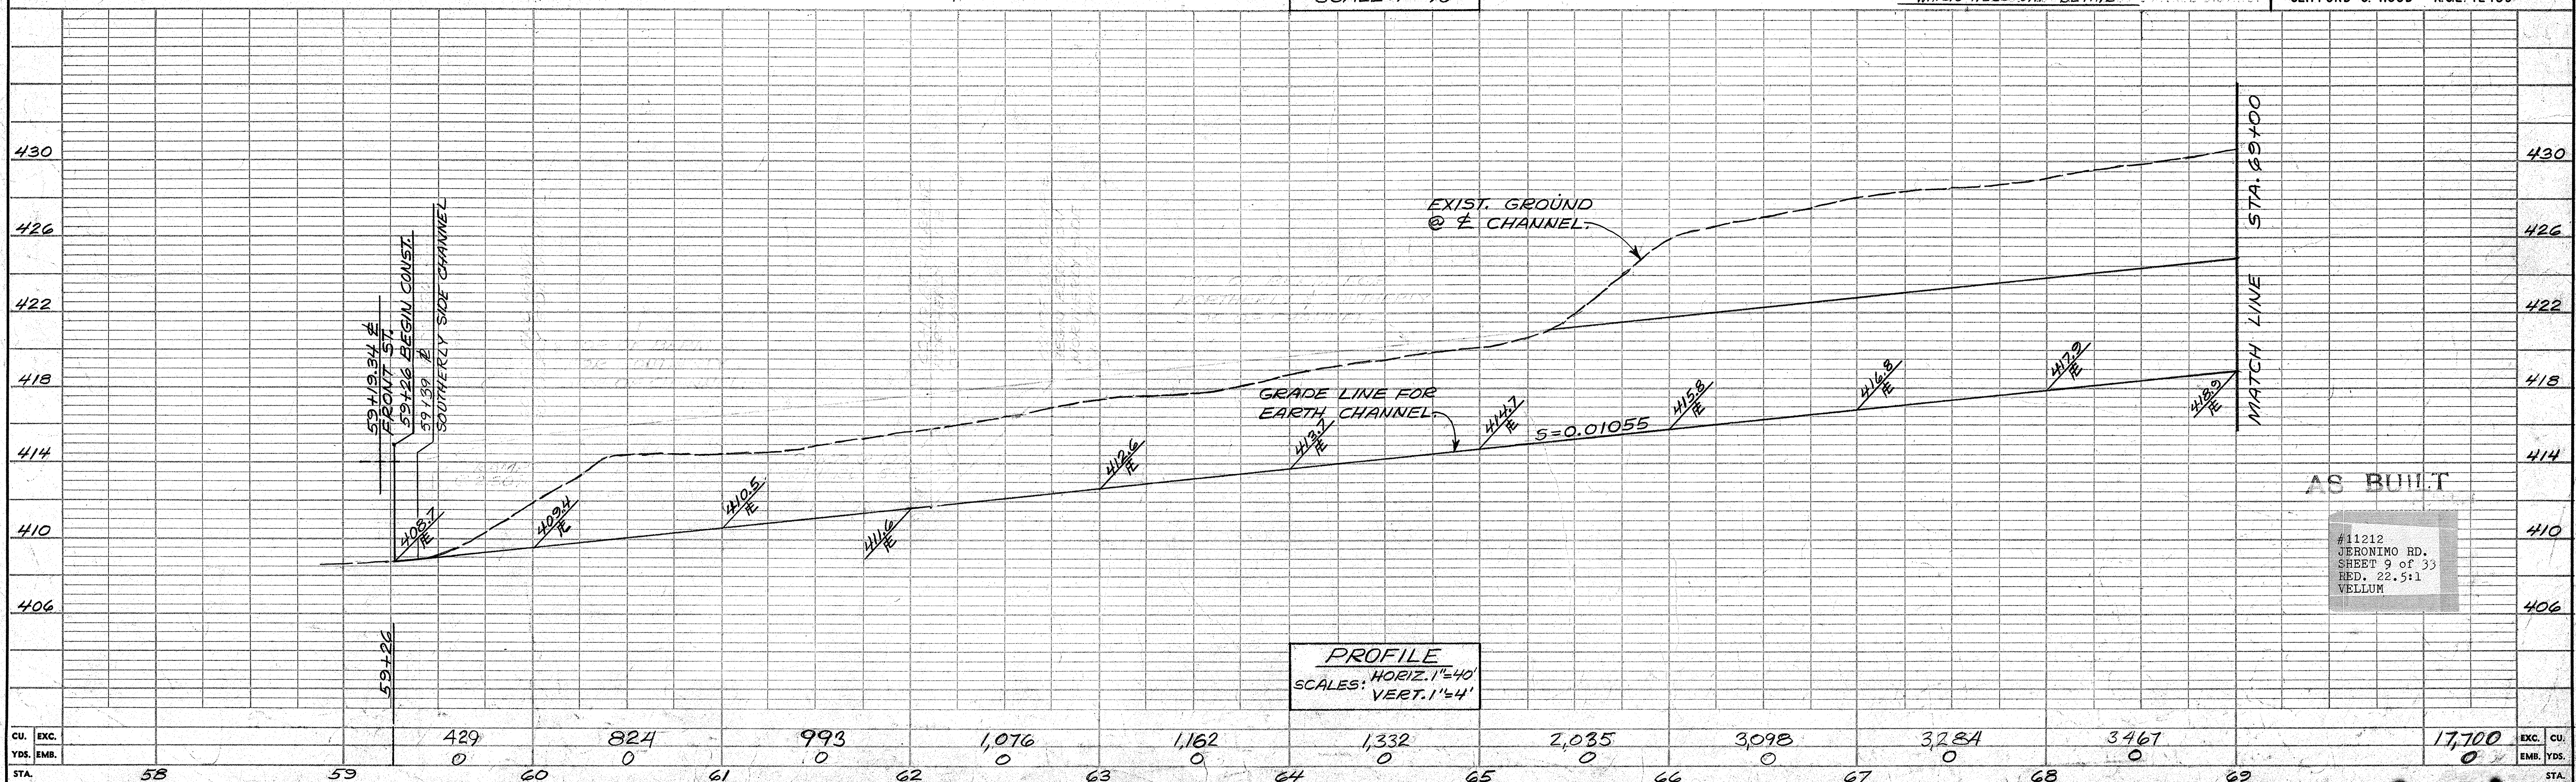

PROFILE
SCALES: HORIZ. 1"=40'
VERT. 1"=4'

AS BUILT

#11212
JERONIMO RD.
SHEET 9 OF 33
RED. 22.5:1
VELLUM

DE. 10 (11212)