


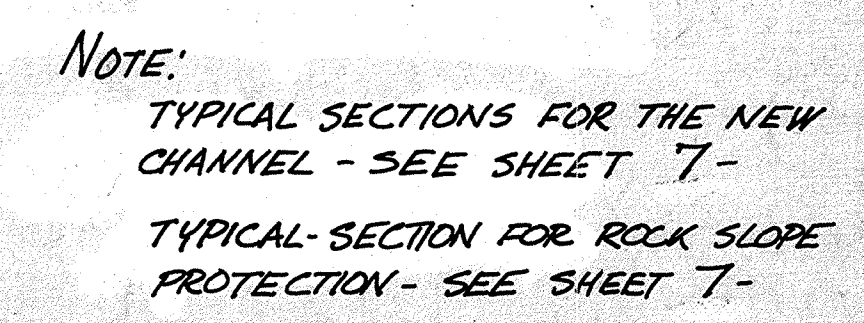

PREPARED UNDER THE SUPERVISION OF:
Clifford C. Hood DATE 3-2-71
CLIFFORD C. HOOD R.C.E. 12489

NOTE:
EXISTING SLOPE PROTECTION ON THE
WEST SIDE OF SECOND STREET BRIDGE
TO REMAIN UNDISTURBED IN PLACE.

CLIFFORD C. HOOD R.C.E. 12489

AS BUILT

#11212
JERONIMO RD.
SHEET 10 of 33
RED. 22.5.11
MEX. SEPTA

CU. EMB.	STA.	69	70	71	72	73	74	75	76	77	78	EXC. CU. EMB.
3372	0	3325	3676	3947	4067	4167	2989	3793	2080	2395	1017	1046
102	127	25712	21600	1350	4248							

#11212
JERONIMO RD.
SHEET 10 of 33
RED. 22.5:1
~~WEX~~ SEPIA