


FINAL	SURVEYED	BY	DATE
SURVEY	PLOTTED		
NOTE BOOK	TEMPLATE		
NO.	AREAS CHECKED		

ORIGINAL	SURVEYED	BY	DATE
SURVEY	PLOTTED		
NOTE BOOK	TEMPLATE		
NO.	AREAS CHECKED		

ORANGE COUNTY ROAD DEPARTMENT
PROJECT JERONIMO ROAD
LIMITS LOS ALISOS BLVD. + CHERRY AVE
SCALE HORIZ. & VERT. 1"=40' SHEET 16 OF 33

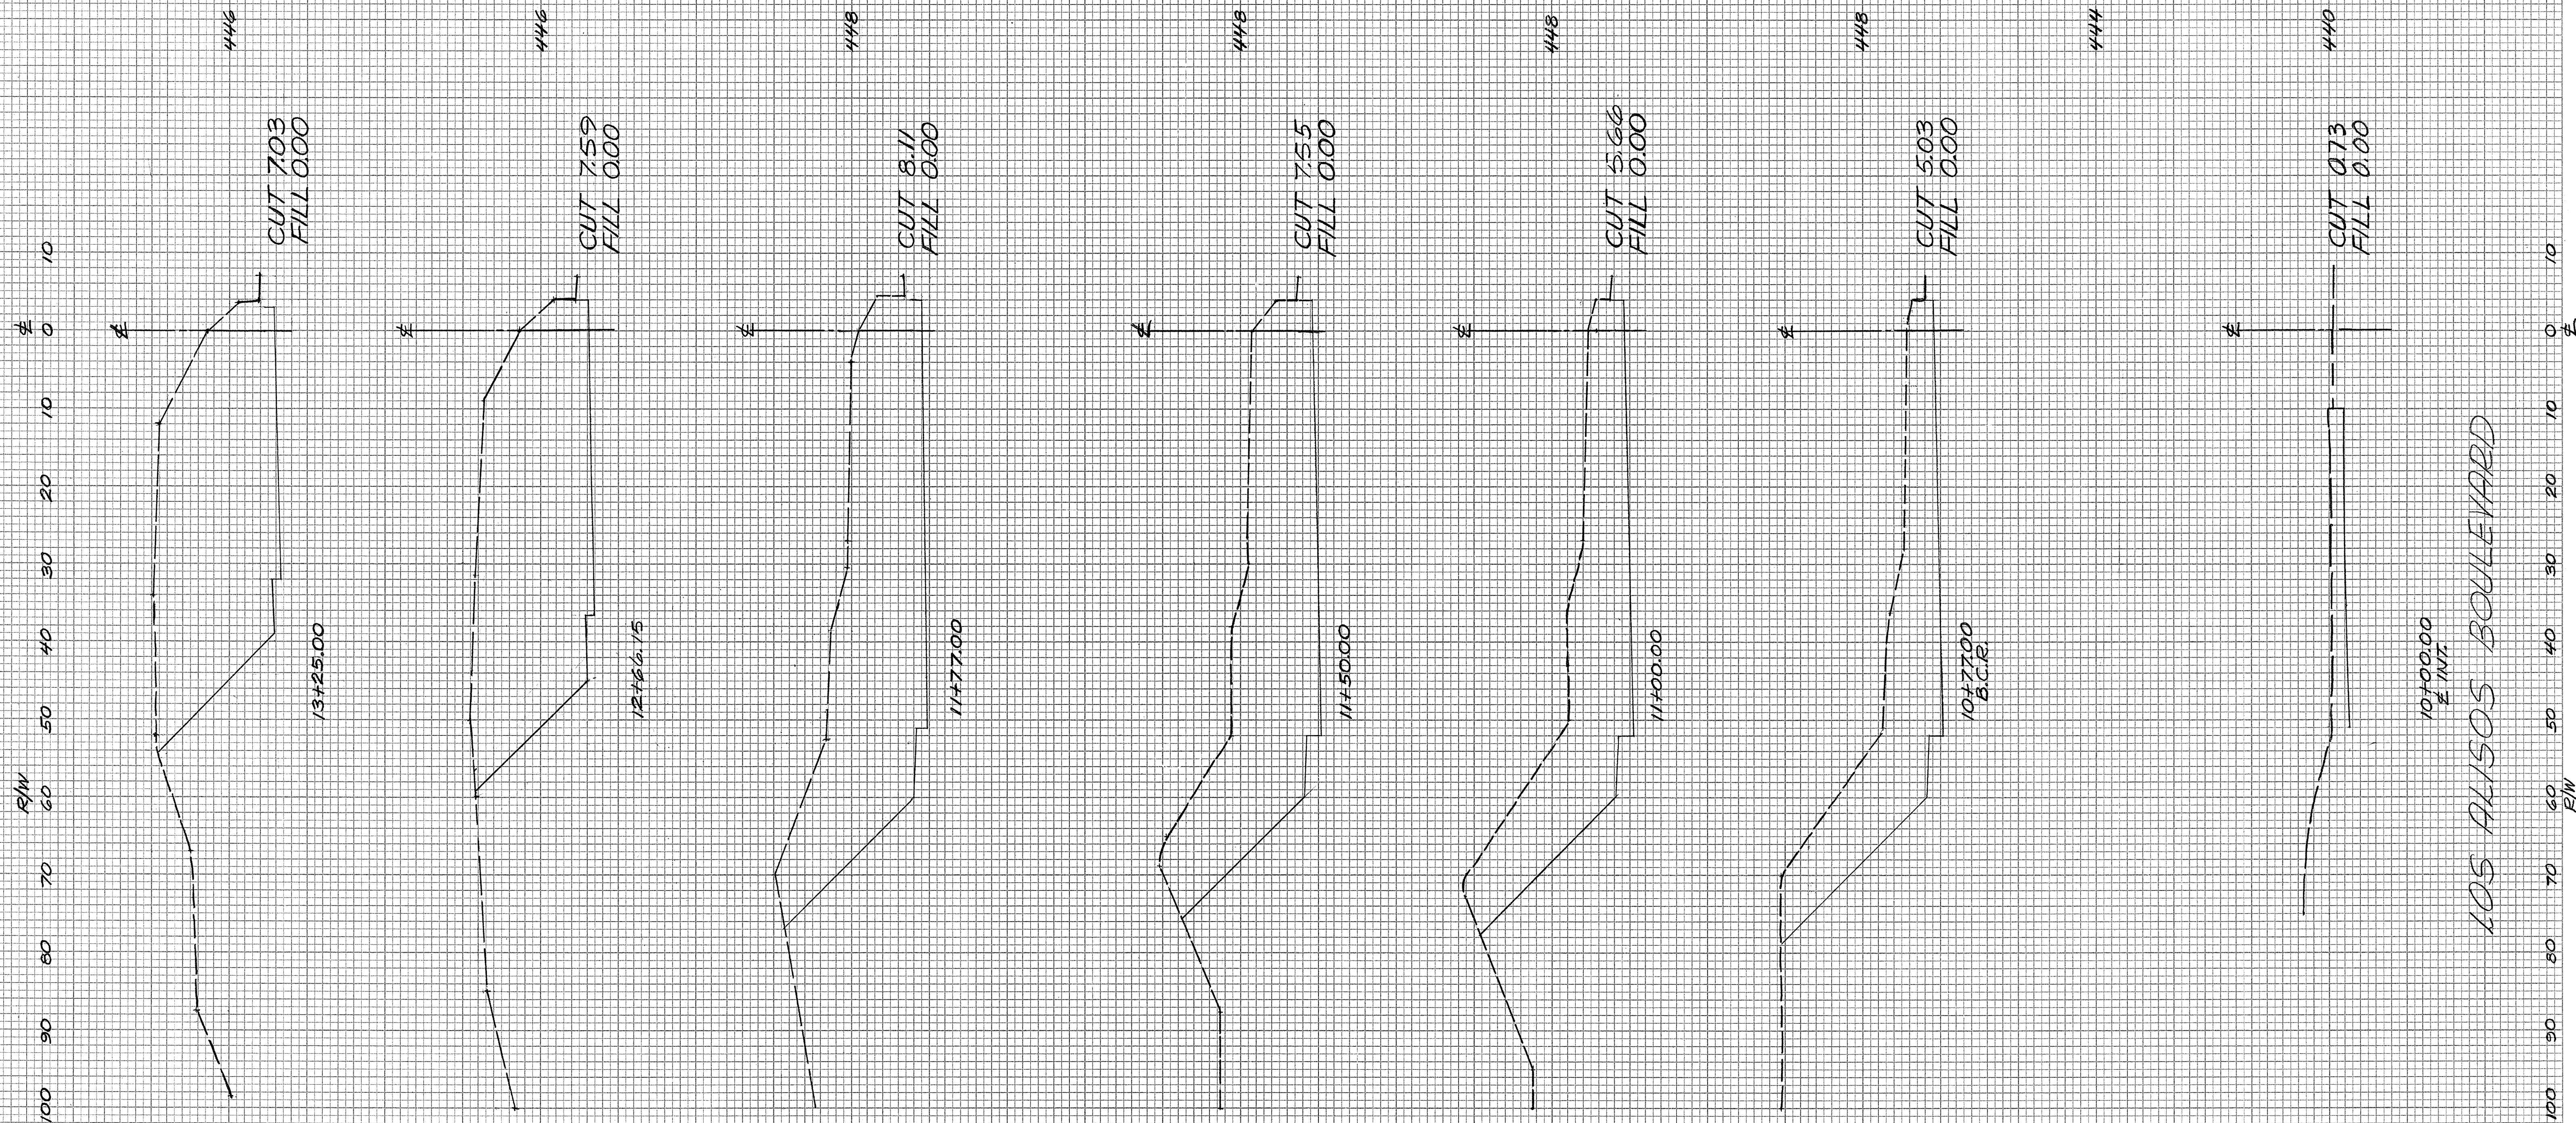

AS BUILT

#11212
JERONIMO RD.
SHEET 16 of 33
RED. 22.5:1
CROSS SECTION