


FINAL SURVEY	SURVEYED	BY	DATE
NO.	PLOTTED		
	NOTE BOOK		
	AREAS CHECKED		

ORIGINAL SURVEY	SURVEYED	BY	DATE
NO.	PLOTTED		
	NOTE BOOK		
	AREAS CHECKED		

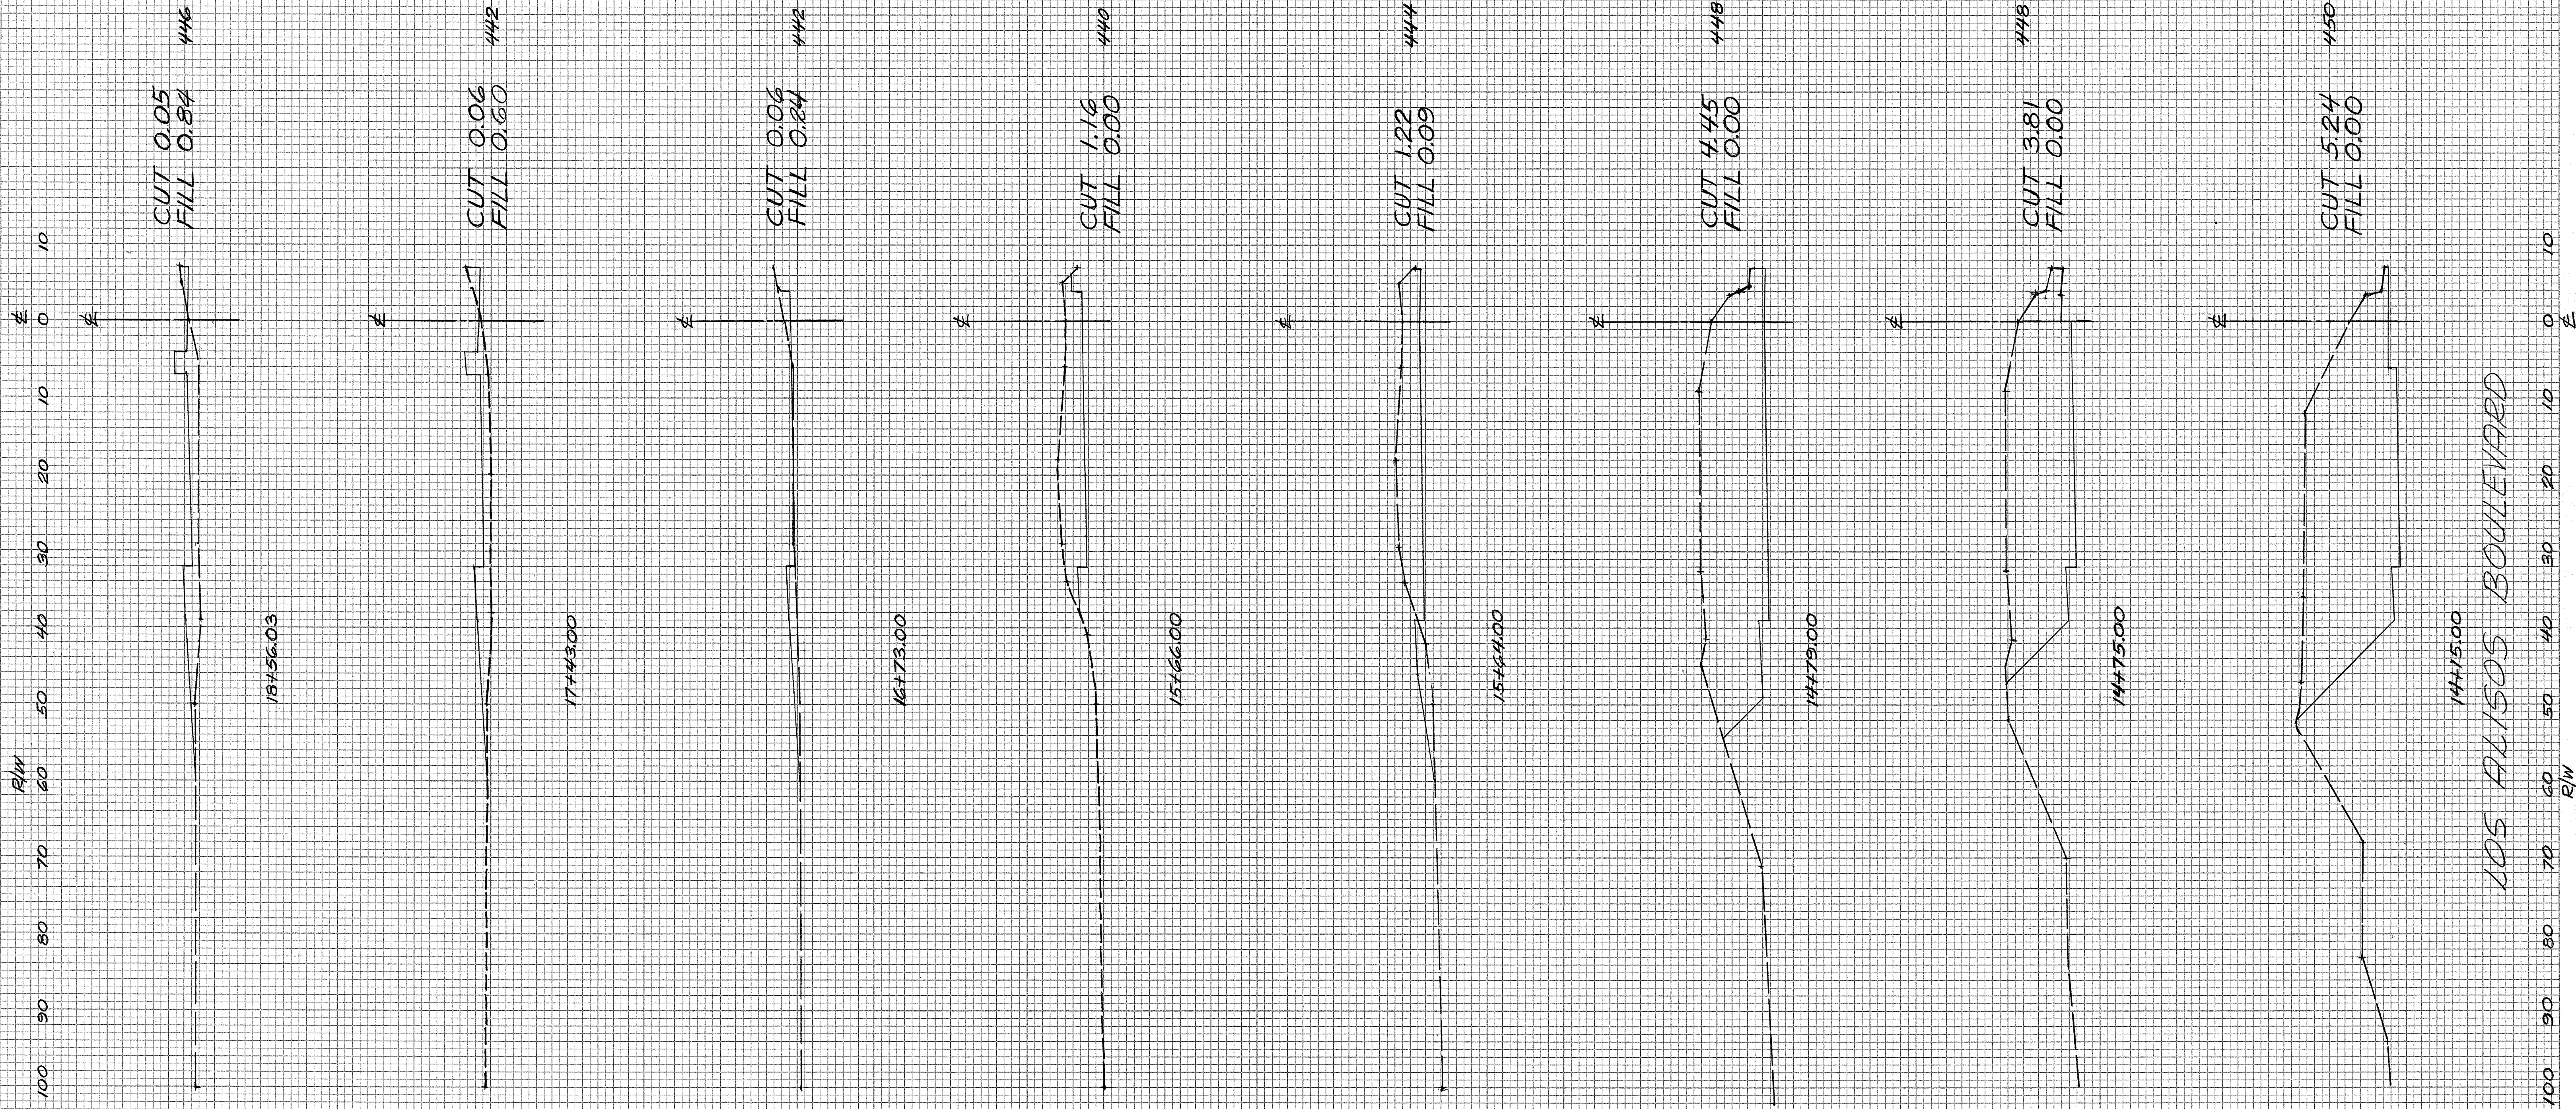

AS BUILT

#11212
JERONIMO RD.
SHEET 17 OF 33
RED. 22.5:1
CROSS SECTION