


FINAL SURVEY	SURVEYED	DATE
SURVEY	PLOTTED	
NOTE BOOK	TEMPERATURE	
NO.	AREAS CHECKED	

ORIGINAL SURVEY	BY	DATE
SURVEY		
NOTE BOOK	TEMPERATURE	
NO.	AREAS CHECKED	

ORANGE COUNTY ROAD DEPARTMENT
PROJECT JERONIMO ROAD
LIMITS Los Alisos Blvd. to Cherry Ave
SCALE: HORIZ. & VERT. 1"=10' SHEET 18 OF 33

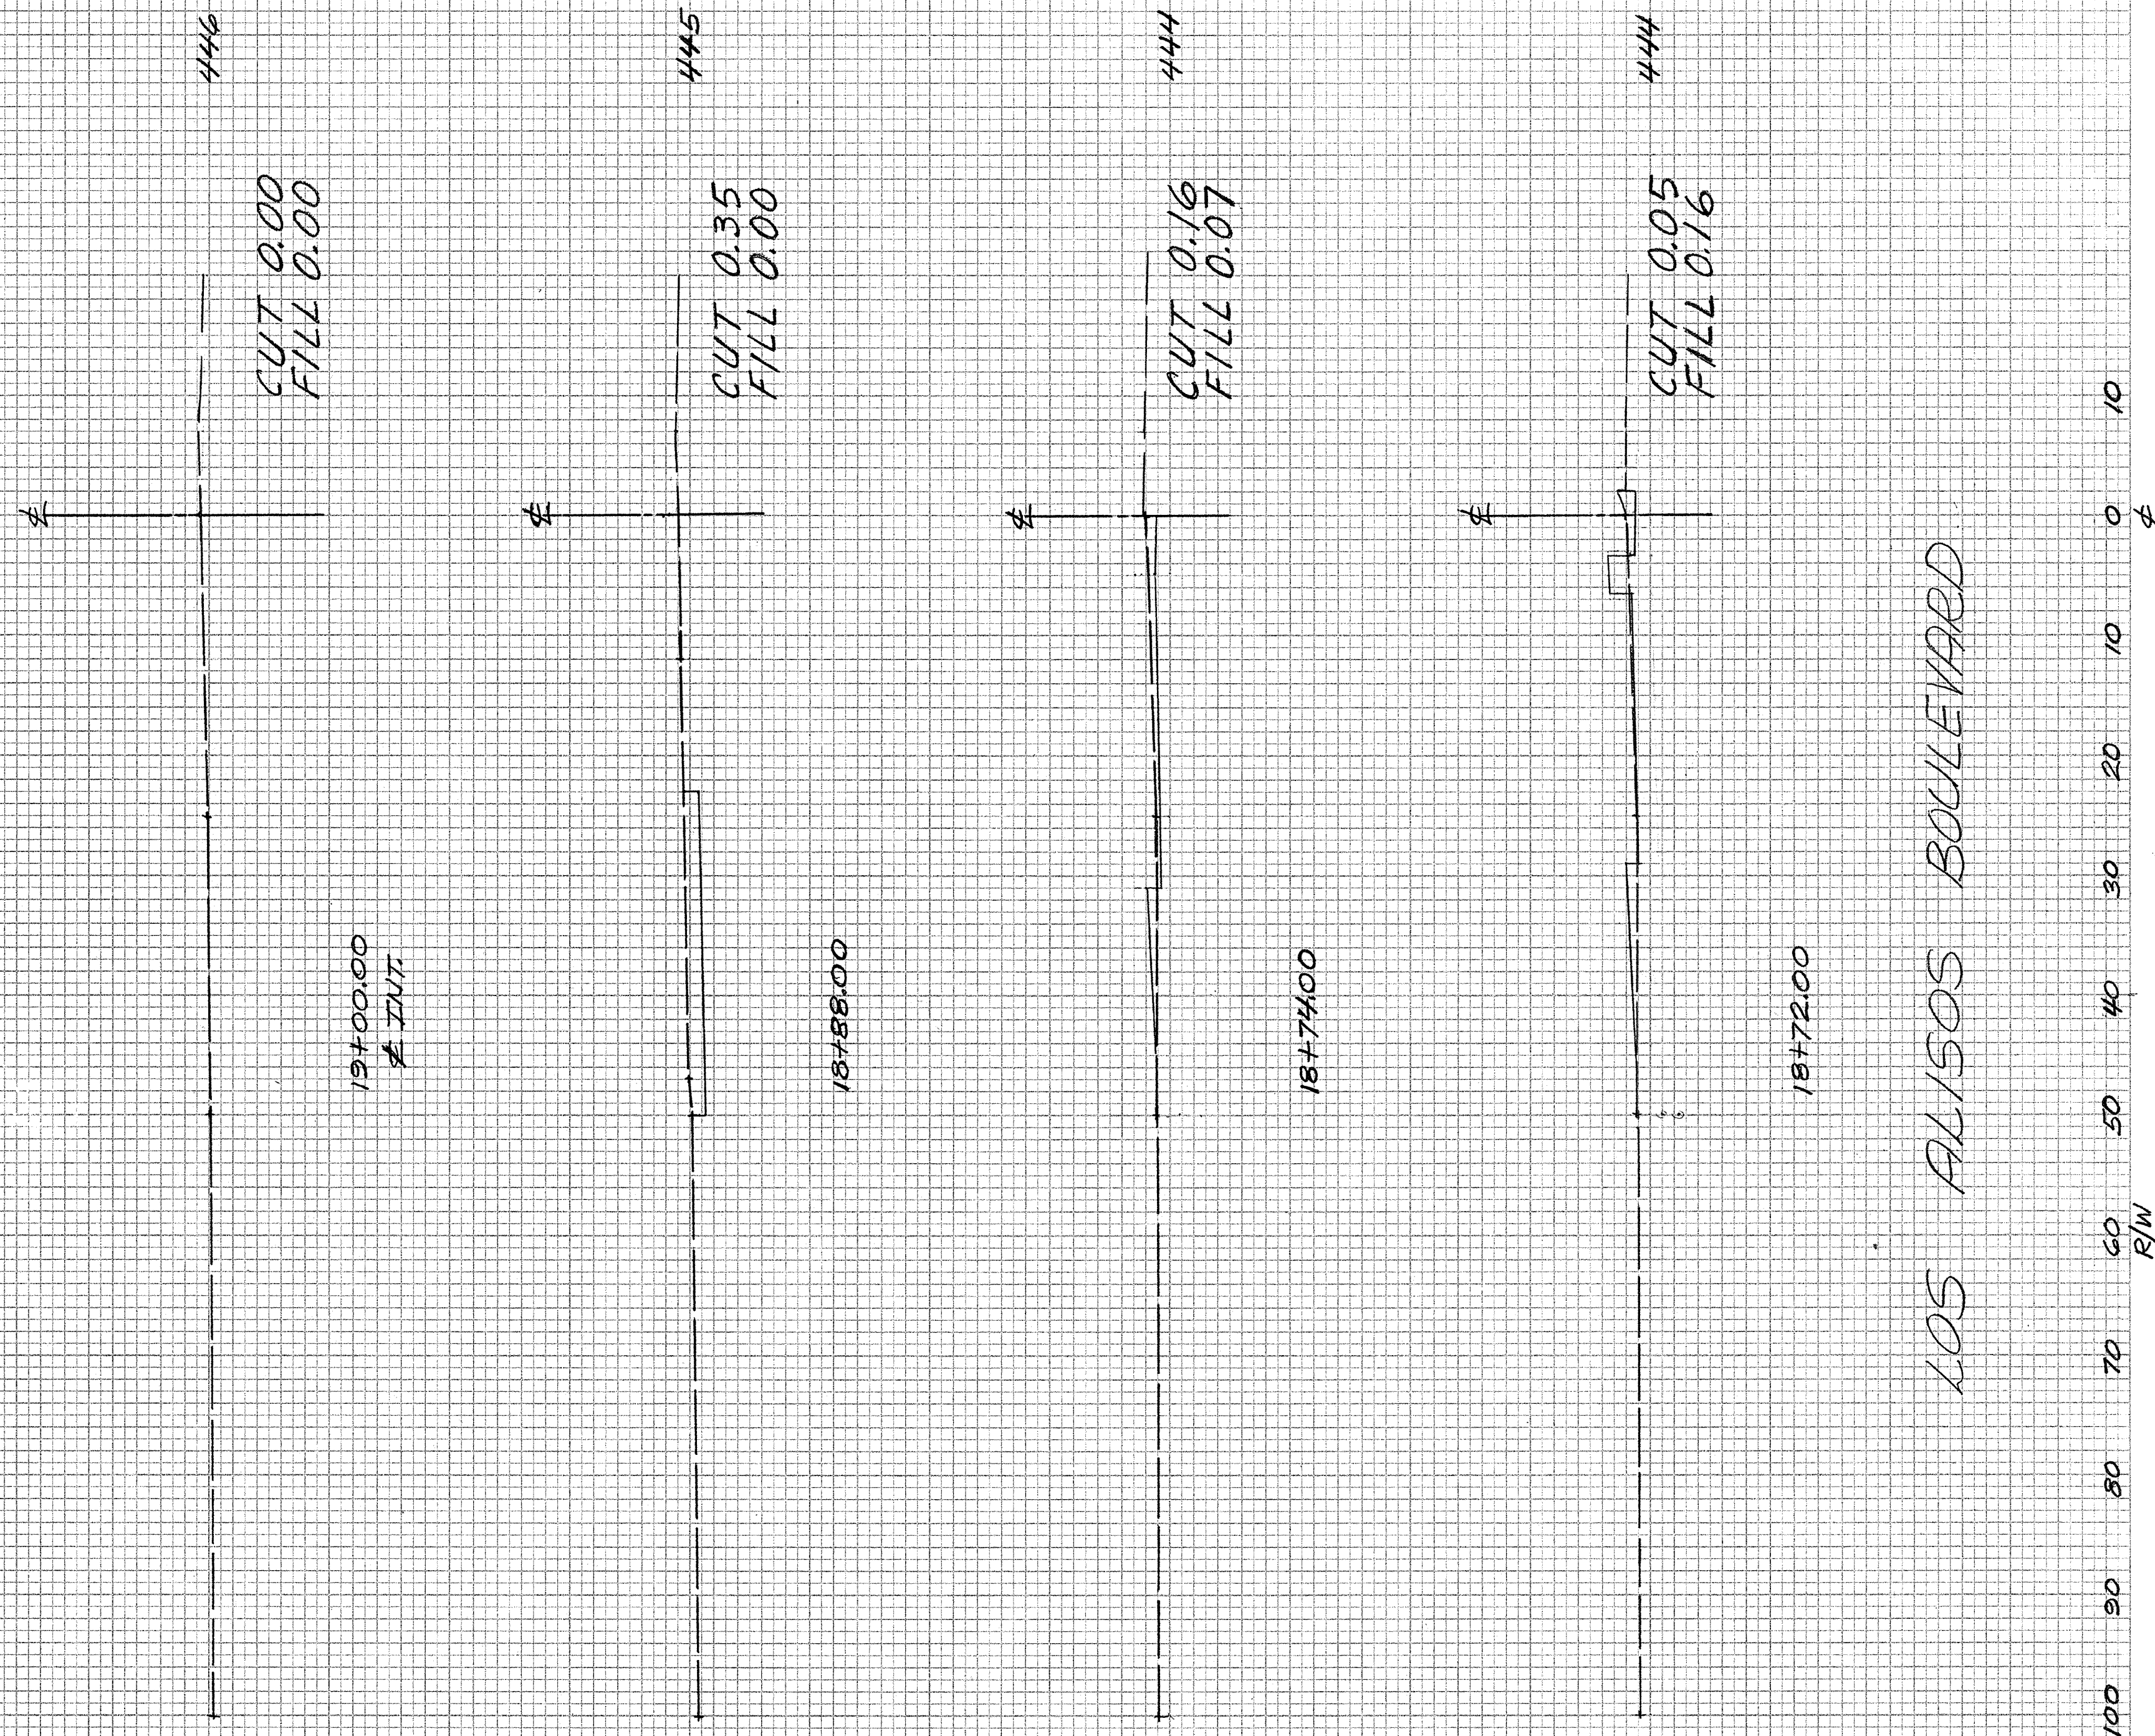

AS BUILT

#11212
JERONIMO RD.
SHEET 18 of 33
RED. 22.5:1
CROSS SECTION