


ORIGINAL SURVEY	SURVEYED PLOTED	BY	DATE
NO.	NO.		
NOTE BOOK		DATE	
AREAS CHECKED		DATE	

FINAL SURVEY	SURVEYED PLOTED	BY	DATE
NO.	NO.		
NOTE BOOK		DATE	
AREAS CHECKED		DATE	

RANGE COUNTY ROAD DEPARTMENT
 PROJECT JERONIMO ROAD
 LIMITS LOS ALAMOS BLVD TO CHERRY AVE
 SCALE HORIZ. 1"=10' VERT. 1"=10' SHEET 19 OF 33

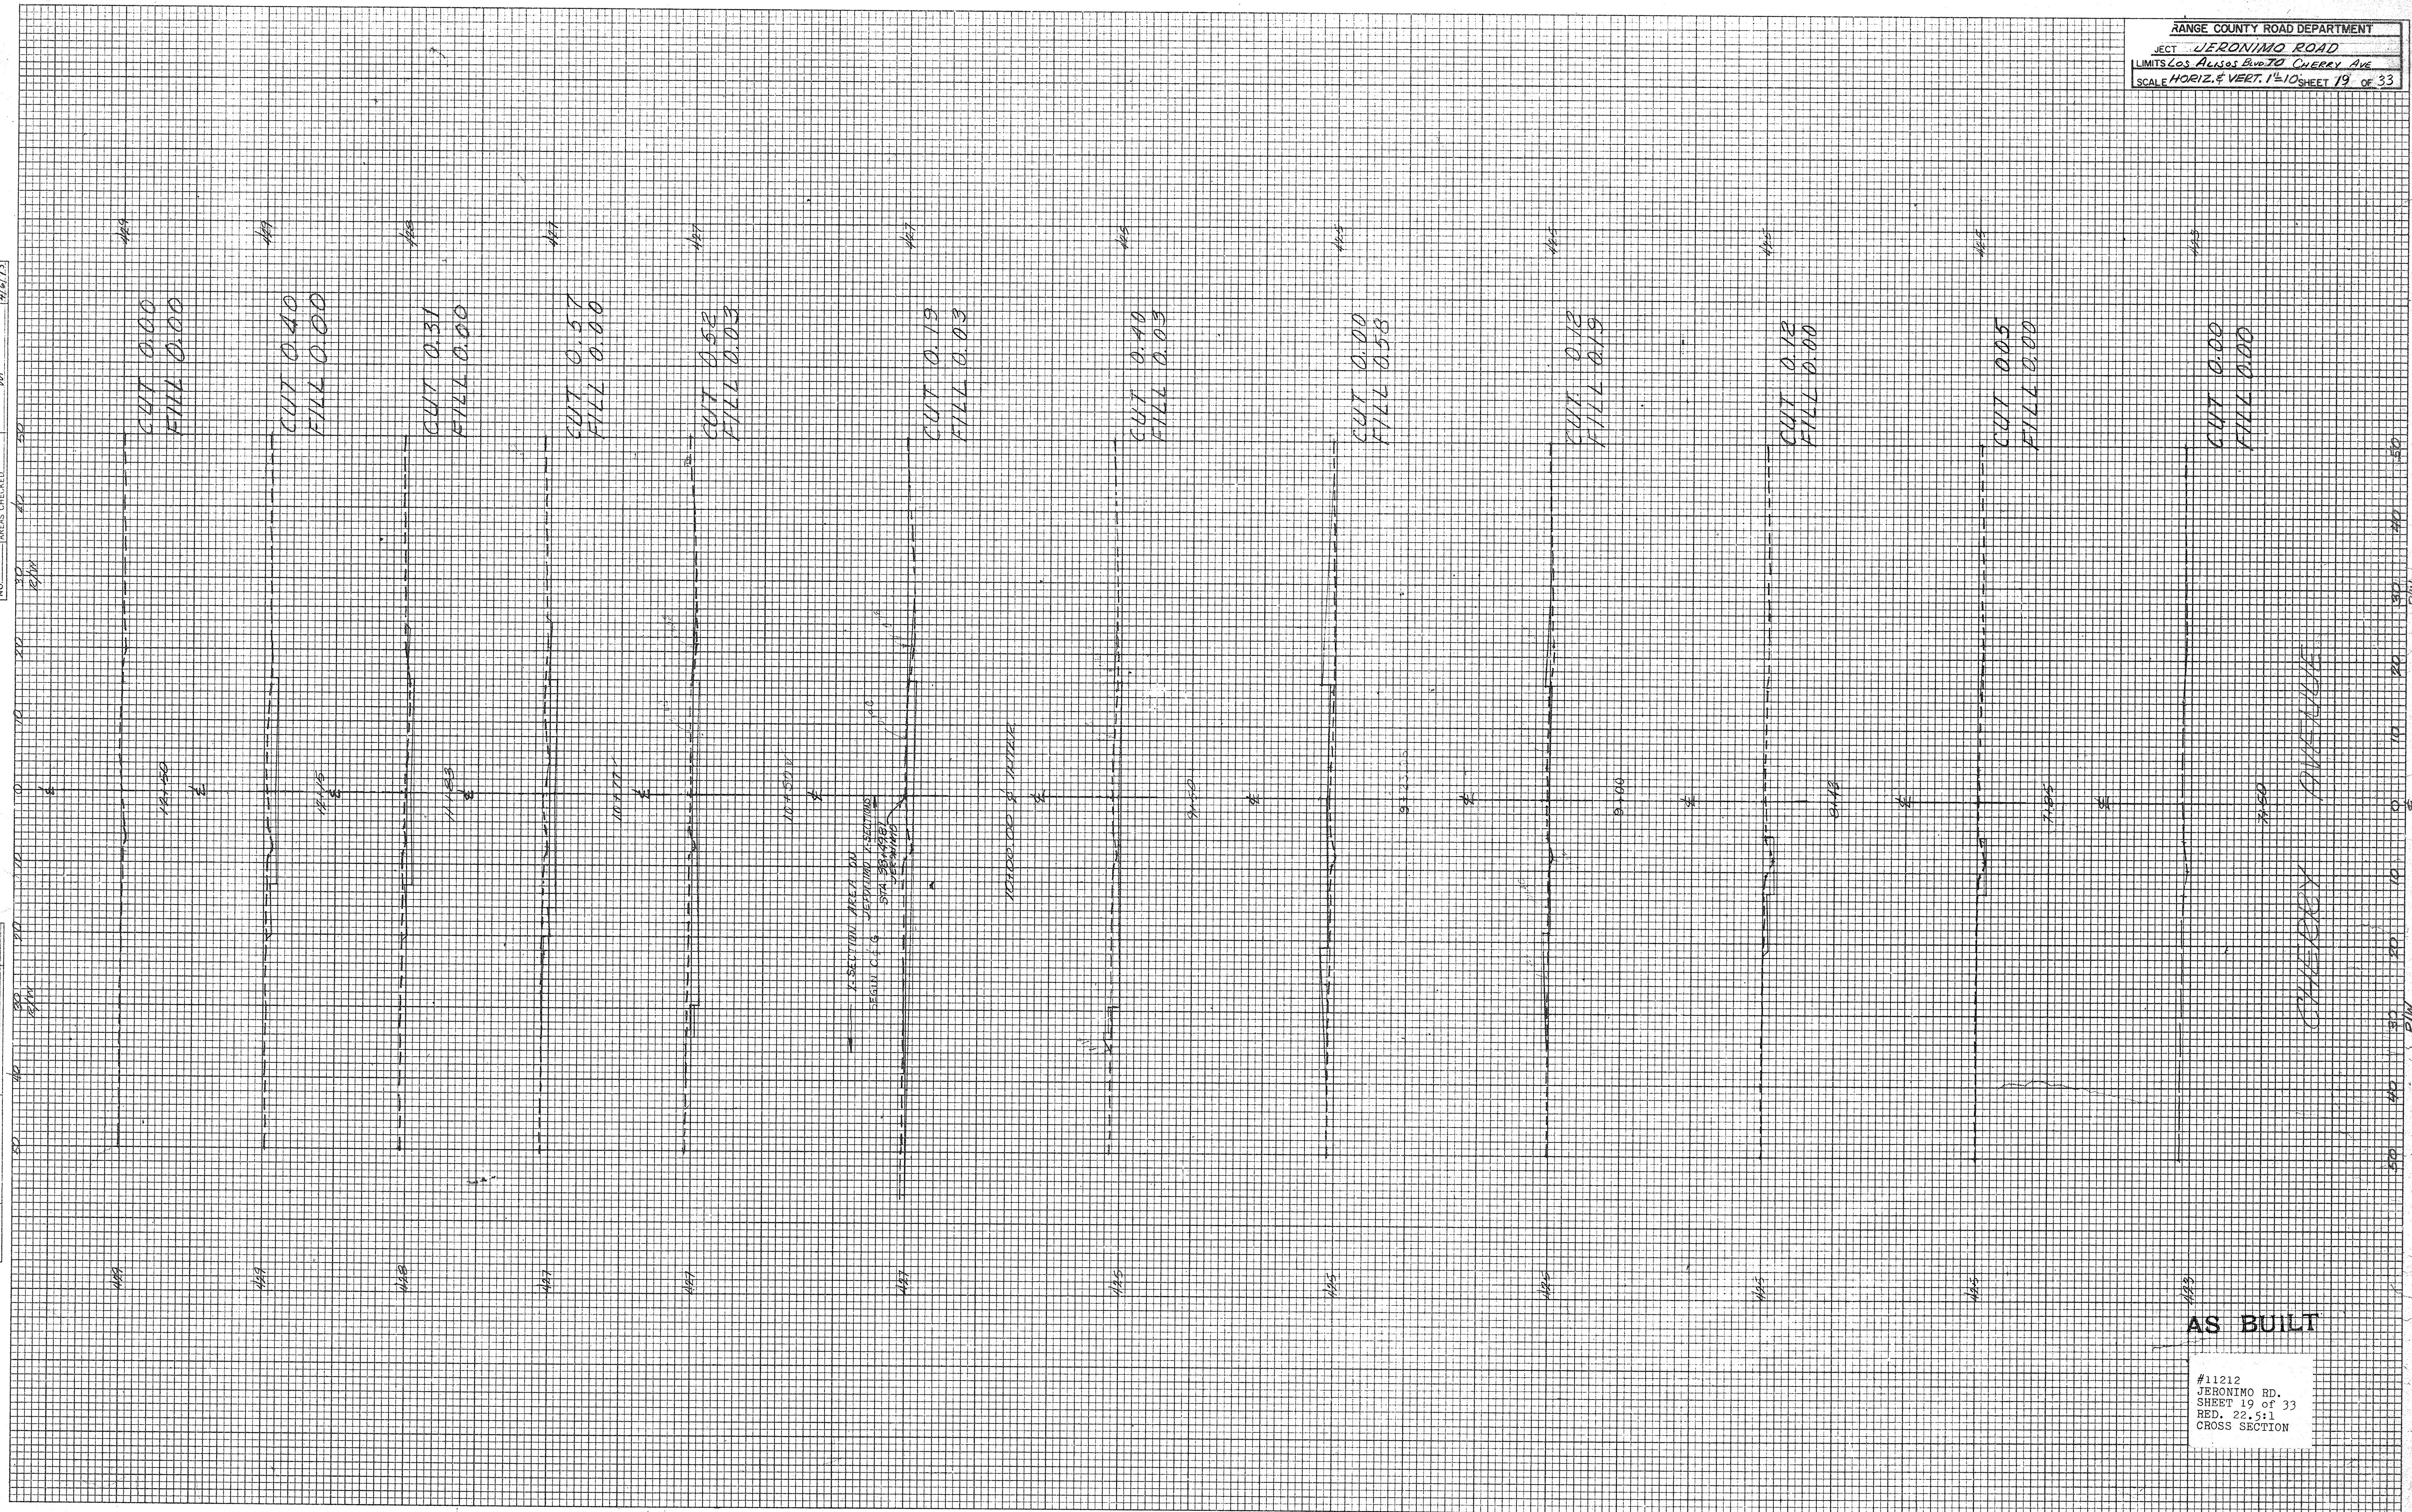

KE PLATE 3, CROSS SECTION
 KEUFFEL & ESSER CO.

48 7056 ALBANENE® TRACING PAPER 27945
 MADE IN U.S.A.

AS BUILT

#11212
 JERONIMO RD.
 SHEET 19 of 33
 RED. 22.5:1
 CROSS SECTION

DR. 10 (11212)