


FINAL	SURVEYED	DATE
SURVEY	PLOTTED	BY
NO.	NOTE BOOK	NO.
	AREAS CHECKED	

ORIGINAL	SURVEYED	DATE
SURVEY	PLOTTED	BY
NO.	NOTE BOOK	NO.
	AREAS CHECKED	

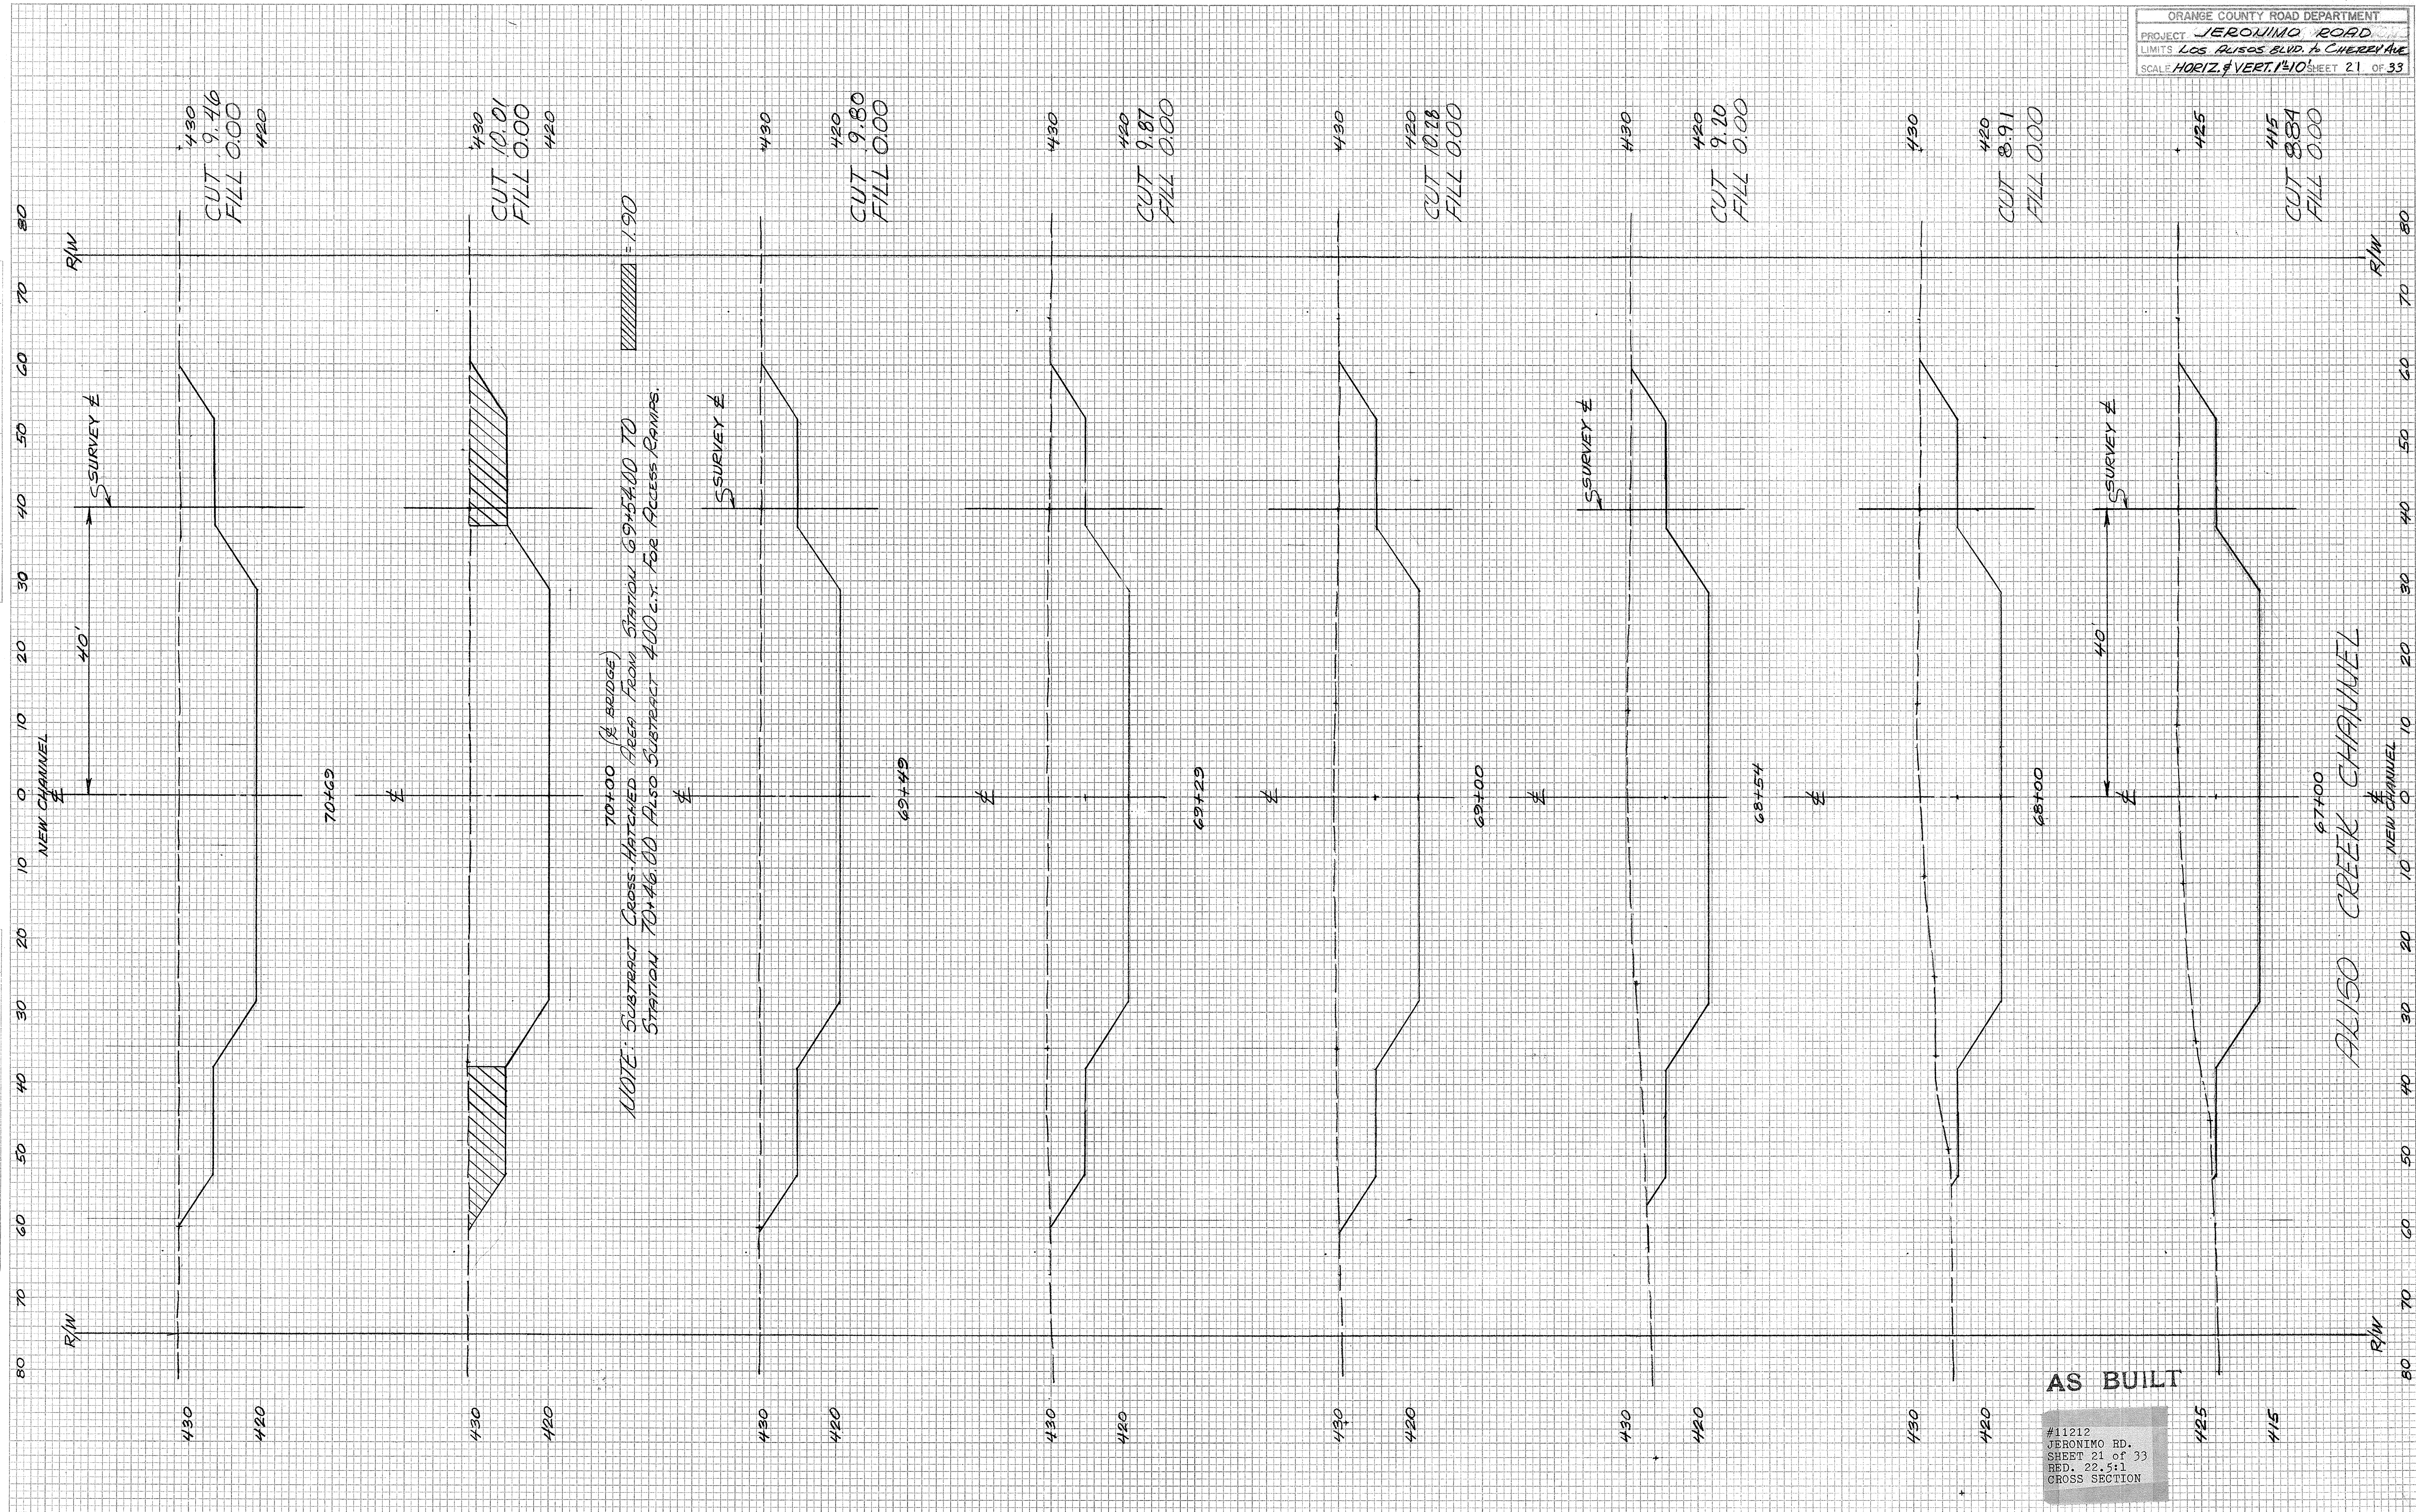

#11212
JERONIMO RD.
SHEET 21 of 33
RED. 22.5:1
CROSS SECTION

DR. 10 (11212)