


FINAL SURVEY  
 SURVEYED, PLOTTED, & CHECKED  
 NO. \_\_\_\_\_ DATE \_\_\_\_\_  
 BY \_\_\_\_\_  
 NOTE BOOK NO. \_\_\_\_\_  
 AREAS CHECKED \_\_\_\_\_

ORIGINAL SURVEY  
 SURVEYED, PLOTTED, & CHECKED  
 NO. \_\_\_\_\_ DATE \_\_\_\_\_  
 BY \_\_\_\_\_  
 NOTE BOOK NO. \_\_\_\_\_  
 AREAS CHECKED \_\_\_\_\_

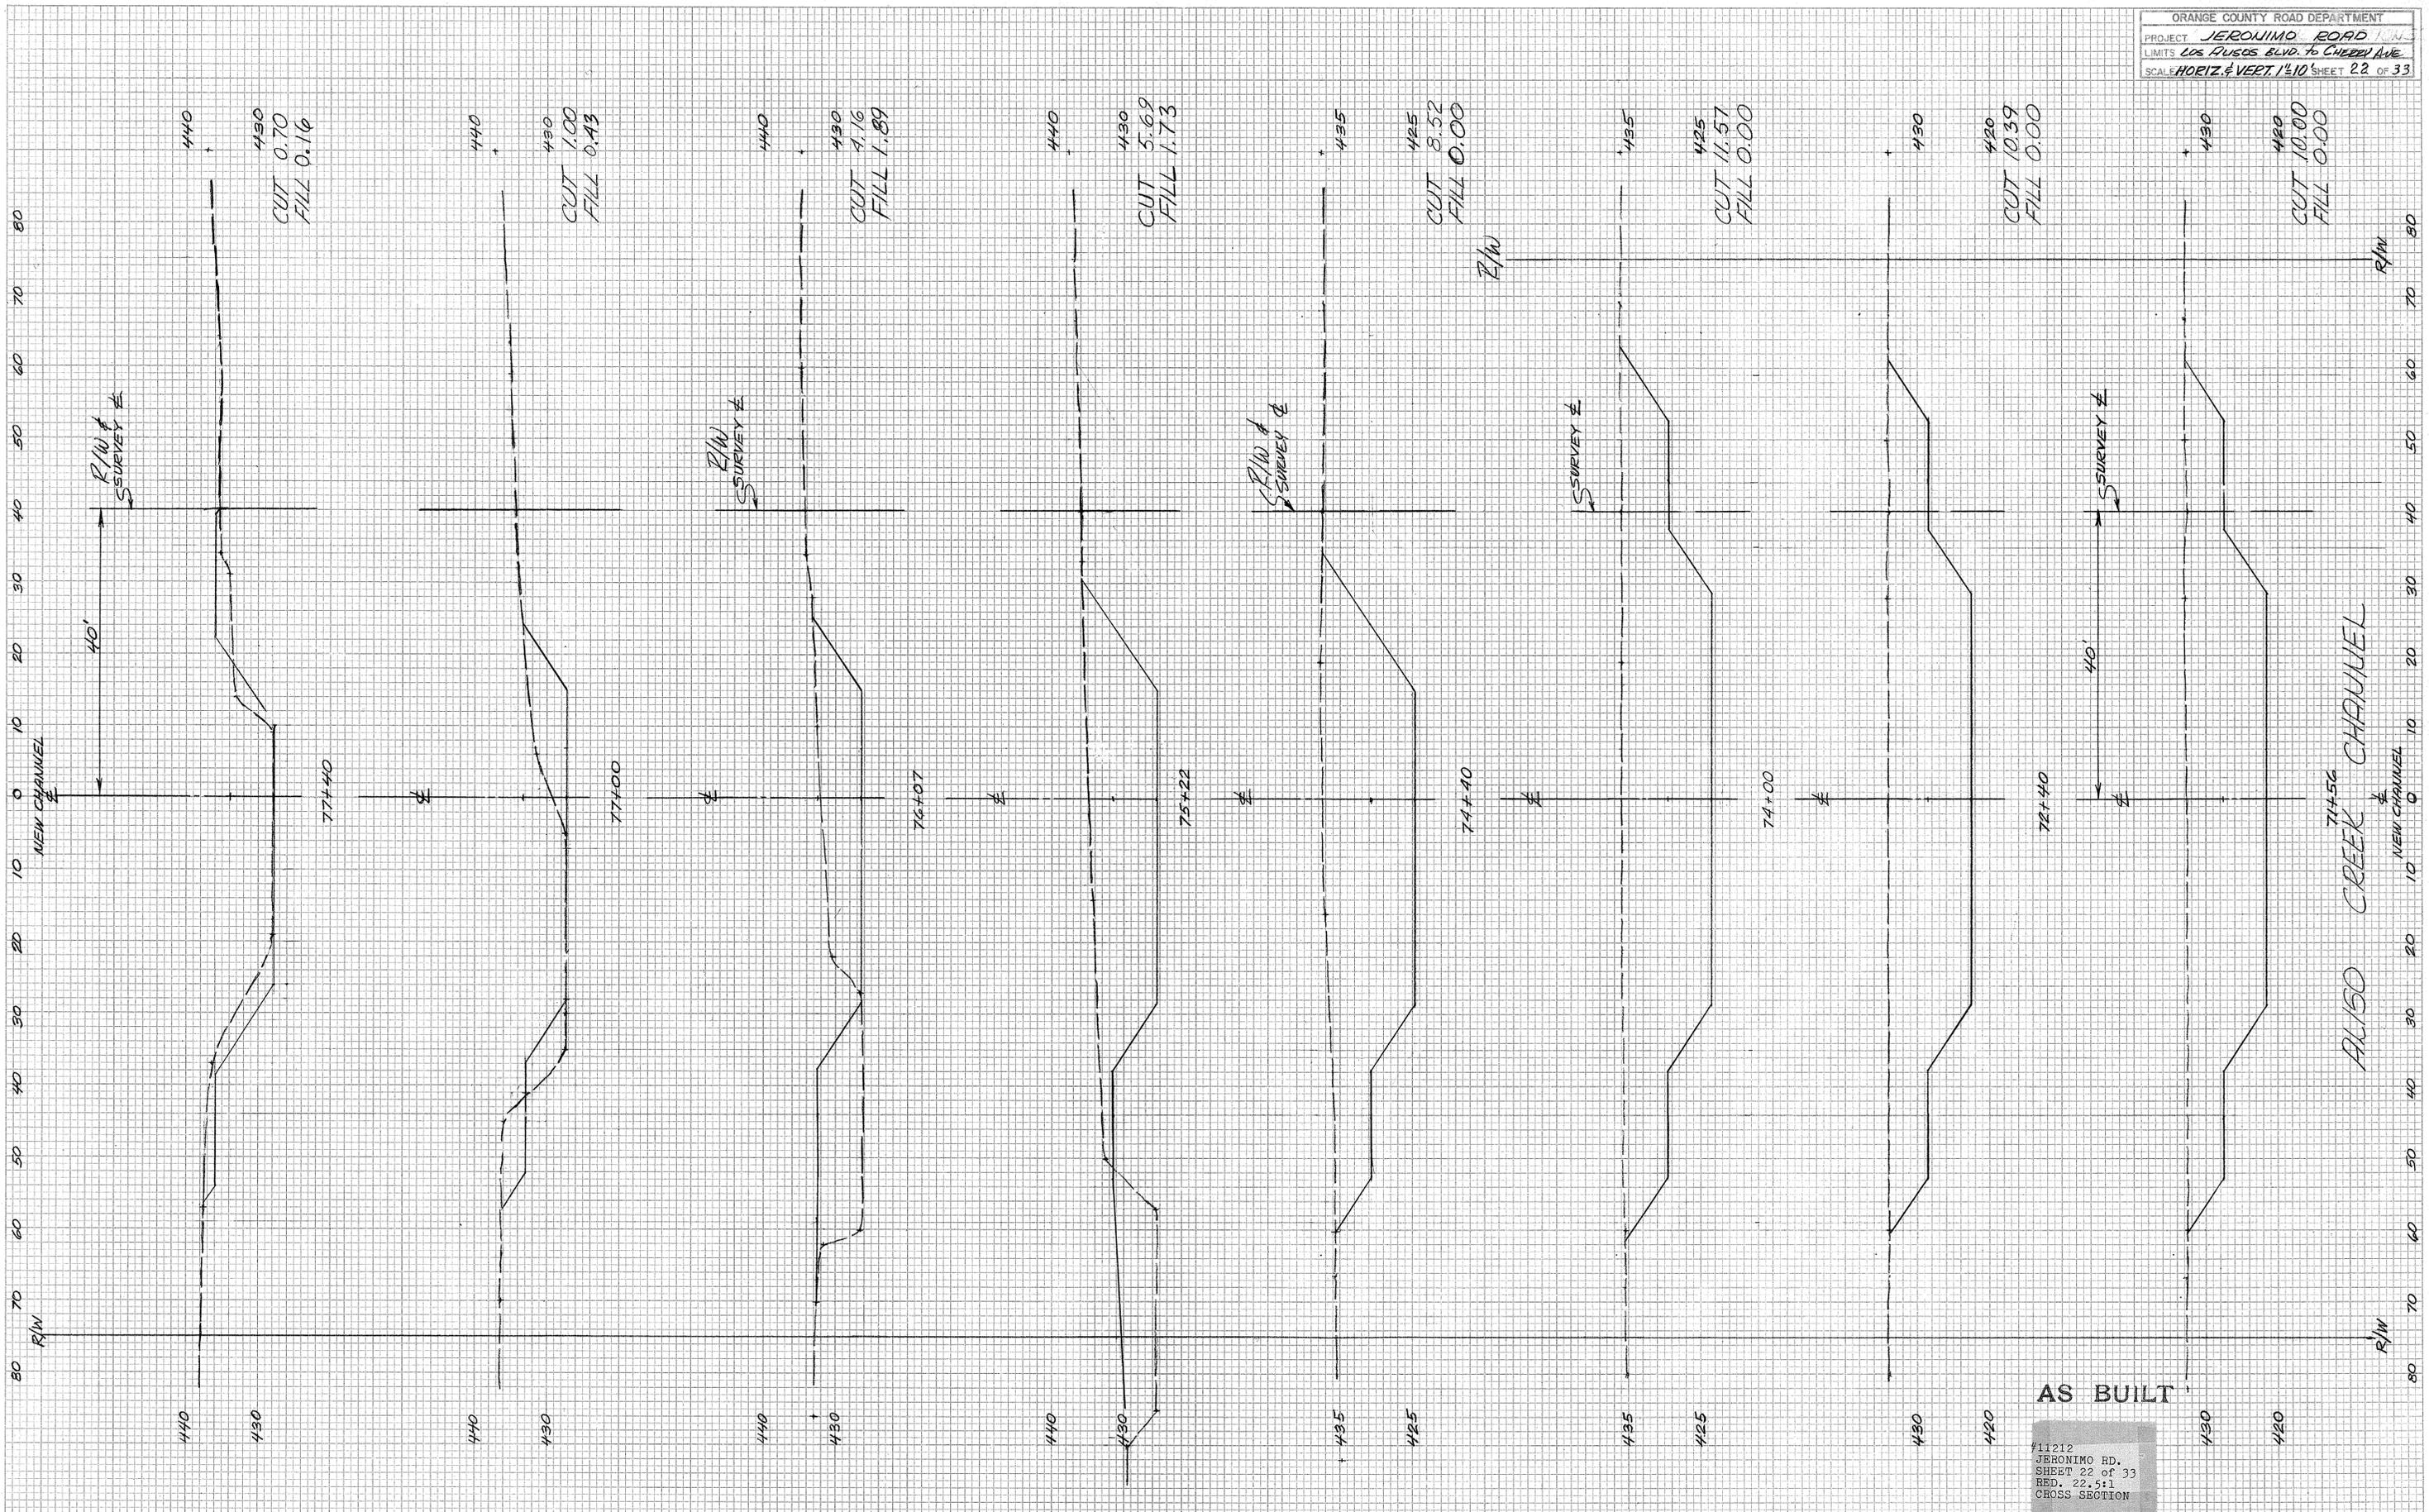

AS BUILT

711212  
 JERONIMO RD.  
 SHEET 22 of 33  
 HED. 22.5:1  
 CROSS SECTION