

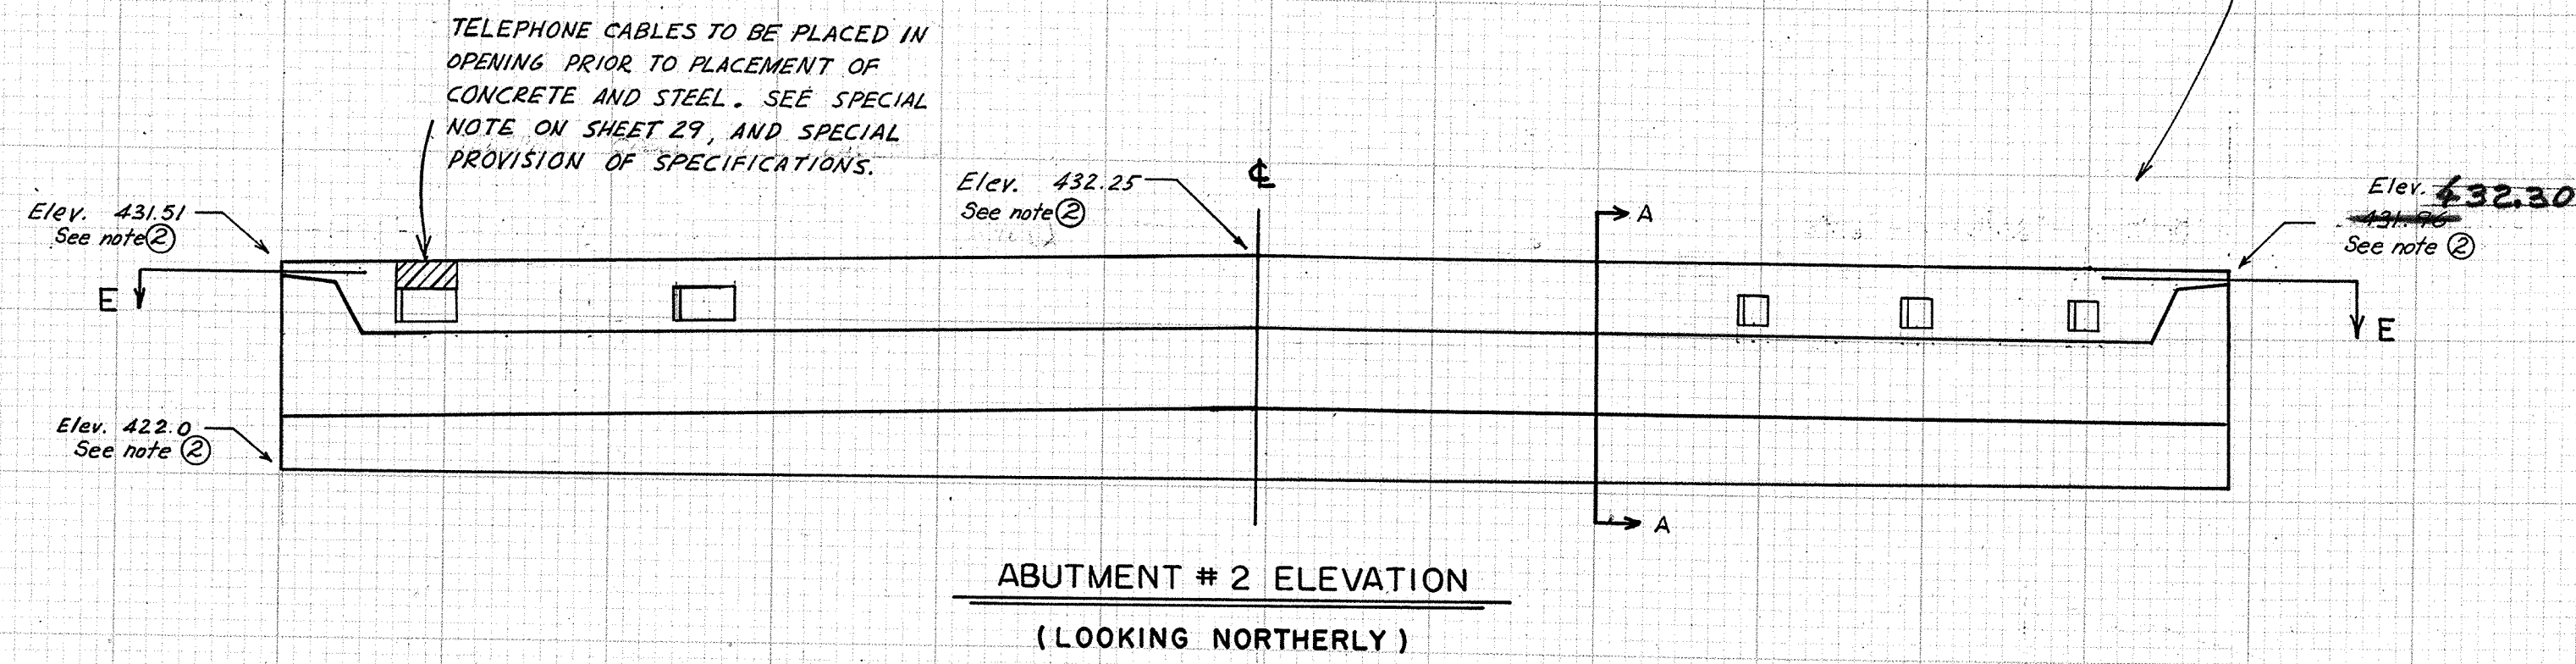
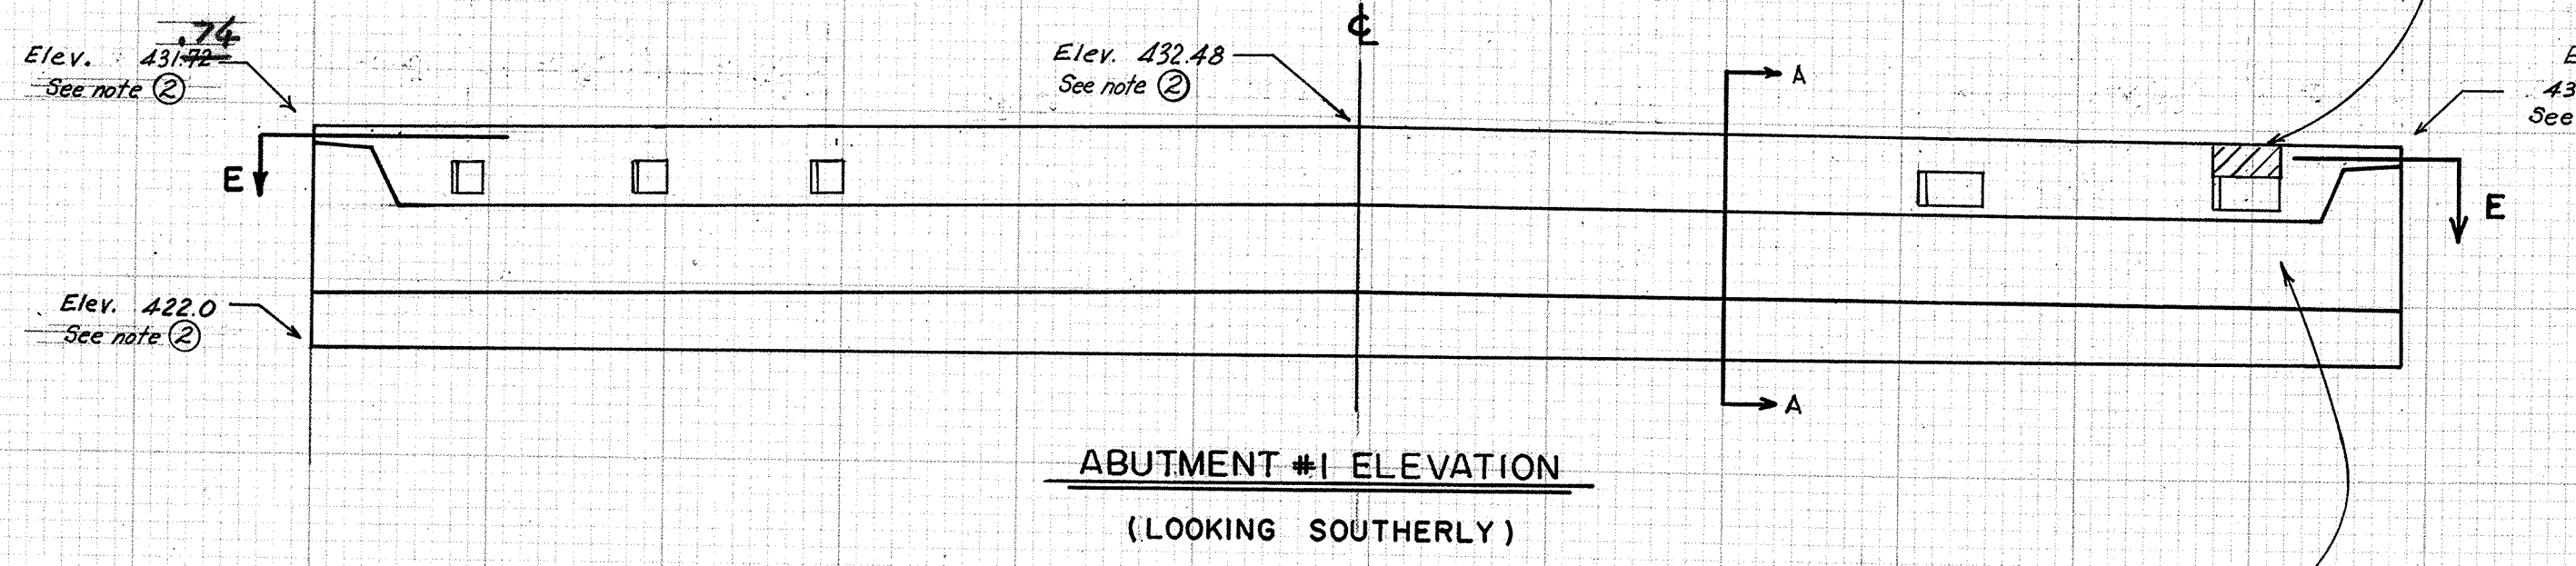
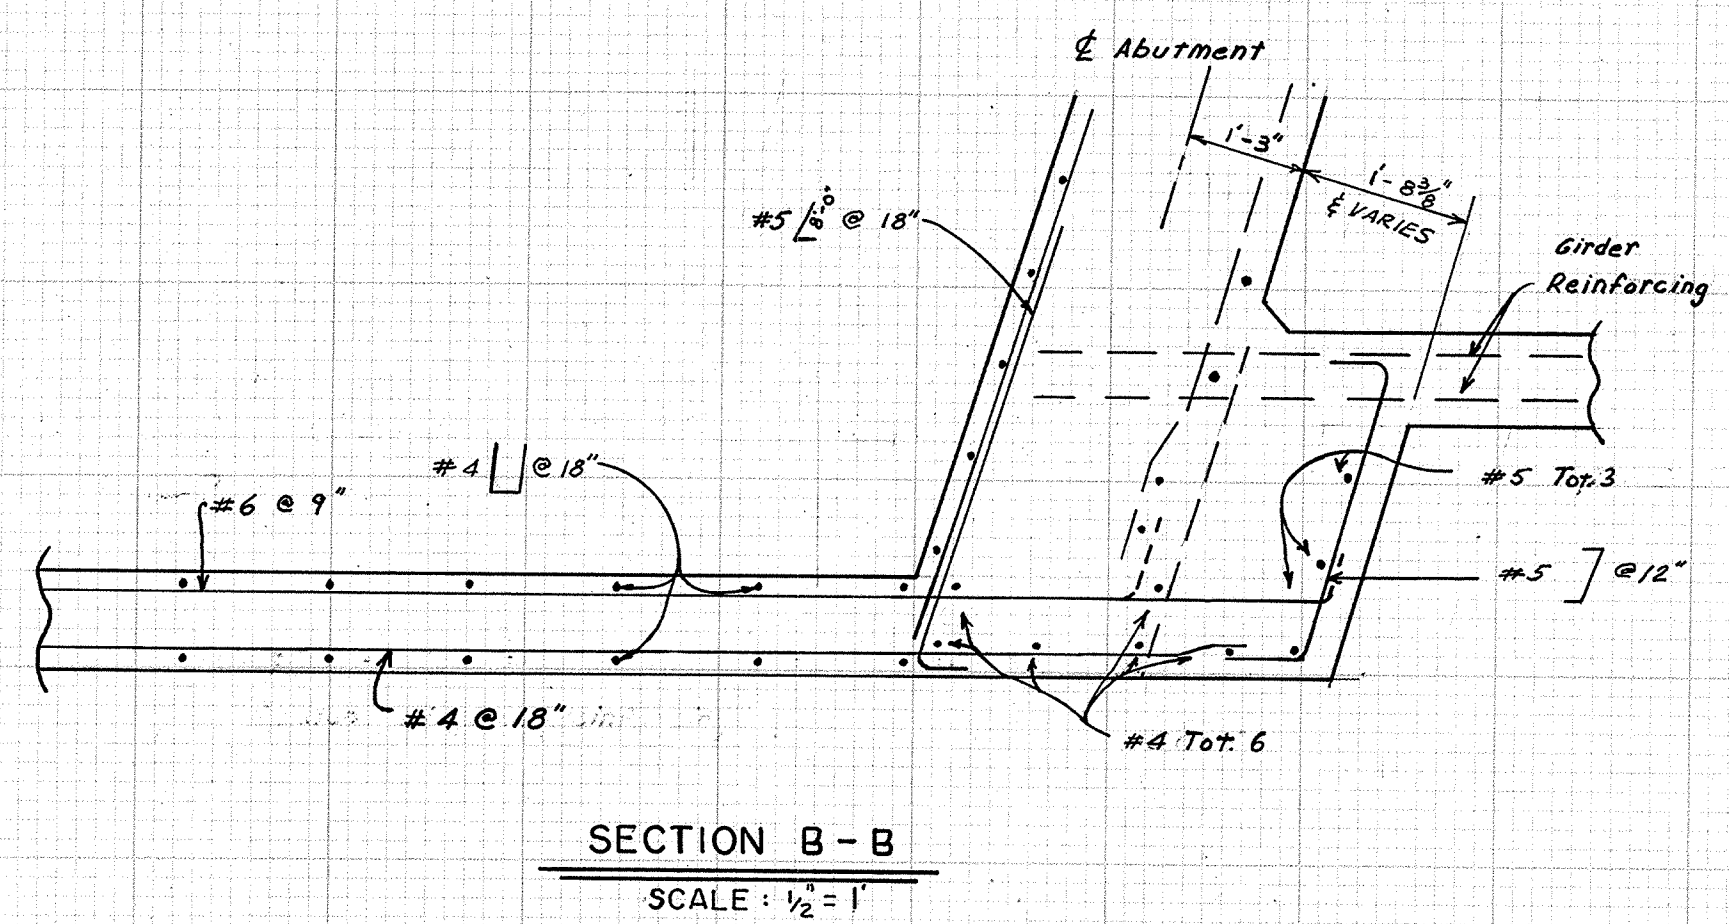
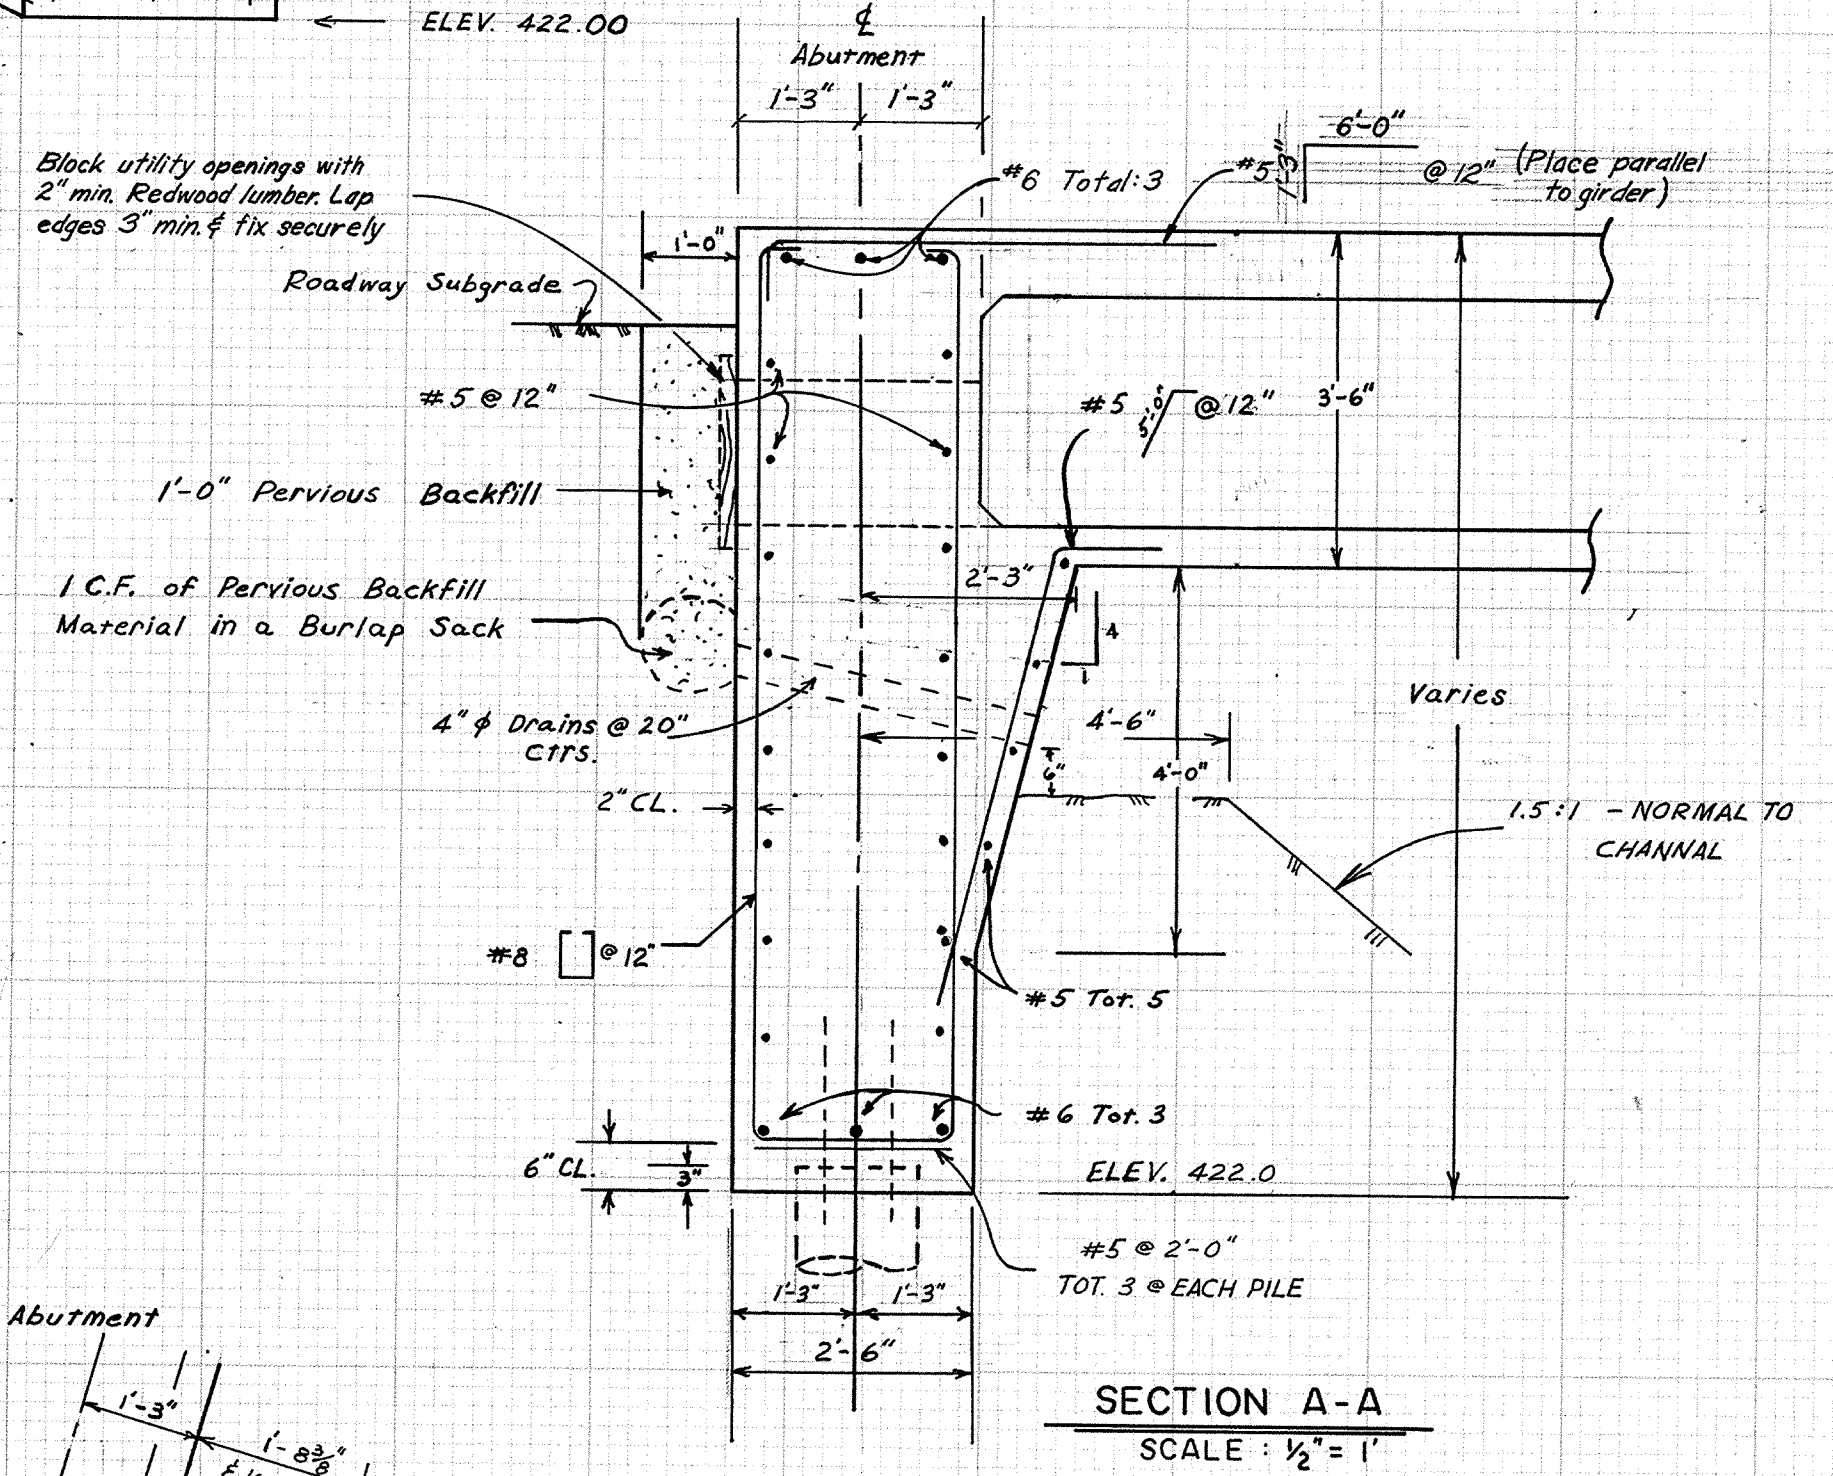
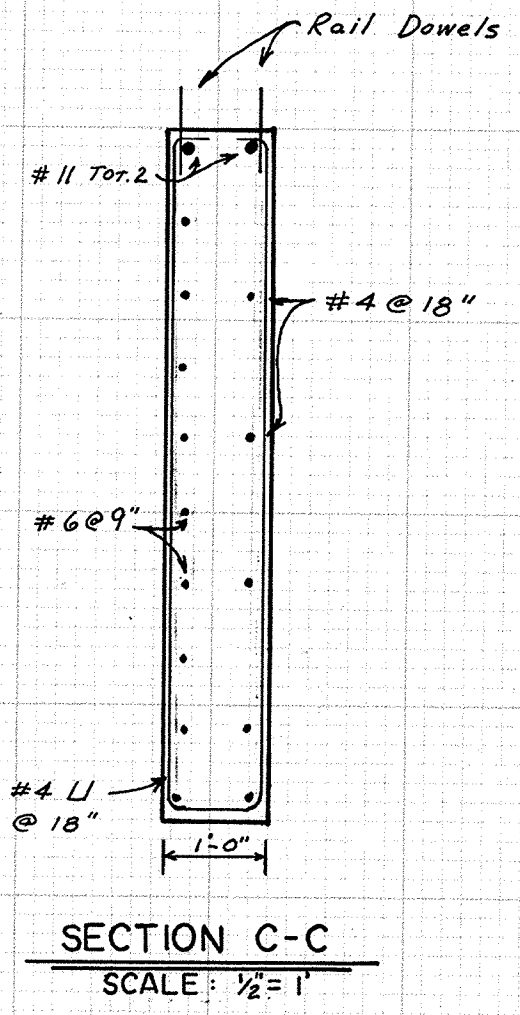


- NOTES**
- ① FOR EXACT SIZE AND LOCATION OF UTILITY OPENINGS, SEE SHEET 28.
 - ② ELEVATIONS SHOWN ARE AT $\frac{1}{2}$ OF ABUTMENT.
 - ③ WINGWALLS NOT TO BE PLACED UNTIL AFTER STRESSING IS COMPLETED.

TELEPHONE CABLES TO BE PLACED IN OPENING PRIOR TO PLACEMENT OF CONCRETE AND STEEL. SEE SPECIAL NOTE ON SHEET 29, AND SPECIAL PROVISIONS OF SPECIFICATIONS.

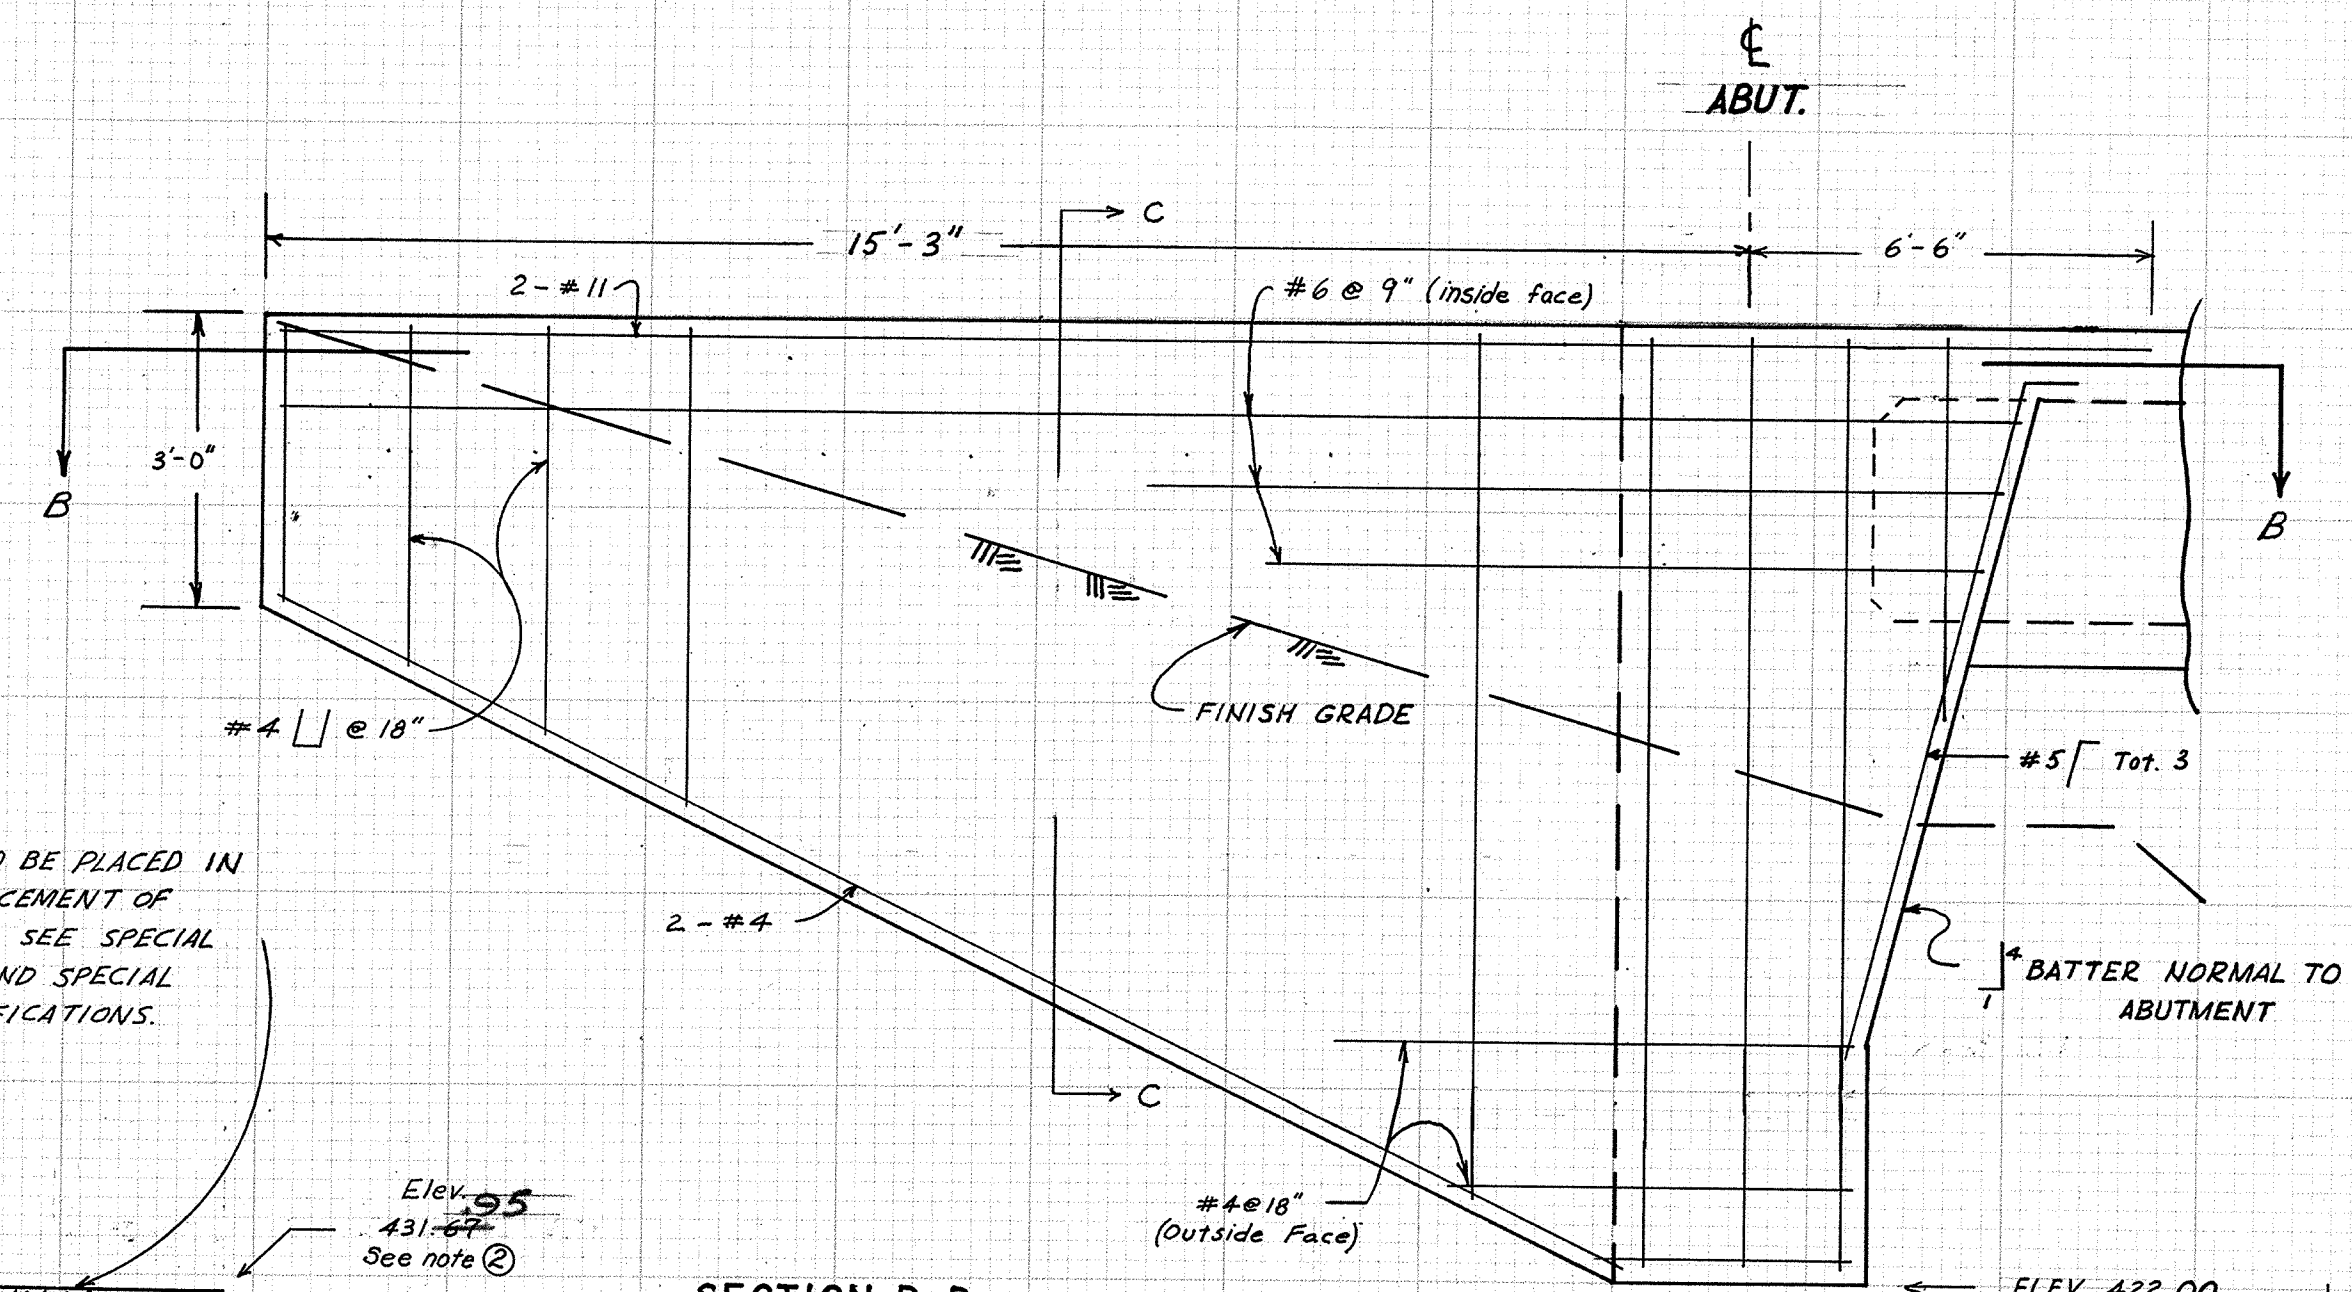

ABUTMENT ELEVATION
SCALE: $\frac{1}{8}'' = 1'$

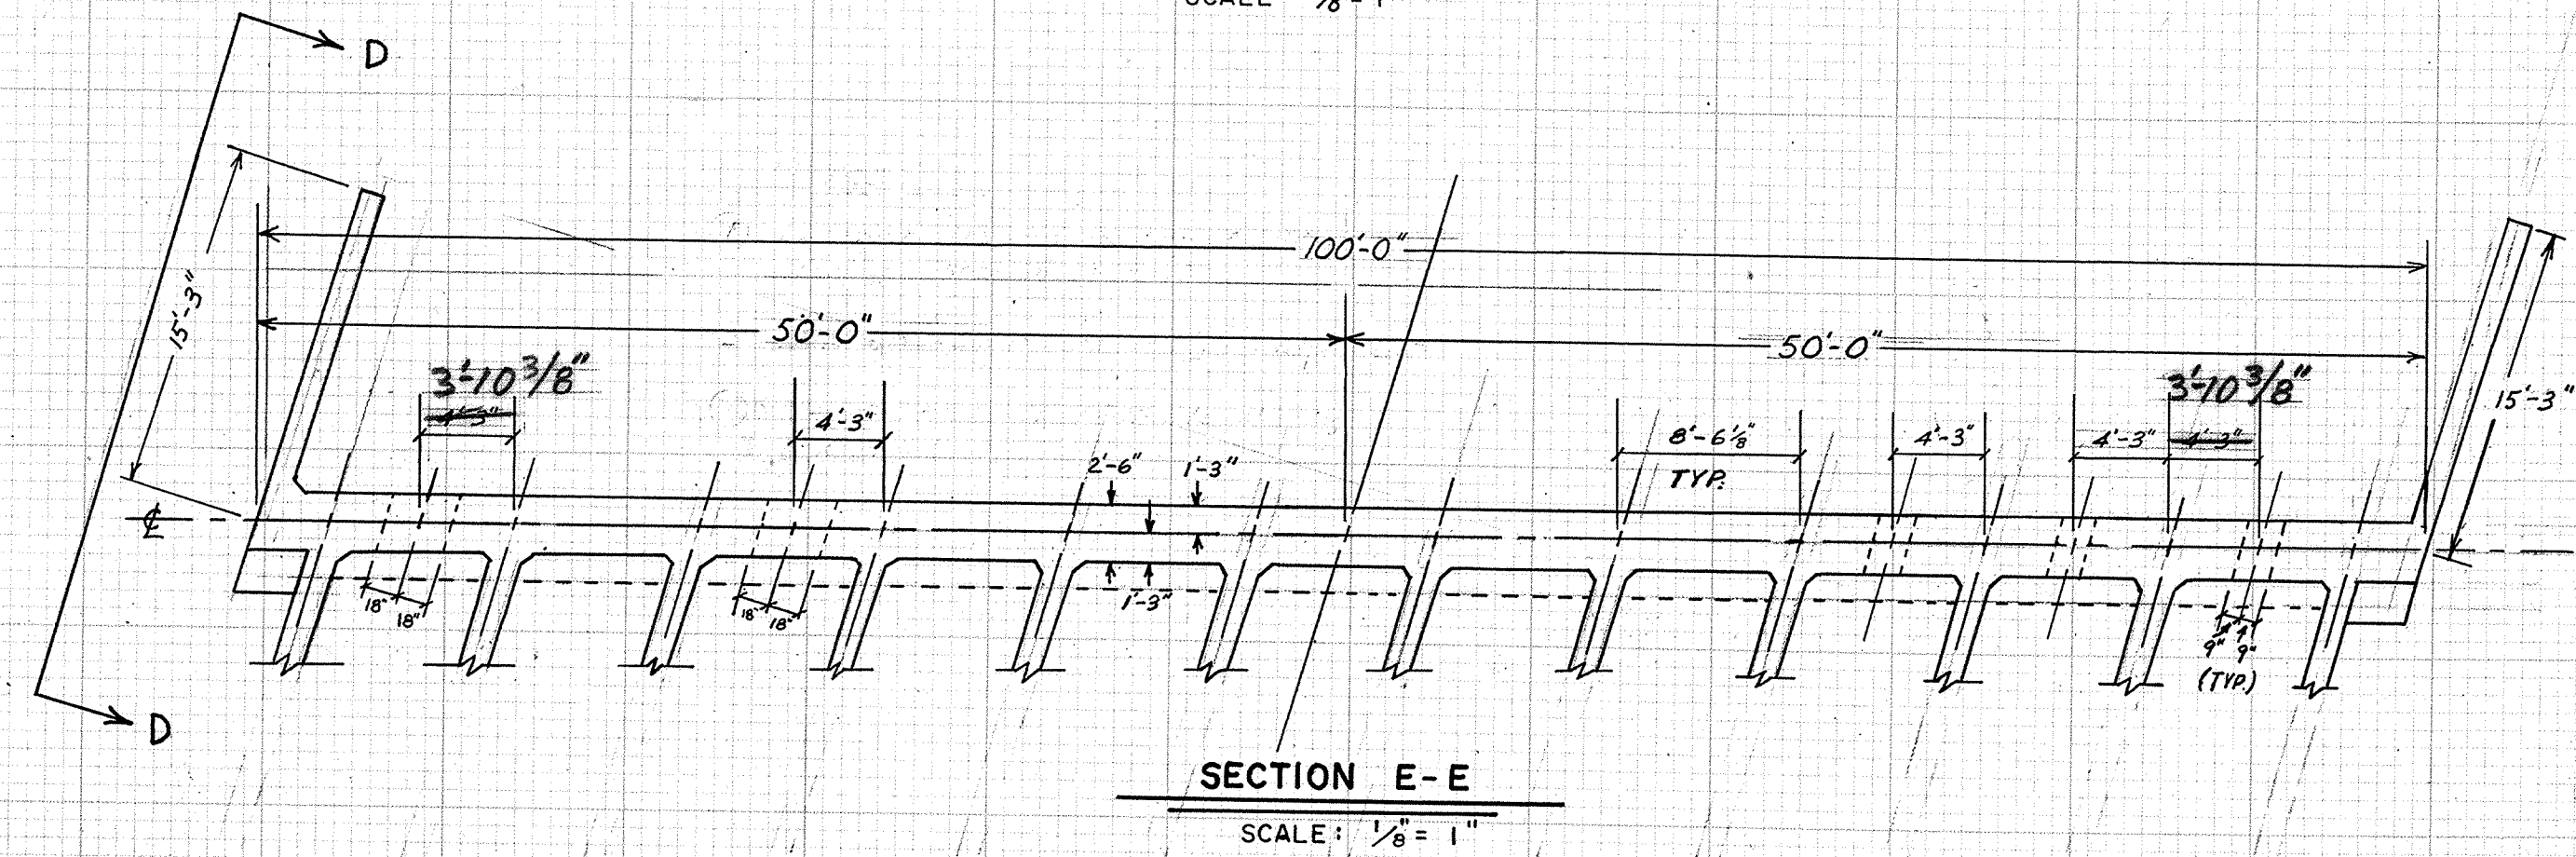

AS BUILT

#11212
JERONIMO RD.
SHEET 26 of 33
RED. 22.5.1
CROSS SECTION

ORANGE COUNTY ROAD DEPARTMENT

JERONIMO ROAD
BRIDGE AL-10
OVER
ALISO CREEK
ABUTMENT AND
WINGWALL DETAILS

Scale: AS NOTED

SHEET 26 of 33