


TYPICAL SECTION

SCALE: $\frac{1}{4}" = 1'-0"$


SIDEWALKS AND RAILING NOT SHOWN

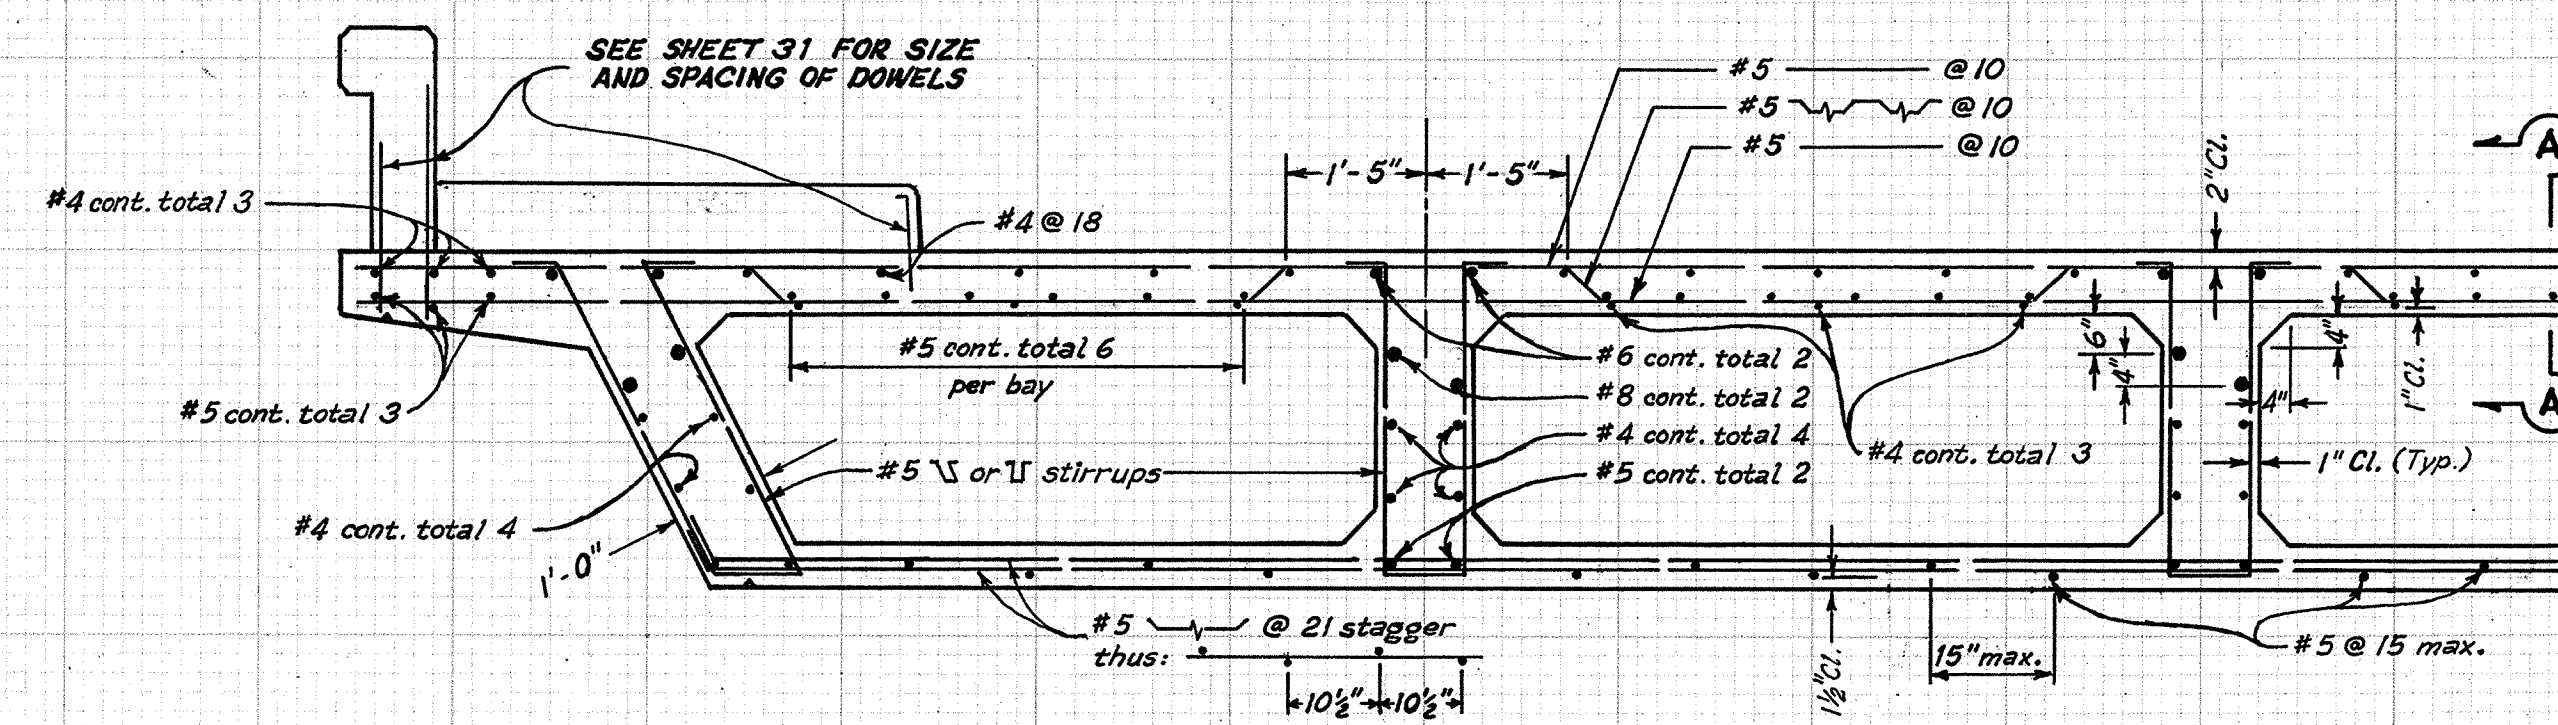

PART SECTION

SCALE: $\frac{1}{2}'' = 1'-0''$

PRESTRESSING DUCTS NOT SHOWN

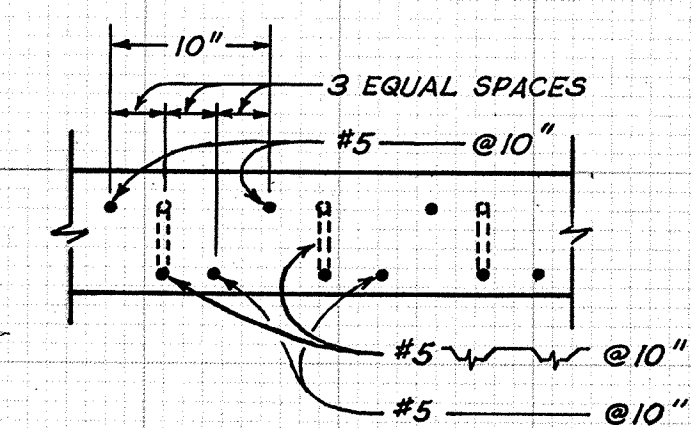

SECTION A-A

SCALE: 1" = 1'-0"

AS BUILT

#11212
JERONIMO RD.
SHEET 28 of 33
RED. 22.5:1
CROSS SECTION