

LOS ALISOS BLVD

R/W

UNTREATED

SHOULDER

PLAN VIEW
SCALE: 1" = 20'

JERONIMO ROAD


CHERRY AVE.

R/W

UNTREATED


SHOULDER

TYPICAL BORING

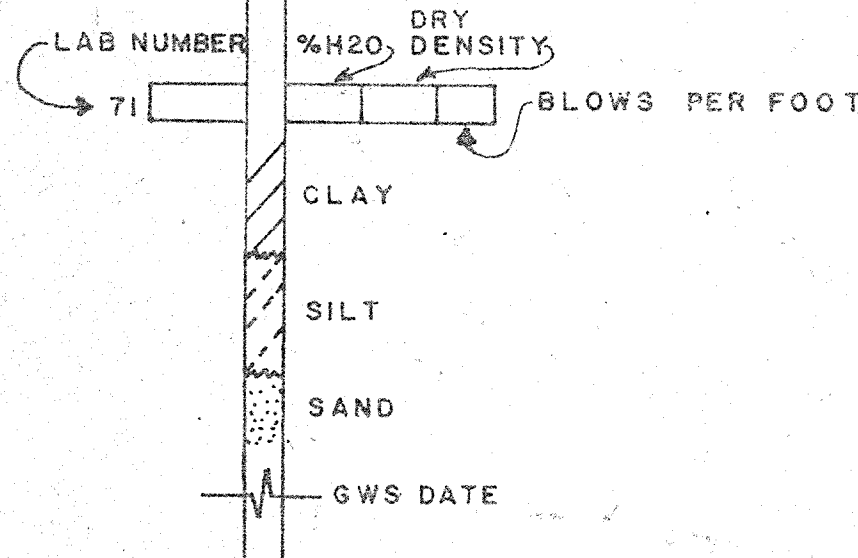

435					435
430					430
425					425
420					420
415					415
410					410
405					405
400					400
395					395
390					390
385					385
380					380
375					375

ELEVATION THROUGH
SCALE: HORIZ. 1" = 20'
VERT. 1" = 10'

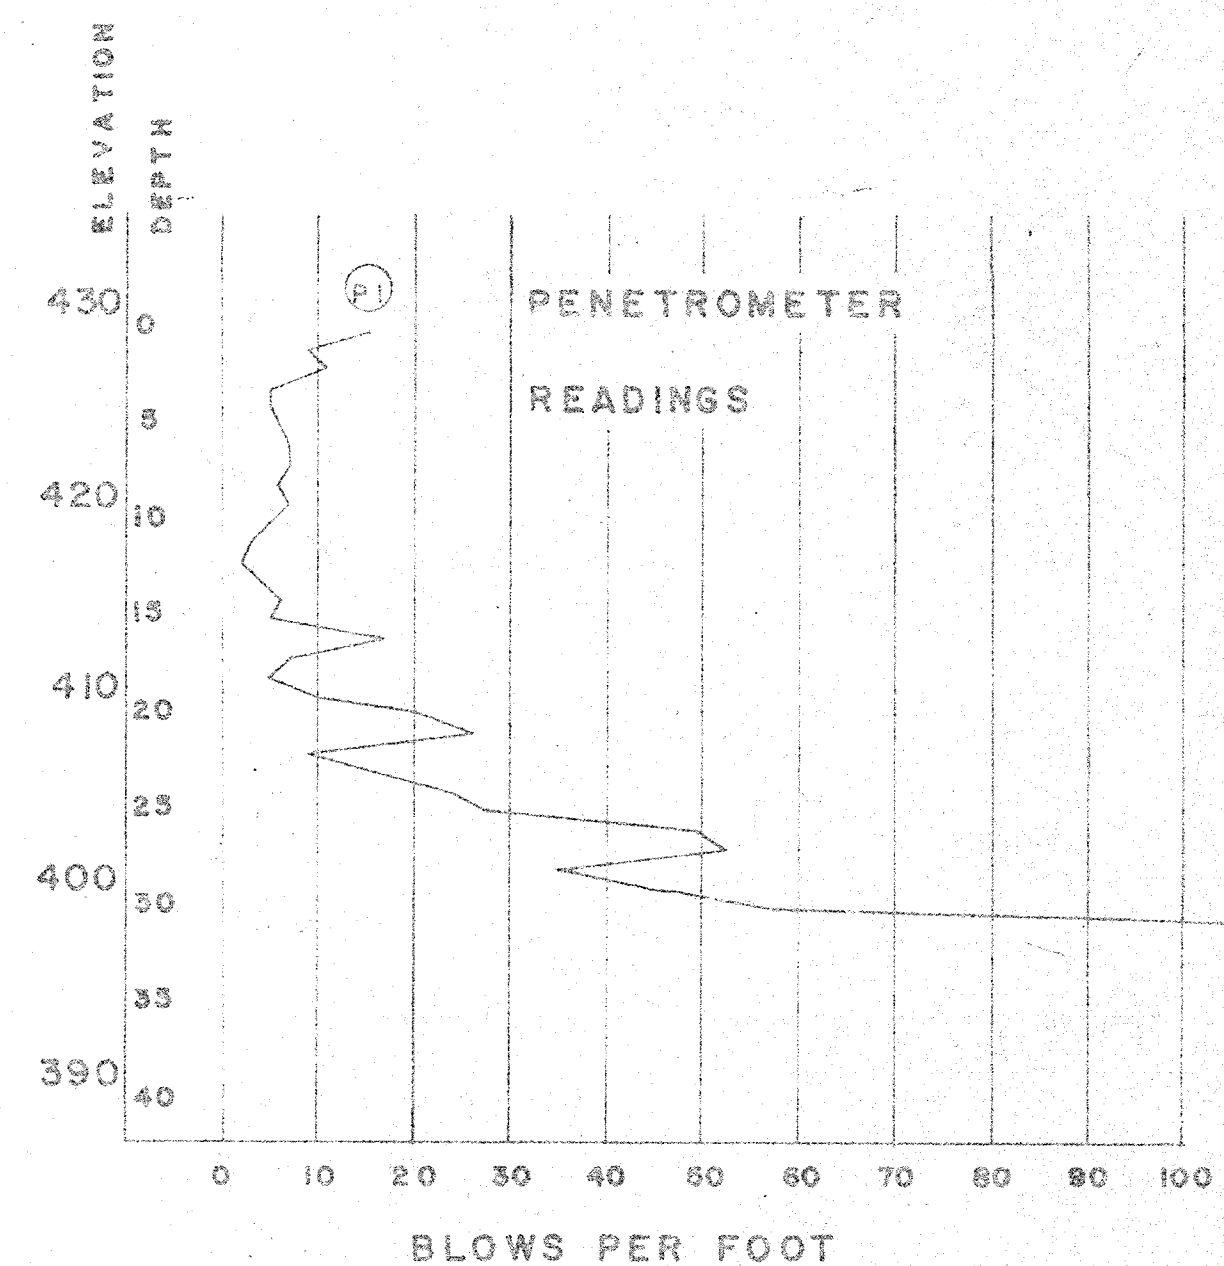

AS BUILT

#11212
JERONIMO RD.
SHEET 33 of 33
RED. 22.5:1
VELLUM

ORANGE COUNTY ROAD DEPARTMENT

JERONIMO ROAD
BRIDGE AL-10
OVER
ALISO CREEK

BORING LOG

SCALE: NO SCALE

SHEET 33 of 33

11515 - Core logs