




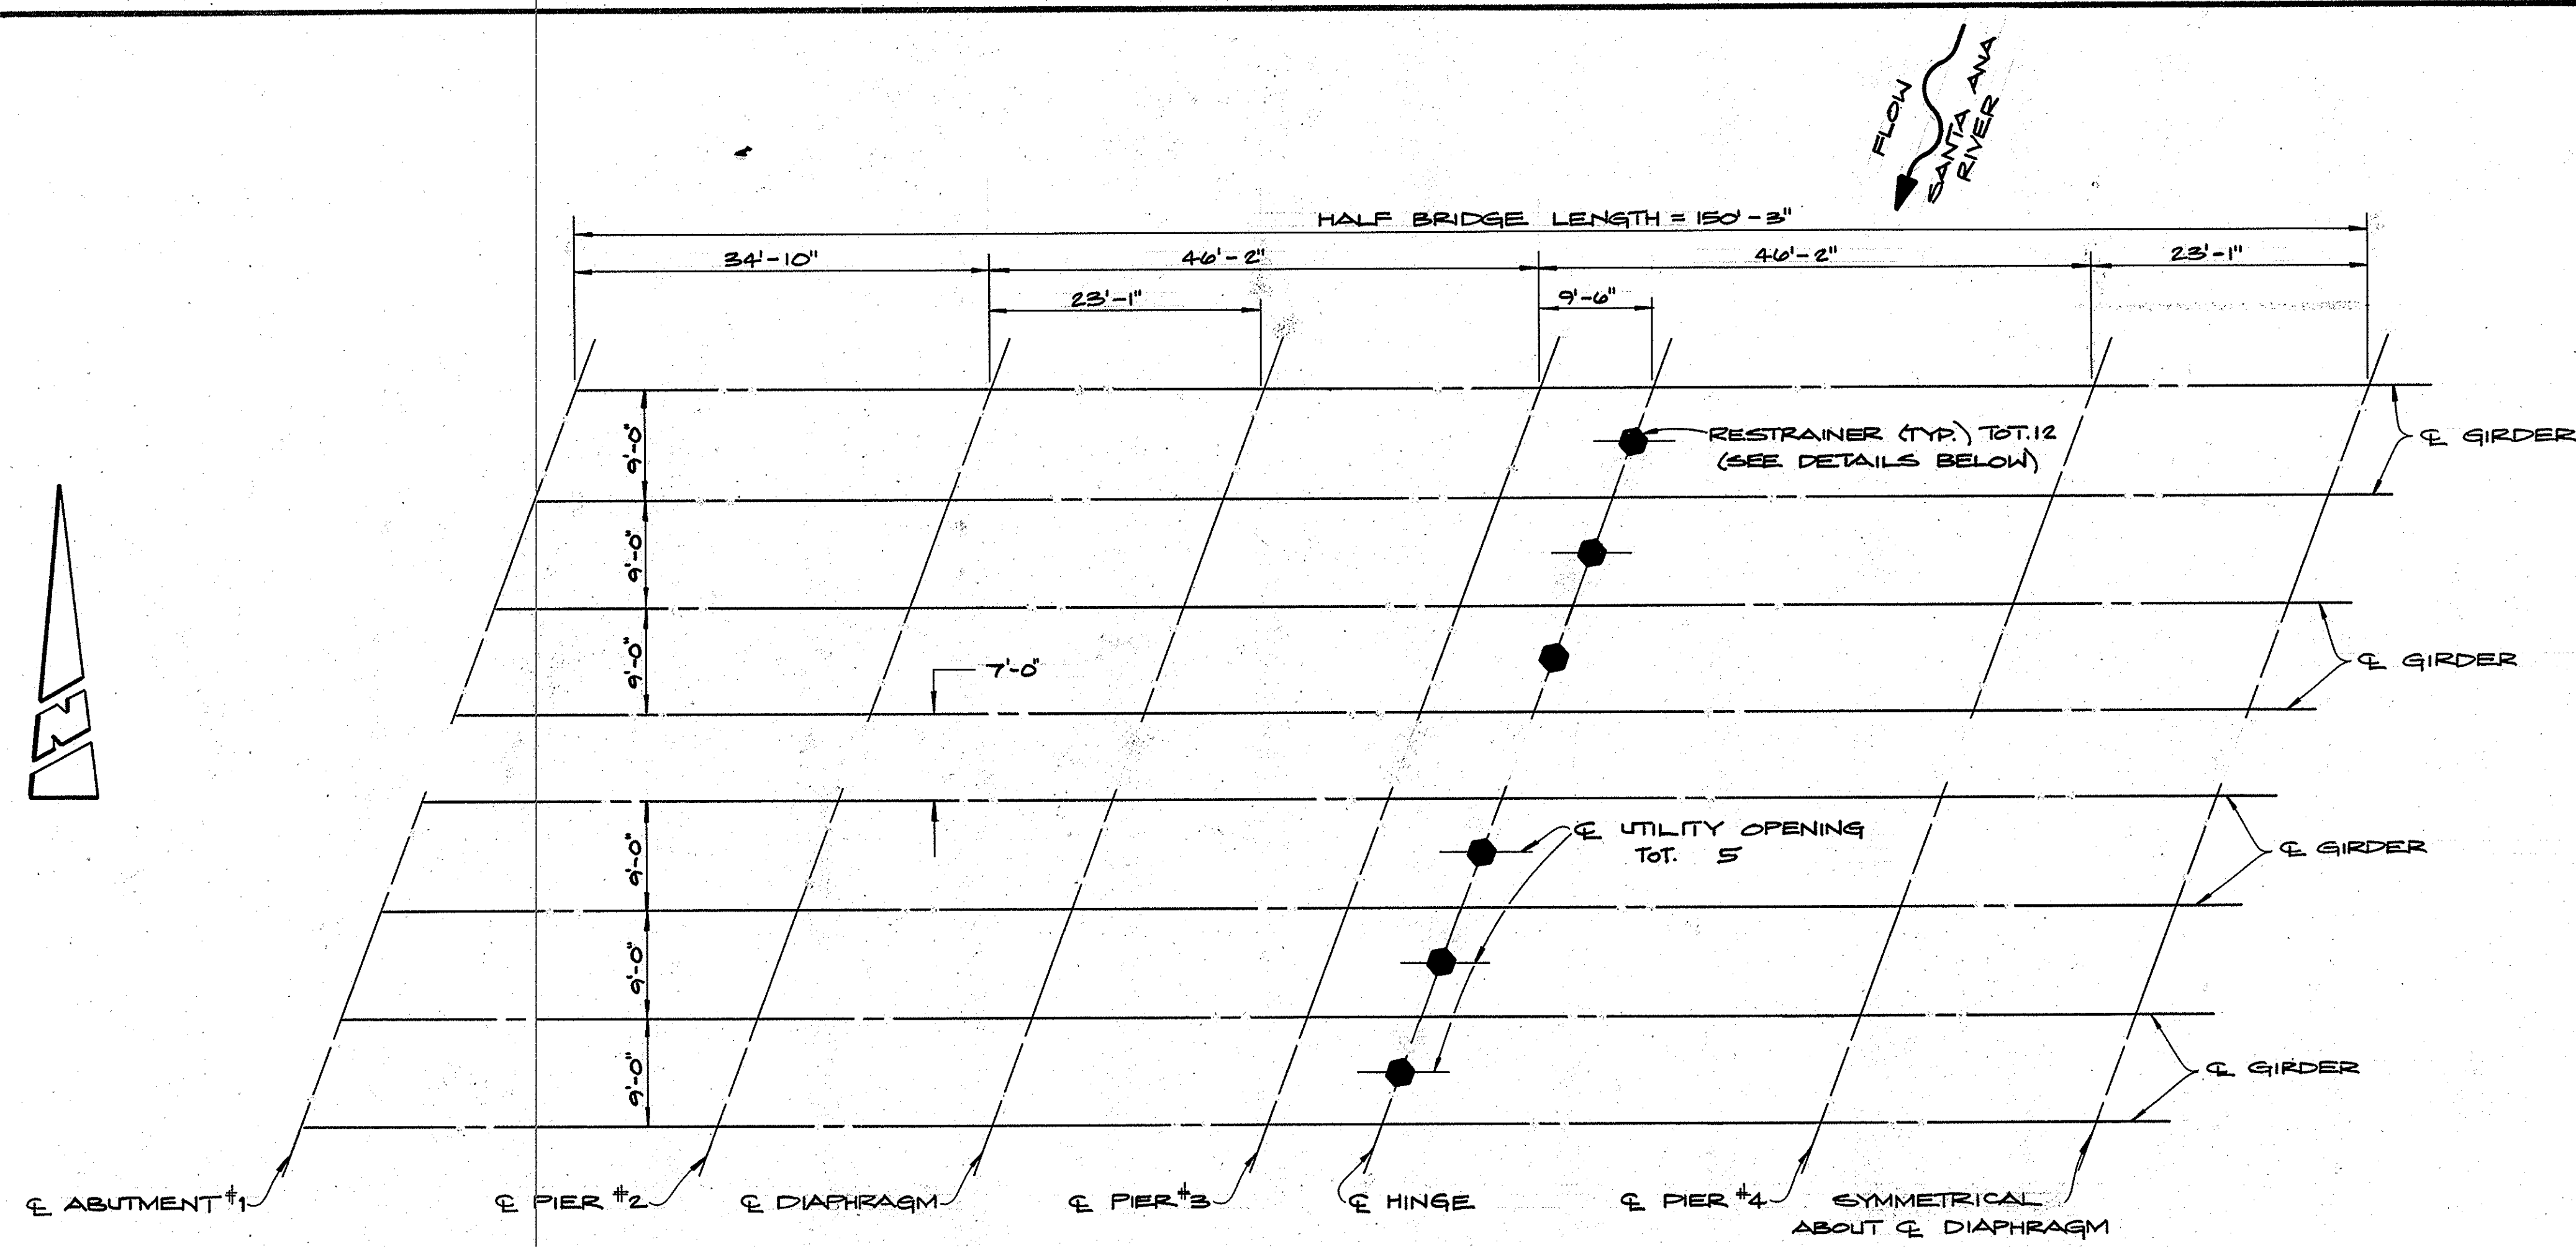


RESTRAINER LAYOUT
SCALE: 1"=10'

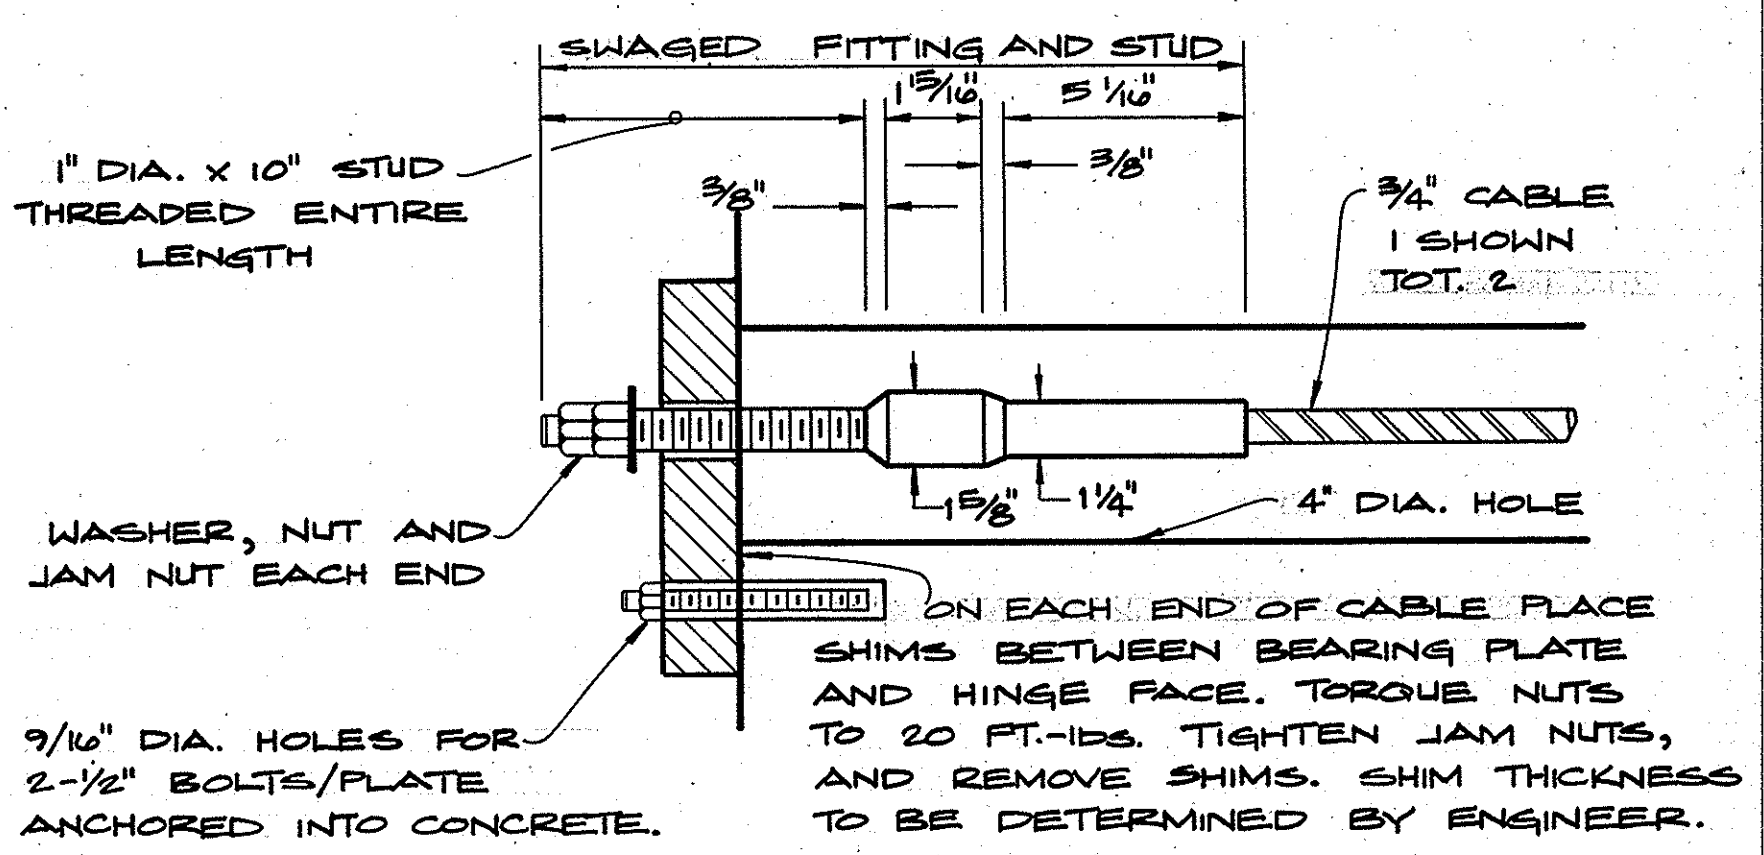

CABLE END ANCHORAGE
NO SCALE

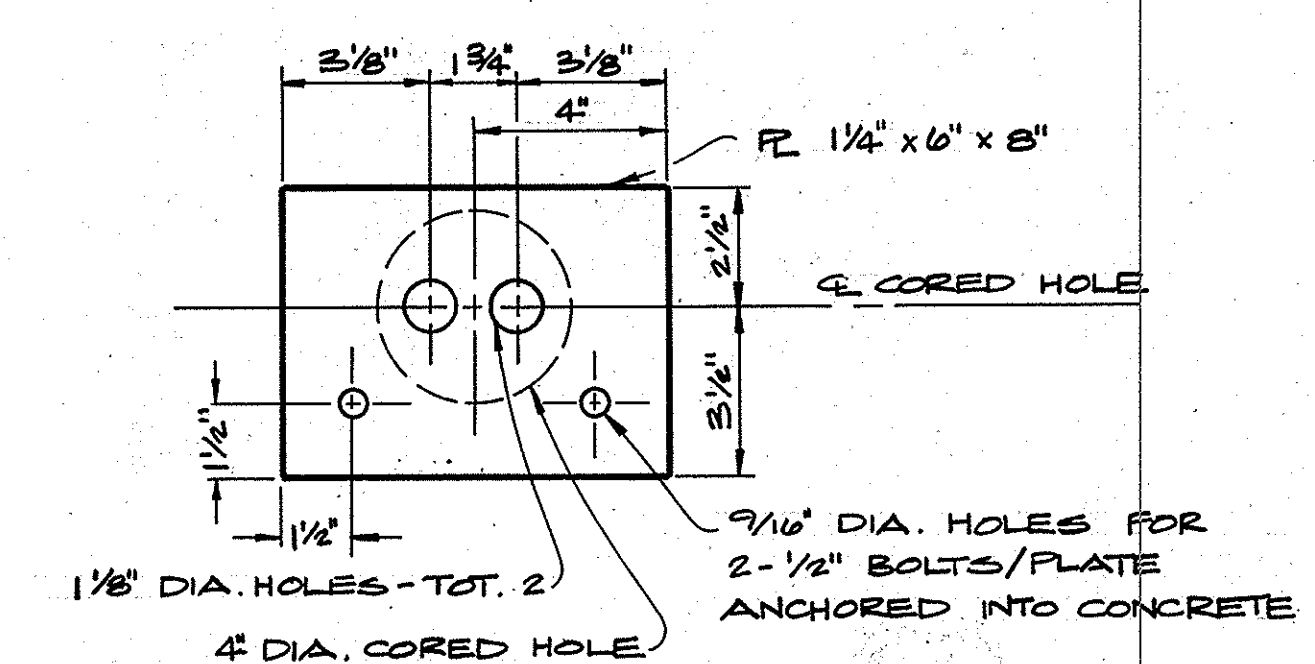


BEARING PLATE DETAIL
NO SCALE

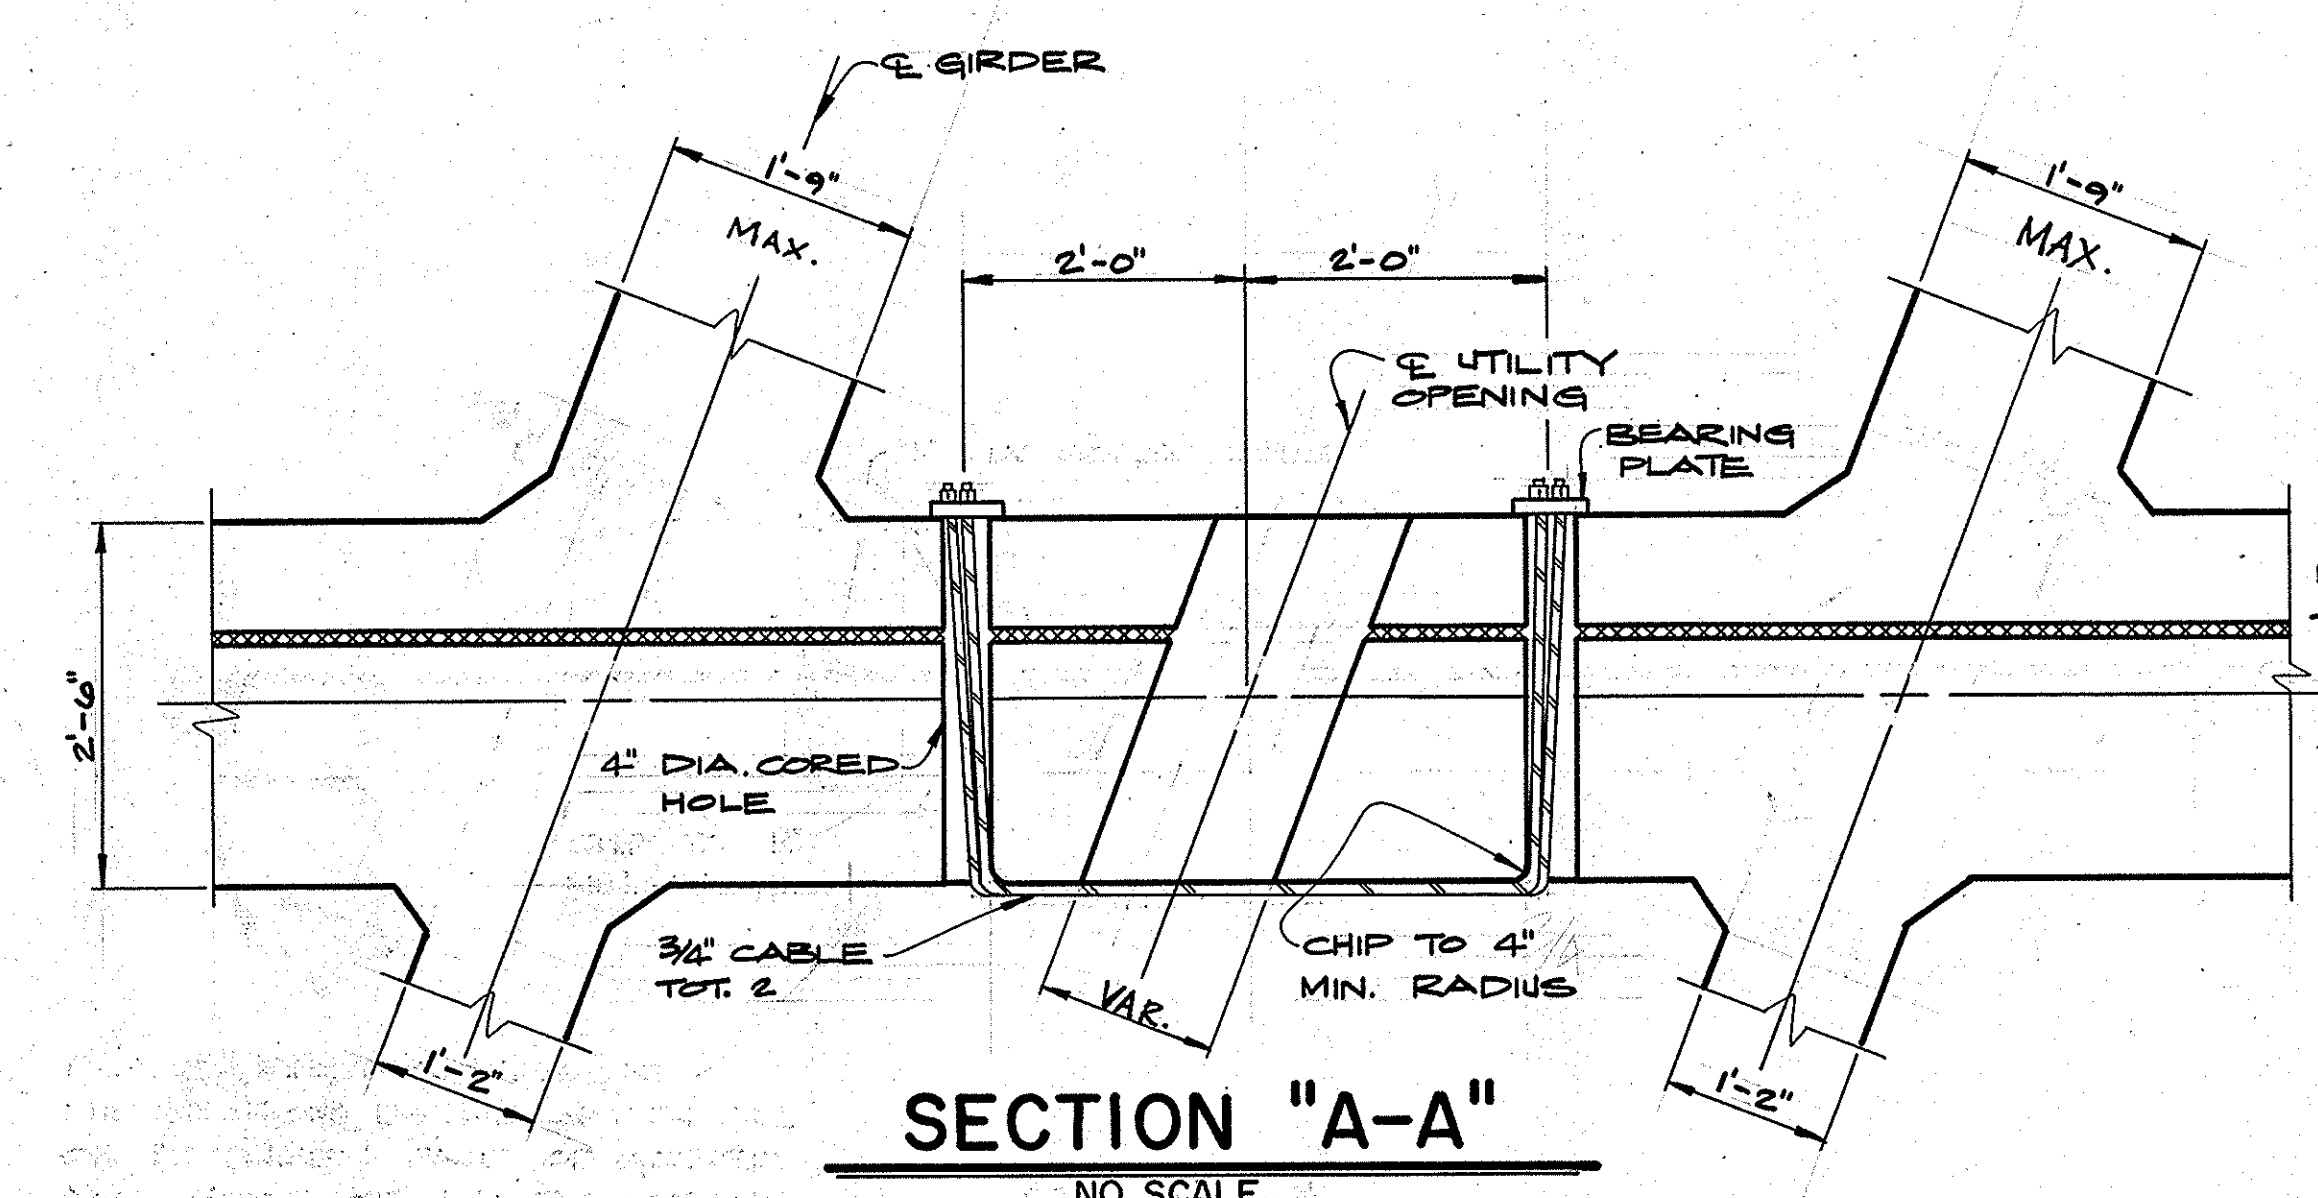

SECTION "A-A"
NO SCALE
(ROTATED 90° CLOCKWISE)

NOTE:
THE CONTRACTOR SHALL VERIFY ALL DEPENDENT DIMENSIONS IN THE FIELD BEFORE ORDERING OR FABRICATING ANY MATERIAL.

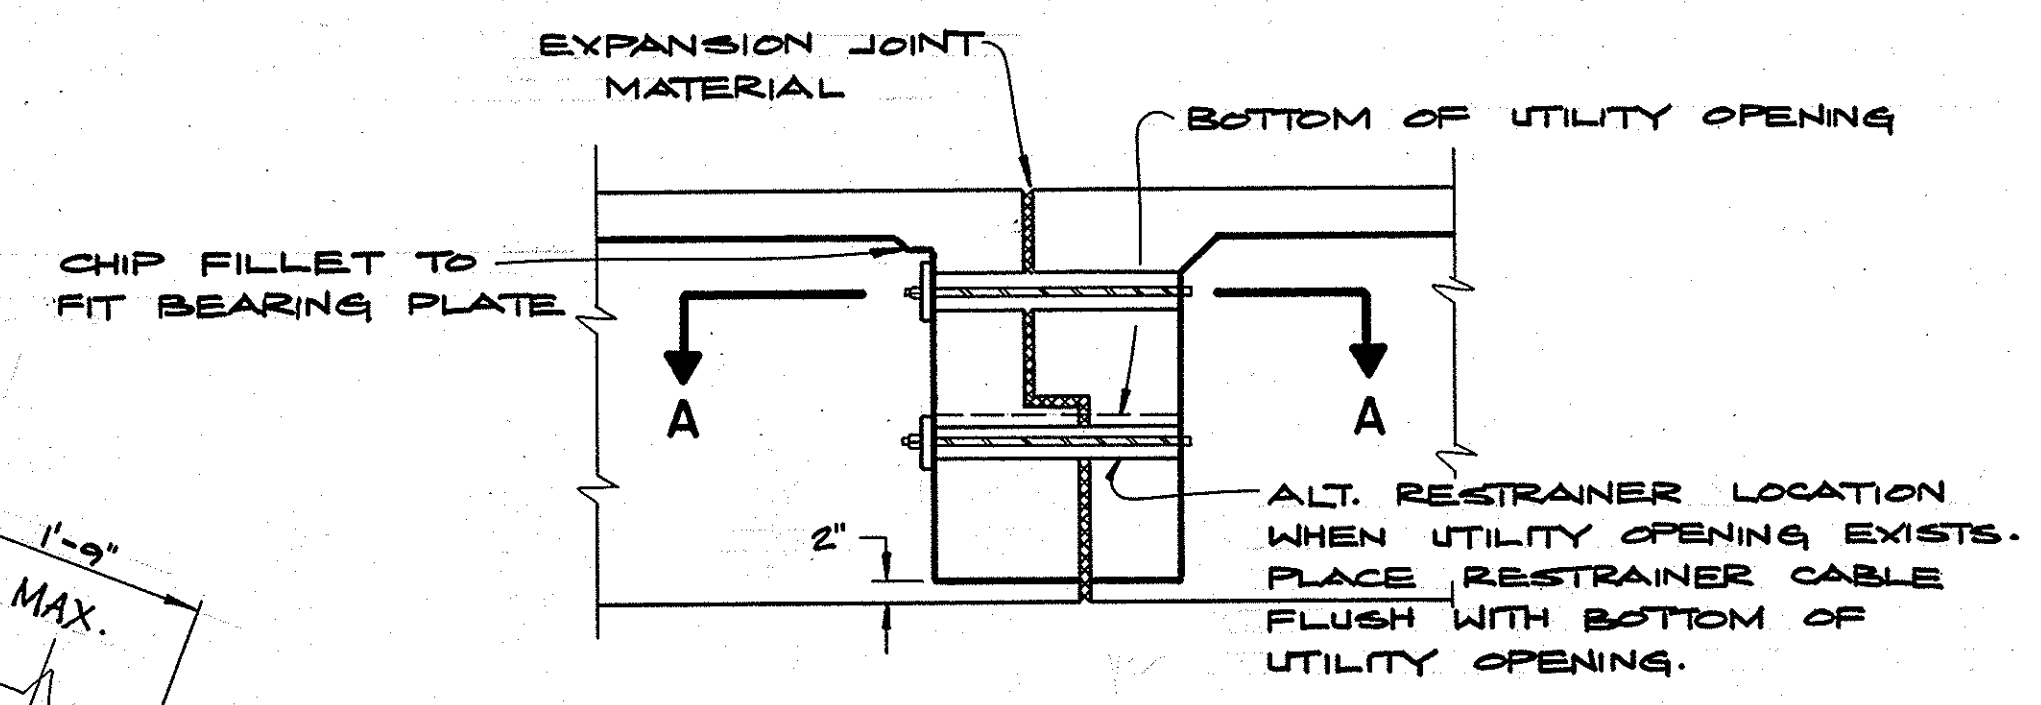

SECTION THRU RESTRAINER UNIT
NO SCALE

1/2 0 1 2
3 inches on original drawing

ORANGE COUNTY ENVIRONMENTAL MANAGEMENT AGENCY			
SEISMIC RETROFIT			
KATELLA AVE. BRIDGE			
at			
SANTA ANA RIVER			
(SA-14 and SA-14A)			
MARK	DATE	DESCRIPTION	PREPARED UNDER SUPERVISION OF <i>James P. Burk</i> DATE <i>10/83</i> SHEET
REVISIONS			
DESIGNED	<i>M.M.H.S.U.</i>	SCALE	DATE
DRAWN	<i>P.BURK</i>	CHECKED	DWG. NO. 10