



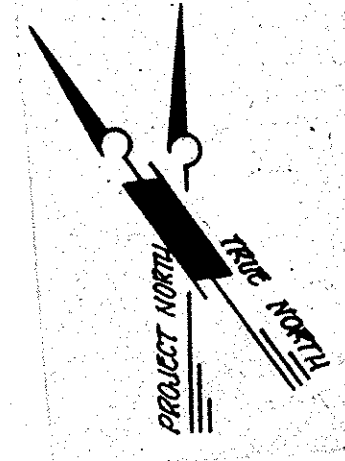


As-Built Settlement Pin Elevations*			
Location	West Abutment (Line 1)	Pier (Line 2)	East Abutment (Line 3)
North Side			
South Side			

* Table to be filled in by O.C.E.M.A.

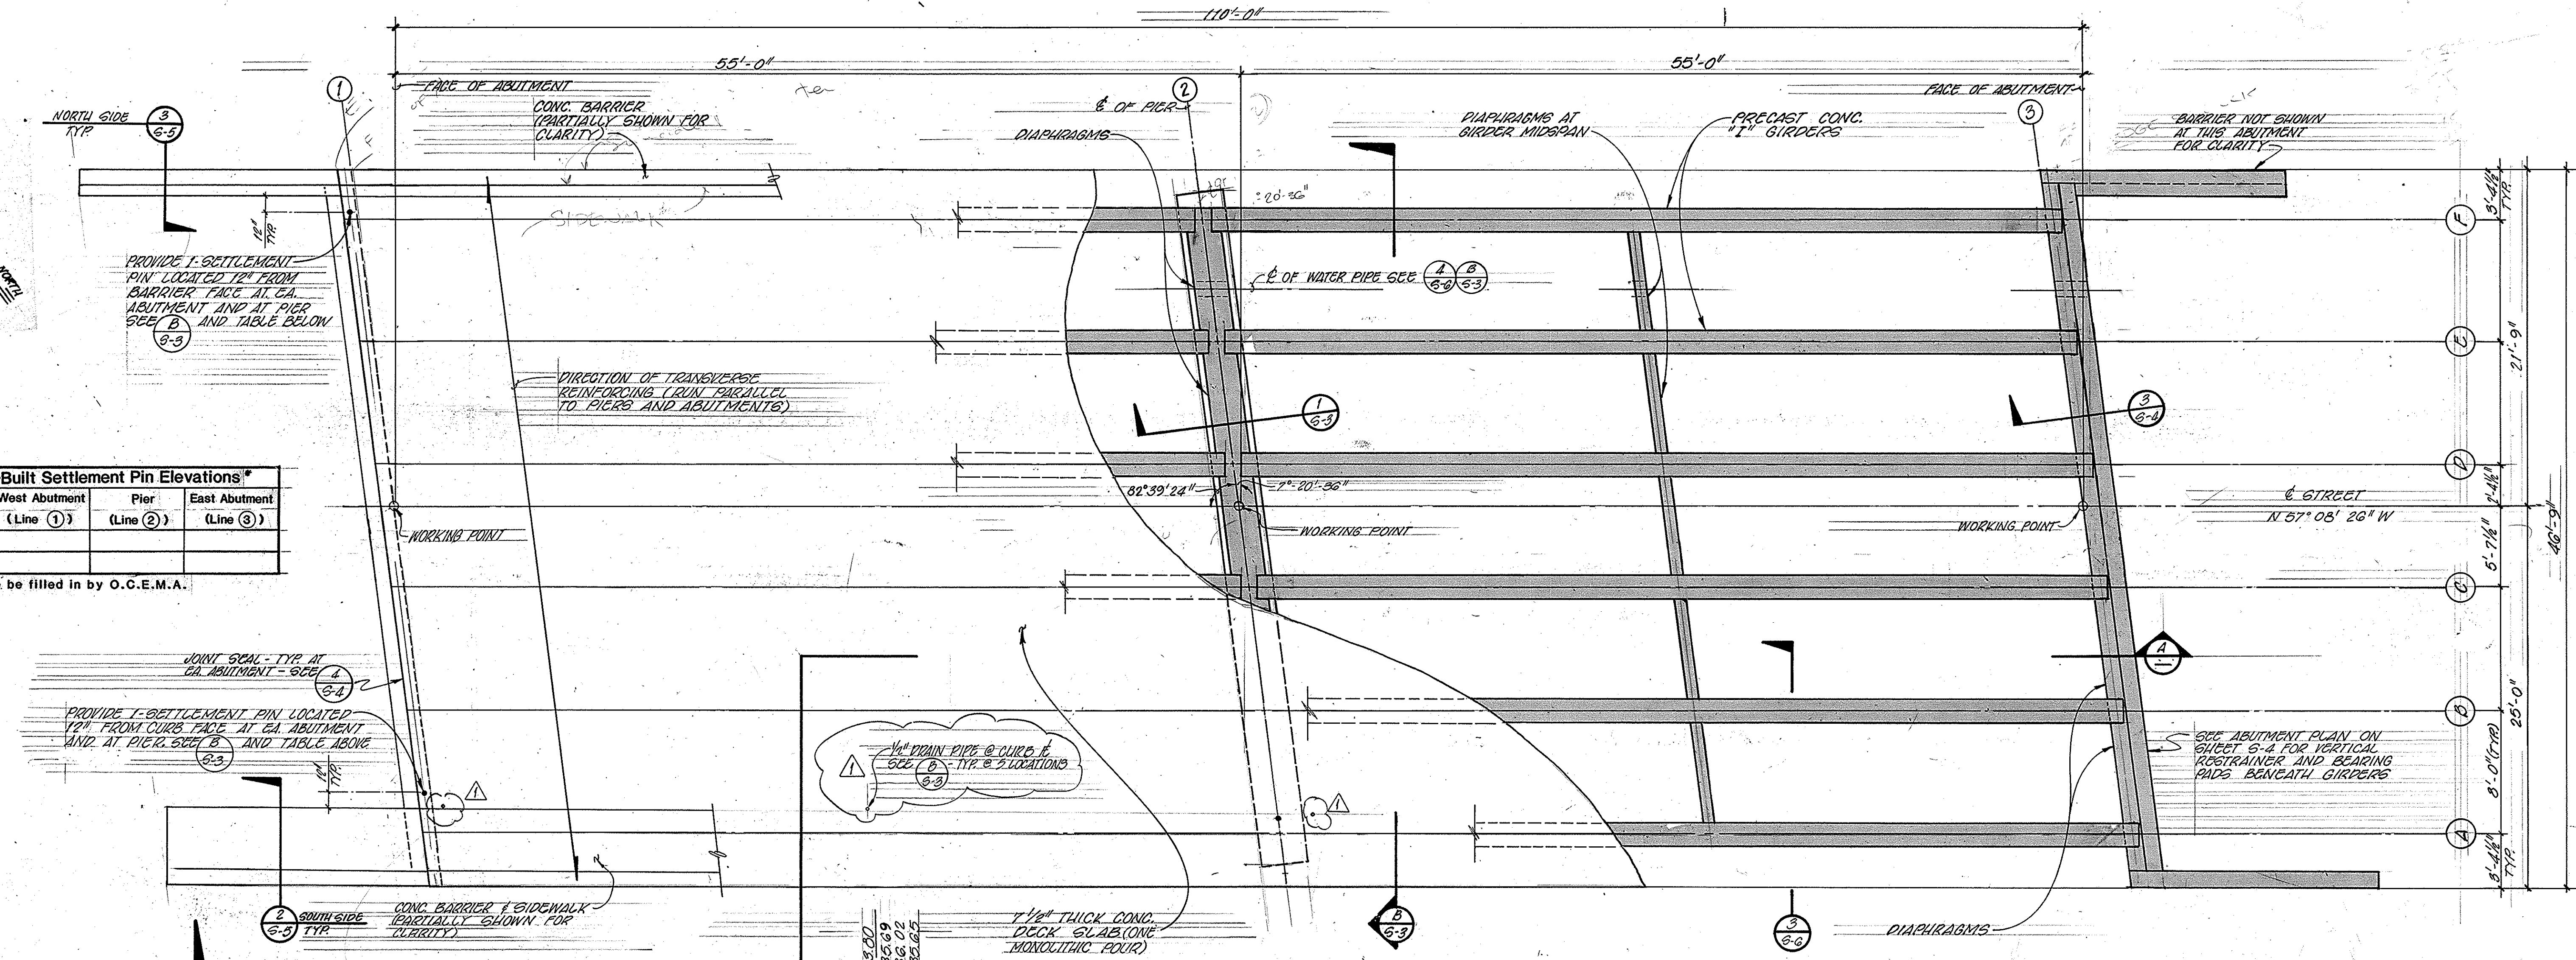


DECK PLAN

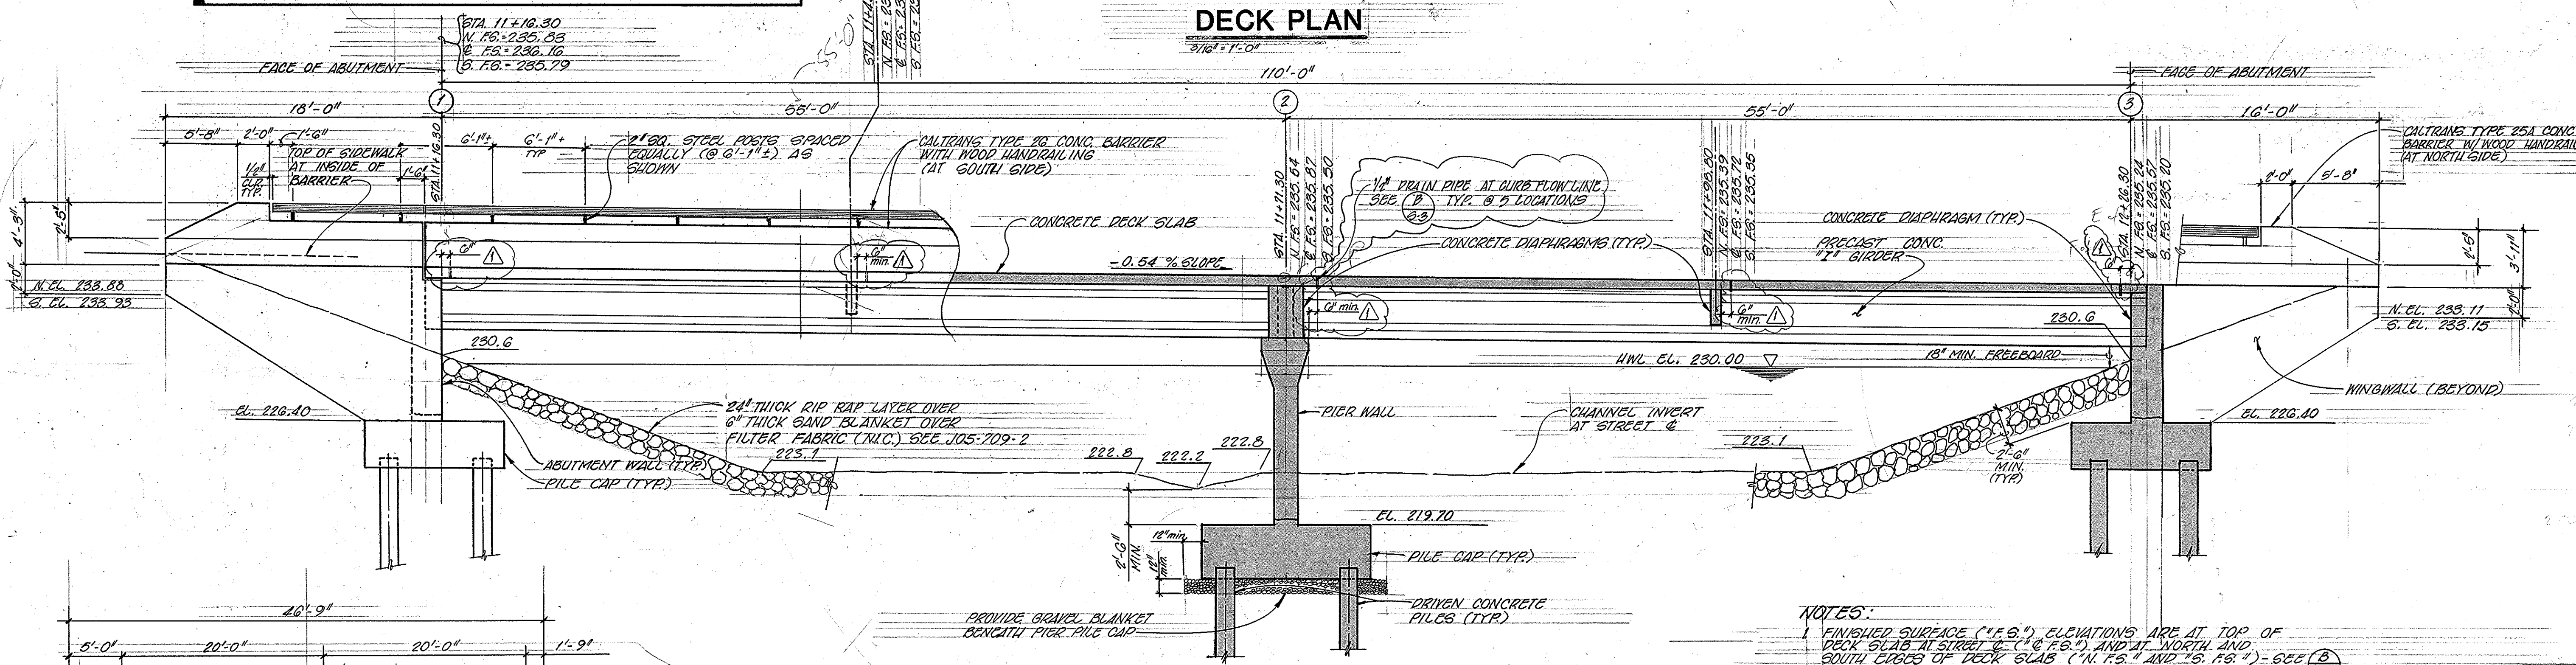

LONGITUDINAL BRIDGE SECTION

- NOTES:
- FINISHED SURFACE ("F.S.") ELEVATIONS ARE AT TOP OF DECK SLAB AT STREET C.G. ("C.G.") AND AT NORTH AND SOUTH SIDES OF DECK SLAB ("N.S." AND "S.S.") - SEE (B) 6-3
 - SEE FOUNDATION PLAN ON SHEET 6-1 FOR PILE LENGTHS

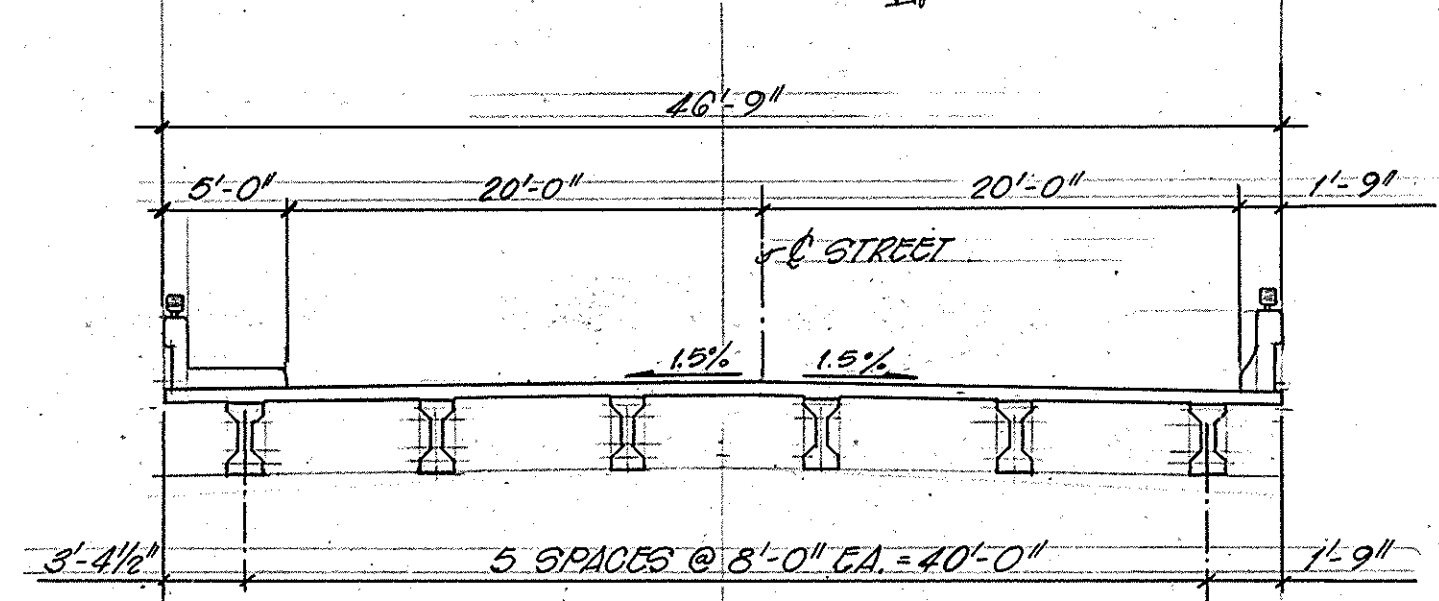


TYPICAL SECTION

ASL Consulting Engineers

DESIGNED BY: D.E.W.
DRAWN BY: K.M.R.
CHECKED BY: Z.G.A.
DATE: 2-84

DATE	BY	REVISION DESCRIPTION	APPD	DATE	DES.	DWN.
8-7-83	VEN	1. APPROX 1/4" DRAIN PIPES THRU DECK SLAB			CKD	DATE

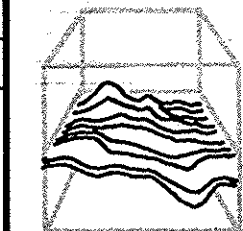

Church Engineering, Inc.
Consulting Civil Engineers
Land Planners
Land Surveyors

4020 Campus Dr.
Newport Beach
CA 92660
(714) 540-7377

ALICIA CREEK BRIDGE
DECK PLAN
LONGITUDINAL BRIDGE SECTION
TRACT NO. 12091

SHEET
S2
12121