

ORANGE COUNTY ENVIRONMENTAL MANAGEMENT AGENCY

SANTA ANA, CALIFORNIA

PLANS FOR CONSTRUCTION OF


SHEEP HILLS ROAD BRIDGE

ACROSS ALISO CREEK (CHANNEL NO. J01)

CONSTRUCTED AS PART OF TRACT 11392

PREPARED FOR MISSION VIEJO COMPANY 26137 LA PAZ ROAD • MISSION VIEJO, CALIF. 92691 714-837-6050


70 TON BENT PILE

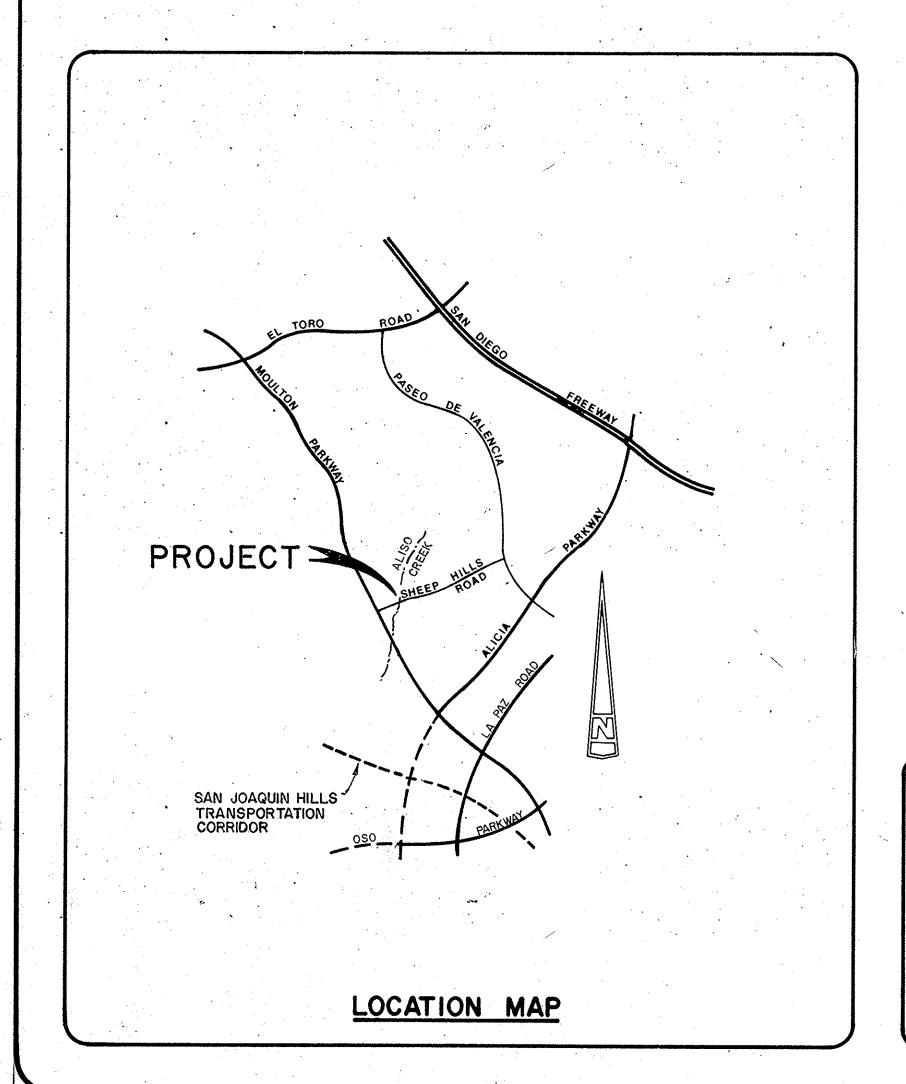

ALL UNDERGROUND UTILITIES OR STRUCTURES REPORTED BY THE OWNER OR OTHERS AND THOSE SHOWN ON THE RECORDS EXAMINED, ARE INDICATED WITH THEIR APPROX IMATE LOCATION AND EXTENT. THE OWNER, BY ACCEPTING THESE PLANS OR PRO-CEEDING WITH IMPROVEMENTS PURSUANT THERETO, AGREES TO ASSUME LIABILITY WITH THOSE REPORTED OR SHOWN ON RECORDS EXAMINED. THE CONTRACTOR IS RE-QUIRED TO TAKE DUE PRECAUTIONARY MEASURES TO PROTECT. THE UTILITIES OR STRUCTURES SHOWN AND ANY OTHER UTILITIES OR STRUCTURES FOUND AT THE SITE. IT SHALL BE THE CONTRACTOR'S RESPONSIBILITY TO NOTIFY THE OWNERS OF THE UTILITIES OR STRUCTURES CONCERNED BEFORE STARTING WORK.

ENGINEER, AND THE COUNTY OF ORANGE HARMLESS FROM ANY AND ALL LIABILITY, REAL OR ALLEGED, IN CONNECTION WITH THE PERFORMANCE OF WORK ON THIS PROJECT, EXCEPTING FOR LIABILITY ARISING FROM THE SOLE NEGLIGENCE OF THE OWNER, THE CONSULTING ENGINEER, OR THE COUNTY OF ORANGE,

ENGINEER

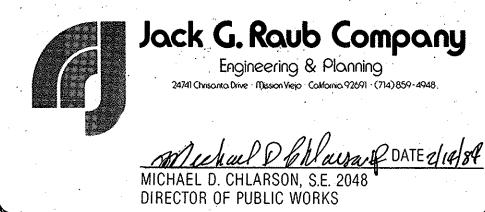

EMA-REGULATION

DATE: May 9, 1984

THIS PLAN IS SIGNED BY E.M.A. / REGULATION FOR CONCEPT AND ADHERENCE TO COUNTY STANDARDS AND REQUIREMENTS ONLY. E.M.A./REGULATION IS NOT RESPONSIBLE FOR DESIGN, ASSUMPTIONS, OR

INDEX OF SHEETS

SHEET

DESCRIPTION

UTILITY PHONE NO.

835-3833 SOUTHERN CALIFORNIA EDISON CO. SOUTHERN CALIFORNIA 495-4430 GAS CO. PACIFIC TELEPHONE CO. 951-0552 MOULTON NIGUEL 831-1070 WATER DISTRICT COUNTY OF ORANGE 834-3488 E.M.A. TRI-CITIES MUNICIPAL 979-5240

WATER DISTRICT UNDERGROUND SERVICE 800-422-4133

EXPANSION JOINT AND LEVEL WITH THE BRIDGE DECK. LEV. 1970 - ADJ. 1970 - ELEV. 279842

PARCEL MAP FILED IN BOOK 144, PAGES 10 AND 11 OF PARCEL MAPS RECORDS OF ORANGE COUNTY CALIFORNIA BEING N'6° 26' 19" W

I THRU 17 ADDED DIMENSIONS - SECT FINAL COUNTY PLAN CHECK CORRECTION 2,348 DESCRIPTION APPROVED . DATE REVISIONS

DWG. NO

DR. 5° (13985)